

การลดการใช้พลังงานในการเดินเครื่องโรงไฟฟ้าพลังความร้อนร่วม
กรณีศึกษา โรงไฟฟ้า อ่างทอง เพาเวอร์

จิรากร อิ่มทอง

สารนิพนธ์นี้เป็นส่วนหนึ่งของการศึกษาตามหลักสูตรวิศวกรรมศาสตรมหาบัณฑิต
สาขาวิชาการจัดการทางวิศวกรรม วิทยาลัยนวัตกรรมการด้านเทคโนโลยีและ
วิศวกรรมศาสตร์ มหาวิทยาลัยธุรกิจบัณฑิตย์

พ.ศ. 2562

**Reduction of Energy Usage in the operation of the Combined Cycle
Power Plant: A Case Study of Anghong Power Plant**

Jirakorn Imthong

**A Thematic Paper Submitted in Partial Fulfillment of the Requirements
for the Degree of Master of Engineering
College of Innovative Technology and Engineering
Dhurakij Pundit University**

2019



ใบรับรองสารนิพนธ์

วิทยาลัยนวัตกรรมการด้านเทคโนโลยีและวิศวกรรมศาสตร์ มหาวิทยาลัยธุรกิจบัณฑิตย์

ปริญญา วิศวกรรมศาสตรมหาบัณฑิต

หัวข้อสารนิพนธ์ การลดการใช้พลังงานในการเดินเครื่องโรงไฟฟ้าพลังความร้อนร่วม
กรณีศึกษา โรงไฟฟ้า อ่างทอง เพาเวอร์

เสนอโดย จิรากร อิ่มทอง

สาขาวิชา การจัดการทางวิศวกรรม

อาจารย์ที่ปรึกษาสารนิพนธ์ ผู้ช่วยศาสตราจารย์ ดร.อำนาจ ผดุงศิลป์


ได้พิจารณาเห็นชอบโดยคณะกรรมการสอบสารนิพนธ์แล้ว


.....ประธานกรรมการ
(รองศาสตราจารย์ ดร. ชีรเดช วุฒิพรพันธ์)


.....กรรมการและอาจารย์ที่ปรึกษาสารนิพนธ์
(ผู้ช่วยศาสตราจารย์ ดร.อำนาจ ผดุงศิลป์)


.....กรรมการ
(ผู้ช่วยศาสตราจารย์ ดร.ศุภรัชชัย วรรณรัตน์)

วิทยาลัยนวัตกรรมการด้านเทคโนโลยีและวิศวกรรมศาสตร์ รับรองแล้ว

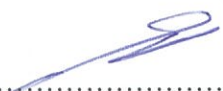
.....
(ผู้ช่วยศาสตราจารย์ ดร.ณรงค์เดช กิรติพรานนท์)
คณบดีวิทยาลัยนวัตกรรมการด้านเทคโนโลยีและวิศวกรรมศาสตร์
วันที่ ๒๐ เดือน กรกฎาคม พ.ศ. ๒๕๖๒

หัวข้อสารนิพนธ์	การลดการใช้พลังงานในการเดินเครื่องโรงไฟฟ้าพลังความร้อนร่วม กรณีศึกษาโรงไฟฟ้า อ่างทอง เพาเวอร์
ชื่อผู้เขียน	จิรากร อิ่มทอง
อาจารย์ที่ปรึกษา	ผู้ช่วยศาสตราจารย์ ดร. อำนาจ ผดุงศิลป์
สาขาวิชา	การจัดการทางวิศวกรรม
ปีการศึกษา	2561

บทคัดย่อ

งานวิจัยเรื่องการลดการใช้พลังงานในการเดินเครื่องโรงไฟฟ้าพลังความร้อนร่วมกรณีศึกษาโรงไฟฟ้า อ่างทอง เพาเวอร์ มีวัตถุประสงค์เพื่อลดการใช้พลังงานในกระบวนการผลิตไฟฟ้าและเพิ่มประสิทธิภาพโดยรวมระบบโคเจนเนอเรชัน (Cogeneration Overall Efficiency) ของโรงไฟฟ้าพลังความร้อนร่วม ในการศึกษาครั้งนี้ ได้นำเครื่องมือผังแสดงเหตุและผล (Cause-and-Effect Diagram) มาเป็นเครื่องมือที่ช่วยในการค้นหาปัจจัยที่ส่งผลต่อการสิ้นเปลืองการใช้พลังงาน และเครื่องมือควบคุมคุณภาพทั้ง 7 ชนิด (7 QC Tools) เพื่อช่วยพัฒนาและแก้ไขปัญหาต่างๆ รวบรวมและประยุกต์ใช้วิธีการทางสถิติและเปรียบเทียบข้อมูลก่อนและหลังปรับปรุง และปัจจัยที่ส่งผลต่อการสิ้นเปลืองการใช้พลังงานมากที่สุด คือ ระบบเครื่องอัดและเพิ่มความดันก๊าซธรรมชาติ (Gas Compressor System) ซึ่งมีการใช้พลังงานไฟฟ้าเฉลี่ยต่อวันอยู่ที่ประมาณ 28,800 kWh การใช้พลังงานไฟฟ้า 10,368,000 kWh/ปี ทางผู้วิจัยจึงได้เสนอแนวทางปรับปรุงและพัฒนาเพื่อลดการใช้พลังงาน โดยการเดินเครื่องกังหันก๊าซในแบบที่ไม่ใช้ชุดเครื่องอัดและเพิ่มความดันก๊าซธรรมชาติ โดยจะต้องไม่เกิดผลกระทบต่อกระบวนการผลิตไฟฟ้าหลักของโรงไฟฟ้าและจะต้องคำนึงถึงความเสี่ยงของระบบและความปลอดภัยในการปฏิบัติงาน

ผลจากการศึกษาพบว่า การเดินเครื่องโรงไฟฟ้าพลังความร้อนร่วมโดยไม่ใช้ชุดเครื่องอัดและเพิ่มความดันก๊าซธรรมชาติ สามารถลดการใช้พลังงานไฟฟ้าได้ประมาณ 9,467,640 kWh/ปี คิดเป็นเงินประมาณ 22,936,304.664 บาทต่อปี สามารถลดการใช้ปริมาณเชื้อเพลิงก๊าซธรรมชาติในกระบวนการผลิตกระแสไฟฟ้าและไอน้ำของโรงไฟฟ้าพลังความร้อนร่วมได้ประมาณ 222,541.80 MMBTU/ปี ซึ่งสามารถคิดเป็นเงินประมาณ 53,410,032 บาทต่อปี และประสิทธิภาพโดยรวมระบบโคเจนเนอเรชัน (Cogeneration Overall Efficiency) ของโรงไฟฟ้าพลังความร้อนร่วมมีประสิทธิภาพเพิ่มขึ้นเท่ากับ 0.36 %

Thematic Paper Title	Reduction of Energy Consumption in the Operation of a Combined Cycle Power Plant: A Case Study of Angthong Power Plant
Author	Jirakorn Imthong
Thematic Paper Advisor	Asst. Prof. Aumnad Phdungsilp, Ph.D., Tekn. Dr.
Department	Engineering Management
Academic Year	2018

ABSTRACT

This research was about reduction of energy consumption in the operation of a Combined Cycle Power Plant. A case at Angthong Power Plant was studied. The research aimed to reduce energy consumption in the power generation process and increase cogeneration overall efficiency of the Combined Cycle Power Plant. In this study, the Cause-and-Effect Diagram was used as a tool to determine factors that affected energy consumption. Seven Quality Control tools (7 QC tools) were utilized to improve the system and solve various problems. Data before and after the improvement were collected. Consequently, statistical methods were applied to compare the data. It was found that the factor that affected the energy consumption the most was the natural gas compressor system which consumed approximately 28,800 kWh per day, or 10,368,000 kWh per year on average. The researcher therefore proposed ways to improve and develop the system in order to reduce energy consumption by operating the gas turbine without using the natural gas compressor. This did not affect the main power generation process of the power plant. The risks and operational safety were also taken into account.

The results of the study showed that the operation of the Combined Cycle Power Plant without using the air compressor system could reduce the electricity consumption by approximately 9,467,640 kWh per year, worth about 22,936,304.664 baht per year. The improvement could also reduce the utilization of natural gas fuel in the process of generating electricity and steam of the combined cycle power plant by 222,541.80 MMBTU per year, accounted for approximately 53,410,032 baht per year. As a result, the cogeneration overall efficiency of the Combined Cycle Power Plant increased by 0.36%.

กิตติกรรมประกาศ

การศึกษาค้นคว้าเรื่อง “เรื่อง การลดการใช้พลังงานในการเดินเครื่องโรงไฟฟ้าพลังความร้อนร่วม กรณีศึกษา โรงไฟฟ้า อ่างทอง เพาเวอร์” ครั้งนี้สำเร็จลุล่วงได้ด้วยดี โดยได้รับความช่วยเหลือและการสนับสนุนจากหลายๆ ท่าน โดยเฉพาะอย่างยิ่ง ผู้ช่วยศาสตราจารย์ ดร. อำนาจ ผดุงศิลป์ ซึ่งเป็นอาจารย์ที่ปรึกษาได้ให้คำแนะนำในการคัดเลือกเรื่องที่จะทำการศึกษาค้นคว้า ให้ความรู้ด้านวิชาการ ด้านเทคนิค และข้อคิดต่างๆ ที่เป็นประโยชน์ต่อการศึกษาค้นคว้าในครั้งนี้ ผู้ทำการศึกษาซาบซึ้งในความกรุณาของท่านเป็นอย่างยิ่ง

การดำเนินการศึกษาค้นคว้าครั้งนี้จะสำเร็จลงไม่ได้ หากขาดความร่วมมือจากเพื่อนพนักงาน บริษัท อ่างทอง เพาเวอร์ จำกัด แผนกเดินเครื่อง แผนกซ่อมบำรุงบำรุง และแผนกแผนกประสิทธิภาพ ซึ่งเสียสละเวลาในการทำการวิเคราะห์ข้อมูล จากการดำเนินงานด้วยวิธีการสำรวจหน้างานจริง ประกอบกับการเก็บรวบรวมข้อมูลและการวิเคราะห์ข้อมูลทางสถิติ ทำให้ได้ข้อมูลที่เป็นประโยชน์ต่อบริษัท อ่างทอง เพาเวอร์ จำกัด

ในท้ายที่สุดนี้ ขอกราบขอบพระคุณบิดา มารดา เพื่อนๆ และเจ้าหน้าที่คณะวิศวกรรมศาสตร์ทุกท่านที่ช่วยเหลือและให้กำลังใจ และต้องขอระลึกถึงความกรุณาของคณาจารย์ทุกท่านที่เป็นผู้ชี้แนะแนวทางการศึกษาในตอนต้น รวมทั้งให้คำแนะนำในการประมวลผลข้อมูลด้วยระบบคอมพิวเตอร์ และการทดสอบต่าง ๆ ที่เป็นประโยชน์ และขอขอบพระคุณทุกท่านที่มีได้กล่าวนามมา ณ ที่นี้ ขอขอบคุณกำลังใจจากบุคคลในครอบครัวและเพื่อนร่วมชั้นเรียน ผู้เขียนขอมอบคุณประโยชน์ของสารนิพนธ์ฉบับนี้ให้แก่ บพการี ครูอาจารย์และผู้มีพระคุณทุกท่าน ที่มีส่วนช่วยเหลือและเป็นกำลังใจรวมทั้งให้การสนับสนุนเป็นอย่างดีจนทำให้การศึกษาค้นคว้าครั้งนี้สำเร็จลุล่วงด้วยดี

จิรากร อิ่มทอง

สารบัญ

	หน้า
บทคัดย่อภาษาไทย.....	ฉ
บทคัดย่อภาษาอังกฤษ.....	ง
กิตติกรรมประกาศ.....	จ
สารบัญตาราง.....	ช
สารบัญภาพ.....	ฉ
บทที่	
1. บทนำ.....	1
1.1 ความสำคัญและความเป็นมาของปัญหา.....	2
1.2 วัตถุประสงค์ของการวิจัย.....	5
1.3 ขอบเขตการวิจัย.....	5
1.4 ประโยชน์ที่คาดว่าจะได้รับ.....	6
1.5 ขั้นตอนการดำเนินงานวิจัย.....	6
2. แนวคิด ทฤษฎี และผลงานวิจัยที่เกี่ยวข้อง.....	9
2.1 บทนำ.....	9
2.2 การแบ่งประเภทของเครื่องอัดและการเพิ่มความดันของอากาศและก๊าซ.....	12
2.3 กังหันก๊าซ (Gas turbine).....	15
2.4 SIEMENS SGT-800 กังหันก๊าซ (Gas turbine).....	19
2.5 เครื่องมือคุณภาพ 7 ชนิด (7 QC Tools).....	35
2.6 งานวิจัยที่เกี่ยวข้อง.....	41
3. ระเบียบวิธีวิจัย.....	47
3.1 ศึกษาและวิเคราะห์ผลกระทบระบบของบริษัทกรณีศึกษา ปัจจัยที่ส่งผลต่อการ สิ้นเปลืองการใช้พลังงาน.....	47
3.2 แผนผังการวิจัย.....	48
3.3 ข้อมูลทั่วไปของโรงไฟฟ้าอ่างทอง เพาเวอร์.....	50

สารบัญ (ต่อ)

บทที่	หน้า
3.4 ประเภทของสถานีก๊าซธรรมชาติ สถานีควบคุมและวัดปริมาณก๊าซธรรมชาติ หรือสถานีก๊าซธรรมชาติ [(Gas Pipeline and Metering & Regulation Station ; (GMRS)].....	53
3.5 ข้อมูลและขั้นตอนการดำเนินการ.....	59
3.6 การสรุปผล.....	71
4. ผลการวิจัย.....	72
4.1 ข้อมูลค่าความดันเชื้อเพลิงก๊าซธรรมชาติต้นทาง (Upstream) หลังทำการปรับปรุง.....	72
4.2 ข้อมูลค่าความดันเชื้อเพลิงก๊าซธรรมชาติ หลังจากที่ตั้งค่าแรงดันที่จุดวาล์ว ควบคุมความดันก๊าซธรรมชาติ (Downstream) หลังทำการปรับปรุง.....	73
4.3 ข้อมูลการใช้พลังงาน ไฟฟ้า (Plant Station Service Energy (kWh)) ก่อน-หลังทำการปรับปรุง.....	73
4.4 ข้อมูลการใช้ปริมาณเชื้อเพลิงก๊าซธรรมชาติ ในการผลิตกระแสไฟฟ้า (Fuel Gas Consumption (MMBTU)) ก่อน-หลังทำการปรับปรุง.....	74
4.5 ข้อมูลประสิทธิภาพโดยรวมระบบ โคเจนเนอเรชัน (Cogeneration Overall Efficiency) ของ โรงไฟฟ้าพลังความร้อนร่วม ก่อน-หลังทำการปรับปรุง.....	76
5. สรุปและอภิปรายผลงานวิจัย.....	78
5.1 สรุปผลการวิจัย.....	78
5.2 ข้อเสนอแนะและข้อจำกัด.....	79
บรรณานุกรม.....	82
ภาคผนวก.....	85
ประวัติผู้เขียน.....	294

สารบัญตาราง

ตารางที่		หน้า
1.1	แสดงปัจจัยที่ส่งผลต่อการสิ้นเปลืองการใช้พลังงาน.....	3
1.2	แสดงแผนการศึกษาและวิจัยของโครงการ.....	7
2.1	Parameter of Cogeneration System.....	19
2.2	SIEMENS SGT-800 Performance Specifications.....	35



สารบัญภาพ

ภาพที่	หน้า
2.1 แทนจุดเจาะก๊าซธรรมชาติ กลางทะเลอ่าวไทย.....	10
2.2 เครื่องอัดและเพิ่มความดันแบบอัดในแนวแกน Axial Compressor.....	12
2.3 เครื่องอัดและเพิ่มความดันแบบอัดหมุนเหวี่ยงหนีศูนย์กลาง Centrifugal Compressor...	13
2.4 เครื่องอัดและเพิ่มความดันแบบสกรูอัดหมุนแบบชนิด Twin screw compressor....	14
2.5 เครื่องอัดและเพิ่มความดันแบบสกรูอัดหมุนแบบชนิด Single screw compressor...	14
2.6 เครื่องอัดและเพิ่มความดันแบบลูกสูบ Reciprocating Compressors.....	15
2.7 กังหันก๊าซ.....	16
2.8 กังหันก๊าซแบบวัฏจักรเปิด.....	17
2.9 กระบวนการต่างๆในวัฏจักรเบรย์ตัน (Brayton Cycle).....	18
2.10 แสดงหน้าจอ SIMATIC HMI PSC7 for SIEMENS SGT-800.....	19
2.11 SIEMENS SGT-800.....	21
2.12 Gas Turbine Compressor (เครื่องอัดอากาศ).....	22
2.13 Sealing & Cooling air stage 3 & stage 5.....	22
2.14 Gas Turbine Combustion Chamber.....	23
2.15 ภาพแสดง Turbine blades.....	24
2.16 ภาพแสดงกระบวนการทำงานภายใน Gas Turbine.....	24
2.17 หลักการทำงานของ Brayton Cycle.....	25
2.18 วัฏจักรการทำงานของ Gas Turbine.....	27
2.19 กราฟแสดงความสัมพันธ์อุณหภูมิของอากาศที่เข้า Compressor กับ Parameter ต่างๆ.....	28
2.20 (ต่อ) กราฟแสดงความสัมพันธ์อุณหภูมิของอากาศที่เข้า Compressor กับ Parameter ต่างๆ.....	29
2.21 ฟังกระบวนการ Process Flow Diagram.....	30
2.22 กราฟแสดงความสัมพันธ์เมื่อความขึ้นเปลี่ยนแปลงกับ Output และ Heat Rate.....	31
2.23 SGT-800 Power Generation Performance.....	34

สารบัญภาพ (ต่อ)

ภาพที่	หน้า
2.24 ตัวอย่าง แผนภูมิพารेटโต (Pareto Diagram).....	37
2.25 ตัวอย่าง ผังแสดงเหตุและผล (Cause-and-Effect Diagram).....	38
2.26 ตัวอย่าง กราฟ (Graph).....	38
2.27 ตัวอย่าง ใบตรวจสอบ (Check Sheet).....	39
2.28 ตัวอย่าง ผังการกระจาย (Scatter Diagram).....	40
2.29 ตัวอย่าง ฮิสโตแกรม (Histogram).....	40
2.30 ตัวอย่าง แผนภูมิควบคุม (Control Chart).....	41
3.1 ภาพแสดงผังก้างปลาเพื่อค้นหาปัจจัยที่ส่งผลต่อการสิ้นเปลืองการใช้พลังงาน....	48
3.2 แผนผังขั้นตอนการดำเนินงานศึกษา.....	49
3.3 แสดงภาพบริษัท อ่างทอง เพาเวอร์ จำกัด หรือโรงไฟฟ้า อ่างทอง.....	50
3.4 แผนภาพการทำงานของโรงไฟฟ้าพลังความร้อนร่วม.....	51
3.5 ภาพแสดงสภาวะการณ์การทำงานของโรงไฟฟ้าอ่างทอง เพาเวอร์ ที่ใช้ชุดเครื่องอัด และเพิ่มความดันก๊าซธรรมชาติในการเดินเครื่องโรงไฟฟ้า.....	51
3.6 The low gas supply pressure requirement 27-30 Bar(a) or 390-435 psi(a).....	52
3.7 สถานีก๊าซฯ แบบ Conventional Type.....	53
3.8 สถานีก๊าซฯ แบบ Skid Pack Type.....	54
3.9 ตัวอย่างแผนผังสถานีควบคุมและวัดปริมาณก๊าซธรรมชาติ (GMRS).....	54
3.10 อุปกรณ์ Dry Gas Filter.....	55
3.11 แสดงอุปกรณ์ Regulator.....	56
3.12 แสดงอุปกรณ์ Safety Shut off Valve.....	56
3.13 แสดงอุปกรณ์ Pressure Safety Valve.....	57
3.14 แสดงอุปกรณ์ Turbine Flow Meter.....	58
3.15 แสดงอุปกรณ์ Electronic Volume Corrector (EVC).....	58
3.16 ห้องควบคุม Central Control Room (CCR) การเดินเครื่องของโรงไฟฟ้า อ่างทอง เพาเวอร์.....	60
3.17 Overview Software SCADA Wonderware Intouch by Schneider Electric.....	61

สารบัญภาพ (ต่อ)

ภาพที่	หน้า
3.18 Overview Foxselect Software Foxboro Distributed Control System (DCS) Solutions by Schneider Electric Foxboro Evo Process Automation System.....	63
3.19 Software SCADA Wonderware Intouch by Schneider Electric.....	64
3.20 Foxboro Distributed Control System (DCS) Solutions by Schneider Electric...	64
3.21 ภาพแสดงการรวบรวมข้อมูลก่อนการปรับปรุง ข้อมูลจากหน้างาน ข้อมูลจากการตรวจสอบการทำงานของเครื่องจักรที่ห้อง Control Room.....	65
3.22 ภาพแสดงการตัดแยกระบบและปรับตั้งสปริงของชุดวาล์วควบคุมความดันก๊าซธรรมชาติ และ Pressure and Leak Testing with official test report with R-Stamp และ Re-Test and Certificate suction Piping N2 Flushing and Blanking of Gas Compressor Long Term Preservation.....	66
3.23 ภาพแสดงวงจรการทำงานของโรงไฟฟ้าพลังความร้อนร่วม หลังการปรับปรุง..	67
3.24 แสดงค่าเฉลี่ยแรงดันขาเข้า (Upstream) ก่อนทำการปรับปรุง.....	68
3.25 แสดงค่าเฉลี่ยแรงดันขาออกของชุดวาล์วควบคุมความดันก๊าซธรรมชาติ (Downstream) ก่อนทำการปรับปรุง.....	68
3.26 แสดงค่าเฉลี่ยการใช้พลังงานไฟฟ้า ก่อนทำการปรับปรุง.....	69
3.27 แสดงค่าเฉลี่ยการใช้ปริมาณเชื้อเพลิงก๊าซธรรมชาติ ก่อนทำการปรับปรุง.....	70
3.28 แสดงค่าเฉลี่ยประสิทธิภาพการเดินเครื่อง โดยรวมระบบ โคอเจนเนอเรชัน (Cogeneration Overall Efficiency) ก่อนทำการปรับปรุง.....	70
4.1 แสดงค่าเฉลี่ยแรงดันขาเข้า (Upstream) หลังทำการปรับปรุง.....	72
4.2 แสดงค่าเฉลี่ยแรงดันขาออกของชุดวาล์วควบคุมความดันก๊าซธรรมชาติ (Downstream) หลังทำการปรับปรุง.....	73
4.3 แสดงค่าเฉลี่ยการใช้พลังงานไฟฟ้า ก่อน-หลังทำการปรับปรุง.....	74
4.4 แสดงค่าเฉลี่ยการใช้ปริมาณเชื้อเพลิงก๊าซธรรมชาติ ก่อน-หลังทำการปรับปรุง....	75
4.5 แสดงค่าเฉลี่ยประสิทธิภาพการเดินเครื่อง โดยรวมระบบ โคอเจนเนอเรชัน (Cogeneration Overall Efficiency) ก่อน-หลังทำการปรับปรุง.....	76

บทที่ 1

บทนำ

พลังงานนับว่าเป็นปัจจัยพื้นฐานสำคัญในการขับเคลื่อนเศรษฐกิจซึ่งภาคอุตสาหกรรม การผลิตนั้นถือว่าเป็นหัวใจสำคัญในการสร้างการเติบโตทางเศรษฐกิจและเนื่องจากการขยายตัวอย่างรวดเร็วทั้งทางภาคเศรษฐกิจและภาคอุตสาหกรรมรวมทั้งจำนวนประชากรที่เพิ่มขึ้นอย่างต่อเนื่องทำให้ความต้องการในการใช้พลังงานสูงมากขึ้นตลอดในช่วงทศวรรษที่ผ่านมาโดยอัตราการใช้พลังงานในประเทศไทยมีแนวโน้มว่าจะสูงเพิ่มขึ้นตามการขยายตัวของเศรษฐกิจไทยต่อไป และจากสถานการณ์ราคาน้ำมันในตลาดโลกที่มีความผันผวนประกอบกับแหล่งพลังงานภายในประเทศมีจำกัดทำให้ต้องอาศัยการนำเข้าพลังงานจากต่างประเทศเป็นจำนวนมากดังนั้นสัดส่วนการพึ่งพาจากต่างประเทศจึงสูงกว่าร้อยละ 60 เมื่อเทียบกับการใช้พลังงานทั่วทั้งประเทศ นอกจากนั้นในการสำรวจหาและพัฒนาแหล่งพลังงานใหม่ๆไม่เพียงแต่จะใช้เงินลงทุนสูงมากเท่านั้นแต่ยังทำให้ต้องสูญเสียทรัพยากรธรรมชาติที่มีค่าอันอาจก่อให้เกิดผลกระทบต่อสิ่งแวดล้อมในระยะยาวอีกด้วยซึ่งล้วนแต่ส่งผลกระทบต่อต้นทุนการผลิตและความเจริญก้าวหน้าของเศรษฐกิจของภาคอุตสาหกรรมไทย

โรงงานอุตสาหกรรมที่มีการใช้พลังงานสูงจึงมีความจำเป็นต้องคอยปรับตัวเองให้พร้อมกับสถานการณ์ต่างๆแนวทางหนึ่งที่น่ามาใช้เพื่อแก้ปัญหาก็คือการใช้พลังงานอย่างประหยัดและมีประสิทธิภาพซึ่งเป็นตัวช่วยลดการใช้พลังงานอย่างสิ้นเปลืองนอกจากนี้ยังเป็นการลดการลงทุนในการจัดหาแหล่งพลังงานใหม่และช่วยลดการนำเข้าพลังงานจากต่างประเทศรวมทั้งป้องกันผลกระทบต่อสภาวะแวดล้อมที่อาจเกิดขึ้นจากการผลิตและการใช้พลังงาน การประหยัดพลังงานจึงเป็นสิ่งจำเป็นอย่างยิ่ง โดยเฉพาะในภาคธุรกิจอุตสาหกรรมที่มีการแข่งขันกันสูงปัจจุบันมีการใช้พลังงานต่างๆในกระบวนการผลิตเป็นจำนวนมากทั้งที่อยู่ในรูปของเหลวของแข็งและก๊าซดังนั้นจึงจำเป็นต้องหามาตรการหรือแนวทางในการประหยัดพลังงานและการลดต้นทุนที่ผลอย่างจริงจังในภาคปฏิบัติมาใช้เพื่อลดการใช้พลังงานควบคู่ไปกับการลดต้นทุนทุกอย่างพร้อมกับพัฒนาความสามารถของบุคลากรให้มีประสิทธิภาพเพื่อให้สามารถแข่งขันในตลาดโลกได้

1.1 ความสำคัญและความเป็นมาของปัญหา

ปัจจุบันประเทศไทยมีความต้องการในการใช้ไฟฟ้าในปริมาณที่สูงมากขึ้นทุกปี ซึ่งไฟฟ้าเป็นปัจจัยหลักที่ใช้ในการพัฒนาเศรษฐกิจและการเติบโตของประเทศ การทำให้โรงไฟฟ้าสามารถผลิตไฟฟ้าได้อย่างเต็มประสิทธิภาพจึงเป็นสิ่งจำเป็นที่ช่วยในการชะลอการสร้างโรงไฟฟ้าใหม่ซึ่งจะเห็นได้ว่าการสร้างโรงไฟฟ้าใหม่ในปัจจุบันนั้นค่อนข้างเป็นไปได้ยาก เนื่องจากต้องคำนึงถึงผลกระทบที่เกิดขึ้นต่อประชาชนและสิ่งแวดล้อมเป็นหลัก โรงไฟฟ้าที่มีผลกระทบต่อสิ่งแวดล้อมน้อยและมีการผลิตไฟฟ้าโดยส่วนมากในประเทศไทยมาจากโรงไฟฟ้าพลังความร้อนร่วม (Combined Cycle Power Plant) โดยกังหันก๊าซ (Gas Turbine) เป็นอุปกรณ์สำคัญที่ส่งผลต่อกำลังการผลิตไฟฟ้า ซึ่งการทำให้กังหันก๊าซมีกำลังการผลิตอยู่ในเกณฑ์ปกติ จะทำให้โรงไฟฟ้ามีส่วนการใช้พลังงานสำหรับการผลิตไฟฟ้าเป็นปกติได้ กระบวนการผลิตไฟฟ้าและไอน้ำของบริษัท อ่างทอง เพาเวอร์ จำกัด หรือเรียกว่าโรงไฟฟ้าอ่างทอง เพาเวอร์ ซึ่งเป็นโรงไฟฟ้าพลังความร้อนร่วมโดยใช้ก๊าซธรรมชาติจาก ปตท. เป็นเชื้อเพลิงในการผลิตหลักและใช้น้ำดิบจากแหล่งน้ำธรรมชาติในเขตพื้นที่อำเภอไชโย จังหวัดอ่างทอง ในการผลิตไอน้ำและน้ำหล่อเย็น เนื่องด้วยการผลิตที่มีต้นทุนที่สูงอยู่แล้วนั้น ทำให้เกิดแนวความคิดที่จะปรับปรุงกระบวนการผลิตให้เกิดการใช้พลังงานที่คุ้มค่าที่สุด ประหยัดพลังงานที่สุด และมีประสิทธิภาพกับโรงไฟฟ้าอ่างทอง เพาเวอร์มากที่สุด

จากที่กล่าวมาแล้วว่าในปัจจุบันทางภาคอุตสาหกรรมธุรกิจพลังงานมีการแข่งขันกันสูงมากยิ่งขึ้น ปัจจัยอย่างหนึ่งที่ทำให้องค์กรสามารถอยู่รอดและแข่งขันในธุรกิจภาคอุตสาหกรรมธุรกิจพลังงานได้ คือการลดค่าใช้จ่ายขององค์กรและการอนุรักษ์พลังงาน ดังนั้นจึงต้องมีการศึกษาการใช้พลังงานเพื่อหาแนวทางหรือมาตรการในการลดการใช้พลังงาน ทางผู้จัดทำจึงมองเห็นปัจจัยที่ส่งผลต่อการสิ้นเปลืองการใช้พลังงาน และสามารถจำแนกความสำคัญและความเป็นมาของปัญหา ออกเป็น 4 ปัจจัยหลักๆดังนี้

1. ปัจจัยทางด้านคน (Man) พนักงานหรือบุคลากรทั้งจากภายในและภายนอก
2. ปัจจัยทางด้านเครื่องจักร (Machine) เครื่องจักรหรืออุปกรณ์อำนวยความสะดวก
3. ปัจจัยทางด้านวัตถุดิบ (Material) ผลิตภัณฑ์ บริการ วัตถุดิบหรืออะไหล่ อุปกรณ์

อื่นๆ

4. ปัจจัยทางด้านขั้นตอนหรือวิธีการปฏิบัติงาน (Method) กระบวนการทำงาน

ตารางที่ 1.1 แสดงปัจจัยที่ส่งผลต่อการสิ้นเปลืองการใช้พลังงาน

ลำดับ	ปัจจัยที่ส่งผลต่อการสิ้นเปลืองการใช้พลังงาน	รายละเอียดความสำคัญและความเป็นมาของปัญหา
1	ปัจจัยทางด้านคน (Man)	Board Man ควบคุมกระบวนการผลิตพลังงานไฟฟ้า เกินสัญญาซื้อขายไฟฟ้าให้กับ EGAT เฉลี่ยต่อวัน อยู่ที่ประมาณ 1,500 kWh
2	ปัจจัยทางด้านเครื่องจักร (Machine)	ระบบเครื่องอัดและเพิ่มความดันก๊าซธรรมชาติ (Gas Compressor System) ปริมาณการใช้พลังงานไฟฟ้าเฉลี่ยต่อวัน อยู่ที่ประมาณ 28,800 kWh ตลอด 24 ชั่วโมง
3	ปัจจัยทางด้านวัตถุดิบ (Material)	ระบบน้ำหล่อเย็น (Cooling Water) ปริมาณการใช้น้ำในการหล่อเย็นเฉลี่ยต่อวัน 150,000 ลูกบาศก์เมตร (M3) ตลอด 24 ชั่วโมง
4	ปัจจัยทางด้านขั้นตอนหรือวิธีการปฏิบัติงาน (Method)	ขั้นตอนการปฏิบัติงาน Startup/Shutdown Gas Turbine and Boiler เพื่อควบคุมปริมาณการสิ้นเปลืองเชื้อเพลิง <i>(อยู่ในขั้นตอนและแนวทางการอนุรักษ์พลังงาน ยังคงไม่มีตัวเลขที่แน่นอน)</i>

จากการจำแนกปัจจัยที่นำมาศึกษา สามารถวิเคราะห์เพื่อหาปัญหาและความสำคัญที่จะนำมาปรับปรุงและพัฒนา การลดค่าใช้จ่ายขององค์กรและการอนุรักษ์พลังงาน เพื่อลดการใช้พลังงานในกระบวนการผลิตไฟฟ้าและเพิ่มประสิทธิภาพโดยรวมระบบ โคอเจนเนอเรชัน (Cogeneration Overall Efficiency) ของ โรงไฟฟ้าพลังความร้อนร่วม และจากประเด็นปัจจัยหลักทั้ง 4 ข้อ ทางผู้จัดทำจึงสังเกตเห็น ปัจจัยที่ส่งผลต่อการสิ้นเปลืองการใช้พลังงานมากที่สุด คือ ปัจจัยทางด้านเครื่องจักร (Machine) คือ ระบบเครื่องอัดและเพิ่มความดันก๊าซธรรมชาติ (Gas Compressor System) มีการใช้พลังงานไฟฟ้าเฉลี่ยต่อวัน อยู่ที่ประมาณ 28,800 kWh ซึ่งถ้าคำนวณการใช้พลังงานไฟฟ้าต่อปี จะสูงถึง 10,368,000 kWh จากตัวเลขดังกล่าว จะเห็นได้ว่ามีค่าการใช้พลังงานไฟฟ้าที่สูงมาก ทางผู้จัดทำจึงมีแนวทางและมองเห็นว่าเป็นปัจจัยที่ควรนำไปปรับปรุงและพัฒนาเพื่อลดการใช้พลังงาน โดยที่จะเดินเครื่องกังหันก๊าซ โรงไฟฟ้าพลังความร้อนร่วม ของ โรงไฟฟ้า อ่างทอง เพาเวอร์ โดยไม่ใช้ชุดเครื่องอัดและเพิ่มความดันก๊าซธรรมชาติ (Gas Compressor System) เพื่อลดการใช้พลังงานไฟฟ้า โดยทั้งหมดที่กล่าวมานี้จะต้องไม่เกิดผลกระทบต่อกระบวนการผลิตไฟฟ้าหลักของโรงไฟฟ้าอ่างทอง เพาเวอร์และจะต้องคำนึงถึงความเสี่ยงของระบบและความปลอดภัยในการปฏิบัติงาน

ในการศึกษานี้ได้ทำการศึกษาเพื่อลดการใช้พลังงานในกระบวนการผลิตไฟฟ้าและเพิ่มประสิทธิภาพการเดินเครื่อง โรงไฟฟ้าพลังความร้อนร่วม ทางผู้จัดทำได้มีแนวคิดที่จะพัฒนาให้

เกิดการใช้พลังงานอย่างคุ้มค่า เหมาะสมและประหยัดพลังงานสูงสุดเพื่อที่จะเป็นการลดต้นทุนการผลิตได้ โดยมุ่งเน้นไปที่ระบบเครื่องอัดและเพิ่มความดันก๊าซธรรมชาติ (Gas Compressor System) โดยได้มีการนำเสนอให้ทาง ปตท. ปรับตั้งค่าแรงดันที่สถานีควบคุมความดันและวัดปริมาณก๊าซธรรมชาติของ ปตท. ในเขตพื้นที่โรงไฟฟ้าอ่างทอง เนื่องจากแรงดันต้นทางหลักที่รับมาจากส่วนปฏิบัติการระบบท่อเขต 2 รับผิดชอบระบบท่อส่งก๊าซฯ ครอบคลุมพื้นที่จังหวัดกรุงเทพมหานคร ปทุมธานี พระนครศรีอยุธยา สระบุรี ลพบุรี และปราจีนบุรี มายังสถานีควบคุมความดันและวัดปริมาณก๊าซธรรมชาติ ปตท. ในเขตพื้นที่โรงไฟฟ้าอ่างทอง โดยวัดได้ที่แรงดันต้นทาง (Upstream) ประมาณ 52 Bar(a) และผ่านมายังชุดควาล์วควบคุมความดันก๊าซธรรมชาติปรับลดแรงดันลง (Downstream) ที่แรงดันประมาณ 20 Bar(a) ซึ่งทางหน่วยงานปฏิบัติการเดินเครื่องของโรงไฟฟ้าอ่างทองเพาเวอร์ ได้รวบรวมและเก็บข้อมูลก่อนทำการปรับปรุงของค่าความดันต้นทาง (Upstream) และผ่านมายังชุดควาล์วควบคุมความดันก๊าซธรรมชาติปรับลดแรงดันลง (Downstream) และเริ่มศึกษาทำความเข้าใจ เก็บข้อมูลตั้งแต่โรงไฟฟ้า อ่างทองเพาเวอร์ เริ่มดำเนินการจำหน่ายไฟฟ้าเข้าสู่ระบบเชิงพาณิชย์ (Commercial Operation Date : COD) เมื่อเดือนพฤษภาคม พ.ศ. 2559 โดยทั้งนี้ได้เริ่มดำเนินการเก็บข้อมูล วิเคราะห์ข้อมูล ในการเดินเครื่อง เป็นระยะเวลา 6 เดือน เริ่มตั้งแต่ เดือน มิถุนายน พ.ศ. 2559 ถึง เดือน พฤศจิกายน พ.ศ. 2559 และยังรวมไปถึงการเก็บข้อมูลการใช้พลังงานไฟฟ้ารวมของโรงไฟฟ้าอ่างทอง (Plant Station Service Energy (kWh)) ในขณะที่เดินเครื่องอัดและเพิ่มความดันก๊าซธรรมชาติ (Gas Compressor System) ต่อวัน และการใช้ปริมาณเชื้อเพลิงก๊าซธรรมชาติ (Fuel Gas Consumption (MMBTU)) ในการผลิตกระแสไฟฟ้าต่อวัน และยังรวมไปถึงประสิทธิภาพของการเดินเครื่องโดยรวม Overall Plant Net Cogen. Efficiency LHV (dry) (%) ของโรงไฟฟ้า อ่างทอง เพาเวอร์ อีกด้วย ทั้งนี้ได้นำข้อมูลดังกล่าวที่ใช้ในกระบวนการผลิตต่อวันนำไปคำนวณหาค่าเฉลี่ยออกมาเป็นรายเดือน และจากข้อมูลดังกล่าวนี้ จึงได้ดำเนินการรวบรวมและสรุปผลในช่วงระยะเวลา 6 เดือนแรก ก่อนทำการปรับปรุง หลังจากที่โรงไฟฟ้าอ่างทอง เริ่มดำเนินการจำหน่ายไฟฟ้าเข้าสู่ระบบเชิงพาณิชย์ (Commercial Operation Date : COD) เพื่อส่งมอบข้อมูลให้กับทาง ปตท. ในการพิจารณา เพื่อขอปรับตั้งค่าแรงดันที่ชุดควาล์วควบคุมความดัน (Downstream) จากเดิม ที่แรงดัน 20 Bar(a) และให้ปรับตั้งค่าแรงดันที่ชุดควาล์วควบคุมความดันไปที่แรงดัน 30 Bar(a) โดยได้ขอให้ทาง ปตท. ปรับตั้งค่าแรงดันในช่วงเดือน ธันวาคม พ.ศ. 2559 ซึ่งในช่วงเวลาดังกล่าวทางโรงไฟฟ้าอ่างทอง จะมีการซ่อมบำรุงประจำปี และเมื่อทางโรงไฟฟ้าอ่างทอง ได้ดำเนินการปรับตั้งค่าแรงดันที่ชุดควาล์วควบคุมความดันไปที่แรงดัน 30 Bar(a) ใหม่แล้วนั้น จะเริ่มเดินเครื่องโรงไฟฟ้าทันที โดยที่จะให้ก๊าซธรรมชาติผ่านเข้าสู่ห้องเผาไหม้ของเครื่องกังหันก๊าซโดยตรง และจะเดินเครื่องโรงไฟฟ้าพลังความร้อนร่วม โดยไม่ใช้เครื่องอัดและเพิ่มความ

ดันก๊าซธรรมชาติ (Gas Compressor System) จากนั้นจะเริ่มดำเนินการเก็บข้อมูลหลังการปรับปรุง เพื่อนำมาเปรียบเทียบกับข้อมูลก่อนการปรับปรุง โดยจะเริ่มดำเนินการเก็บข้อมูลในช่วงเดือน มกราคม พ.ศ. 2560 ถึง เดือน มิถุนายน พ.ศ. 2560 เป็นระยะเวลา 6 เดือน เช่นกัน

ทั้งนี้จึงสรุปได้ว่า ทางผู้จัดทำจะนำระบบเครื่องอัดและเพิ่มความดันก๊าซธรรมชาติ (Gas Compressor System) มาทำการศึกษาในการวิจัยครั้งนี้ โดยเหตุผลสืบเนื่องจากที่มีข้อมูลก่อนปรับปรุงครบถ้วนแล้วและมีสัมพันธที่ดีกับ ปตท. เพื่อขอดำเนินการปรับตั้งสปริงที่ชุกควาล์วควบคุมความดันก๊าซธรรมชาติ (Downstream) ที่สถานีควบคุมความดันและวัดปริมาณก๊าซธรรมชาติจาก ปตท. ในเขตพื้นที่โรงไฟฟ้าอ่างทอง เพาเวอร์ จากเดิมที่แรงดัน 20 Bar(a) ไปที่แรงดัน 30 Bar(a) (ตามที่คุณผลิตได้ออกแบบ (SIEMENS SGT-800)) คือ 27-30 Bar(a) เพื่อให้ค่าความดันดังกล่าวผ่านไปยังห้องเผาไหม้ของเครื่องกังหันก๊าซได้โดยตรง โดยที่ไม่จำเป็นต้องผ่านไปยังระบบของชุดเครื่องอัดและเพิ่มความดันก๊าซธรรมชาติ (Gas Compressor System) ต่อไป โดยทั้งหมดที่กล่าวมานี้จะต้องไม่เกิดผลกระทบต่อกระบวนการผลิตไฟฟ้าหลักของโรงไฟฟ้าอ่างทอง เพาเวอร์และจะต้องคำนึงถึงความเสี่ยงของระบบและความปลอดภัยในการปฏิบัติงาน

1.2 วัตถุประสงค์ของการวิจัย

1. เพื่อลดการใช้พลังงานในกระบวนการผลิตไฟฟ้าของ โรงไฟฟ้าพลังความร้อนร่วม
2. เพื่อเพิ่มประสิทธิภาพโดยรวมระบบโคเจนเนอเรชัน (Cogeneration Overall Efficiency) ของ โรงไฟฟ้าพลังความร้อนร่วม

1.3 ขอบเขตการวิจัย

1. ศึกษาการใช้พลังงานไฟฟ้าของชุดเครื่องอัดและเพิ่มความดันของก๊าซธรรมชาติ (Gas Compressor System) ในช่วงก่อนปรับปรุงและหลังปรับปรุง
2. เปรียบเทียบค่าการใช้พลังงานไฟฟ้าในกระบวนการผลิตไฟฟ้าของ โรงไฟฟ้าพลังความร้อนร่วม ก่อนปรับปรุงและหลังปรับปรุง
3. เปรียบเทียบประสิทธิภาพการเดินเครื่องในกระบวนการผลิตไฟฟ้าของ โรงไฟฟ้าพลังความร้อนร่วม ก่อนปรับปรุงและหลังปรับปรุง
4. เปรียบเทียบการใช้ปริมาณเชื้อเพลิงก๊าซธรรมชาติ ในกระบวนการผลิตไฟฟ้าของ โรงไฟฟ้าพลังความร้อนร่วม ก่อนปรับปรุงและหลังปรับปรุง

1.4 ประโยชน์ที่คาดว่าจะได้รับ

1. สามารถลดการใช้พลังงานไฟฟ้าในกระบวนการผลิตไฟฟ้าของโรงไฟฟ้าพลังความร้อนร่วม
2. ไม่มีผลกระทบต่อสถานการณ์การเดินเครื่องของโรงไฟฟ้าพลังความร้อนร่วมและประสิทธิภาพโดยรวมระบบโคเจนเนอเรชัน (Cogeneration Overall Efficiency) ของโรงไฟฟ้าพลังความร้อนร่วม
3. เป็นการเพิ่มองค์ความรู้ให้กับองค์กรและในภาคอุตสาหกรรม ทั้งในด้านการอนุรักษ์พลังงานและสามารถนำไปประยุกต์ใช้เพื่อปรับปรุงกับโรงไฟฟ้าหรืออุตสาหกรรมอื่นๆได้ต่อไป
4. ลดค่าใช้จ่ายต้นทุนของเชื้อเพลิงก๊าซธรรมชาติ ในกระบวนการผลิตไฟฟ้าของโรงไฟฟ้าพลังความร้อนร่วม

1.5 ขั้นตอนการดำเนินงานวิจัย

1. ศึกษาและการวิเคราะห์ผลกระทบและปัจจัยที่ส่งผลต่อการสิ้นเปลืองการใช้พลังงาน ในการที่จะทำการศึกษาการประหยัดพลังงาน
2. ทำการการคัดเลือกปัจจัยที่ส่งผลต่อการสิ้นเปลืองการใช้พลังงาน เพื่อทำการศึกษาการประหยัดพลังงาน
3. ทบทวนด้านเอกสาร (Desktop Review) ดำเนินการจัดทำแผนงานการรวบรวมเอกสารที่เกี่ยวข้องเพื่อนำมาใช้ในการตัดสินใจเลือกหาแนวทางการอนุรักษ์พลังงานไฟฟ้า ทำการประเมินความเสี่ยงต่างๆ ก่อนและหลังทำการทดสอบปรับปรุง รวบรวมเงื่อนไขต่างๆไม่ว่าจะเป็นค่าพิกัดต่างๆ เช่น หน่วยกำลังไฟฟ้าและค่ากระแสไฟฟ้าของมอเตอร์เครื่องอัดและเพิ่มแรงดันก๊าซ แรงดันและอัตราการไหลของก๊าซธรรมชาติ กำลังการผลิตของเครื่องกังหันก๊าซ อัตราการสิ้นเปลืองการใช้เชื้อเพลิงก่อนและหลังทำการทดสอบปรับปรุง
4. ศึกษาด้านวิศวกรรมการประเมินของระบบ (Engineering Assessment of System) เพื่อนำมาประยุกต์ใช้ในงานปรับตั้งค่าแรงดันที่หาค่าแล้วควบคุมความดันก๊าซ ที่สถานีควบคุมความดันและวัดปริมาตรก๊าซธรรมชาติ ปตท. ในเขตพื้นที่โรงไฟฟ้าอ่างทอง เพาเวอร์ เพื่อให้ได้มาซึ่งอุปกรณ์และหลักการทางวิศวกรรมที่เหมาะสมสูงสุดกับการเดินเครื่องผลิตไฟฟ้าของโรงไฟฟ้าอ่างทอง เพาเวอร์
5. ทำการทดสอบและเก็บบันทึกข้อมูลจากหน้างาน (Site Based Inspection and Record Parameter) ทำการเก็บบันทึกข้อมูลที่จำเป็นเพื่อการประมวลผลหาประสิทธิภาพการทำงานของ ชุดวาล์วควบคุมความดันก๊าซและเครื่องกังหันก๊าซและเครื่องอัดและเพิ่มความดันของก๊าซธรรมชาติ และประสิทธิภาพที่จะสามารถประหยัดพลังงานไฟฟ้าได้

6. กำหนดและวางแผนสำหรับเวลางานปรับตั้งค่าแรงดันที่ชุดควาล์วควบคุมความดันก๊าซ ที่สถานีควบคุมความดันและวัดปริมาณก๊าซธรรมชาติ ปตท. ในเขตพื้นที่โรงไฟฟ้าอ่างทอง เพาเวอร์ และการเดินเครื่องโรงไฟฟ้ากังหันก๊าซโดยไม่ใช้ชุดเครื่องอัดและเพิ่มความดันก๊าซธรรมชาติ

7. ทำการสรุปผลจากการทดสอบและจัดทำรายงาน (Executive Summary Report) หลังจากที่ได้ทำการรวบรวมข้อมูล วิธีการและเครื่องมือ ทำการวางแผนและทำการตรวจสอบและทดสอบจากหน่วยงาน ทำการจดบันทึกผล รวบรวมข้อมูลต่างๆที่ดำเนินการไปแล้วนำมาจัดทำรายงานสรุปผลของโครงการ

ตารางที่ 1.2 แสดงแผนการศึกษาและวิจัยของโครงการ

กิจกรรม	ระยะเวลา (เดือน)											
	1	2	3	4	5	6	7	8	9	10	11	12
โครงการ การลดการใช้พลังงานในการเดินเครื่องโรงไฟฟ้าพลังความร้อนร่วมกรณีศึกษา โรงไฟฟ้า อ่างทอง เพาเวอร์												
1 การวิเคราะห์ผลกระทบและปัจจัยที่ส่งผลต่อการสิ้นเปลืองการใช้พลังงานในการที่จะทำการศึกษการประหยัดพลังงาน	●	●										
2 การคัดเลือกปัจจัยที่ส่งผลต่อการสิ้นเปลืองการใช้พลังงาน เพื่อทำการศึกษการประหยัดพลังงาน		●										
3 การรวบรวมข้อมูลและวิเคราะห์จากเอกสารและการเดินเครื่องของโรงไฟฟ้า			●									
4 ทบทวนเอกสารด้านวิศวกรรม				●								
5 ศึกษาด้านวิศวกรรมการประเมนของชุดเครื่องอัดและเพิ่มความดันของก๊าซธรรมชาติและชุดควาล์วควบคุมความดันก๊าซในการเครื่องกังหันก๊าซ					●							
6 ทำการทดสอบและเก็บรวบรวมบันทึกข้อมูลจากหน่วยงานก่อนการปรับตั้งค่าที่ชุดควาล์วควบคุมความดันก๊าซ ในการเดินเครื่องกังหันก๊าซและเก็บบันทึกข้อมูล					●	●						

บทที่ 2

แนวคิด ทฤษฎี และผลงานวิจัยที่เกี่ยวข้อง

2.1 บทนำ

แหล่งที่มาและคุณสมบัติของก๊าซธรรมชาติที่ขุดพบได้ในแอ่งใต้พื้นดินบนบกหรือในทะเล หรืออาจพบร่วมกับน้ำมันดิบ หรือ คอนเดนเสท(ผลิตภัณฑ์ของเหลวไฮโดรคาร์บอนที่กลั่นตัวจากก๊าซธรรมชาติ) โดยคาดว่าจะเป็แหล่งพลังงานหลัก ที่จะนำมาใช้ได้อีกประมาณ 65 ปี ข้างหน้า ปริมาณสำรองที่พิสูจน์แล้วทั่วโลกเมื่อปี พ.ศ. 2548 มีปริมาณ 6,348 ล้านล้านลูกบาศก์ฟุต โดยพบมากที่สุด ในรัสเซีย มีปริมาณ 1,688 ล้านล้านลูกบาศก์ฟุต รองลงมาคืออิหร่าน 944 ล้านล้านลูกบาศก์ฟุต และกาตาร์ 910 ล้านล้านลูกบาศก์ฟุต

ก๊าซธรรมชาติในประเทศไทย ประเทศไทยได้มีการสำรวจพบแหล่งก๊าซธรรมชาติ 2 แหล่ง คือ ในทะเลบริเวณอ่าวไทย และบนบก อำเภอ น้ำพอง จังหวัดขอนแก่น ซึ่งนำขึ้นมาใช้ตั้งแต่ปี พ.ศ.2524 โดยการนำมาใช้เป็นเชื้อเพลิงในการผลิตกระแสไฟฟ้าและในโรงงานอุตสาหกรรม เพื่อทดแทนการใช้ถ่านหินและน้ำมันเตาซึ่งมีราคาสูงและต้องนำเข้าจากต่างประเทศ ซึ่งแต่ละปีมีมูลค่ามหาศาล และขณะเดียวกันก็ต้องเผชิญความผันผวนของราคาน้ำมันตลาดโลกซึ่งเสี่ยงต่อความมั่นคงด้านพลังงาน

การนำก๊าซธรรมชาติจากอ่าวไทยขึ้นมาใช้ จึงเป็นการเปิดศักราชใหม่ของการพึ่งพาพลังงานที่มีอยู่ภายในประเทศของเราเองอย่างเป็นรูปธรรม และเนื่องด้วยก๊าซธรรมชาติเป็นเชื้อเพลิงที่สะอาด คุณภาพดีและราคาถูกกว่าเชื้อเพลิงชนิดอื่นๆ ทำให้ปริมาณการใช้ก๊าซธรรมชาติของไทยสูงขึ้นเรื่อย ๆ ทุกปี ผู้รับสัมปทานสำรวจและผลิตก๊าซจึงได้แสวงหาแหล่งก๊าซใหม่ๆ เพื่อนำก๊าซจากแหล่งที่มีอยู่ขึ้นมาใช้ให้ได้มากที่สุด ขณะเดียวกันหน่วยงานภาครัฐและเอกชน ได้พยายามนำก๊าซธรรมชาติมาใช้ให้ได้ประโยชน์สูงสุด นอกเหนือจากการนำไปเป็นเชื้อเพลิงในโรงไฟฟ้า โรงงานอุตสาหกรรมและยานพาหนะ โดยให้การสนับสนุนพิเศษในการนำก๊าซธรรมชาติ มาเป็นเชื้อเพลิงสำหรับยานยนต์ หรือที่เราเรียกว่าเอ็นจีวีนั่นเอง



ภาพที่ 2.1 แท่นขุดเจาะก๊าซธรรมชาติ กลางทะเลอ่าวไทย

ที่มา: บริษัท เซฟรอนประเทศไทยสำรวจและผลิต จำกัด

<http://www.thansettakij.com/content/50050>

ปัจจุบันประเทศไทยมีความต้องการในการใช้ไฟฟ้าในปริมาณที่สูงมากขึ้นทุกปี ซึ่งไฟฟ้าเป็นปัจจัยหลักที่ใช้ในการพัฒนาเศรษฐกิจและการเติบโตของประเทศ การทำให้โรงไฟฟ้าสามารถผลิตไฟฟ้าได้อย่างเต็มประสิทธิภาพจึงเป็นสิ่งจำเป็นที่ช่วยในการชะลอการสร้างโรงไฟฟ้าใหม่ซึ่งจะเห็นได้ว่าการสร้างโรงไฟฟ้าใหม่ในปัจจุบันนั้นค่อนข้างเป็นไปได้ยาก เนื่องจากต้องคำนึงถึงผลกระทบที่เกิดขึ้นต่อประชาชนและสิ่งแวดล้อมเป็นหลัก โรงไฟฟ้าที่มีผลกระทบต่อสิ่งแวดล้อมน้อยและมีการผลิตไฟฟ้าโดยส่วนมากในประเทศไทยมาจากโรงไฟฟ้าพลังงานความร้อนร่วม (Combined Cycle Power Plant) โดยกังหันก๊าซ (Gas Turbine) เป็นอุปกรณ์ที่สำคัญที่ส่งผลต่อกำลังการผลิตไฟฟ้า ซึ่งการทำให้กังหันก๊าซมีกำลังการผลิตอยู่ในเกณฑ์ปกติ จะทำให้โรงไฟฟ้ามีส่วนการใช้พลังงานสำหรับการผลิตไฟฟ้าเป็นปกติได้ และในส่วนของโรงไฟฟ้าอ่างทองแพเวอรั ก็เป็นโรงไฟฟ้าพลังงานความร้อนร่วม (Combined Cycle Power Plant) โดยกังหันก๊าซ (Gas Turbine) เช่นกัน และยังมี Helical Screw Gas Compressor ที่ใช้ในการอัดและเพิ่มความดันก๊าซเข้าสู่ Combustion Turbine ของ Gas Turbine ในการเพิ่มประสิทธิภาพในการอัดและเพิ่ม

ความดันก๊าซเข้าสู่ Combustion Turbine ของ Gas Turbine นั้น ซึ่งเป็นอุปกรณ์หลักที่สำคัญในการเดินเครื่องโรงไฟฟ้า อ่างทองเพาเวอร์ เพราะกักกันก๊าซที่โรงไฟฟ้า อ่างทองเพาเวอร์ ใช้ของบริษัท SIEMENS รุ่น SGT-800 ซึ่งถูกออกแบบมาให้อนุญาตรับความดันก๊าซที่ 27-30 Bar(a) ระบบเครื่องอัดและเพิ่มความดันก๊าซธรรมชาติ มีหน้าที่หลักคือ เพื่ออัดและเพิ่มความดันของก๊าซธรรมชาติ โดยรับแรงดันก๊าซธรรมชาติที่สถานีควบคุมความดันและวัดปริมาตรก๊าซธรรมชาติจาก ปตท. ในเขตพื้นที่โรงไฟฟ้าอ่างทอง เพาเวอร์ ที่แรงดันต้นทาง (Upstream) 52 Bar(a) และผ่านมายังชุดวาล์วควบคุมความดันก๊าซธรรมชาติ ปรับลดแรงดันลง (Downstream) 20 Bar(a) และก๊าซธรรมชาติที่รับมาจากสถานีฯ จะเข้าสู่ชุดเครื่องอัดและเพิ่มความดันของก๊าซธรรมชาติ (Gas Compressor System) ที่ต้องใช้กำลังไฟฟ้าในการขับเคลื่อนที่ประมาณ 1,200 kW หรือ 1.2 MW ซึ่งเป็นต้นทุนกำลังในการเดินเครื่องอัดและเพิ่มความดันของก๊าซธรรมชาติ โดยจะเพิ่มแรงดันของก๊าซธรรมชาติไปที่ประมาณ 30 Bar(a) เพื่อเข้าสู่กระบวนการเผาไหม้ในห้องเผาไหม้ของเครื่องกังหันก๊าซ ซึ่งที่แรงดันดังกล่าวนี้เป็นค่าแรงดันที่ยอมรับได้ สามารถเข้าสู่ห้องเผาไหม้ของเครื่องกังหันก๊าซ ตามที่ผู้ออกแบบ (SIEMENS SGT-800) ได้ออกแบบไว้ คือ 27-30 Bar(a) เป็นแรงดันที่เครื่องกังหันก๊าซของ SIEMENS SGT-800 ถูกออกแบบมาให้ใช้แรงดันดังกล่าว ซึ่งแรงดันจากสถานีควบคุมความดันและวัดปริมาตรก๊าซธรรมชาติจาก ปตท. ในเขตพื้นที่โรงไฟฟ้าอ่างทอง เพาเวอร์ มีค่าที่ต่ำกว่าค่าการออกแบบของ SIEMENS SGT-800 จึงไม่สามารถอนุญาตให้เข้าสู่กระบวนการเผาไหม้ในห้องเผาไหม้ของเครื่องกังหันก๊าซของ SIEMENS SGT-800 ได้โดยตรง จึงเป็นที่มาของการติดตั้งชุดเครื่องอัดและเพิ่มความดันก๊าซธรรมชาติ และจากข้อมูลดังกล่าวมานั้น จึงมีแนวคิดที่จะไม่ใช้เครื่องอัดและเพิ่มความดันก๊าซธรรมชาติ เพื่อลดการใช้พลังงานไฟฟ้าที่ใช้ขับเคลื่อนของชุดเครื่องอัดและเพิ่มความดันก๊าซธรรมชาติ โดยที่มีทางเลือกคือ จะปรับตั้งสปริงของชุดค่าแรงดันที่ชุดวาล์วควบคุมความดันก๊าซธรรมชาติ (Downstream) ที่สถานีควบคุมความดันและวัดปริมาตรก๊าซธรรมชาติจาก ปตท. ในเขตพื้นที่โรงไฟฟ้าอ่างทอง เพาเวอร์ โดยจะปรับตั้งค่าความดันที่ชุดวาล์วควบคุมความดันก๊าซธรรมชาติ (Downstream) ให้ได้ที่แรงดัน 30 Bar(a) เพื่อให้ก๊าซธรรมชาติสามารถผ่านเข้าสู่ห้องเผาไหม้ของเครื่องกังหันก๊าซได้โดยตรง โดยที่ไม่ต้องผ่านเข้าไปยังชุดเครื่องอัดและเพิ่มความดันก๊าซธรรมชาติ (Gas Compressor System) ซึ่งแนวคิดนี้เป็นแนวคิดที่สามารถอนุรักษ์และลดการใช้พลังงานไฟฟ้าที่ใช้ขับเคลื่อนของชุดเครื่องอัดและเพิ่มความดันก๊าซธรรมชาติ (Gas Compressor System) ในโรงไฟฟ้าพลังความร้อนร่วมของโรงไฟฟ้า อ่างทองเพาเวอร์ ได้ถึงประมาณ 1,200 kW หรือ 1.2 MW ต่อชั่วโมง หรือประมาณ 28,800 kWh ต่อวัน

Gas Compressor คืออะไร Gas Compressor คือ อุปกรณ์ที่ใช้ในการเพิ่มความดันของก๊าซ (Static pressure) ให้สูงขึ้น แบ่งเป็น 4 ชนิด คือ 1. Axial Gas Compressors, 2. Centrifugal

Gas Compressors, 3. Helical Screw Gas Compressors และ 4. Reciprocating Gas Compressors ดังแสดงรายละเอียดต่างๆ ดังต่อไปนี้

2.2 การแบ่งประเภทของเครื่องอัดและการเพิ่มความดันของอากาศและก๊าซฯ

เครื่องอัดและการเพิ่มความดันของอากาศและก๊าซฯ สามารถแบ่งออกได้ 4 แบบ ดังนี้

2.2.1 เครื่องอัดและเพิ่มความดันแบบอัดในแนวแกน (Axial Gas Compressors)

แบบอัดในแนวแกน (Axial compressor) มีลักษณะคล้ายตัวกังหัน ประกอบด้วยใบพัดที่ติดอยู่บนเพลลาเป็นแถวๆ ระหว่างแถวของใบพัดจะมีใบพัดติดอยู่ที่ตัวเรือน สลับกันเป็นแถวๆ เช่นเดียวกัน เมื่ออากาศถูกดูดพร้อมกับอัดผ่านแต่ละแถวของใบพัดที่อยู่กับที่ และใช้ใบพัดหมุนที่ประกอบติดอยู่บนเพลลาแล้ว ปริมาณของมันจะลดลง ดังนั้นขนาดและความยาวของใบพัด ก็จะลดลงตามทิศทางการไหลของอากาศหรือก๊าซเป็นสัดส่วนเรื่อยไป




ภาพที่ 2.2 เครื่องอัดและเพิ่มความดันแบบอัดในแนวแกน Axial Compressor

ที่มา: <https://turbomachinery.man-es.com/products/compressors/axial>

2.2.2 เครื่องอัดและเพิ่มความดันแบบอัดหมุนเหวี่ยงหนีศูนย์กลาง (Centrifugal Gas Compressors)

แบบอัดหมุนเหวี่ยงหนีศูนย์กลาง (Centrifugal compressors) เป็นเครื่องอัดและเพิ่มความดันที่ใช้หลักการทางด้านพลศาสตร์ ทำงานด้วยการเปลี่ยนพลังงานจลน์เป็นความดัน ทิศทางการเคลื่อนที่ของอากาศหรือก๊าซอัดจะถูกเหวี่ยงตัวออกไปในแนวรัศมี อากาศหรือก๊าซจะถูกเข้าสู่แกน

ตรงกลางเพลาใบพัดและถูกเหวี่ยงตัวออกไปในแนวรัศมีของใบพัดสู่ผนังเครื่องอัดและเพิ่มความดัน และถูกส่งไปตามระบบท่อ อากาศหรือก๊าซอัดจะมีความกดดันสูงขึ้นแต่ความเร็วยังคงที่ เมื่อเราต้องการอากาศหรือก๊าซอัดที่มีค่าความกดดันสูงมากขึ้น เราสามารถกระทำได้โดยการใช้เครื่องอัดและเพิ่มความดันหลายสเตจ โดยที่อากาศหรือก๊าซอัดซึ่งได้จากการอัดในสเตจแรกจะถูกส่งต่อไปยังสเตจต่อไปและอัดอากาศหรือก๊าซให้เพิ่มความดันที่ต้องการ อากาศหรือก๊าซที่อัดได้ในแต่ละสเตจจะมีความร้อนสูงขึ้น ดังนั้นจึงต้องมีการระบายความร้อนออกจากอากาศหรือก๊าซอัดก่อนที่จะส่งอากาศหรือก๊าซอัดไปยังสเตจต่อไป

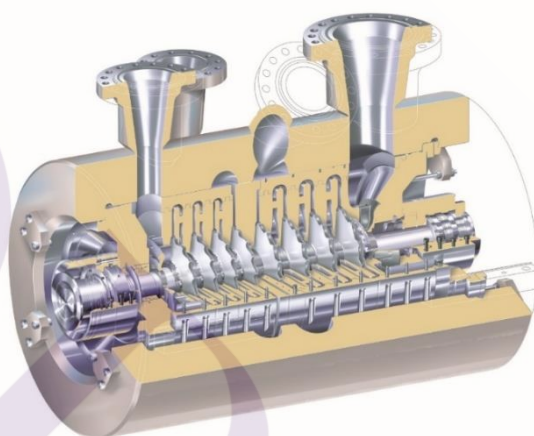


ภาพที่ 2.3 เครื่องอัดและเพิ่มความดันแบบอัดหมุนเหวี่ยงหนีศูนย์กลาง Centrifugal Compressor

ที่มา: <https://www.arab-oil-naturalgas.com/compressors-gas-turbine-videos/>

2.2.3 เครื่องอัดและเพิ่มความดันแบบสกรูอัดหมุน (Helical Screw Gas Compressors)

แบบสกรูอัดหมุน (Helical screw compressors) เครื่องอัดอากาศหรือก๊าซแบบสกรูจะอัดและเพิ่มความดันอันเป็นผลมาจากการเคลื่อนที่ผลัดกันของโรเตอร์ในลักษณะการแทนที่ของอากาศหรือก๊าซ อากาศหรือก๊าซอัดที่ได้จะมีอัตราการไหลอย่างสม่ำเสมอแต่ปริมาณอากาศหรือก๊าซอัดที่ได้จะมีค่าความกดดันค่อนข้างต่ำกว่ามาก การหมุนของโรเตอร์เพื่ออัดอากาศหรือก๊าซจะต้องหมุนด้วยความเร็วรอบที่สูง ซึ่งจะก่อให้เกิดเสียงดังและชิ้นส่วนที่เคลื่อนที่ภายในจะมีอัตราการสึกหรอค่อนข้างสูง เครื่องอัดอากาศหรือก๊าซประเภทนี้หรือสกรูคอมเพรสเซอร์แบ่งออกเป็น ลักษณะย่อยๆจะมีอยู่ 2 ชนิด คือ Twin-screw compressor และ Single-screw compressor ดังนี้


2.2.3.1 Twin-screw compressor จะประกอบด้วยเกลียวพินเฉียง (helical screw) 2 ตัว คือ เกลียวตัวเมีย (female) และเกลียวตัวผู้ (male) โดยเกลียวตัวผู้จะทำหน้าที่เป็นเกลียวขับ โดยเกลียวตัวผู้จะมีลักษณะเป็น lobe ส่วนเกลียวตัวเมียมีลักษณะเป็น gully

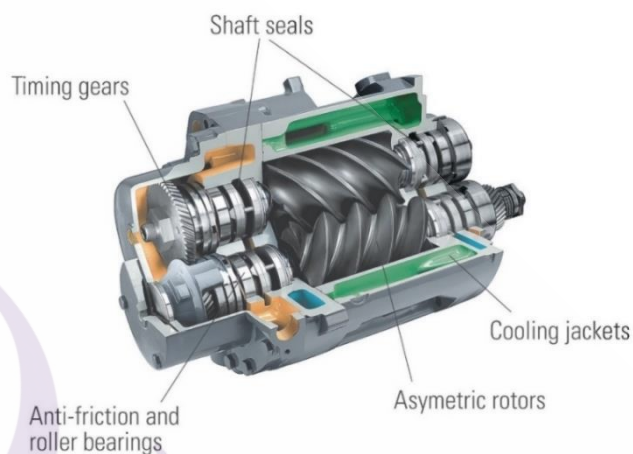

ภาพที่ 2.4 เครื่องอัดและเพิ่มความดันแบบสกรูอัดหมุนแบบชนิด Twin screw compressor

ที่มา: <https://www.nrcan.gc.ca/energy/products/reference/14970>

2.2.3.2 Single screw compressor ประกอบด้วยเกลียวเอียงหนึ่งตัวและเฟืองดาวเคราะห์อีกสองตัว สกรูเดี่ยวถูกขับเคลื่อนโดยมอเตอร์ไฟฟ้า การทำความเย็นของคอมเพรสเซอร์ทำได้โดยการฉีดน้ำมันหล่อลื่นเข้าคอมเพรสเซอร์ จำเป็นต้องมีตัวแยกน้ำมันและปั๊มหมุนเวียนน้ำมันหล่อลื่น

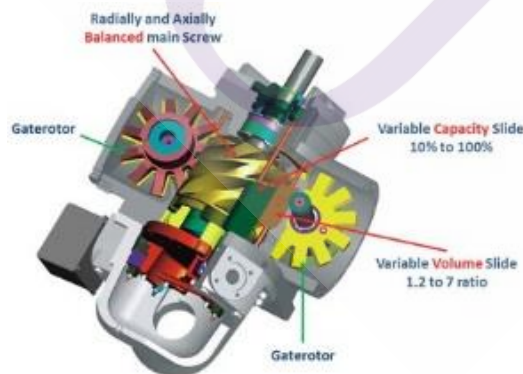


ภาพที่ 2.5 เครื่องอัดและเพิ่มความดันแบบสกรูอัดหมุนแบบชนิด Single screw compressor

ที่มา: <https://tallahasseescene.com/2017/09/single-screw-compressor-market-2017-by-types-stationary-and-portable/>

2.2.3.3 เครื่องอัดและเพิ่มความดันแบบลูกสูบ (Reciprocating Gas Compressors)

แบบลูกสูบ (Reciprocating Compressors) เครื่องอัดอากาศหรือก๊าซประเภทนี้ ส่วนใหญ่จะมีขนาดเล็กใช้แหล่งกำลังงานต้นกำลังจากมอเตอร์หรือเครื่องยนต์ ขนาดเล็ก โดยมีสายพานเป็นอุปกรณ์ถ่ายทอดกำลังงานไปสู่เครื่องอัดอากาศหรือก๊าซ เพื่อให้ลูกสูบเคลื่อนที่อัดอากาศหรือก๊าซให้มีปริมาตรเล็กลง และความกดดันของอากาศหรือก๊าซสูงขึ้น อากาศหรือก๊าซอัดจะถูกส่งไปเก็บไว้ในถังลมก่อนที่จะนำไปใช้งาน การเลือกใช้แบบต่างๆ นั้น มีทั้งแบบ Single Stage และแบบ Two Stage นิยมใช้ในกรณีที่ไม่ต้องการอากาศหรือก๊าซอัดปริมาณมากแต่ต้องการความดันสูง

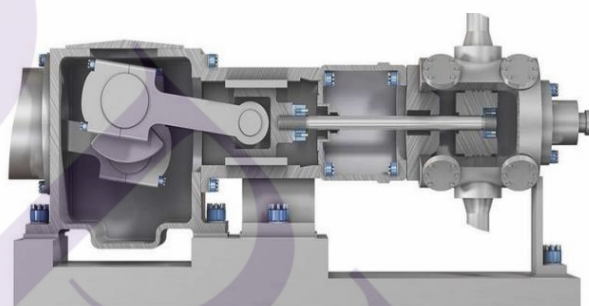

ภาพที่ 2.6 เครื่องอัดและเพิ่มความดันแบบลูกสูบ Reciprocating Compressors

ที่มา: <http://aermech.com/reciprocating-compressors-and-typesworking-principleengineering-explained/>


2.3 กังหันก๊าซ (Gas turbine)

การทำงานของเครื่องกังหันก๊าซ คล้ายกับกังหันไอน้ำ โดยกังหันไอน้ำจะใช้พลังงานจากไอน้ำเป็นตัวขับเคลื่อน แล้วเปลี่ยนเป็นพลังงานกลขณะที่ไอน้ำวิ่งผ่านใบพัด พร้อมกับขยายตัวเป็นช่วง ๆ จนเข้าสู่เครื่องควบแน่น (Condenser) ส่วนกังหันก๊าซนั้นตัวที่ขับเคลื่อนจะเป็นก๊าซร้อนที่เกิดจากการเผาไหม้ของเชื้อเพลิงภายในห้องเผาไหม้ แล้วส่งเข้าตัวกังหัน

การทำงานของเครื่องกังหันก๊าซ โดยมีเครื่องอัดอากาศ (compressor) ต่ออยู่บนเพลาดียวกับชุดกังหัน และต่อตรงไปยังเครื่องกำเนิดไฟฟ้า เมื่อเริ่มเดินเครื่อง อากาศจะถูกดูดจาก


ภายนอกเข้าหาเครื่องอัดอากาศทางด้านล่าง ถูกอัดจนมีความดันและอุณหภูมิสูงขึ้น แล้วถูกส่งไปยังห้องเผาไหม้ ซึ่งใช้เชื้อเพลิงเป็นก๊าซธรรมชาติหรือน้ำมัน จะถูกเผาไหม้และให้ความร้อนแก่อากาศ ก๊าซร้อนที่ออกจากห้องเผาไหม้ จะถูกส่งไปยังตัวกังหัน ทำให้กังหันหมุนเกิดงานขึ้น ไปขับเครื่องอัดอากาศและขณะเดียวกันก็ขับเครื่องกำเนิดไฟฟ้าด้วย ความดันของก๊าซเมื่อผ่านตัวกังหันจะลดลง และผ่านออกมาที่บรรยากาศ

ปกติห้องเผาไหม้จะสร้างด้วยโลหะทนความร้อนสูง แต่เนื่องจากอุณหภูมิของก๊าซร้อนที่เข้าไปขับตัวกังหันมีขีดจำกัด ดังนั้นอากาศประมาณ 1/6 ของอากาศอัดทั้งหมด จะถูกใช้ในห้องเผาไหม้ส่วนที่เหลือ ก็จะทำหน้าที่ผสมกับก๊าซร้อน แล้วจึงนำไปยังเรือนกังหัน อุณหภูมิของเปลวไฟในห้องเผาไหม้อยู่ระหว่าง 3,000 – 4,000 องศาฟาเรนไฮต์ แต่ก๊าซร้อนมีอุณหภูมิประมาณ 1,000 – 1,500 องศาฟาเรนไฮต์ ก่อนเข้าสู่เรือนกังหัน เพื่อขับกังหันต่อไป พลังงานที่ผลิตจากเครื่องกังหันก๊าซ จะนำไปขับเครื่องอัดอากาศประมาณ 60% ส่วนที่เหลือจะนำไปขับเครื่องกำเนิดไฟฟ้า และอุปกรณ์ประกอบช่วยงานอย่างอื่น

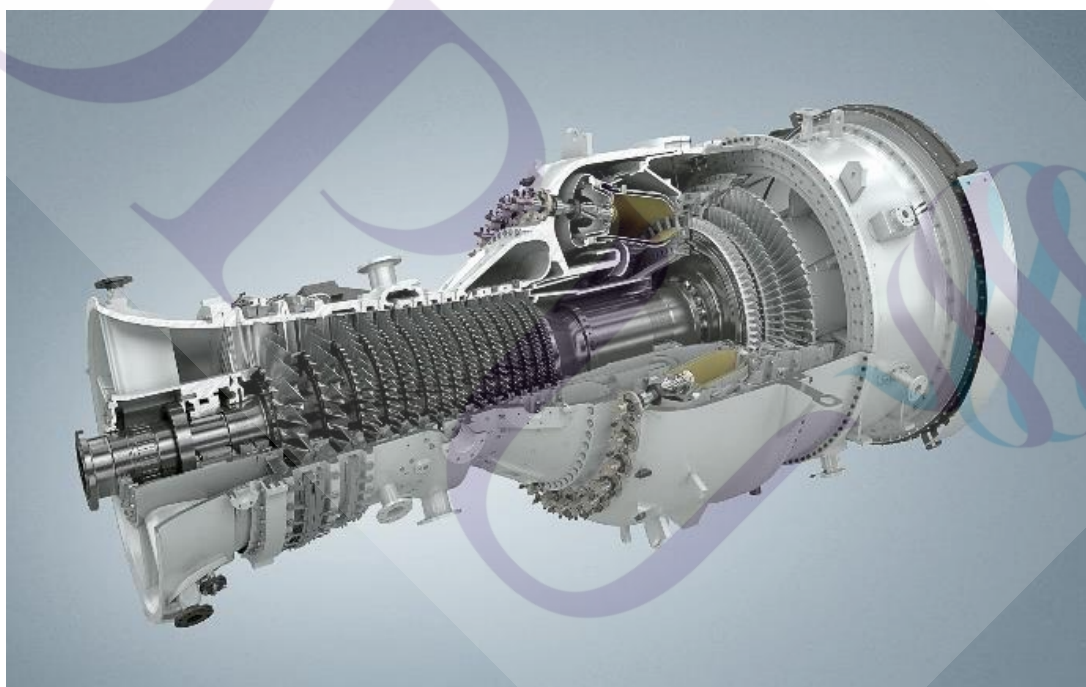

ภาพที่ 2.7 กังหันก๊าซ

ที่มา: Siemens Industrial Turbomachinery AB Training Department E S SO MGT FS4 S-612 83
FINSPONG SWEDEN

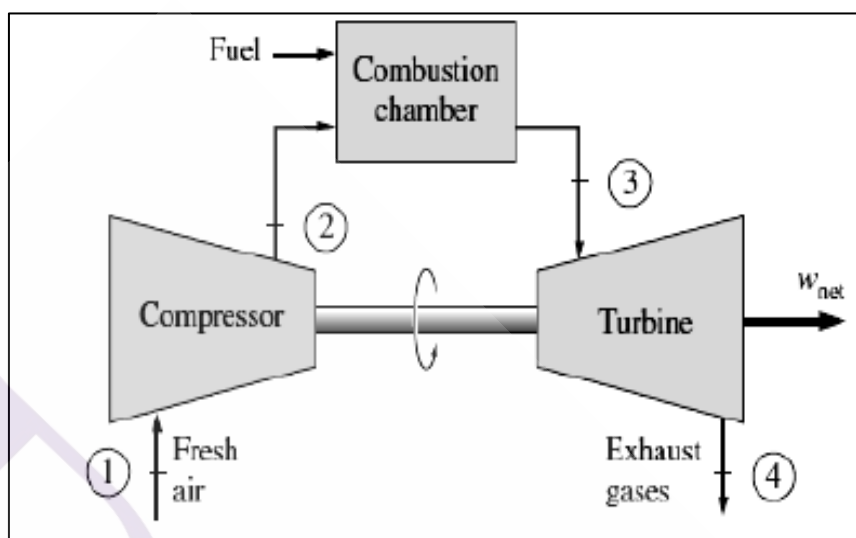


ภาพที่ 2.8 กังหันก๊าซแบบวัฏจักรเปิด

ที่มา: Siemens Industrial Turbomachinery AB Training Department E S SO MGT FS4 S-612 83
FINSPONG SWEDEN

กังหันก๊าซ (Gas turbine) เป็นเครื่องยนต์สันดาปภายใน โดยก๊าซร้อนที่เกิดจากการเผาไหม้จะขยายตัวขับใบพัดของกังหันก๊าซ เป็นการแปลงผันพลังงานความร้อนจำนวนหนึ่งของก๊าซไปเป็นพลังงานกลโดยการหมุนเพลามีส่วนประกอบหลัก ๆ คือ

- คอมเพรสเซอร์ (Compressor) ทำหน้าที่ดูดอากาศจากภายนอกที่สภาวะ 1 และอัดอากาศที่ไหลเข้ามาด้วยใบพัด (Compressor blades) ทำให้อากาศมีความดันและอุณหภูมิสูงที่สภาวะ 2 จากนั้นอากาศอัดจะถูกส่งเข้าสู่ห้องเผาไหม้ ดังภาพที่ 2.8
- ห้องเผาไหม้ (Combustion chamber) ทำหน้าที่เผาไหม้อากาศอัดความดันสูงที่ผสมกับเชื้อเพลิงภายใต้ความดันคงที่ จะได้ก๊าซร้อนที่มีอุณหภูมิและความดันสูงที่สภาวะ 3 ส่งไปยังส่วนของกังหันต่อไป ดังภาพที่ 2.8
- กังหัน (Turbine) ทำหน้าที่แปลงผันพลังงานความร้อนส่วนหนึ่งจากก๊าซร้อนที่ขยายตัวซึ่งได้จากห้องเผาไหม้ไปเป็นพลังงานกลโดยการหมุนผ่านชุดใบพัด (Turbine blades) ส่วนไอเสียที่ออกจากกังหันที่สภาวะ 4 จะนำทิ้งออกสู่บรรยากาศถ้าไม่นำมาใช้ประโยชน์อีกต่อไป ดังภาพที่ 2.8

การทำงานของกังหันก๊าซสามารถอธิบายจากวัฏจักรเบรย์ตัน (Brayton Cycle : Ideal Cycle for Gas Turbine Engine)

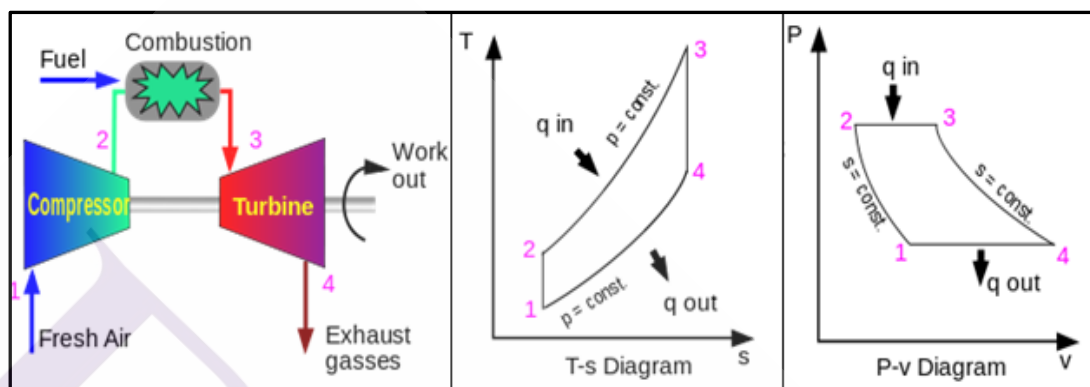

ภาพที่ 2.9 กระบวนการต่างๆในวัฏจักรเบรย์ตัน (Brayton Cycle)

ที่มา: Siemens Industrial Turbomachinery AB Training Department E S SO MGT FS4 S-612 83
FINSPONG SWEDEN

ในวัฏจักรเบรย์ตันมี มาตรฐานอากาศประกอบด้วยกระบวนการย้อนกลับดังนี้

- กระบวนการ 1-2 คือ กระบวนการอัดตัวแบบไอเซนโทรปิก (คอมเพรสเซอร์)
- กระบวนการ 2-3 คือ กระบวนการรับความร้อนภายใต้ความดันคงที่ (ห้องเผาไหม้)
- กระบวนการ 3-4 คือ กระบวนการขยายตัวแบบไอเซนโทรปิก (กังหันก๊าซ)
- กระบวนการ 4-1 คือ กระบวนการถ่ายความร้อนทิ้งภายใต้ความดันคงที่ (การขับไล่ก๊าซไอเสีย)


รูปแบบของระบบผลิตไฟฟ้าและความร้อนร่วมที่กล่าวมาจะมีความแตกต่างและเหมือนกันในเรื่องของอุปกรณ์หลายประการ ซึ่งตารางที่ 1 จะแสดงถึงการเปรียบเทียบพารามิเตอร์ต่างๆ บางประการของรูปแบบของระบบผลิตไฟฟ้าและความร้อนร่วม 3 ระบบคือ กังหันไอน้ำ กังหันแก๊ส และเครื่องยนต์สันดาปภายใน

ตารางที่ 2.1 Parameter of Cogeneration System

รายละเอียด	Back Pressure Steam turbine	กังหันแก๊ส	เครื่องยนต์สันดาป ภายใน
ขนาดของระบบ	500 kW – 15MW	500 kW – 100MW	15 kW – 10MW
ประสิทธิภาพรวม	สูงสุด 80% (ขึ้นอยู่กับ Boiler)	55-75%	50-80%
H/P	5-20	2-5	1-3
ความร้อนที่ออก จากระบบ	ไอน้ำอุณหภูมิสูงถึง 150 °C	แก๊สร้อนอุณหภูมิ 450-550 °C	50% น้ำร้อนและ 50% แก๊สร้อน 450 °C
เชื้อเพลิงที่ใช้	ใช้เชื้อเพลิงได้หลายชนิด	แก๊ส,ดีเซลหรือเชื้อเพลิง เหลวขึ้นอยู่กับขนาด	แก๊สหรือเชื้อเพลิง เหลว

2.4 SIEMENS SGT-800 กังหันก๊าซ (Gas turbine)

หลักการการทำงานของกังหันก๊าซ (Gas Turbine Principles) และส่วนประกอบหลักที่สำคัญต่างๆ ดังนี้

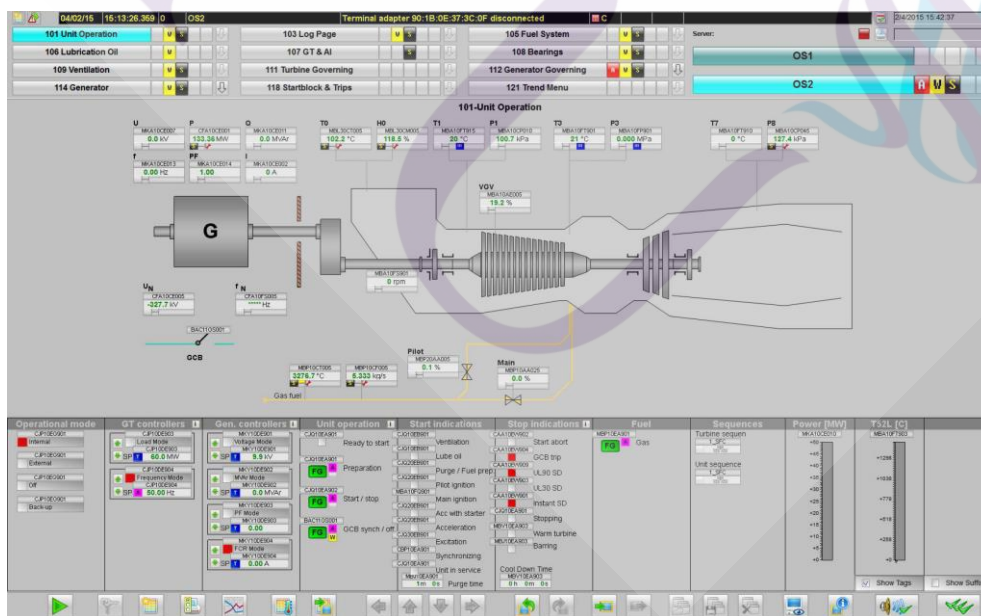

ภาพที่ 2.10 แสดงหน้าจอ SIMATIC HMI PSC7 for SIEMENS SGT-800

ที่มา: Siemens Industrial Turbomachinery AB Training Department E S SO MGT FS4 S-612 83
FINSPONG SWEDEN

เทคโนโลยีกังหันก๊าซหรือเครื่องกำเนิดไฟฟ้านั้นเป็นส่วนประกอบที่สำคัญในการผลิตไฟฟ้าประเภทพลังงานความร้อนร่วม (Combined Cycle Cogeneration Plants : CCCP) โดยเทคโนโลยีกังหันก๊าซนั้นมีหลายรุ่น ขึ้นอยู่กับขนาดกำลังการผลิตและความเหมาะสมของโรงไฟฟ้านั้นๆ ในส่วนกังหันก๊าซของซีเมนส์ สำหรับอุตสาหกรรมรุ่น SGT-800 นั้นเป็นอีกเทคโนโลยีหนึ่งของกังหันก๊าซสำหรับผลิตกระแสไฟฟ้าเพื่อให้เกิดประสิทธิภาพในการผลิตไฟฟ้าและประหยัดพลังงาน


เครื่องกังหันก๊าซซีเมนส์รุ่น SGT- 800 ถูกออกแบบให้มีความทนทาน มีประสิทธิภาพและมีการปล่อยของเสียน้อยมากเมื่อเทียบกับกังหันชนิดอื่น เนื่องจากกังหันก๊าซรุ่น SGT-800 เป็นนวัตกรรมล่าสุดที่ใช้เทคโนโลยีการเผาไหม้แบบ Dry Low Emissions (DLE) ทำให้ลดการเกิดก๊าซไนโตรเจนได้อย่างมาก นอกจากนี้ เครื่อง ยังถูกออกแบบให้ใช้งานง่าย มีประสิทธิภาพและความทนทานสูง มีความยืดหยุ่นในการจ่ายน้ำมัน จึงเหมาะกับโรงงานอุตสาหกรรมหลายรูปแบบ เหมาะกับการจ่ายไฟในรูปแบบการผลิตไฟฟ้าพลังงานความร้อนร่วม (Co-generation) และการผลิตไฟฟ้าแบบ simple cycle ขนาดกำลังการผลิต 110-130 เมกะวัตต์

กังหันรุ่น SGT- 800 ยังถูกปรับปรุงและอัพเกรดให้มีกำลังไฟฟ้าเพิ่มอีก 3 เมกะวัตต์ เป็น 50.5 เมกะวัตต์ โดยการเพิ่มกำลังเครื่องอัดอากาศ (compressor) กังหันแบบ อากาศพลศาสตร์ (aerodynamics) และปรับตำแหน่งการวางเครื่องทำความเย็น (cooling air layout) ช่วยให้สามารถผลิตกำลังไฟฟ้าได้อย่างมีประสิทธิภาพ และลดการสิ้นเปลืองพลังงานเป็นอย่างดี จึงทำให้ลดต้นทุนต่อกิโลวัตต์-ชั่วโมงได้

นอกจากนี้กังหันก๊าซรุ่น SGT-800 ยังสามารถสร้างพลังงานได้จากเชื้อเพลิง 2 ประเภท ทั้งเชื้อเพลิงจาก ก๊าซธรรมชาติ และน้ำมันดีเซล หรือเรียกว่า bi-fuel หลักการทำงานคือ การอัดอากาศด้วย Compressor แล้วส่งไปยังห้องเผาไหม้ระบบ DLE (Dry Low Emission Combustion System) เพื่อควบคุมการเผาไหม้ให้สมบูรณ์ เทคโนโลยี DLE ของ Siemens ทำให้การเผาไหม้สมบูรณ์ส่งผลให้สามารถควบคุมมลภาวะให้อยู่ในเกณฑ์ต่ำที่ 43 ppm ต่ำกว่าค่ามาตรฐานกฎหมายกำหนดไว้ที่ 60 ppm.

ส่วนความร้อนจากห้องเผาไหม้ร่วมกับแรงอัดอากาศจาก compressor จะทำให้ Gas Turbine Blade หมุนเพลลาเครื่องปั่นไฟ (Generator) ด้วยความเร็วสูง เกิดการสร้างพลังงานและกระแสไฟฟ้ามาเข้าระบบ จากนั้นก๊าซร้อนจาก Gas Turbine จะถูกปล่อยออกมายังระบบอย่าง

ต่อเนื่อง ก๊าซร้อนจากการเผาไหม้สูงมากกว่า 500 องศาเซลเซียสสามารถนำไปใช้ประโยชน์ต่อได้ โดยการออกแบบระบบต่อเนื่องในการนำอากาศร้อนที่เหลือจาก Siemens Gas Turbine SGT-800 ไปผ่านระบบ Heat Recovery Steam Generator (HRSG) เพื่อผลิตไอน้ำเพื่อนำไปใช้ประโยชน์ในอุตสาหกรรมต่อไป

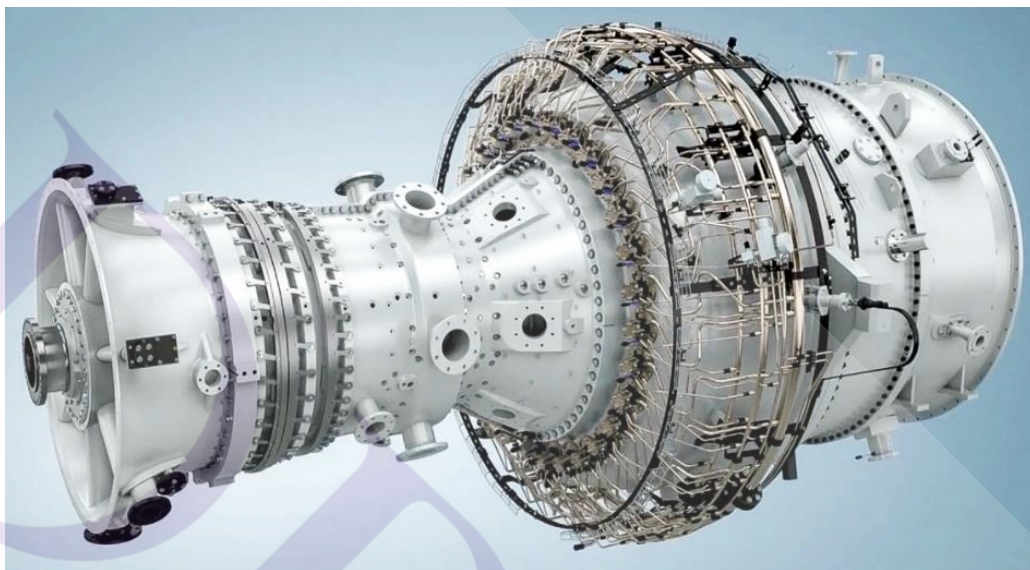

ภาพที่ 2.11 SIEMENS SGT-800


ที่มา: Siemens Industrial Turbomachinery AB Training Department E S SO MGT FS4 S-612 83
FINSPONG SWEDEN

Gas Turbine จัดเป็น Heat Engine ประเภทเครื่องสันดาปภายใน (Internal Combustion Engine) โดยพลังงานความร้อนที่เกิดจากการเผาไหม้ของเชื้อเพลิง จะถูกนำไปใช้งานโดยตรงโดยไม่ผ่านตัวกลาง หรืออีกนัยหนึ่งคือ แก๊สร้อน ที่เกิดจากการเผาไหม้จะทำหน้าที่เป็น Working Fluid นำพลังงานความร้อนไปถ่ายเทให้แก่ Turbine Rotating Blades ของเครื่อง Gas Turbine เพื่อเปลี่ยนพลังงานความร้อน เป็นพลังงานกลในรูปของการหมุนเพลต Gas Turbine โดยการทำงานในส่วนต่างๆของ Gas Turbine จะเกิดขึ้นพร้อมกันอย่างต่อเนื่องและสม่ำเสมอ (ดูด (Air Inlet), อัด (Compressor), ระเบิด (Combustor), คาย (Exhaust))

Gas Turbine ประกอบด้วยอุปกรณ์หลักอยู่ 3 ส่วน คือ

1. Compressor (เครื่องอัดอากาศ) จะทำหน้าที่ดูดอากาศจากบรรยากาศแล้วอัด เพื่อเพิ่มความดันให้สูงขึ้น (ขณะเดียวกันอุณหภูมิจะสูงขึ้นด้วย) แล้วส่งต่อไปเพื่อใช้ในการเผาไหม้ และการ cooling


➤ Compressor มีหลาย stages (Multiple stages) แต่ละ Stages ประกอบด้วย Rotor เรียกว่า Rotating blades และ Stator เรียกว่า Stationary guide vanes

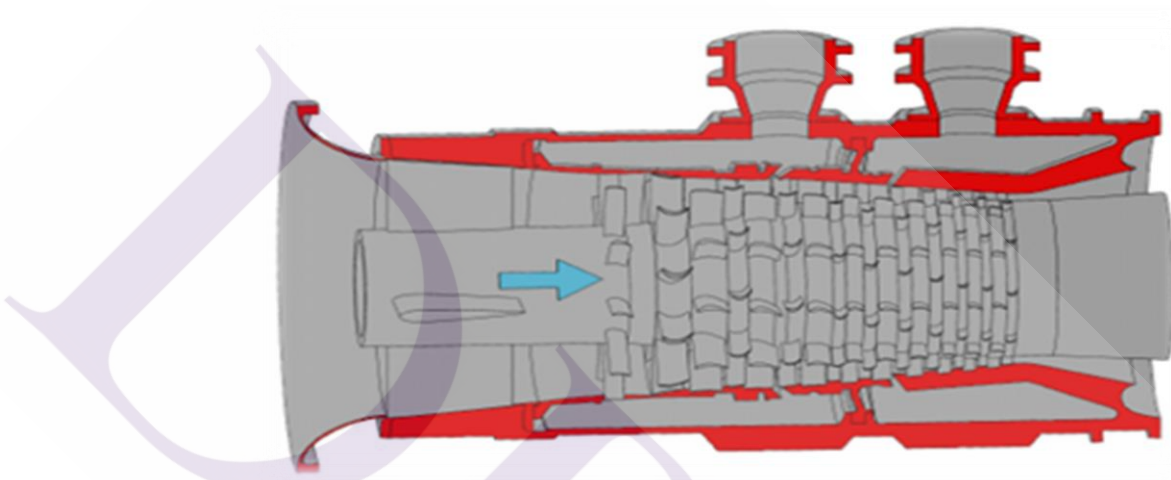

ภาพที่ 2.12 Gas Turbine Compressor (เครื่องอัดอากาศ)

ที่มา: Siemens Industrial Turbomachinery AB Training Department E S SO MGT FS4 S-612 83
FINSPONG SWEDEN



➤ อากาศที่ผ่าน Compressor บางส่วนถูกนำไปใช้เป็น Cooling & Sealing air

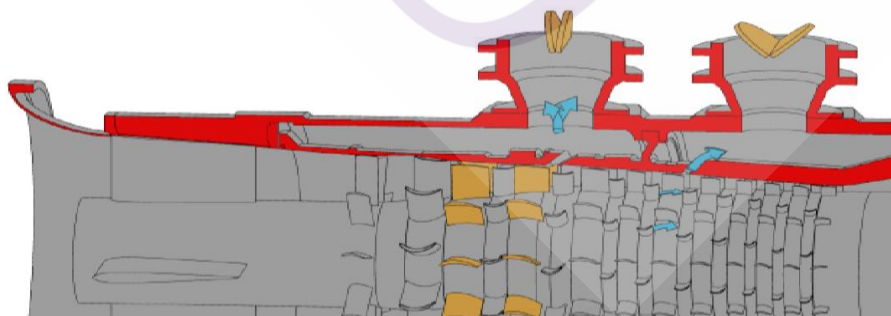

ภาพที่ 2.13 Sealing & Cooling air stage 3 & stage 5

ที่มา: Siemens Industrial Turbomachinery AB Training Department E S SO MGT FS4 S-612 83
FINSPONG SWEDEN


2. Combustion Chamber (ห้องเผาไหม้) เป็นส่วนที่เกิดการเผาไหม้ของอากาศที่ได้รับจาก Compressor ผสมกับเชื้อเพลิง ผลจากการเผาไหม้ในส่วนนี้จะได้ Exhaust gas (แก๊สร้อน) ที่มีอุณหภูมิและความดันสูง เพื่อส่งไปยัง Turbine blades ต่อไป

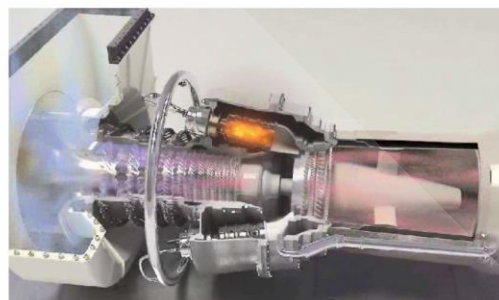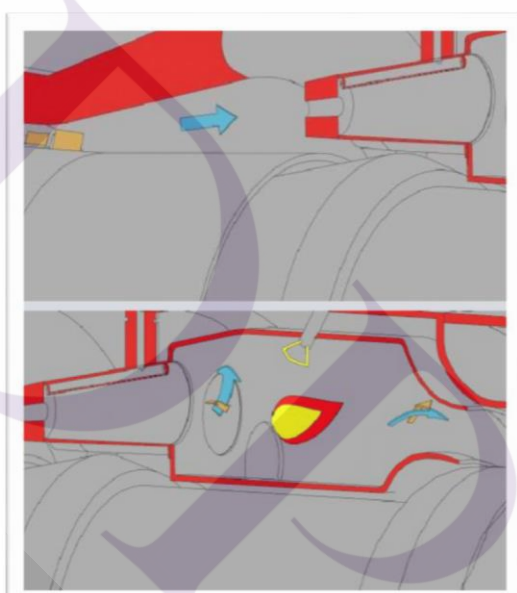

ภาพที่ 2.14 Gas Turbine Combustion Chamber


ที่มา: Siemens Industrial Turbomachinery AB Training Department E S SO MGT FS4 S-612 83
FINSPONG SWEDEN

3. Turbine (เครื่องกังหัน) เป็นส่วนที่ทำหน้าที่เปลี่ยนพลังงานความร้อนของแก๊สร้อนที่ได้จากการเผาไหม้ให้เป็นพลังงานกล โดยอาศัย Turbine blades เป็นตัวเปลี่ยนพลังงานกลที่ได้ส่วนหนึ่งจะนำไปใช้ในการขับเคลื่อน Compressor

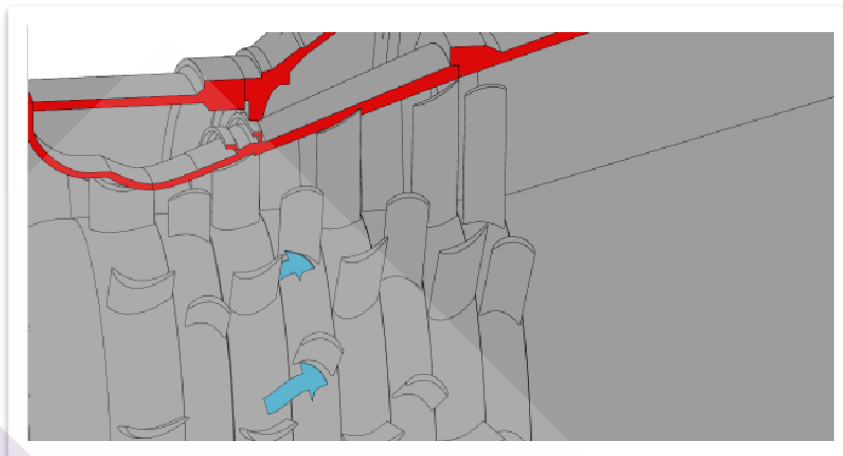

ภาพที่ 2.15 ภาพแสดง Turbine blades


ที่มา: Siemens Industrial Turbomachinery AB Training Department E S SO MGT FS4 S-612 83
FINSPONG SWEDEN

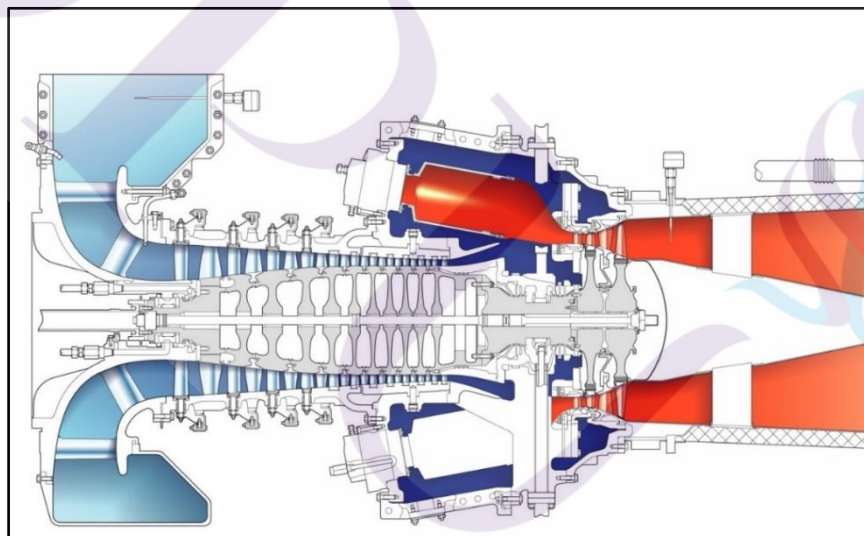

ภาพที่ 2.16 ภาพแสดงกระบวนการทำงานภายใน Gas Turbine

ที่มา: Siemens Industrial Turbomachinery AB Training Department E S SO MGT FS4 S-612 83
FINSPONG SWEDEN

Gas Turbine มีวงจรการทำงานโดยใช้หลักการของ Brayton Cycle ซึ่งเป็นชื่อของวิศวกรอเมริกัน ชื่อ George Brayton ซึ่งได้พยายามทำ Cycle นี้ไปใช้ใน Gas Engine เมื่อประมาณ พ.ศ.2413 วงจรการทำงานนี้เรียกอีกชื่อหนึ่งว่า Constant Pressure Cycle (ภาพที่ 2.17) โดยในช่วงของการเผาไหม้ใน Combustor และช่วงปล่อย Exhaust Gas ที่ผ่าน Turbine แล้วออกสู่บรรยากาศจะเป็นไปโดยอยู่ในสภาวะที่ความดันคงที่ (เนื่องจากการไหลของ Gas อย่างต่อเนื่อง)

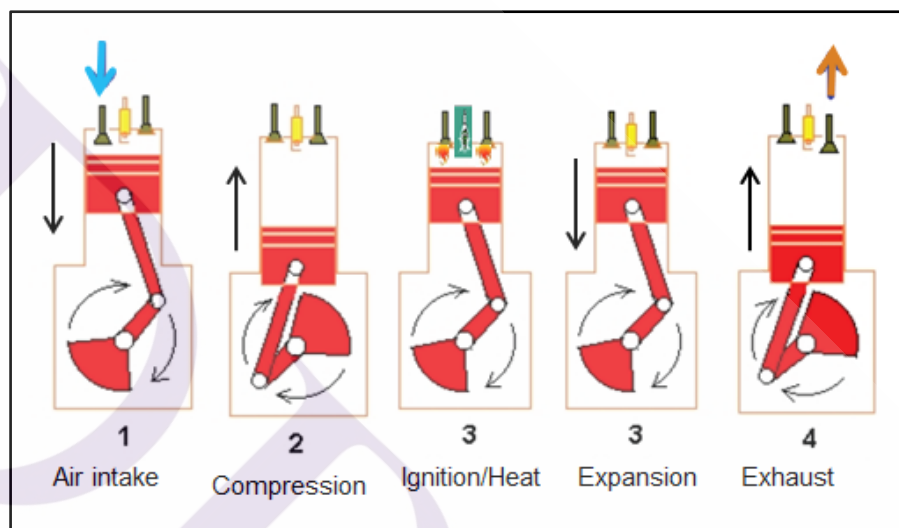

ภาพที่ 2.17 หลักการทำงานของ Brayton Cycle

ที่มา: Siemens Industrial Turbomachinery AB Training Department E S SO MGT FS4 S-612 83 FINSPONG SWEDEN

จากภาพที่ 2.17 เป็นวงจรการทำงานของ Gas Turbine ประกอบด้วยกระบวนการ 2 แบบ คือ Adiabatic Process (กระบวนการที่ไม่มีความร้อนเข้าหรือออกจากระบบ) , $s = \text{constant}$ และ Constant pressure process จากภาพที่ 2.17 สามารถอธิบายได้ดังนี้

Process 1-2 เป็นการทำงานของ Compressor อัดอากาศจากบรรยากาศ เพื่อส่งเข้ายัง Combustor โดยใช้ Adiabatic Process ($Pv^k = \text{Constant}$: $P_1v_1 = P_2v_2$)

ความดันจะเพิ่มขึ้นจาก	$P_1 \rightarrow P_2$	$(P_2 > P_1)$
อุณหภูมิจะเพิ่มขึ้นจาก	$T_1 \rightarrow T_2$	$(T_2 > T_1)$
ปริมาตรลดลงจาก	$v_1 \rightarrow v_2$	$(v_2 < v_1)$
Entropy คงที่เท่าเดิม	$s_1 = s_2$	

Process 2 - 3 เป็นการทำงานจากการเผาไหม้ของเชื้อเพลิงใน Combustor จะเพิ่มความร้อนในสภาวะความดันคงที่ (Constant Pressure Process), $P = \text{constant}$

ความดันคงที่เท่าเดิม	$P_2 = P_3$	
อุณหภูมิจะเพิ่มขึ้นจาก	$T_2 \rightarrow T_3$	$(T_3 > T_2)$
ปริมาตรเพิ่มขึ้นจาก	$v_2 \rightarrow v_3$	$(v_3 > v_2)$
Entropy เพิ่มขึ้นจาก	$s_2 \rightarrow s_3$	$(s_3 > s_2)$

Process 3 - 4 เป็นการขยายตัวของ hot gas ผ่าน turbine โดยใช้ Adiabatic Process

$(Pv^k = \text{Constant} : P_3v_3 = P_4v_4)$

ความดันจะลดลงจาก	$P_3 \rightarrow P_4$	$(P_4 < P_3)$
อุณหภูมิจะลดลงจาก	$T_3 \rightarrow T_4$	$(T_4 < T_3)$
ปริมาตรเพิ่มขึ้นจาก	$v_3 \rightarrow v_4$	$(v_3 > v_4)$
Entropy คงที่เท่าเดิม	$s_3 = s_4$	

Process 4 - 1 เป็นการคายความร้อนที่ผ่าน turbine ออกสู่ภายนอก ในสภาวะความดันคงที่ (Constant Pressure Process), $P = \text{constant}$


ความดันจะคงที่เท่าเดิม	$P_4 = P_1$	
อุณหภูมิจะลดลงจาก	$T_4 \rightarrow T_1$	$(T_1 < T_4)$
ปริมาตรลดลงจาก	$v_4 \rightarrow v_1$	$(v_1 < v_4)$
Entropy ลดลงจาก	$s_4 \rightarrow s_1$	$(s_1 < s_4)$

เปรียบเทียบกับ การเดินเครื่องของ Gas turbine เมื่อเริ่มเดินเครื่อง W_c หรือ กำลังงานที่ใช้ขับ compressor จะได้จาก Starting motor เพื่ออัดอากาศ จาก Process 1-2

ใน Process 2-3 Q_{in} หรือ พลังงานความร้อนที่เข้าหรือให้แก่ turbine จะได้จากการเผาไหม้ใน combustor ซึ่ง Q_{in} จะมากหรือน้อย แปรผัน ตามปริมาณเชื้อเพลิงที่จ่ายเข้าไปเพื่อการเผาไหม้ โดยปกติปริมาณของเชื้อเพลิงหรือ Q_{in} จะถูกจำกัดด้วย T_3 ซึ่ง จะสัมพันธ์กับความสามารถของ material ที่นำมาทำ turbine blade และกรรมวิธีว่าสามารถทนอุณหภูมิได้มากน้อยเท่าใด

Process 3-4 เป็น Process ที่ hot gas จากการเผาไหม้ ขยายตัวผ่าน turbine และ turbine จะเปลี่ยนพลังงานความร้อน (Q_{in}) ไปเป็นพลังงานกล (W_t : Work Turbine) ในรูปของการหมุนเพลานำไปขับอุปกรณ์อื่น เช่น generator, compressor และ auxiliary อื่นๆ ที่ต่ออยู่กับ turbine shaft และ W_c ที่เดิมได้จาก starting motor จะเปลี่ยนเป็นใช้จาก W_t ใน Process 4 ไป 1 พลังงานความร้อนส่วนที่เหลือจากการเปลี่ยนไปเป็น W_t ใน Process 3 - 4 จะถูกปล่อยสู่ภายนอก คือ Q_{out} ในภาพ

ที่ 2.18 การทำงานของ gas turbine จะเป็น cycle จาก Process 1 - 2 - 3 - 4 - 1 เป็นลำดับอย่างต่อเนื่องตลอดไป

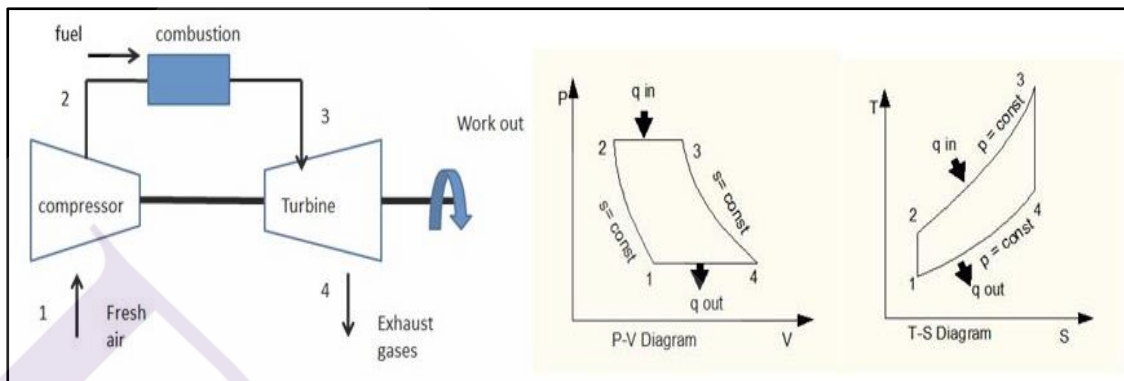

ภาพที่ 2.18 วัฏจักรการทำงานของ Gas Turbine

ที่มา: Siemens Industrial Turbomachinery AB Training Department E S SO MGT FS4 S-612 83
FINSPONG SWEDEN

จากจุดต่างๆ ของ Gas Turbine Cycle (Brayton Cycle) ดังภาพที่ 2.18 จุด 1, 2, 3 และ 4 เมื่อวิเคราะห์แล้วจะได้ค่าต่างๆ ซึ่งสามารถนำไปใช้งาน สรุปได้ดังนี้

ประสิทธิภาพทางความร้อน (Thermal Efficiency), η_{thermal} ของ Gas Turbine จะหาได้จาก

$$\eta_{\text{thermal}} = 1 - T_1/T_2 = 1 - T_4/T_3$$

ค่าทาง Performance อีกค่าหนึ่งที่น่าสนใจเมื่อก้าวถึงคุณสมบัติของ Gas Turbine คือค่า Heat Rate ซึ่งจะแสดงถึง อัตราส่วนของค่าความร้อนที่ใช้ในการผลิตพลังงานไฟฟ้าได้ 1 หน่วย (kWh) โดยมีหน่วยเป็น kcal/kWh หรือ BTU/kWh ซึ่งสามารถใช้พิจารณาคุณสมบัติของเครื่อง แทนค่าประสิทธิภาพได้และยังสะดวก ในการใช้หาค่าเชื้อเพลิงที่ใช้ในการผลิต การหาค่า Heat Rate สามารถหาได้จาก

Heat Rate = ปริมาณความร้อนที่ใช้ใน 1 ชั่วโมง/พลังงานไฟฟ้าที่ผลิตได้ใน
ช่วงเวลานั้น (kWh)

= ปริมาณเชื้อเพลิงที่ใช้ \times Heating Value/kWh ที่ได้ และสามารถ
หาค่า Thermal Efficiency ได้จากค่า Heat Rate ดังนี้

$$\begin{aligned} \text{Thermal Efficiency} &= [860/\text{Heat Rate (kcal/kWh)}] \times 100 \% \text{ หรือ} \\ &= [3,413/\text{Heat Rate (BTU/kWh)}] \times 100 \% \end{aligned}$$

Thermal Efficiency คือ อัตราส่วนของกำลังงานที่ได้รับ ต่อความร้อนที่ใส่เข้าไปซึ่งก็คือความร้อนที่เกิดจากการเผาไหม้เชื้อเพลิง (1 kWh = 859.84522785899 kcal) หรือ (1kWh = 3,412.969 BTU)

ประสิทธิภาพของกังหันก๊าซ (Gas Turbine Performance)

ปัจจัยที่มีผลต่อประสิทธิภาพของ Gas Turbine มีดังนี้

1. อุณหภูมิของอากาศที่เข้า Compressor หรือ Ambient temperature


ถ้าอุณหภูมิของอากาศที่เข้า Compressor เพิ่มขึ้น จะส่งผลให้

- กำลังการผลิตลดลง (ผลมาจาก Temperature control ของไหมคควบคุม)
- Heat rate เพิ่มขึ้น หรือ ประสิทธิภาพลดลง (ผลมาจาก Compressor Discharge

Pressure ลดลง)


- Heat consumption ลดลง เพราะใช้เชื้อเพลิงมากขึ้น (ผลมาจากประสิทธิภาพที่ลดลง)

- Exhaust flow (Mass flow) ลดลง (ผลมาจากความหนาแน่นของอากาศลดลง)

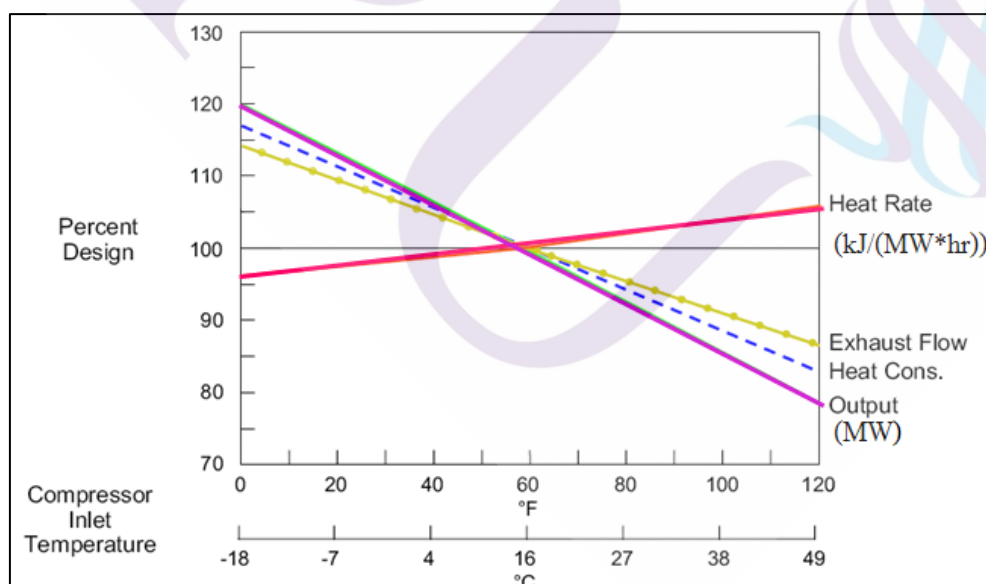


ภาพที่ 2.19 กราฟแสดงความสัมพันธ์อุณหภูมิของอากาศที่เข้า Compressor กับ Parameter ต่างๆ

ที่มา: Siemens Industrial Turbomachinery AB Training Department E S SO MGT FS4 S-612 83
FINSPONG SWEDEN

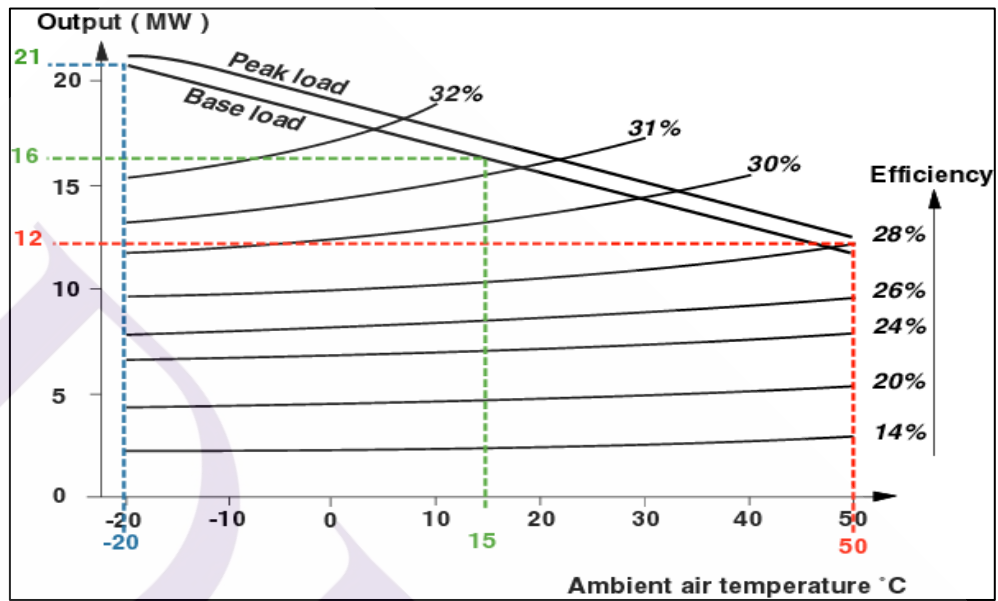

ภาพที่ 2.20 (ต่อ) กราฟแสดงความสัมพันธ์อุณหภูมิของอากาศที่เข้า Compressor กับ Parameter ต่างๆ

ที่มา: Siemens Industrial Turbomachinery AB Training Department E S SO MGT FS4 S-612 83
FINSPONG SWEDEN

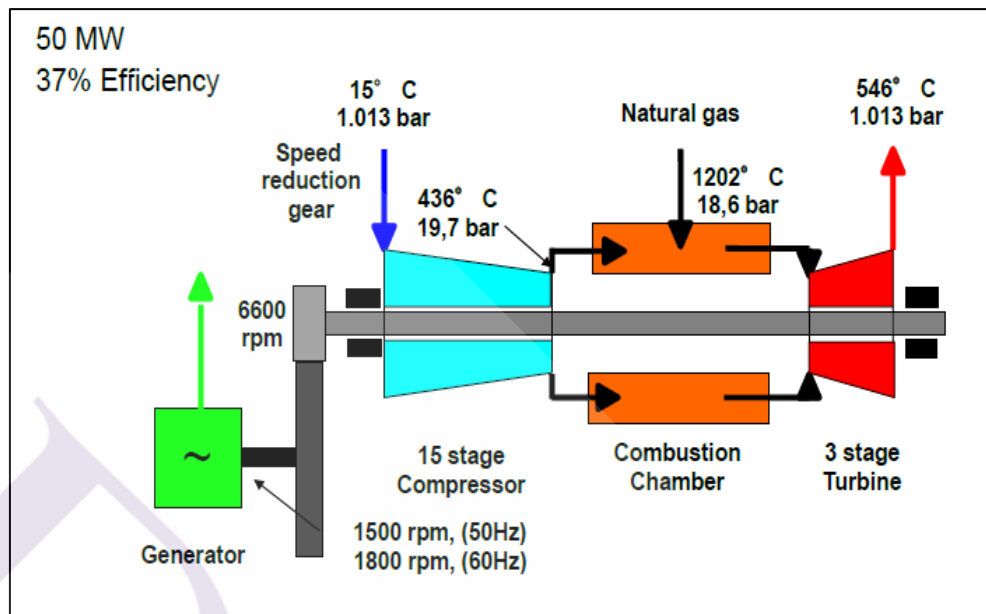

ภาพที่ 2.21 ฟังก์ชันการทำงาน Process Flow Diagram

ที่มา: Siemens Industrial Turbomachinery AB Training Department E S SO MGT FS4 S-612 83
FINSPONG SWEDEN

การเดินเครื่อง Gas Turbine ให้ได้ Output(MW) และ ประสิทธิภาพสูงสุด เรียกว่า Base load เป็นการควบคุม Turbine inlet temperature ที่สูงสุดให้คงที่ (ไม่เกิดการออกแบบขึ้นส่วนของ Hot Gas Path) แต่เนื่องจากไม่สามารถวัดค่า Turbine inlet temperature ได้ จึงต้องใช้ Turbine Exhaust Temperature เป็นค่าควบคุม เรียกกระบวนการควบคุมนี้ว่า Temperature Control

2. ความชื้น (Humidity)


ถ้าความชื้นของอากาศ เพิ่มขึ้น จะส่งผลดังต่อไปนี้

- Power Output หรือกำลังการผลิตไฟฟ้าที่ Base Load ลดลง (Correction factor น้อยกว่า 1)

หมายเหตุ Power output พิจารณากำลังการผลิตไฟฟ้าสูงสุด (พิจารณาที่ Temperature control)

- Heat rate เพิ่มขึ้น (ประสิทธิภาพลดลง)

หมายเหตุ Heat rate พิจารณา เชื้อเพลิงต่อกำลังการผลิตไฟฟ้า (พิจารณาที่ Load control)

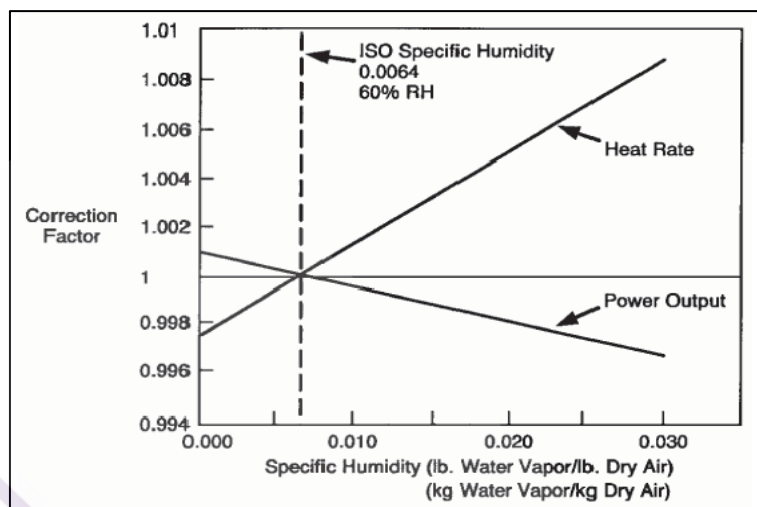

ภาพที่ 2.22 กราฟแสดงความสัมพันธ์เมื่อความชื้นเปลี่ยนแปลงกับ Output และ Heat Rate

ที่มา: Siemens Industrial Turbomachinery AB Training Department E S SO MGT FS4 S-612 83
FINSPONG SWEDEN

3. ความดันที่สูญเสียที่ Air Inlet Filter และด้านไอเสีย (Exhaust)

ผลกระทบดังกล่าว ขึ้นอยู่กับการออกแบบ Gas turbine แต่ละชนิด ความดันสูญเสีย

(Pressure Loss) มากขึ้นมีผลทำให้

- สูญเสียกำลังการผลิต (MW Output ลดลง)
- Heat Rate เพิ่มขึ้น (ใช้เชื้อเพลิงสูงขึ้น)
- อุณหภูมิไอเสีย เพิ่มขึ้น (Exhaust Temperature สูงขึ้น)

4. ค่าความร้อนของเชื้อเพลิง

ถ้าค่าความร้อนของเชื้อเพลิงลดลง ทำให้ Base Load ผลิตกำลังไฟฟ้าได้ลดลง เนื่องจากพลังงานความร้อนที่ได้จากการเผาไหม้ลดลง(เปรียบเทียบในจำนวนเชื้อเพลิงที่เท่ากัน)

5. อากาศที่ถูกดึงไปใช้งานในด้านอื่นๆ

การดึงอากาศไปใช้งานด้านอื่น เพิ่มขึ้น ส่งผลดังต่อไปนี้

- Power Output ลดลง หรือกำลังการผลิตไฟฟ้าที่ Base Load ลดลง
- Heat Rate เพิ่มขึ้น (ประสิทธิภาพลดลง)

ปัจจัยที่กล่าวมาทั้งหมดนี้ ล้วนส่งผลต่อประสิทธิภาพของกังหันก๊าซ ดังนั้นฤดูกาลจึงมีผลโดยตรงต่อประสิทธิภาพของกังหันก๊าซ เช่น ในฤดูร้อน Ambient temperature มีค่าสูงขึ้น ส่งผลให้ประสิทธิภาพกังหันก๊าซต่ำลง หรือ ในฤดูฝน ค่าความชื้นของอากาศสูงขึ้น ทำให้ประสิทธิภาพลดลงด้วยเช่นกัน

SIEMENS SGT-800 Technical Specifications

Axial Compressor

- 15 Stage axial-flow compressor, 3 stage variable guide vanes
- Electron-beam welded rotor
- Cr-steel blades and vanes
- Abradable seals
- Control diffusion airfoils

Combustion and Emission Control

- DLE combustion system
- 30 dual-fuel DLE burners in damped combustor
- Welded annular sheet metal design
- Thermal-barrier-coated inner surface

Fuel System

- Gas only or dual-fuel (Gas/Diesel)
- On-load fuel changeover capability
- Load-rejection capability
- Gas supply pressure requirement 27-30 bar(a)

Turbine

- Single-module high-efficiency 3-stage turbine

Bearings

- Tilting-pad radial and thrust bearings
- Vibration and temperature monitoring

Speed Reduction Gearbox

- Double helical design
- Cold-end driven generator
- Speeds of 1,500 rpm and 1,800 rpm to 50 Hz or 60 Hz operation

Generator

- Four poles design
- Rated voltage : 10.5 kV/11.0kV/13.8kV
- 50 Hz or 60 Hz
- Protection **IP54**
- PMG for excitation power supply
- Complies with IEC/EN 6034-1 standard

Lubrication

- Lubrication oil system placed on separate skid
- 3x50% AC driven lube oil pump with DC back up
- Oil cooler and oil heaters

Starting

- Electric VSD start-motor connected to the gearbox

Control System

- Siemens Simatic control system
- Distributed Inputs/Outputs


Other

- Straight axial exhaust
- Fire and gas detection equipment
- Compressor cleaning options
- Combustion air inlet filtration with options for static, pulse cleaning and HEPA
- Enclosure in carbon or stainless steel. Noise level options (85dB(A) standard)

การนำ Absorption Chiller มาเพิ่มประสิทธิภาพของ Gas Turbine ทำได้โดยนำ Chilled Water ที่ได้จาก Absorption Chiller มาลดอุณหภูมิของ Air inlet ก่อนเข้า Compressor อุณหภูมิของอากาศที่ลดลงทำให้ความหนาแน่นของอากาศที่เข้า Compressor สูงขึ้น นั่นคือ ปริมาณอากาศที่เข้าสู่ห้องเผาไหม้ก็เพิ่มมากขึ้นตามไปด้วย

จากภาพที่ 2.22 แสดงให้เห็นว่า เมื่ออุณหภูมิของอากาศที่เข้าสู่ Compressor (Compressor air intake temperature) ลดลงและกำลังไฟฟ้า (Electrical power output(MW)) ที่ผลิตได้ จะสูงขึ้นตามไปด้วย กราฟ Base load ในภาพที่ 2.22 พิจารณาจากสภาวะการเดินเครื่องที่

- Ambient pressure : 1.013 bar(a)
- Inlet duct pressure loss : 0 mbar
- Relative humidity : 60%
- Outlet duct pressure loss : 0 mbar
- Power turbine speed : 6600 rpm
- Generator frequency : 50 Hz
- Gas : 100% CH₄
- Power factor : 0.9

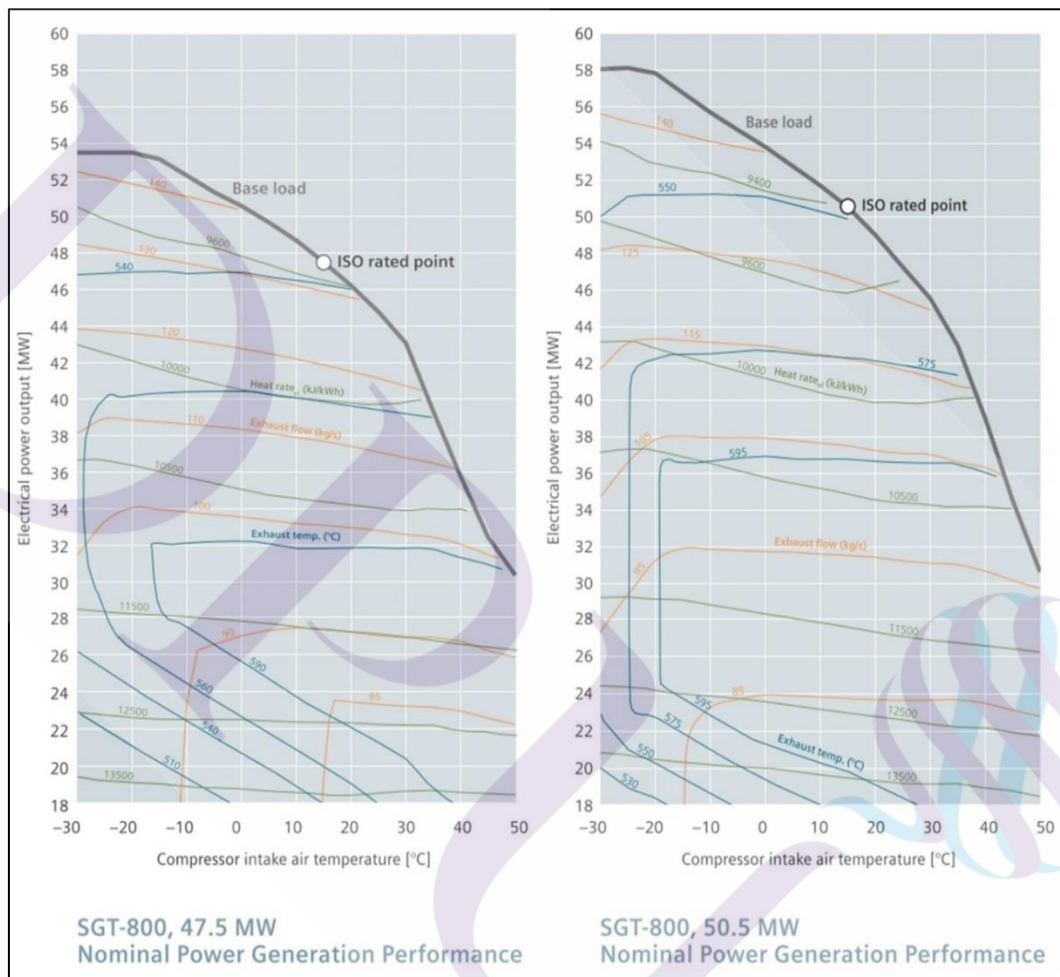

ภาพที่ 2.23 SGT-800 Power Generation Performance

ที่มา: Siemens Industrial Turbomachinery AB Training Department E S SO MGT FS4 S-612 83
 FINSPONG SWEDEN

ตารางที่ 2.2 SIEMENS SGT-800 Performance Specifications

Power Generation	47.5 MW Version	50.5 MW Version
Simple Cycle		
Power Output	ISO 47.5 MW(e)	ISO 50.5 MW(e)
Frequency	50/60 Hz	50/60 Hz
Electrical Efficiency	37.7%	38.3%
Heat rate	9,557 kJ/kWh(9,058 Btu/kWh)	9,407 kJ/kWh(8,916 Btu/kWh)
Turbine Speed	6,608 rpm	6,608 rpm
Compressor pressure ratio	20.4:1	21.1:1
Exhaust gas flow	132.8 kg/s (292.8 lb/s)	134.2 kg/s (295.8 lb/s)
Exhaust temperature	541 °C (1,006 °F)	553 °C (1,027 °F)
NO _x Emission)with DLE to 15 %O ₂ dry	<=15 ppmV	<=15 ppmV
Combined Cycle SCC-800 1x1		
Net Plant Output	ISO 66.6 MW(e)	ISO 71.4 MW(e)
Net Plant Efficiency	53.8%	55.1%
Net Plant Heat Rate	6,693 kJ/kWh (6,344 Btu/kWh)	6,530 kJ/kWh (6,189 Btu/kWh)
Combined Cycle SCC-800 2x1		
Net Plant Output	ISO 135.4 MW(e)	ISO 143.6 MW(e)
Net Plant Efficiency	54.7%	55.4%
Net Plant Heat Rate	6,583 kJ/kWh (6,239 Btu/kWh)	6,494 kJ/kWh (6,155 Btu/kWh)

2.5 เครื่องมือคุณภาพ 7 ชนิด (7 QC Tools)

เครื่องมือคุณภาพ 7 ชนิด นับได้ว่าเป็นสิ่งที่ช่วยพัฒนาและแก้ไขปัญหาต่าง ๆ ได้อย่างมีประสิทธิภาพ เครื่องมือเหล่านี้เป็นการรวบรวมและประยุกต์ใช้วิธีการทางสถิติ การใช้หลักการทางด้านเหตุผล และศาสตร์ความรู้ในด้านต่าง ๆ มารวบรวม และเลือกใช้ในการจัดการกับปัญหาแต่ละชนิด เครื่องมือคุณภาพ 7 ชนิดนี้มีที่มาจากองค์กรหนึ่งในประเทศญี่ปุ่น ชื่อว่า Union of Japanese Scientists and Engineers และกลุ่ม Quality Control Research Group ซึ่งได้ถูกจัดตั้งขึ้น ในปี ค.ศ.

1946 เพื่อค้นคว้าและทำการศึกษา ตลอดจนเผยแพร่ความรู้ความเข้าใจในเรื่องระบบการควบคุมคุณภาพให้กับอุตสาหกรรมภายในประเทศของญี่ปุ่น โดยมีจุดหมายเพื่อพัฒนาคุณภาพสินค้าของญี่ปุ่นให้สามารถเข้าสู่การแข่งขันในตลาดโลกได้อย่างทัดเทียมประเทศผู้นำทางเศรษฐกิจในสมัยนั้นอย่างอเมริกา และกลุ่มประเทศยุโรปตะวันตก

จากนั้นได้มีการกำหนดมาตรฐานอุตสาหกรรมของประเทศญี่ปุ่น (Japanese Industrial Standards) หรือ JIS marking system ได้นำมาบังคับใช้เป็นกฎหมายในปี ค.ศ. 1950 และยังสามารถเปิดสัมมนาทางวิชาการด้านการควบคุมคุณภาพให้แก่ผู้บริหารระดับต่าง ๆ และวิศวกรในประเทศ โดยมีผู้เชี่ยวชาญระดับโลกอย่าง Dr. W. E. Deming เป็นผู้นำในโครงการ นับเป็นจุดเริ่มต้นของการพัฒนาคุณภาพ ซึ่งต่อมาก็ได้มีการตั้งรางวัล Deming Prize อันมีชื่อเสียงทั่วโลก เพื่อมอบให้กับองค์กรอุตสาหกรรมหรือโรงงานที่มีการพัฒนาด้านคุณภาพดีเด่นของญี่ปุ่น

ต่อมาในปี ค.ศ. 1954 ทางญี่ปุ่นได้เชิญ Dr. J. M. Juran มาทำการฝึกอบรมเกี่ยวกับหลักการควบคุมคุณภาพ เพื่อสร้างรากฐานความรู้ความเข้าใจแก่ผู้บริหารระดับสูงขององค์กรในการนำเทคนิคเหล่านี้มาใช้งาน โดยได้รับความร่วมมือจากพนักงานทุกฝ่าย นับเป็นจุดเริ่มต้นของการพัฒนาและรวบรวมเครื่องมือที่ใช้ในการควบคุมคุณภาพ ทั้ง 7 ชนิด ที่เรียกกันว่า 7 QC Tools มาใช้อย่างแพร่หลายจนทุกวันนี้

เครื่องมือคุณภาพ 7 ชนิดนี้ คือ บรรดาเทคนิค วิธีการ ผัง แผนภูมิ ตาราง และรูปแบบในการนำเสนอข้อมูลต่าง ๆ ที่เรานำมาใช้เพื่อช่วยในการค้นหาข้อเท็จจริงในการเก็บข้อมูลในการช่วยค้นหาความคิด และจดความคิดอย่างเป็นระบบ ช่วยในการวิเคราะห์หาความสัมพันธ์ของเหตุและผล ตลอดจนการตัดสินใจ การนำมาตราการแก้ไขหรือปรับปรุงงาน ไปปฏิบัติและจัดตั้งการควบคุม


เครื่องมือควบคุมคุณภาพทั้ง 7 ชนิดนี้ ตั้งชื่อตามนักรบในตำนานของชาวญี่ปุ่นที่ชื่อ "เบงเค" (Ben-ke) ผู้ซึ่งมีอาวุธอันร้ายกาจแตกต่างกัน 7 ชนิด พกอยู่ที่หลัง และสามารถเลือกดึงมาใช้สยบคู่ต่อสู้ที่มีฝีมือร้ายกาจคนแล้วคนเล่า สำหรับเครื่องมือทั้ง 7 ชนิด สามารถแจกแจงได้ดังนี้

เครื่องมือคุณภาพทั้ง 7 ชนิดที่ได้รับการยอมรับและนิยมใช้ทั่วโลกนั้น มีดังต่อไปนี้

- 1) แผนภูมิพาเรโต (Pareto Diagram)
- 2) ผังแสดงเหตุและผล (Cause-and-Effect Diagram)
- 3) กราฟ (Graph)
- 4) ใบตรวจสอบ (Check Sheet)
- 5) ผังการกระจาย (Scatter Diagram)
- 6) ฮิสโตแกรม (Histogram)

7) แผนภูมิควบคุม (Control Chart)


1) แผนภูมิพาเรโต (Pareto Diagram) คือแผนภูมิแบบหนึ่งที่น่ามาใช้ในการแสดงให้เห็นขนาดของปัญหาและเพื่อจัดลำดับความสำคัญของปัญหา ชื่อแผนภูมิมิที่มาจากชื่อของนักเศรษฐศาสตร์ชาวอิตาลีชื่อ Vilfredo Federico Damaso Pareto ซึ่งเป็นผู้คิดค้นหลักการนี้ขึ้นเอง

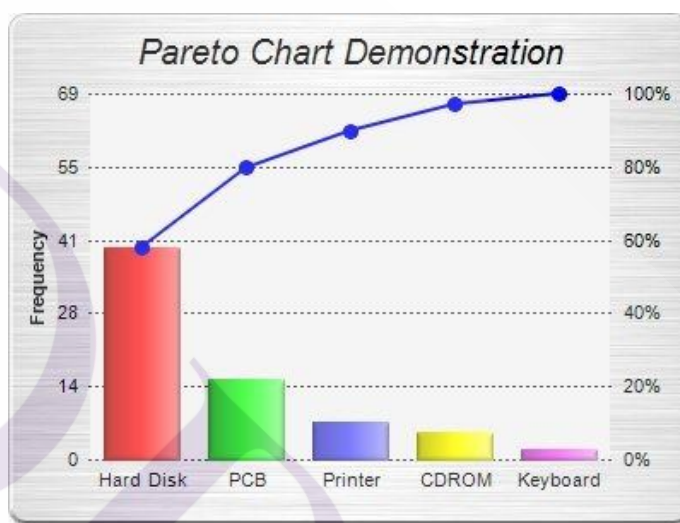

ภาพที่ 2.24 ตัวอย่าง แผนภูมิพาเรโต (Pareto Diagram)

ที่มา: <https://www.advsofteng.com/doc/cdnetdoc/pareto.htm>

2) ฟังแสดงเหตุและผล (Cause-and-Effect Diagram) หรือฟังก้างปลา (Fishbone Diagram) บางครั้งเรียกว่า Ishikawa Diagram ซึ่งเรียกตามชื่อของ Kaoru Ishikawa ผู้ซึ่งเริ่มนำฟังนี้มาใช้ในปี ค.ศ.1953 เป็นฟังที่แสดงความสัมพันธ์ระหว่างคุณลักษณะ ทางคุณภาพกับปัจจัยต่างๆ ที่เกี่ยวข้อง

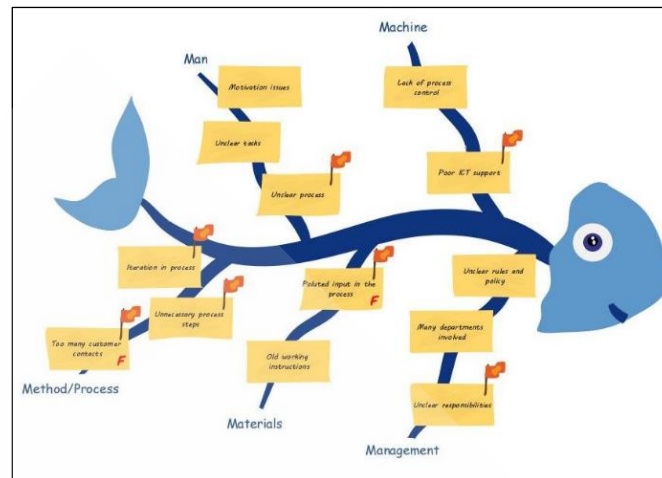

ภาพที่ 2.25 ตัวอย่าง ฟังแสดงเหตุและผล (Cause-and-Effect Diagram)

ที่มา: <https://www.slideshare.net/MaritesTeope/ishikawa-diagram-65760083>

3) กราฟ (Graph) คือ แผนภาพประเภทใดประเภทหนึ่งที่เป็นกรนำเสนอข้อมูลเป็นรูปภาพ แทนคำบรรยาย โดยมีเป้าหมายหลักคือ ต้องทำให้ผู้ที่ดูกราฟสามารถเข้าใจได้ง่ายและรวดเร็วที่สุด



ภาพที่ 2.26 ตัวอย่าง กราฟ (Graph)

ที่มา: http://www.rininspired.com/wp-content/uploads/2017/01/statistic-infographics_1057-284.jpg


4) ใบตรวจสอบ (Check Sheet) หรือที่นิยมเรียกกันว่า Check Sheet เป็นแผ่นงานที่ได้ ออกแบบมาอย่างเฉพาะเจาะจงต่องานนั้น ๆ โดยมีจุดประสงค์ที่จะเก็บข้อมูลสำคัญ ๆ ได้ง่ายและเป็นระบบ

ANGTHONG POWER		ANGTHONG POWER.		Shift	Shift	Shift				
CRO. Log sheets		Area: DCS		CRO:	CRO:	CRO:				
KKS No.		Description	Unit	Limit	DATE	20/08/2018	Sheet 1/10			
					TIME					
					01:00	05:00	09:00	13:00	17:00	21:00
GT11 Turbine Data										
11MBA10CS005	SPEED	RPM	600/6600							
11MBA10AE005	VEV	%	19-80							
11MBA10CF900	TURBINE INLET MASS FLOW	Kg/s								
11MBV10EA903	COOLING TIME	h/m/s								
11MBA10CT025	COMP INLET TEMP	°C	<LL 7							
11MBA10CP010	COMP INLET PRESS	KPa								
11MBA10CP020	COMBUST CHAMBER	MPa								
11MBA10CT030	COMP DISCH TEMP 3	°C								
11MBA10CP015	COMP DISCH p P3	MPa								
11MBA10CP045	EXH pr /DP	KPa								
11MBA10CP800	TUR EXH DP	KPa								
GT11 Cooling and Sealing Air.										
11MBA10CT065	TURB CASING TEMP	°C	>H 350							
11MBA10CT070	VANE SEAL2 TEMP	°C								
11MBA10CF905	STAT 1-2 TEMP	°C								
11MBA10CF910	STAT 2-3 TEMP	°C	>H 300							
11MBH10CF025	EXTR 3 DP	KPa								
11MBH10CF020	EXTR 5 DP	KPa								
11MBH10CF020	EXTR 10 DP	KPa								
11MBA10CP035	DISC 1 PRESSURE	MPa								
11MBH10AA005	BLEED VALVE 1	%								
11MBH10AA010	BLEED VALVE 2	%								
GT11 Generator Data.										
11CFA10CE001	POWER. P	MW								
11MKA10CE011	REACTIVE POWER. Q	MVAR								
11MKA10CE014	POWER FACTOR. PF									
11MKA10CE013	FREQUENCY. F	Hz								
11MKA10CE007	VOLTAGE. U	kV								
11MKA10CE002	CURRENT. I	A								
11MKA10CT800	STATOR TEMP PHASE	°C	>H 130							
11MKA10CT805	STATOR TEMP PHASE	°C	>H 130							
11MKA10CT810	STATOR TEMP PHASE	°C	>H 130							
11MKA10CT020	WARM AIR	°C	>H 90							
11MKA10CT015	COOL AIR	°C	>H 50							

ภาพที่ 2.27 ตัวอย่าง ใบตรวจสอบ (Check Sheet)

ที่มา: Log Sheet for Control Room Operator ของบริษัท อ่างทอง เพาเวอร์ จำกัด


5) พังการกระจาย (Scatter Diagram) คือ พังที่ใช้แสดงค่าของข้อมูลที่เกิดความสัมพันธ์ของตัวแปร 2 ตัว ว่ามีแนวโน้มไปในทางใด เพื่อที่จะใช้หาความสัมพันธ์ที่แท้จริง

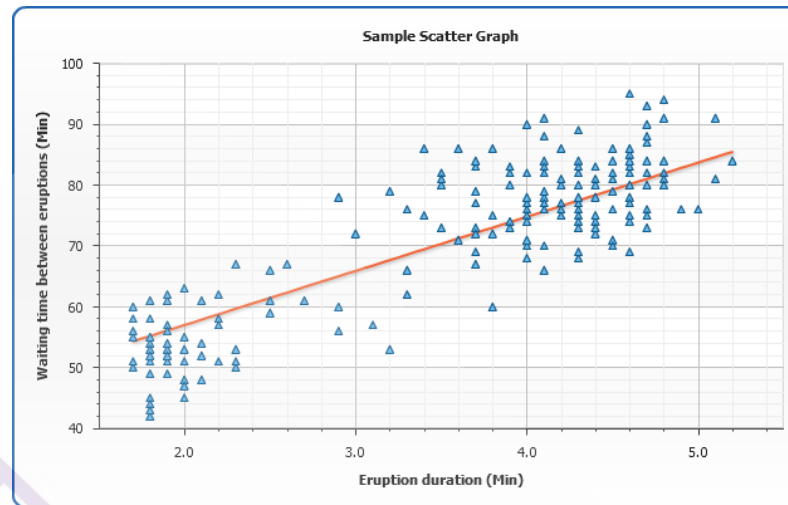

ภาพที่ 2.28 ตัวอย่าง ผังการกระจาย (Scatter Diagram)

ที่มา: <http://6.anychart.com/products/anychart/docs/users-guide/Scatter-Chart.html>


6) ฮิสโตแกรม (Histogram) เป็นแผนภูมิแท่งที่บอกถึงความถี่ที่เกิดขึ้นในแต่ละชั้นความถี่นั้น ๆ โดยแต่ละแท่งจะวางเรียงติดกัน แกนนอนจะกำกับด้วยค่าขอบบนและขอบล่างของชั้นนั้นหรือใช้ค่ากลาง (Midpoint) ส่วนแกนตั้งเป็นค่าความถี่ในแต่ละชั้น ความสูงของแต่ละแท่งจะขึ้นอยู่กับความถี่ที่เกิดขึ้นนั้น

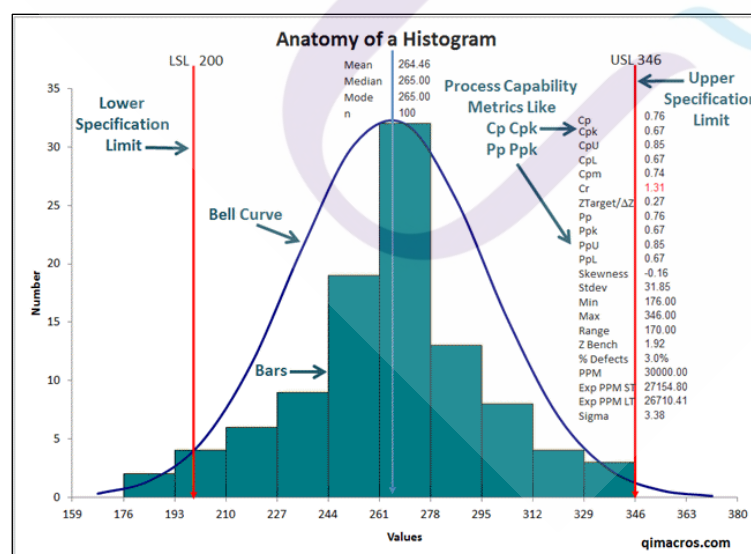

ภาพที่ 2.29 ตัวอย่าง ฮิสโตแกรม (Histogram)

ที่มา: <https://www.qimacros.com/histogram-excel/>

7) แผนภูมิควบคุม (Control Chart) คือแผนภูมิที่มีการแสดงค่าที่ยอมรับได้ตาม (ข้อกำหนดทางเทคนิค : Specification) เพื่อเป็นแนวทางในการควบคุมกระบวนการโดยการติดตามผลของข้อมูลที่เกิดขึ้น เทียบกับ Spec. และขีดจำกัดบน – ล่าง (Control limit) ที่ได้ทำการคำนวณไว้ตามวิธีการทางสถิติ

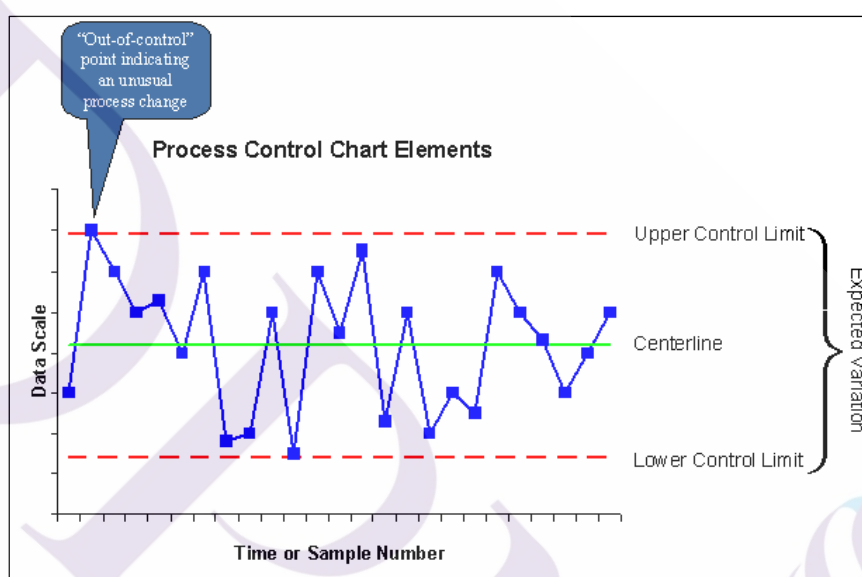

ภาพที่ 2.30 ตัวอย่าง แผนภูมิควบคุม (Control Chart)

ที่มา: <https://qcclass.files.wordpress.com/2007/03/chart.gif>

2.6 งานวิจัยที่เกี่ยวข้อง

สาณัฐ อุตศาสตร์ (2553) ได้ศึกษาความเป็นไปได้ทางด้านเทคนิคและทางการเงินในการนำความร้อนทิ้งจากไอเสียของแก๊สเทอร์ไบน์มาใช้ในสถานีเพิ่มความดันแก๊สไทรโยค โดยเป็นการนำความร้อนทิ้งมาใช้ในกระบวนการผลิตกระแสไฟฟ้า นำไฟฟ้าที่ผลิตได้มาใช้งานในสถานีเพิ่มความดันแก๊สไทรโยคและขายไฟฟ้าส่วนที่เหลือให้กับการไฟฟ้าส่วนภูมิภาค ในการวิจัยได้เข้าศึกษาและเก็บข้อมูลในสถานีเพิ่มความดันแก๊สไทรโยค โดยพบว่าแก๊สเทอร์ไบน์มีการทำงานเฉลี่ย 6,745 ชั่วโมงต่อปี อุณหภูมิของแก๊สไอเสียมีค่าเฉลี่ย 577 °C คิดเป็นอัตราการนำความร้อนจากไอเสียมาใช้ได้ 29,388 kW การศึกษาศักยภาพของระบบผลิตไฟฟ้าได้เลือกระบบผลิตไฟฟ้าแบบ Organic

Turbine Generator มาใช้ โดยพิจารณาจากปัจจัยหลักที่ระบบนี้ไม่ต้องใช้น้ำในการผลิตกระแสไฟฟ้า เนื่องจากสถานีเพิ่มความดันแก๊สไทรโยคขาดแคลนแหล่งน้ำดิบที่พอเพียง โดยผลการศึกษาพบว่าสามารถผลิตกำลังไฟฟ้า ได้ 11.17 MW คิดเป็นพลังงานไฟฟ้าที่ผลิตได้ 75,650,786 kWh/year มีระยะเวลาคืนทุนคือ 6.9 ปี และอัตราผลตอบแทนการลงทุน (IRR) คือ 14%

ชลวิทย์ เผือกผาสุก (2554) ได้ศึกษาการจัดการพลังงานไฟฟ้าในอาคารแบบบูรณาการกรณีศึกษาอาคารกรมการกงสุล โดยมุ่งเน้นที่ระบบปรับอากาศและระบบแสงสว่าง โดยการรวบรวมข้อมูลรายละเอียดต่างๆ เช่น การออกแบบ การติดตั้ง ประเภทของเครื่องปรับอากาศ ที่ตั้ง ช่วงเวลาการทำงาน เพื่อหาแนวทางการบริหารจัดการด้านพลังงานไฟฟ้า โดยทำการบันทึกผลทั้งก่อนการปรับปรุงและหลังการปรับปรุง และนำมาวิเคราะห์หาระยะเวลาคืนทุน จากผลการศึกษาในปี พ.ศ. 2553 พบว่าอาคารมีการใช้พลังงานไฟฟ้ารวม 3,337,00 kWh/Year คิดเป็นเงินทั้งสิ้น 10,953,858.06 บาทต่อปี โดยมีสัดส่วนการใช้พลังงานไฟฟ้างานนี้ เครื่องปรับอากาศคิดเป็น 51.63% และระบบแสงสว่างคิดเป็น 11.92% และระบบอื่นๆคิดเป็น 36.44% ของการใช้พลังงานไฟฟ้าทั้งหมดของอาคารกรมกงสุล โดยได้กำหนดมาตรการการอนุรักษ์พลังงานรวม 6 มาตรการ ได้แก่ มาตรการปรับปรุงค่าสมรรถนะการทำความเย็นของเครื่องทำน้ำเย็น มาตรการลดชั่วโมงการทำงานของเครื่องทำน้ำเย็น มาตรการลดชั่วโมงการทำงานของปั้มน้ำในระบบปรับอากาศ และ หอผึ่งน้ำ มาตรการลดชั่วโมงการทำงานของเครื่องส่งลมเย็น มาตรการเปลี่ยนหลอดฟลูออเรสเซนต์ ชนิด T8 เป็น T5 และมาตรการเปลี่ยนหลอดโซเดียมความดันสูงเป็นหลอดคอมแพคฟลูออเรสเซนต์ รวมผลประหยัดพลังงานไฟฟ้าเท่ากับ 659,097.88 kWh/Year คิดเป็นเงินในการประหยัดพลังงานไฟฟ้า 2,161,841.05 บาทต่อปี

สุรินทร์ จันทสุริยวิช (2546) ได้ศึกษาการจัดการด้านการใช้ไฟฟ้า คณะแพทยศาสตร์ มหาวิทยาลัยเชียงใหม่ ประกอบด้วยอาคารตัวอย่าง 4 อาคาร คือ อาคารสุจิน โฉ อาคารบุญสม- มาร์ติน อาคารศรีพัฒน์ และอาคารศัลยกรรม โดยการตรวจวัดหาค่าและช่วงเวลาที่มีความต้องการพลังไฟฟ้าสูงสุดที่ใช้งานจริงของอุปกรณ์ไฟฟ้าต่างๆ ใน ระบบแสงสว่าง และระบบปรับอากาศ เพื่อนำไปวิเคราะห์และวางแผนการจัดการด้านการใช้ไฟฟ้านั้น พบว่าการใช้พลังงาน ไฟฟ้ารวมมีลักษณะที่สม่ำเสมอ โดยมีค่าความต้องการพลังไฟฟ้าสูงสุด 1,521 kW และมีปริมาณ การใช้พลังงานไฟฟ้าประมาณ 9.1×10^6 kWh/year คิดเป็นร้อยละของการใช้พลังงานไฟฟ้าในคณะแพทยศาสตร์ทั้งหมด เท่ากับ 36.88 และ 44.34 ตามลำดับ ช่วงเวลาที่มีความต้องการใช้ พลังไฟฟ้าสูงสุดในรอบ 1 วัน คือระหว่างเวลา 9.00 - 16.00 น. ซึ่งการจัดการด้านการใช้ไฟฟ้าในช่วงที่กว้างนี้ ควรใช้วิธีการใช้อุปกรณ์ไฟฟ้าที่มีประสิทธิภาพสูง และลดการใช้งานอุปกรณ์ไฟฟ้าที่ไม่จำเป็น ได้แก่ การใช้บัลลาสต์สูญเสียพลังงานน้อย การใช้โคมไฟสะท้อนแสง การลดการใช้ หลอดไฟใน

ห้องที่มีกำลังไฟส่องสว่างเกินจำเป็น การใช้เครื่องปรับอากาศประสิทธิภาพสูง การบำรุงรักษาเครื่องปรับอากาศ จากการคำนวณ พบว่าในระบบแสงสว่าง การจัดการร่วมทุกแนวทาง สามารถลดความต้องการพลังไฟฟ้าได้ 226.96 kW และประหยัดพลังงานไฟฟ้า 891,143 kWh/year คิดเป็นเงินที่ประหยัดได้ 2,232,000 บาทต่อปี โดยมีเงินลงทุน 7,180,000 บาท มีระยะเวลาคืนทุน 3.22 ปี และในระบบปรับอากาศ สามารถลดพลังไฟฟ้าได้ 0.41 kW ประหยัดพลังงานไฟฟ้า ได้รวม 46,770 kWh/year คิดเป็นเงินที่สามารถประหยัดได้เท่ากับ 119,900 บาทต่อปี โดยมีเงินลงทุน 63,000 บาท มีระยะเวลาคืนทุน 0.52 ปี

ชัชชัย จันทะสีลา (2549) ได้ศึกษาการใช้พลังงาน และหาค่าดัชนีการใช้พลังงานไฟฟ้า ในอาคารสิรินธร โรงพยาบาลขอนแก่น พบว่า จะมีลักษณะโดยทั่วไปคล้ายกัน คือเป็นอาคารรูปทรงสี่เหลี่ยม ใช้คอนกรีตเป็นวัสดุหลักในการก่อสร้าง การใช้พลังงานไฟฟ้าส่วนใหญ่ใช้ในระบบแสงสว่าง และระบบปรับอากาศ สาเหตุของการสูญเสียพลังงานไฟฟ้า ส่วนใหญ่เกิดจากสาเหตุที่อุปกรณ์ไฟฟ้าขาดการบำรุงรักษา การติดตั้งโคมไฟฟ้ามกเกินความจำเป็น ค่าความส่องสว่างในพื้นที่มีค่าเกินมาตรฐานที่กำหนด การใช้อุปกรณ์ที่ไม่มีประสิทธิภาพในการประหยัดพลังงานและอุปกรณ์ไฟฟ้ามีระยะเวลาในการทำงานมากเกินความจำเป็น ดังนั้น จึงได้เสนอมาตรการดังนี้ ปลอดภัยไฟฟ้ที่ไม่จำเป็นออก จะสามารถประหยัดพลังงานไฟฟ้าได้ประมาณ 96,540.8 kWh/year คิดเป็นเงินที่ประหยัด 178,600.48 บาทต่อปี การประหยัดพลังงานไฟฟ้าโดยการทำความสะอาดและบำรุงรักษาอุปกรณ์ โดยวิธีการล้างทำความสะอาดเครื่องปรับอากาศ จะสามารถประหยัดพลังงานไฟฟ้าได้ประมาณ 38,525.10 kWh/year และคิดเป็นเงินที่ประหยัดได้ประมาณ 71,271.44 บาทต่อปี การประหยัดพลังงานไฟฟ้าโดยใช้อุปกรณ์ชนิดประหยัดพลังงาน คือการใช้บัลลาสต์อิเล็กทรอนิกส์ จะสามารถประหยัดพลังงานไฟฟ้าได้ประมาณ 88,280.30 kWh/year และคิดเป็นเงินที่ประหยัดได้ประมาณ 163,318.5 บาทต่อปี ส่วนการใช้เทอร์โมสแตท อิเล็กทรอนิกส์ แทนเทอร์โมสแตทแบบธรรมดาจะสามารถประหยัดพลังงานไฟฟ้าได้ประมาณ 35,345 kWh/year และคิดเป็นเงินที่ประหยัดได้ประมาณ 8,500.45 บาทต่อปี และเสนอแนะให้ใช้ มาตรการประหยัดพลังงานไฟฟ้าโดยการใช้ Timer Switch ควบคุมการทำงานของเครื่องปรับอากาศ จะสามารถประหยัดพลังงานไฟฟ้าได้ประมาณ 9,768.35 kWh/year และคิดเป็นเงินที่ประหยัดได้ ประมาณ 18,071.45 บาทต่อปี

วัชร จ่าปาดิษฐ์ (2550) ได้พัฒนาระบบสารสนเทศด้านพลังงานในอาคารโรงแรมโดย ใช้วิธีแผนที่พลังงาน จากการดำเนินการในอาคารกรณีศึกษาพบว่า เครื่องซีลเลอร์ เป็นอุปกรณ์ที่มีการใช้พลังงานสูงที่สุดในระบบปรับอากาศ โดยมีสัดส่วนสูงถึง 53.41 % ของพลังงานรวมในระบบปรับอากาศ สำหรับการี่ใช้พลังงานของระบบไฟฟ้าแสงสว่างพบว่า พื้นที่ส่วนหน้ามีการใช้พลังงาน

สูงถึง 83.30 % ของพลังงานที่ใช้ในระบบแสงสว่าง โดยสิ่งที่มีผลต่อปริมาณการใช้พลังงานคือ จำนวนของอุปกรณ์พลังงาน กำลังไฟฟ้าของอุปกรณ์ และชั่วโมงการใช้งานต่อวันของอุปกรณ์ แผนที่พลังงานประกอบด้วย โครงสร้างของอุปกรณ์ ข้อมูลจำเพาะของอุปกรณ์พลังงานและการประมวลผลพลังงานทั้งหมด ซึ่งจะเป็นประโยชน์ต่อการวางแผนเพื่ออนุรักษ์พลังงานประหยัดเวลา ในขั้นตอนของการประมวลผล เมื่อมีการเปลี่ยนแปลงรายการของอุปกรณ์ที่อาจเกิดขึ้นภายในอาคาร

สุวเดช แก้วช่วย (2552) ได้ศึกษาการจัดการใช้พลังงานในอาคารหอสมุดสุรรัตน์ โอภาณุเคราะห์ ที่มหาวิทยาลัยกรุงเทพ วิทยาเขตรังสิต ซึ่งเป็นอาคารสถานศึกษา โดยเป็น หอสมุดกลางของมหาวิทยาลัย เปิดใช้งานในปี พ.ศ. 2545 เป็นอาคารสูง 5 ชั้น มีพื้นที่ใช้สอยรวม 22,700 m² มีจำนวนผู้ใช้อาคารประมาณ 1,551 คน เวลาทำการของอาคาร วันจันทร์-เสาร์ เวลา 07.30-17.00 น. การศึกษามุ่งเน้นที่ระบบปรับอากาศและระบบไฟฟ้าแสงสว่าง เพื่อหาแนวทางในการลดการใช้พลังงานลงไม่ต่ำกว่าร้อยละ 15 ต่อปี โดยใช้มาตรการต่างๆ ในการจัดการพลังงาน พบว่าในระบบปรับอากาศสามารถประหยัดพลังงานไฟฟ้าได้ 392,631 kWh/year คิดเป็นเงิน 1,505,345 บาทต่อปี ในระบบไฟฟ้าแสงสว่างสามารถประหยัดพลังงานไฟฟ้าได้ 93,993 kWh/year คิดเป็นเงิน 281,979 บาทต่อปี รวมผลในระบบปรับอากาศและระบบไฟฟ้าแสงสว่างที่ประหยัดได้ทั้งสิ้น เป็นพลังงานไฟฟ้า 486,624 kWh/year คิดเป็นเงิน 1,787,324 บาทต่อปี


อักรพันธ์ ธรรมไพศาล (2554) งานวิจัยนี้เป็นการศึกษาหาปริมาณการใช้พลังงานต่อหนึ่งหน่วยการผลิต (Specific Energy Consumption) ของโรงงานผลิตไฟฟ้าประเภทโคเจนเนอเรชั่นหรือในทางการผลิตไฟฟ้าจะเรียกว่าค่า Heat Rate ซึ่งจะเป็นดัชนีชี้วัดประสิทธิภาพของโรงไฟฟ้านั้นๆหรือเป็นอัตราส่วนระหว่างปริมาณผลผลิต (ไฟฟ้า + ไอน้ำ) ต่อปริมาณก๊าซธรรมชาติที่ใช้รวมถึงการหาต้นทุนค่าก๊าซธรรมชาติต่อหน่วยการผลิตโดยทำการเปรียบเทียบระหว่างแต่ละเทคโนโลยีการผลิต (กำหนดตามเครื่องกังหันก๊าซที่ใช้) ที่มีผลผลิตเป็นไฟฟ้าและไอน้ำเมื่อกำหนดให้ค่า Heat Rate ของโรงไฟฟ้าตัวอย่างตาม Specification ที่กำลังการผลิตสูงสุดโดยมีผลผลิตไฟฟ้าเพียงอย่างเดียวคือ 6,369.56 BTU / kWh มีต้นทุน 1.93 บาท / kWh เป็นเกณฑ์จะพบว่า Heat Rate ของโรงไฟฟ้าตัวอย่างที่กำลังการผลิตตามสัญญาซื้อขายทั้งไฟฟ้าและไอน้ำนั้นสูงกว่า 16.3% แต่จะต่ำกว่าค่าจากการใช้งานจริงที่ 8,553.60 BTU / kWh ต้นทุน 2.59 บาท / kWh 15.63% ได้มีการนำเสนอแนวทางการปรับปรุงให้ดีขึ้นจากการใช้การจัดการในการเพิ่มผลผลิตและการประหยัดพลังงานทำให้สามารถลดค่า Heat Rate ของโรงไฟฟ้าตัวอย่างที่กำลังการผลิตตามสัญญาซื้อขายทั้งไฟฟ้าและไอน้ำจาก 7,397.13 BTU / kWh หรือมีต้นทุน 2.24 บาทเป็น 6,691.67 BTU / kWh ต้นทุนลดลง 0.21 บาท / kWh และหากเลือก Best Technology จากการวิจัยนี้คือ

Rows-Royce RB211-H63 จะให้ค่า Heat Rate ที่ดีที่สุดคือ 5, 778. 66 BTU / kWh หรือดีขึ้นกว่าเกณฑ์ 9. 27% ต้นทุนลดลง 0. 18 บาท / kWh

กรเทวินทร์ บุญช่วย (2559) ความต้องการใช้ไฟฟ้าของประเทศไทยมีแนวโน้มสูงขึ้นทุกปีเนื่องมาจากการเติบโตทางเศรษฐกิจและพลังงานประกอบกับปัญหาที่สำคัญในด้านพลังงานของประเทศไทยคือก๊าซธรรมชาติที่ได้จากการขุดเจาะที่อ่าวไทยและจากพื้นที่พัฒนาร่วมไทย-มาเลเซียกำลังจะหมดลงในอีก 4-5 ปีทำให้ปีพ. ศ. 2560-2566 จำเป็นต้องนำเข้าก๊าซธรรมชาติเหลวซึ่งมีราคาแพงและมีราคาที่สูงขึ้นผืนผวนดังนั้นสำนักงานนโยบายและแผนพลังงาน (สนพ.) และคณะกรรมการกำกับกิจการพลังงาน (กกพ.) จึงได้เล็งเห็นถึงความสำคัญของมาตรการความร่วมมือลดการใช้ไฟฟ้าซึ่งจะเข้ามามีบทบาทในกิจการพลังงานไฟฟ้าของประเทศไทยในอนาคตเพื่อลดต้นทุนการผลิตไฟฟ้าที่มีราคาสูงวิทยานิพนธ์ฉบับนี้นำเสนอเกณฑ์ในการเรียกใช้มาตรการอัตราค่าไฟฟ้าช่วงวิกฤติที่เหมาะสมและวิธีการคำนวณอัตราค่าชดเชยที่เหมาะสมที่สุดของมาตรการค่าไฟฟ้าช่วงวิกฤติโดยพิจารณาต้นทุนการผลิตไฟฟ้าหน่วยสุดท้ายอัตราค่าไฟฟ้าช่วงวิกฤติจะถูกคำนวณโดยมีวัตถุประสงค์เพื่อให้สวัสดิการสังคม (Social Welfare) สูงสุดด้วยวิธี Quadratic Programming โดยพิจารณาถึงต้นทุนการผลิตไฟฟ้าหน่วยสุดท้ายของระบบผลิตไฟฟ้าในประเทศไทยและพิจารณาการจ่ายกำลังไฟฟ้าในช่วงความต้องการใช้ไฟฟ้าสูงของเขื่อนในประเทศไทยเพื่อช่วยลดต้นทุนการผลิตไฟฟ้าหน่วยสุดท้ายของระบบไฟฟ้าระบบทดสอบที่ใช้ในวิทยานิพนธ์ฉบับนี้คือระบบผลิตไฟฟ้าในประเทศไทยความต้องการใช้ไฟฟ้าของประเทศไทยและความต้องการใช้ไฟฟ้าของผู้ใช้ไฟฟ้าประเภทที่ 3 และ 4 ของปีพ. ศ. 2560 ผลการคำนวณอัตราค่าไฟฟ้าช่วงวิกฤติจะพบว่าหากมีการเรียกใช้มาตรการอัตราค่าไฟฟ้าช่วงวิกฤติจะทำให้สวัสดิการสังคมหรือผลประโยชน์ของประเทศโดยรวมมีค่าสูงขึ้นเป็นที่น่าพอใจและปัจจัยหลักที่มีผลต่อการคำนวณคือประเภทของผู้เข้าร่วมมาตรการและต้นทุนการผลิตไฟฟ้าหน่วยสุดท้ายในระบบไฟฟ้า

สุธี เหลืองรัตนเจริญ (2552) วัตถุประสงค์ที่แท้จริงของการอนุรักษ์พลังงานนั้นคือการดำเนินงานโดยการลดต้นทุนการผลิตให้อยู่ในระดับต่ำที่สุดโดยเฉพาะอย่างยิ่งในอุตสาหกรรมที่มีการใช้พลังงานสูงจึงทำการศึกษาโรงงานประเภทลัดขึ้นรูปทำการประเมินการใช้พลังงานเบื้องต้นของทางโรงงานก่อนจากนั้นก็สร้างแผนภูมิการใช้พลังงานเป็นเครื่องมือเพื่อช่วยในการวิเคราะห์การใช้พลังงานทั้งระบบเพื่อให้รู้ว่าการใช้พลังงานของโรงงานในขณะนั้นมีประสิทธิภาพดีแล้วหรือไม่ซึ่งจากการประเมินการใช้พลังงานเบื้องต้นทางโรงงานตัวอย่างมีค่าดัชนีชี้วัดการใช้พลังงานจำเพาะของผลิตภัณฑ์อัลลูมิเนียมอัลลอยด์เท่ากับ 13. 79 MJ / kg และมีค่าดัชนีชี้วัดการใช้พลังงานจำเพาะของผลิตภัณฑ์สังกะสีอัลลอยด์เท่ากับ 7. 86 MJ / kg หลังจากทำการศึกษาลดต้นทุนพลังงานของโรงงานประเภทลัดขึ้นรูปโลหะโดยการนำแผนภูมิการใช้พลังงานเข้ามา

วิเคราะห์การใช้พลังงานและสร้างมาตรการปรับปรุงซึ่งประกอบด้วยมาตรการระยะสั้น ได้แก่ มาตรการลดการใช้พลังงานจากเตาหลอมศูนย์กลางมาตรการลดการใช้พลังงานจากปั๊มลมปรับปรุง การรั่วของระบบลมมาตรการลดการใช้พลังงานจาก Cooling Tower โดยจัดระบบการเปิด-ปิด Cooling Tower ให้เหมาะสมมาตรการลดการใช้พลังงานจากเตาอุ่นประจำเครื่องและมาตรการลด การใช้แสงสว่างส่วนมาตรการระยะยาว ได้แก่ มาตรการลดอุณหภูมิการฉีดลงให้ไม่เหมาะสมกับ ชี้นงานมาตรการออกแบบทางเดินและระบบรูส้นของแต่ละงานให้เหมาะสมและมาตรการ ปรับเปลี่ยนความเร็วในฉีดให้เหมาะสมในแต่ละชิ้นงานหลังจากนำมาตรการปรับปรุงมาใช้แล้วจะ ได้ค่าดัชนีชี้วัดการใช้พลังงานจำเพาะของผลิตภัณฑ์อัลลูมิเนียมอัลลอยด์เท่ากับ 12.89 MJ/kg และมีค่าดัชนีชี้วัดการใช้พลังงานจำเพาะของผลิตภัณฑ์สังกะสีอัลลอยด์เท่ากับ 7.54 MJ/kg และคาดว่าจะสามารถลดต้นทุนพลังงานลงได้ร้อยละ 5.13 จากเดิม

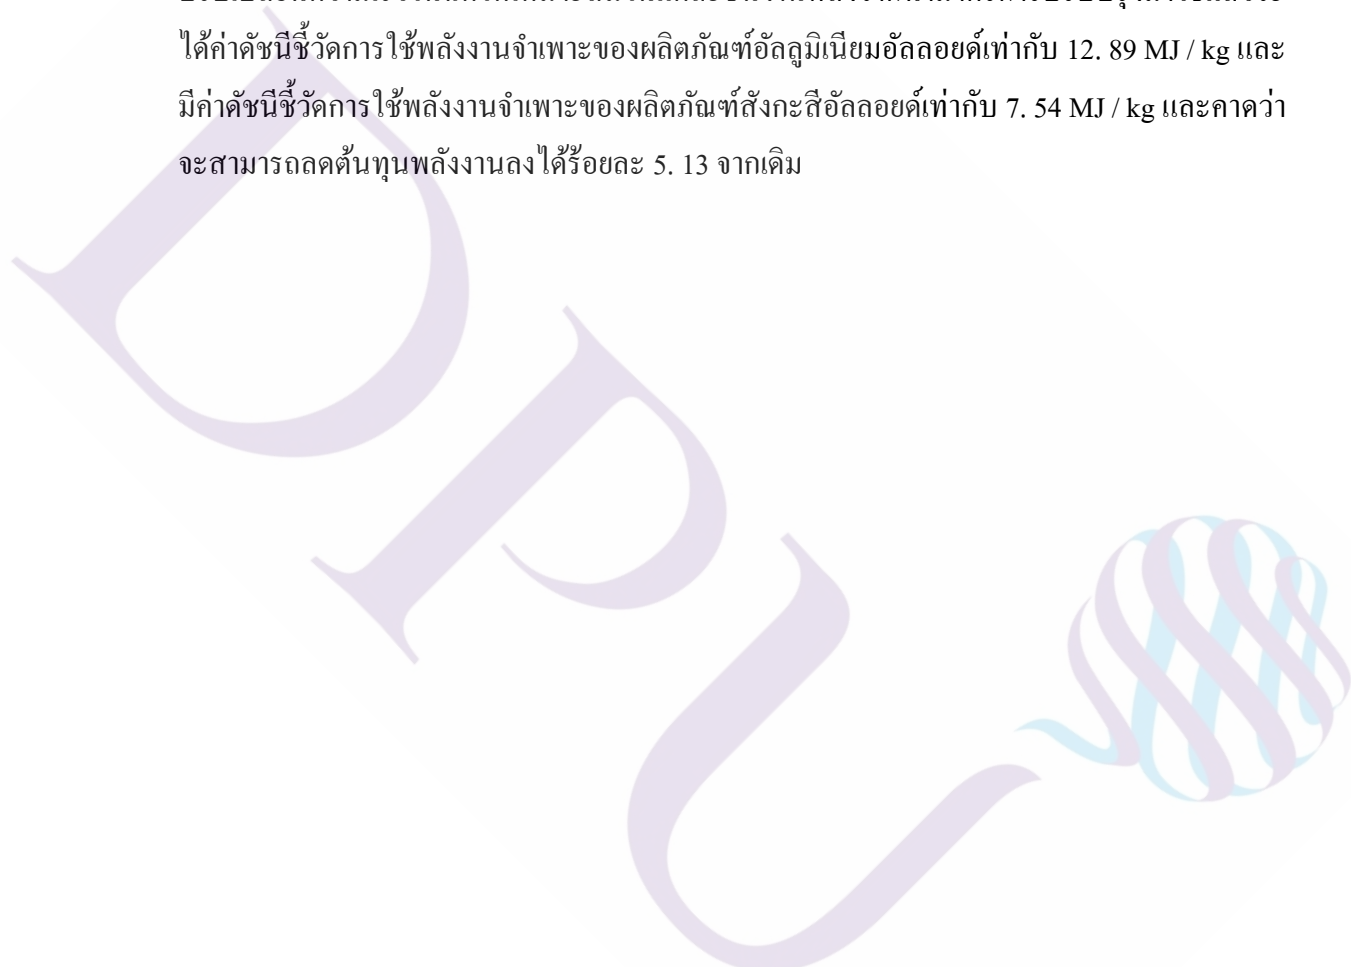


บทที่ 3

ระเบียบวิธีวิจัย

3.1 ศึกษาและวิเคราะห์ผลกระทบระบบของบริษัทกรณีศึกษา ปัจจัยที่ส่งผลต่อการสิ้นเปลืองการใช้พลังงาน


การดำเนินการศึกษาครั้งนี้ ทางผู้จัดทำได้นำปัจจัยทางด้านเครื่องจักร (Machine) คือ ระบบเครื่องอัดและเพิ่มความดันก๊าซธรรมชาติ (Gas Compressor System) ซึ่งมีการใช้พลังงานไฟฟ้าเฉลี่ยต่อวัน อยู่ที่ประมาณ 28,800 kWh จากการใช้พลังงานไฟฟ้าของเครื่องอัดและเพิ่มความดันก๊าซธรรมชาติ (Gas Compressor System) ดังกล่าว จะเห็นได้ว่าการสิ้นเปลืองการใช้พลังงานที่ค่อนข้างสูงเป็นอย่างมาก ดังนั้นทางผู้จัดทำจึงเลือกที่จะนำมาทำการศึกษาในการวิจัย เพื่อลดการใช้พลังงานในกระบวนการผลิตไฟฟ้าและเพิ่มประสิทธิภาพโดยรวมระบบโคเจนเนอเรชัน (Cogeneration Overall Efficiency) ของ โรงไฟฟ้าพลังความร้อนร่วม โดยดำเนินการปรับตั้งสปริงที่ชุดวาล์วควบคุมความดันก๊าซธรรมชาติ (Downstream) ที่สถานีควบคุมความดันและวัดปริมาณก๊าซธรรมชาติจาก ปตท. ในเขตพื้นที่โรงไฟฟ้า อ่างทอง เพาเวอร์ จากเดิมที่แรงดัน 20Bar(a) ไปที่แรงดัน 30 Bar(a) (ตามที่คุณผลิตได้ออกแบบ (SIEMENS SGT-800 คือ ที่แรงดันระหว่าง 27-30 Bar(a)) เพื่อให้ค่าความดันดังกล่าวผ่านไปยังห้องเผาไหม้ของเครื่องกังหันก๊าซได้โดยตรง โดยที่ไม่จำเป็นต้องผ่านไปยังชุดระบบของชุดเครื่องอัดและเพิ่มความดันก๊าซธรรมชาติ (Gas Compressor System) และได้ดำเนินการ Pressure and Leak Testing และ Official test report with R-Stamp และ Re-Test and Certificate suction Piping N₂ Flushing and Blanking of Gas Compressor Long Term Preservation โดยทั้งหมดที่กล่าวมานี้จะต้องไม่เกิดผลกระทบต่อกระบวนการผลิตไฟฟ้าหลักของโรงไฟฟ้าอ่างทอง เพาเวอร์และจะต้องคำนึงถึงความเสี่ยงของระบบและความปลอดภัยในการปฏิบัติงาน

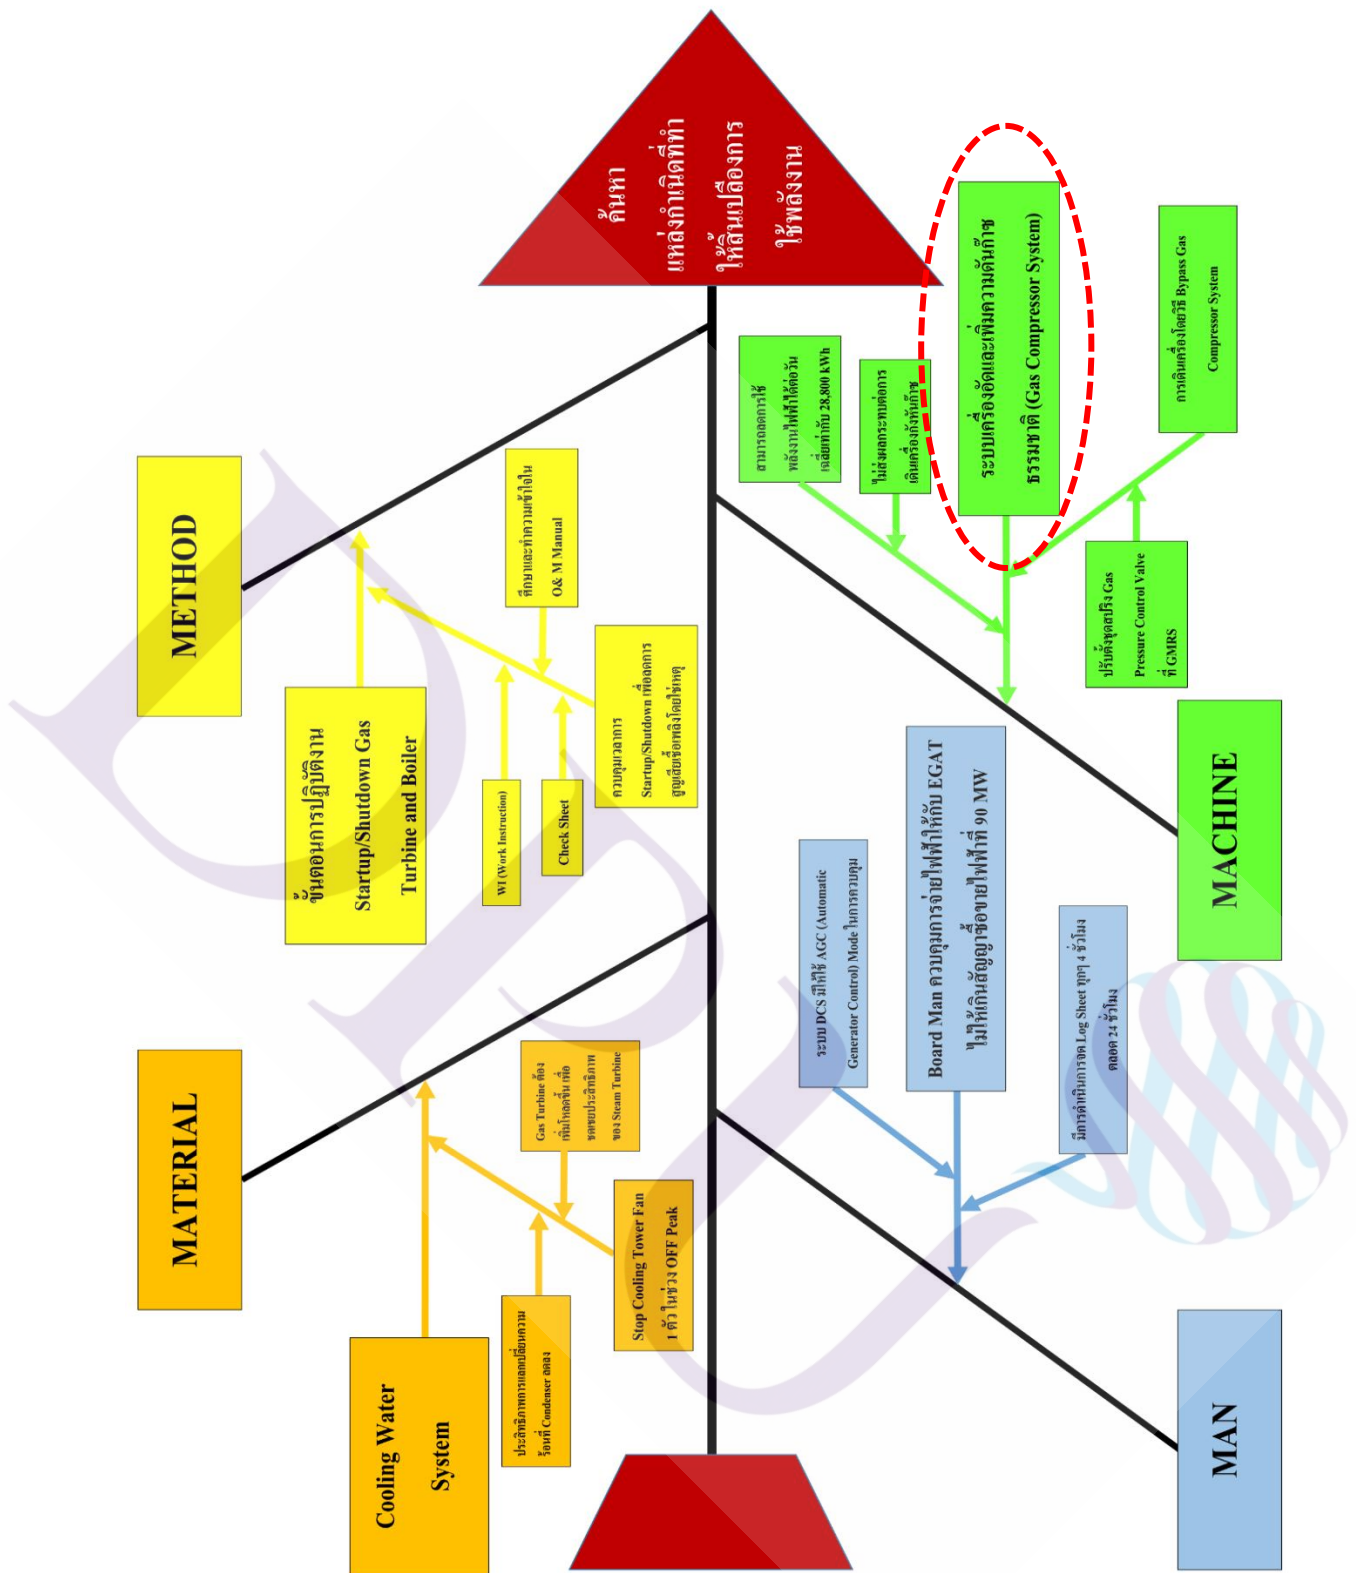

ภาพที่ 3.1 ภาพแสดงฟังก์ชันปลาเพื่อค้นหาปัจจัยที่ส่งผลต่อการเปลี่ยนแปลงการใช้พลังงาน

3.2 แผนผังการวิจัย

ขั้นตอนการดำเนินงานศึกษา การลดการใช้พลังงานในการเดินเครื่องโรงไฟฟ้าพลังความร้อนร่วม กรณีศึกษา โรงไฟฟ้า อ่างทอง เพาเวอร์ เพื่อลดการใช้พลังงานในกระบวนการผลิตไฟฟ้าและเพิ่มประสิทธิภาพโดยรวมระบบโคเจนเนอเรชัน (Cogeneration Overall Efficiency) ของโรงไฟฟ้าพลังความร้อนร่วม โดยมีลำดับขั้นตอนดังนี้

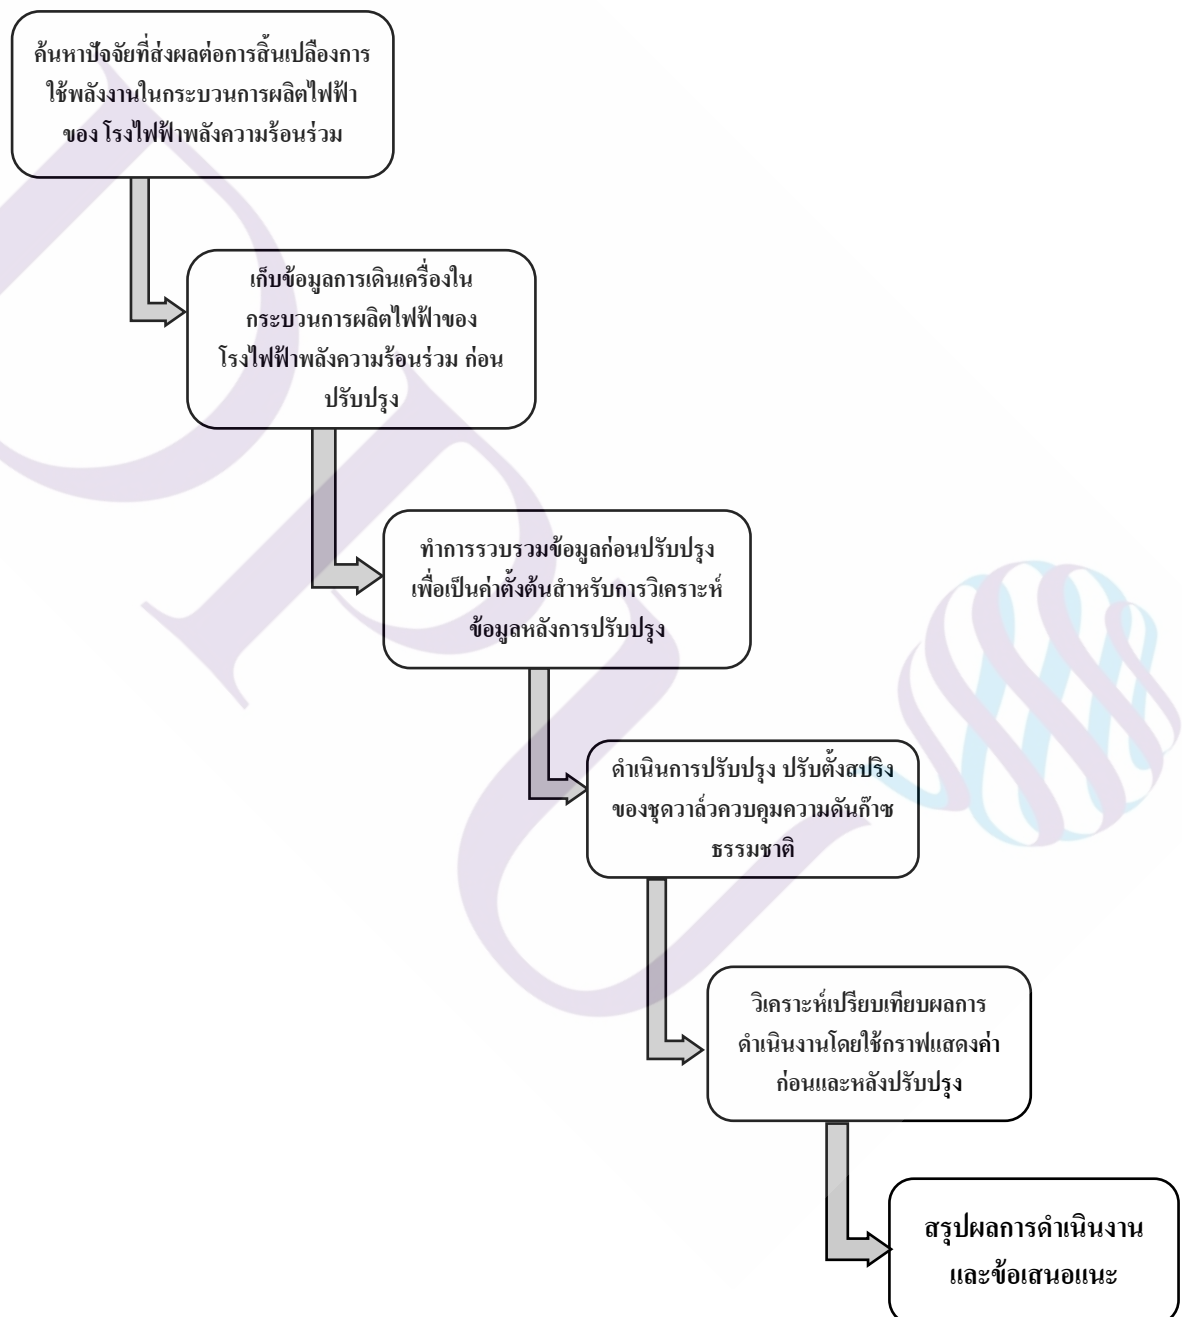


ภาพที่ 3.2 แผนผังขั้นตอนการดำเนินงานศึกษา

3.3 ข้อมูลทั่วไปของโรงไฟฟ้าอ่างทอง เพาเวอร์

บริษัท อ่างทอง เพาเวอร์ จำกัด หรือโรงไฟฟ้าอ่างทอง เพาเวอร์ ตั้งอยู่ เลขที่ 99/2 หมู่ 2 ตำบลหลักฟ้า อำเภอไชโย จังหวัดอ่างทอง ประกอบธุรกิจผลิตไฟฟ้าและไอน้ำ กำลังการผลิตรวมทั้งหมด 142.5 เมกะวัตต์ (MW) และ ไอน้ำ 55 ตันต่อชั่วโมง (Ton/Hr) เวลาหลักในการปฏิบัติงานของโรงไฟฟ้าอ่างทอง เพาเวอร์ แบ่งออกเป็น 2 ลักษณะ ดังนี้ 1. เวลาปฏิบัติงานช่วงเวลากลางวัน (Day Time) ตั้งแต่วันจันทร์ – ศุกร์ เวลา 08:00 – 17:00 น. และ 2. เวลาปฏิบัติการกะ โดยปฏิบัติการกะ 8 ชั่วโมงต่อกะ คือ 1) ปฏิบัติงานกะเช้า (Morning Shift) ตั้งแต่เวลา 07:00 – 15:00 น. 2) ปฏิบัติงานกะบ่าย (Evening Shift) ตั้งแต่เวลา 15:00 – 23:00 น. และ 3) ปฏิบัติงานกะดึก (Night Shift) ตั้งแต่เวลา 23:00 – 07:00 น. ซึ่งพนักงานประจำจะปฏิบัติงานในรูปแบบเวลาดังกล่าวนี้นี้ ตลอดอายุการซื้อขายไฟฟ้าที่ทำสัญญากับการไฟฟ้าฝ่ายผลิตแห่งประเทศไทยหรือ กฟผ. EGAT และสัญญาซื้อขายไฟฟ้าและไอน้ำให้กับบริษัทในเครือตลอด 24 ชั่วโมง




ภาพที่ 3.3 แสดงภาพบริษัท อ่างทอง เพาเวอร์ จำกัด หรือโรงไฟฟ้า อ่างทอง

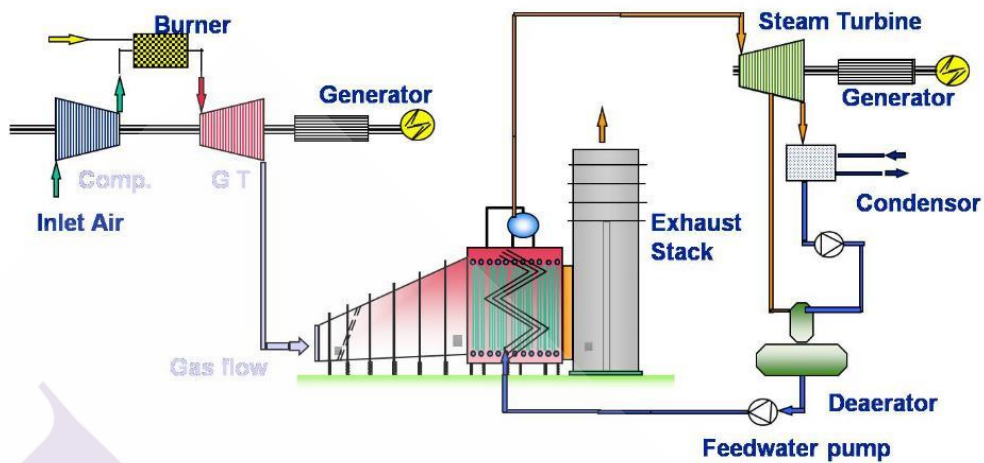


ภาพที่ 3.4 แผนภาพการทำงานของโรงไฟฟ้าพลังความร้อนร่วม

ที่มา: <https://wbsakti.wordpress.com/2012/11/22/heat-recovery-steam-generator-hrsg/>

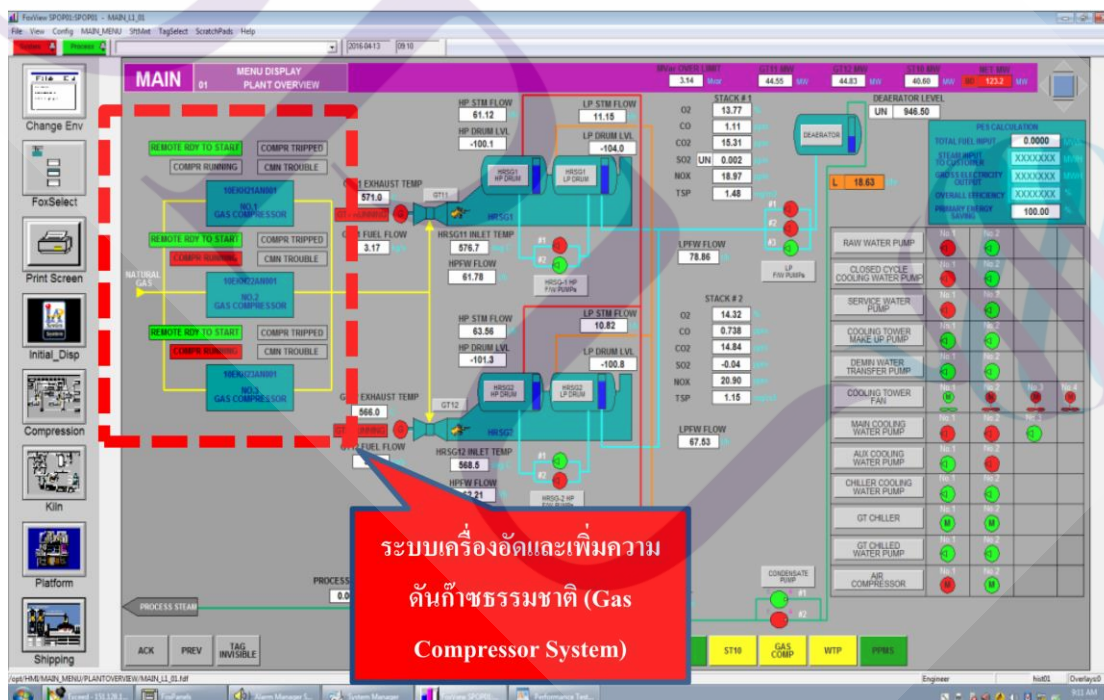

ภาพที่ 3.5 ภาพแสดงสถานการณ์การทำงานของโรงไฟฟ้าอ่างทอง เพาเวอร์ ที่ใช้ชุดเครื่องอัดและเพิ่มความดันก๊าซธรรมชาติในการเดินเครื่องโรงไฟฟ้า

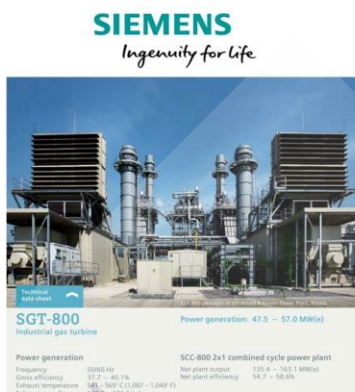

Core engine	Package solutions	Power plants	Service	Fuels	Emissions
Fuel flexibility matters					
Whatever you need: The SGT-800 offers gas only, liquid only (Diesel No.2) or dual fuel (gas/liquid) with on-load fuel-changeover capability. The excellent fuel flexibility allows for high content of inert gases, hydrogen and heavy hydrocarbons without any maintenance impact.					
The low gas supply pressure requirement (27–30 bar[a] / 390–435 psi[a]) reduces the need for a gas compressor on site.					



SIEMENS SGT-800

SPECIFICATION & FUNCTION

- Fuel Gas Supply Pressure = 27 – 30 Bar(a)
- Pilot gas : for sustaining a flame
- Main gas : for power producing
- Central gas : for stabilizing flame

ภาพที่ 3.6 The low gas supply pressure requirement 27-30 Bar(a) or 390-435 psi(a)

และเนื่องด้วยก๊าซธรรมชาติเป็นเชื้อเพลิงที่สะอาด คุณภาพดีและราคาถูกกว่าเชื้อเพลิงชนิดอื่นๆ ทำให้ปริมาณการใช้ก๊าซธรรมชาติของไทยสูงขึ้นเรื่อยๆ ทุกปี ผู้รับสัมปทานสำรวจและผลิตก๊าซจึงได้แสวงหาแหล่งก๊าซใหม่ๆ เพื่อนำก๊าซจากแหล่งที่มีอยู่ขึ้นมาใช้ให้ได้มากที่สุด ขณะเดียวกันหน่วยงานภาครัฐและเอกชน ได้พยายามนำก๊าซธรรมชาติมาใช้ให้ได้ประโยชน์สูงสุด รวมไปถึงการนำเชื้อเพลิงก๊าซธรรมชาตินี้ เพื่อมาผลิตไฟฟ้าด้วยเช่นกัน

ก๊าซธรรมชาติจาก ปตท. เป็นเชื้อเพลิงหลักในการผลิตไฟฟ้าและไอน้ำ เพื่อขายไฟฟ้าตามสัญญาซื้อขายไฟฟ้า PPA* ให้กับกรไฟฟ้าฝ่ายผลิตแห่งประเทศไทยและขายไฟฟ้าและไอน้ำให้กับบริษัทในเครือ

หมายเหตุ. สัญญาซื้อขายไฟฟ้าระยะยาว (Power Purchase Agreement) ส่วนใหญ่ 25 ปี ประเภทของสัญญาแบบ Firm ในรูปแบบของผู้ผลิตไฟฟ้ารายเล็ก (SPP) โรงไฟฟ้า SPP คือโครงการผลิตไฟฟ้าโดยใช้ระบบการผลิตพลังงานความร้อนและไฟฟ้าร่วมกัน หรือการผลิตไฟฟ้าโดยใช้พลังงานหมุนเวียน จำหน่ายไฟฟ้าให้ กฟผ. ไม่เกิน 90 MW สามารถจำหน่ายให้แก่ผู้บริโภคนับบริเวณใกล้เคียงได้โดยตรง

3.4 ประเภทของสถานีก๊าซธรรมชาติ สถานีควบคุมและวัดปริมาณก๊าซธรรมชาติ หรือสถานีก๊าซธรรมชาติ [(Gas Pipeline and Metering & Regulation Station ; (GMRS)]

ปัจจุบันรูปแบบสถานีก๊าซฯที่ใช้กับลูกค้าของ ปตท. มี 2 ประเภท คือ Conventional Type และ Skid Pack Type ทั้งสองประเภทมีความแตกต่างกันที่ปริมาณการใช้งานและชนิดของอุตสาหกรรม ซึ่งผู้ออกแบบสถานีก๊าซฯจะเป็นผู้พิจารณาเลือกใช้ให้เหมาะสมกับอุตสาหกรรมของลูกค้า โดยต้องมีการสำรวจเบื้องต้นทั้งตำแหน่งที่ใช้งานและพิจารณารูปแบบที่เหมาะสมกับทางโรงงาน โดยมีข้อพิจารณาเบื้องต้นดังนี้ Conventional Type ใช้กับโรงไฟฟ้าและอุตสาหกรรมขนาดใหญ่ มีอัตราการใช้ก๊าซฯ มากกว่า 1 MMSCFD (ล้านลูกบาศก์ฟุตมาตรฐาน) และพื้นที่เพียงพอต่อการติดตั้ง



ภาพที่ 3.7 สถานีก๊าซฯ แบบ Conventional Type

ที่มา: [https://dscng.pttplc.com/\(S\(sw4d31d4mllfau5gtb3y4tlt\)\)/Knowledge/Knowledge-inside?p=Metering_and_Regulation_Station](https://dscng.pttplc.com/(S(sw4d31d4mllfau5gtb3y4tlt))/Knowledge/Knowledge-inside?p=Metering_and_Regulation_Station)


Skid Pack Type ใช้กับโรงงานอุตสาหกรรมขนาดเล็ก มีอัตราการใช้ก๊าซฯ น้อยกว่า 1 MMSCFD และพื้นที่ในการติดตั้งสถานีก๊าซฯน้อย



ภาพที่ 3.8 สถานีก๊าซฯ แบบ Skid Pack Type

ที่มา: [https://dscng.pttplc.com/\(S\(sw4d31d4mllfau5gtb3y4tlt\)\)/Knowledge/Knowledge-inside?p=Metering_and_Regulation_Station](https://dscng.pttplc.com/(S(sw4d31d4mllfau5gtb3y4tlt))/Knowledge/Knowledge-inside?p=Metering_and_Regulation_Station)

3.4.1 สถานีก๊าซฯ แบ่งเป็นสองส่วนหลักๆ คือ ส่วนควบคุม (Regulating Equipment) และ ส่วนวัดปริมาตรก๊าซฯ (Metering Equipment) ตามภาพที่ 3.6

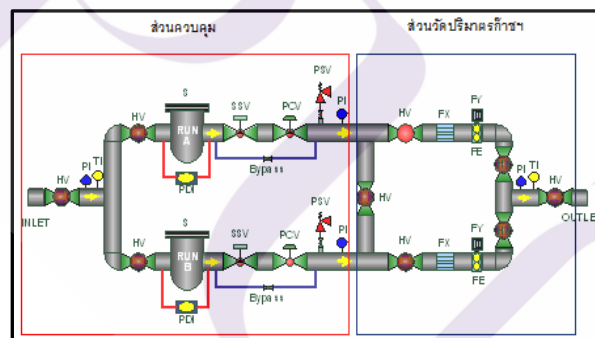


ภาพที่ 3.9 ตัวอย่างแผนผังสถานีควบคุมและวัดปริมาตรก๊าซธรรมชาติ (GMRS)

ที่มา: [https://dscng.pttplc.com/\(S\(sw4d31d4mllfau5gtb3y4tlt\)\)/Knowledge/Knowledge-inside?p=Metering_and_Regulation_Station](https://dscng.pttplc.com/(S(sw4d31d4mllfau5gtb3y4tlt))/Knowledge/Knowledge-inside?p=Metering_and_Regulation_Station)

3.4.2 อุปกรณ์ที่สำคัญภายในสถานีก๊าซฯ มีดังนี้

3.4.2.1 Dry Gas Filter

เป็นอุปกรณ์ที่ใช้กรองสิ่งสกปรกจากฝุ่นที่ติดมากับเนื้อก๊าซฯและระบบท่อ โดยการติดตั้ง Filter จะติดตั้งทั้งสอง Run และสามารถกรองฝุ่นขนาดใหญ่กว่า 5 ไมโครเมตร (ประสิทธิภาพ 98%) โดยในการออกแบบ Dry Gas Filter ต้องสามารถรองรับ Maximum Flow Design และความดันตกคร่อมที่เกิดจากไส้กรองต้องไม่เกิน 80 mbar โดยความเร็วก๊าซฯขณะผ่านไส้กรองจะต้องไม่เกิน 30 cm/s ที่ Maximum Flow Design นอกจากนี้มีอุปกรณ์ Differential Pressure Gauge ติดตั้งไว้เพื่อใช้ตรวจสอบว่าสภาพของ Filter ว่าควรเปลี่ยนหรือไม่

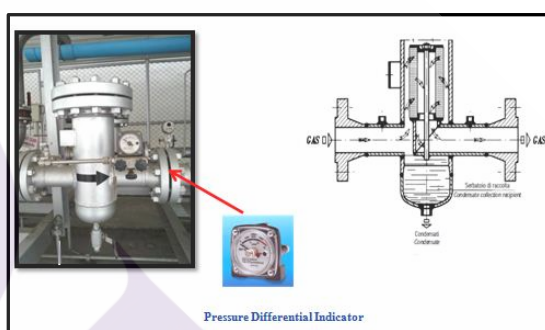

ภาพที่ 3.10 อุปกรณ์ Dry Gas Filter

ที่มา: [https://dscng.pttplc.com/\(S\(sw4d31d4mllfau5gtb3y4tlt\)\)/Knowledge/Knowledge-inside?p=Metering_and_Regulation_Station](https://dscng.pttplc.com/(S(sw4d31d4mllfau5gtb3y4tlt))/Knowledge/Knowledge-inside?p=Metering_and_Regulation_Station)

3.4.2.2 Regulator

เป็นอุปกรณ์ที่ใช้ลดความดันก๊าซฯตามที่ต้องการและควบคุมความดันให้คงที่ตามสัญญาณการซื้อ ขายก๊าซฯ การลดความดันของ Regulator ควรทำงานอยู่ในช่วง 20-80% ของความดันสูงสุดที่ใช้งาน (Maximum Operating Working Pressure) โดยปกติ Regulator จะมีเสียงเกิดขึ้นขณะลดความดัน ดังนั้น ปตท. กำหนดเสียงที่เกิดขึ้นกับอุปกรณ์ดังกล่าวโดยวัดจาก Body ไม่เกิน 85 เดซิเบล (dB) และอุณหภูมิของก๊าซฯที่ออกจาก Regulator ต้องไม่ต่ำกว่า 15 องศาเซลเซียส ที่ Maximum Flow Design บางครั้งในการออกแบบสถานีก๊าซฯถูกจำกัดในเรื่องของพื้นที่ ดังนั้น ปตท. จึงเลือกอุปกรณ์ที่รวมกันระหว่าง Regulator และ Safety shut off Valve (Regulator built-in shut-off valve) เพื่อลดระยะการติดตั้ง ตามภาพที่ 3.8




ภาพที่ 3.11 แสดงอุปกรณ์ Regulator

ที่มา: [https://dscng.ptplc.com/\(S\(sw4d31d4mllfau5gtb3y4tlt\)\)/Knowledge/Knowledge-inside?p=Metering_and_Regulation_Station](https://dscng.ptplc.com/(S(sw4d31d4mllfau5gtb3y4tlt))/Knowledge/Knowledge-inside?p=Metering_and_Regulation_Station)

3.4.2.3 Safety Shut Off Valve (SSV)

เป็นอุปกรณ์ที่ระบุในมาตรฐาน ASME และ IGEM เป็นอุปกรณ์ Safety Device ซึ่งเป็นอุปกรณ์ในกรณีฉุกเฉิน เพื่อป้องกันความดันก๊าซด้าน Outlet เกินกว่าค่าที่สามารถรับได้ของจุดใช้งาน การทำงานของ SSV นั้นใช้ ความดันเป็นตัวควบคุมการทำงาน (Set point) ซึ่งค่า Set point จะต้องอยู่ที่ 50% ของ Spring Range และมีช่วง Spring Range ไม่น้อยกว่า 10% ของค่า set point ด้วย SSV เป็น Safety Device ค่า Accuracy ถูกระบุไม่เกิน 1% และ Response Time ในการปิดตัวสูงสุดไม่เกิน 2 วินาที หลังจากถึงค่า Set point จะปิดการทำงานเร็วเพื่อปกป้องระบบท่อก๊าซและอุปกรณ์ของลูกค้าเสียหาย

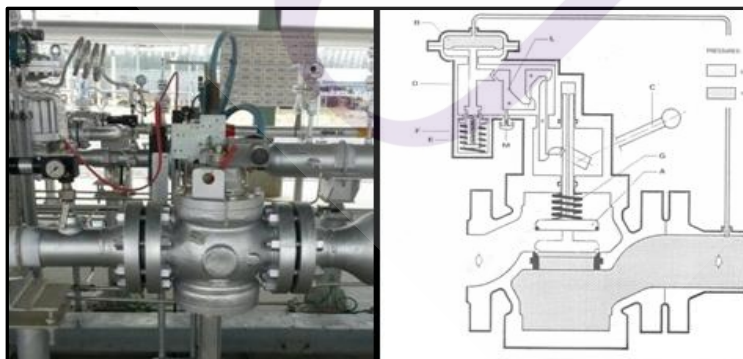


ภาพที่ 3.12 แสดงอุปกรณ์ Safety Shut off Valve

ที่มา: [https://dscng.ptplc.com/\(S\(sw4d31d4mllfau5gtb3y4tlt\)\)/Knowledge/Knowledge-inside?p=Metering_and_Regulation_Station](https://dscng.ptplc.com/(S(sw4d31d4mllfau5gtb3y4tlt))/Knowledge/Knowledge-inside?p=Metering_and_Regulation_Station)

3.4.2.4 Pressure Safety Valve (PSV)

เป็นอุปกรณ์ที่ช่วยลดความดันของสถานีก๊าซฯเมื่อถึงค่า Set point ที่ตั้งไว้โดยวิธีการปล่อยสู่บรรยากาศ โดยสถานีก๊าซฯยังสามารถใช้งานได้ปกติ ต่างกับ SSV ซึ่งสถานีก๊าซฯจะถูกตัดไม่สามารถใช้ก๊าซฯได้ PSV ที่นำมาใช้กับก๊าซฯของ ปตท. เป็นชนิด Pop Up ต้องผลิตและได้รับมาตรฐาน ASME section VIII หรือ API 520 ลักษณะการทำงานที่ 10% ของ Maximum Flow Design และมี Isolation valve แบบ Ball Valve ตัดแยกสำหรับใช้ในการบำรุงรักษาและปรับเทียบ โดยไม่ต้องหยุดการส่งก๊าซฯ

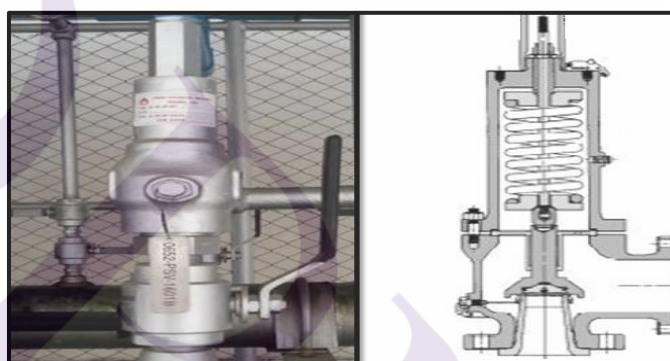


ภาพที่ 3.13 แสดงอุปกรณ์ Pressure Safety Valve

ที่มา: [https://dscng.ptplc.com/\(S\(sw4d31d4mllfau5gtb3y4tlt\)\)/Knowledge/Knowledge-inside?p=Metering_and_Regulation_Station](https://dscng.ptplc.com/(S(sw4d31d4mllfau5gtb3y4tlt))/Knowledge/Knowledge-inside?p=Metering_and_Regulation_Station)

3.4.2.5 Turbine Flow Meter

เป็นอุปกรณ์วัดซื้อขายก๊าซฯที่ใช้วัดปริมาณก๊าซฯ โดยต้องออกแบบให้เป็นตามมาตรฐาน AGA report No.7 และ OIML R32 รวมทั้งการติดตั้ง Turbine meter จะต้องเป็นไปตามมาตรฐาน AGA report No.7 ด้วย ซึ่ง Turbine meter จะต้องมีความ Accurarcy 2% ที่ 20% Qmax และ 1% ที่ 20% - 100% Qmax และมีค่า error ไม่เกิน 0.5% และได้รับการสอบเทียบจาก ปตท. ก่อนนำไปใช้งานและติดตั้ง

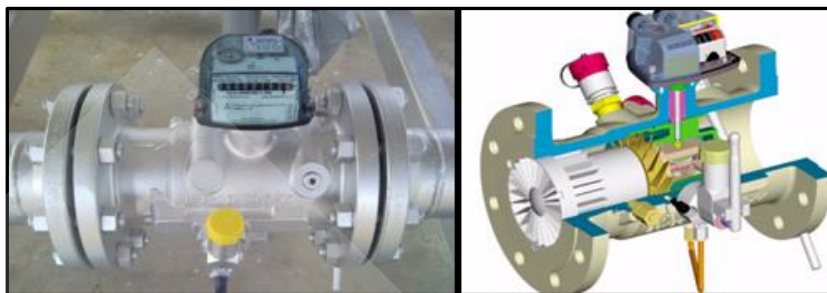

ภาพที่ 3.14 แสดงอุปกรณ์ Turbine Flow Meter

ที่มา: [https://dscng.pttplc.com/\(S\(sw4d31d4mllfau5gtb3y4tlt\)\)/Knowledge/Knowledge-inside?p=Metering_and_Regulation_Station](https://dscng.pttplc.com/(S(sw4d31d4mllfau5gtb3y4tlt))/Knowledge/Knowledge-inside?p=Metering_and_Regulation_Station)

3.4.2.6 Electronic Volume Corrector (EVC)

เป็นชุดอุปกรณ์ใช้วัดและบันทึกปริมาณก๊าซในรูปแบบของข้อมูลอิเล็กทรอนิกส์ จะติดตั้งอยู่กับ Gas Turbine Meter ซึ่ง EVC นั้นจะรับสัญญาณ Pulse จาก Turbine Meter และมี Sensor วัดค่า Pressure ,Temperature ในตัวอุปกรณ์



ภาพที่ 3.15 แสดงอุปกรณ์ Electronic Volume Corrector (EVC)

ที่มา: [https://dscng.pttplc.com/\(S\(sw4d31d4mllfau5gtb3y4tlt\)\)/Knowledge/Knowledge-inside?p=Metering_and_Regulation_Station](https://dscng.pttplc.com/(S(sw4d31d4mllfau5gtb3y4tlt))/Knowledge/Knowledge-inside?p=Metering_and_Regulation_Station)

3.5 ข้อมูลและขั้นตอนการดำเนินการ

3.5.1 วิธีการเก็บรวบรวมข้อมูล

3.5.1.1 แผนกเดินเครื่อง แผนกซ่อมบำรุงและแผนกประสิทธิภาพ ร่วมประชุมปรึกษาหารือ การคัดเลือกระบบเพื่อทำการศึกษาค่าการประหยัดพลังงาน โดยใช้เครื่องมือ ผังแสดงเหตุและผล (Cause-and-Effect Diagram) และร่วมดำเนินการจัดตั้งผู้รับผิดชอบและหน้าที่ต่างๆ ในการรวบรวมข้อมูลที่ได้ทำการประชุม เพื่อนำข้อมูลดังกล่าว มาวิเคราะห์ และนำเสนอความคืบหน้าของงานในแต่ละรายสัปดาห์และรายเดือน

3.5.1.2 ผู้รับผิดชอบในการรวบรวมข้อมูลทั้งหมด ที่ได้จากแผนกเดินเครื่อง แผนกซ่อมบำรุง และทำสรุปรายงานต่อที่ประชุม แต่ละรายสัปดาห์และรายเดือน คือ แผนกแผนกประสิทธิภาพ

3.5.1.3 การวิเคราะห์ผลกระทบและความเสี่ยงในการที่จะทำการศึกษาค่าการประหยัดพลังงาน

3.5.1.4 รวบรวมข้อมูลและวิเคราะห์จากเอกสารและการเดินเครื่องของโรงไฟฟ้า โดยใช้เครื่องมือ กราฟ (Graph) ใช้ในการเปรียบเทียบข้อมูลผลการทดลอง ก่อนปรับปรุงและหลังปรับปรุง

3.5.1.5 แผนกเดินเครื่อง แผนกซ่อมบำรุงบำรุงทบทวนเอกสารด้านวิศวกรรม

3.5.1.6 แผนกซ่อมบำรุงศึกษาด้านวิศวกรรมการประเมินของชุดเครื่องอัดและเพิ่มความดันของก๊าซธรรมชาติและชุดควาล์วควบคุมความดันก๊าซในการเครื่องกังหันก๊าซ

3.5.1.7 แผนกเดินเครื่อง รับผิดชอบหน้าที่ดำเนินการ รวบรวมข้อมูลในแต่ละวัน โดยใช้เครื่องมือ ใบตรวจสอบ (Check Sheet) ใช้ในการเก็บรวบรวมข้อมูลในช่วงการทดลอง ก่อนปรับปรุงและหลังปรับปรุง ดังนี้ แรงดันก๊าซต้นทาง (Upstream) ของแต่ละวัน แรงดันก๊าซที่ผ่านชุดควาล์วควบคุมความดัน (Downstream) ของแต่ละวัน การใช้พลังงานไฟฟ้ารวมของโรงไฟฟ้าของแต่ละวัน (Plant Station Service Energy: kWh) การใช้ปริมาณเชื้อเพลิงก๊าซธรรมชาติของแต่ละวัน (Fuel Gas Consumption: MMBTU) และประสิทธิภาพของการเดินเครื่องโดยรวมของแต่ละวัน [Overall Plant Net Cogen. Efficiency LHV (dry) (%)] และนำข้อมูลดังกล่าวจัดเก็บไว้ใน Sever กลางของบริษัท เพื่อง่ายต่อการเข้าไปใช้งานและตรวจสอบได้ด้วยตนเอง ทำการทดสอบและเก็บบันทึกข้อมูลที่หน้างานก่อนการปรับปรุงการตั้งค่าที่ชุดควาล์วควบคุมความดันก๊าซในการเดินเครื่องกังหันก๊าซและเก็บบันทึกข้อมูลของชุดเครื่องอัดและเพิ่มความดันของก๊าซธรรมชาติ

3.5.1.8 แผนกซ่อมบำรุง รับผิดชอบหน้าที่ จัดทำกระบวนการจัดซื้อจัดจ้างที่ผู้รับเหมาที่จะเข้ามาดำเนินการปรับปรุงและเพื่อทำการปรับตั้งค่าที่ชุดควาล์วควบคุมความดันก๊าซในการ

เดินเครื่องกังหันก๊าซและระบบของชุดเครื่องอัดและเพิ่มความดันของก๊าซธรรมชาติ ในช่วงเวลาที่มีการหยุดระบบของการเดินเครื่องกังหันก๊าซ เพื่อทำการปรับปรุงระบบในโครงการดังกล่าวมานี้

3.5.1.9 แผนกประสิทธิภาพ จัดทำรายงานรวบรวมข้อมูล ส่งผลสรุปและนำเสนอรายงานต่อทางบริษัท ปตท. จำกัด (มหาชน)


3.5.1.10 กำหนดและวางแผนสำหรับการปรับตั้งค่าที่ชุดควาล์วควบคุมความดันก๊าซในการเดินเครื่องกังหันก๊าซและระบบของชุดเครื่องอัดและเพิ่มความดันของก๊าซธรรมชาติ

3.5.1.11 ทำการทดสอบและเก็บบันทึกข้อมูลที่หน้างาน หลังการปรับตั้งค่าที่ชุดควาล์วควบคุมความดันก๊าซธรรมชาติ

3.5.1.12 ทำการสรุปผลจากการทดสอบและเปรียบเทียบข้อมูลก่อนและหลังปรับปรุง โดยใช้เครื่องมือ แผนภูมิควบคุม (Control Chart) ใช้ในการวิเคราะห์ข้อมูลในช่วงการทดลอง ก่อนปรับปรุงและหลังปรับปรุง และ กราฟ (Graph) ใช้ในการสรุปผลการทดลอง หลังปรับปรุง

3.5.2 เครื่องมือที่ใช้ในการเก็บข้อมูล


ในการเปรียบเทียบข้อมูลและบันทึกข้อมูล เพื่อใช้ในทางสถิติ นั้น ต้องมีเครื่องมือที่ทันสมัย เทียบตรง และมีความแม่นยำสูงในการโหลดข้อมูลและวัดผลของค่าพลังงานไฟฟ้า ในส่วนของการปรับปรุงการลดพลังงานไฟฟ้าที่ใช้ขับเคลื่อนของชุดเครื่องอัดและเพิ่มความดันก๊าซ ในการเดินเครื่องผลิตกระแสไฟฟ้า ของโรงไฟฟ้า อ่างทอง เพาเวอร์ โดยมีทางเลือกที่จะมีการปรับตั้งค่าความดันก๊าซที่ผ่านชุดควาล์วควบคุมความดัน (Downstream) ที่สถานีควบคุมความดันและวัดปริมาณก๊าซธรรมชาติ จาก ปตท. ในเขตพื้นที่ของโรงไฟฟ้า อ่างทอง เพาเวอร์ เพื่อลดการใช้พลังงานไฟฟ้าของชุดเครื่องอัดและเพิ่มความดันก๊าซนั้น ได้นำเครื่องมือที่ใช้ในการวิเคราะห์และตรวจสอบข้อมูลพลังงานไฟฟ้า เพื่อนำมาใช้ในทางสถิติ โดยมีเครื่องมือที่ใช้ในการเก็บข้อมูล ดังนี้

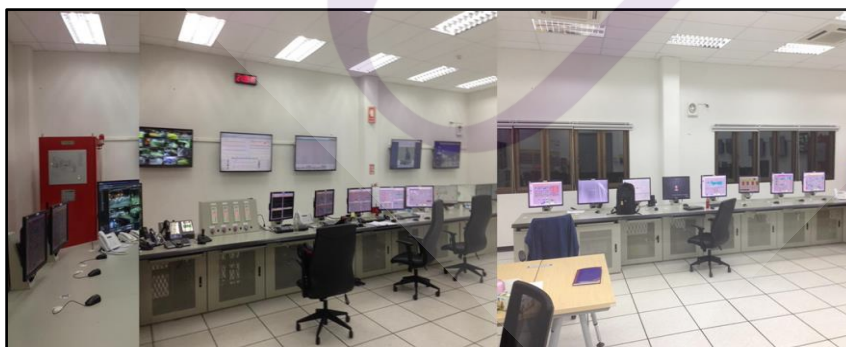

ภาพที่ 3.16 ห้องควบคุม Central Control Room (CCR) การเดินเครื่องของโรงไฟฟ้า อ่างทอง เพาเวอร์


3.5.2.1 Software SCADA Wonderware Intouch by Schneider Electric

[<https://www.wonderware.com/industries/power-and-utilities/>] เป็นเครื่องมือที่ใช้สำหรับดาวน์โหลดข้อมูลพลังงานไฟฟ้าและข้อมูลพารามิเตอร์ต่างๆได้ เป็นระบบเครื่องมืออัตโนมัติสำหรับตรวจสอบเก็บรวบรวมข้อมูลและบริหารระบบควบคุมของกระบวนการผลิตภายในโรงงานและเป็นระบบที่สามารถเอาสัญญาณจากตัววัด ที่อยู่ในรูปของไฟฟ้า หรือพลังงานอื่น ๆ มาแปลงอยู่ในรูปของข้อมูลที่เป็นตัวเลข เพื่อใช้ทำประโยชน์ต่าง ๆ ซึ่งทำให้สามารถนำเข้าข้อมูลจาก PLC เข้าสู่โปรแกรมเช่น MS Excel หรือโปรแกรม Client อื่น ๆ ที่ติดต่อกับ DDE Server ได้ให้กับผู้ปฏิบัติงานในระยะไกล และง่ายต่อการใช้งานสำหรับผู้ดูแล โดยผู้ศึกษาได้นำเครื่องมือนี้มาทำการตรวจวัดวิเคราะห์คุณภาพไฟฟ้าและพลังงาน และเก็บข้อมูลต่างๆ เพื่อนำมาประกอบรายการการคำนวณและวิเคราะห์หาค่าพลังงานไฟฟ้า ค่าแรงดันเชื้อเพลิงก๊าซธรรมชาติ จาก ปตท. ที่ใช้ในการเดินเครื่องมอเตอร์ชุดเครื่องอัดและเพิ่มความดันก๊าซ และนำค่าพลังงานไฟฟ้าที่ใช้เดินเครื่องมอเตอร์ชุดเครื่องอัดและเพิ่มความดันก๊าซ มาคิดคำนวณเป็นค่าใช้จ่ายที่สูญเสียไปทั้งปี โดยคิดออกมาในรูปของค่าพลังงานไฟฟ้า(kWh) และคำนวณออกมาในรูปของค่าใช้จ่ายที่สามารถประหยัดพลังงานไฟฟ้าต่อปี โดยโหลดข้อมูลจาก PLC ผ่าน Software SCADA Wonderware Intouch by Schneider Electric เข้าสู่ Excel และนำไปเข้าสู่ตรรกะคำนวณต่อไป

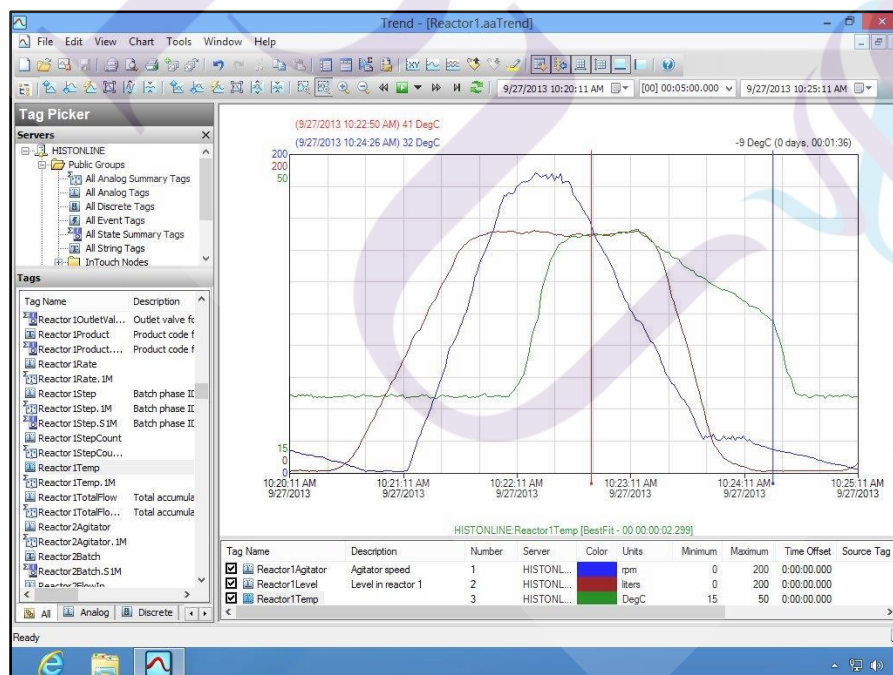

ภาพที่ 3.17 Overview Software SCADA Wonderware Intouch by Schneider Electric

3.5.2.2 Software Foxboro Distributed Control System (DCS) Solutions by Schneider Electric Foxboro Evo Process Automation System [<http://www.schneider-electric.com/en/product-range/63680-foxboro-evo-process-automation-system/>] ทำหน้าที่คำนวณและประมวลผลข้อมูลที่ได้จากฮาร์ดแวร์ต่าง ๆ เช่น PLC, Controller, DCS, RTU แล้วแสดงข้อมูลทางหน้าจอ หรือส่งสัญญาณควบคุมฮาร์ดแวร์ดังกล่าว เช่น หากอุณหภูมิของอุปกรณ์สูงเกินพิกัด ให้ทำการปิดอุปกรณ์นั้น เป็นต้น โดยสั่งงานผ่าน PLC หรือ Controller ที่ติดต่อกันอยู่ ทั้งนี้ SCADA สามารถเก็บรวบรวมข้อมูลที่ได้จากระบบควบคุมทั้งหมดไว้ในฐานข้อมูลเพื่อให้พนักงานหรือโปรแกรมอื่น ๆ สามารถนำไปใช้งานได้ SCADA นั้นเข้าไปมีส่วนในงานควบคุมทั้งเล็กและใหญ่ที่ต้องการแสดงผล แลกเปลี่ยนข้อมูล หรือควบคุมระบบต่าง ๆ จากส่วนกลาง เพื่อการทำงานของระบบรวมที่สัมพันธ์กัน มองเห็นภาพรวมได้อย่างชัดเจนและมีความรวดเร็วต่อเหตุการณ์ต่าง ๆ ที่เกิดขึ้น ระบบ SCADA ในปัจจุบันมีความสามารถในการสื่อสาร ควบคุม และประมวลผลข้อมูลจาก I/O ของอุปกรณ์เช่น PLC, DCS, RTU ได้ถึงระดับที่เกินหนึ่งแสน I/O แล้ว และได้รับการพัฒนาให้มีความสามารถรองรับความต้องการใหม่ ๆ ของผู้ใช้งานอย่างต่อเนื่องตลอดมา SCADA ประกอบด้วยส่วนประกอบหลักคือ หน่วยติดต่อและปฏิบัติการของผู้ใช้ระดับบน หน่วยควบคุมระยะไกล และหน่วยติดต่อระยะไกล ผู้ใช้สามารถตรวจสอบและควบคุมกระบวนการผลิตภายในโรงงานอุตสาหกรรมเป็นระยะทางไกลได้โดย หน่วยติดต่อและปฏิบัติการของผู้ใช้ระดับบนเป็นเครื่องมือปฏิบัติการของผู้ใช้สำหรับตรวจสอบและควบคุม กระบวนการผลิตเชื่อมต่อกับหน่วยควบคุมระยะไกล หน่วยควบคุมระยะไกลติดต่อกับหน่วยติดต่อระยะไกลโดยการสื่อสารข้อมูลแบบดิจิทัลทางระบบเครือข่ายคอมพิวเตอร์ และหน่วยติดต่อระยะไกลเป็นเครื่องมือเชื่อมต่อกับกระบวนการผลิต ประกอบด้วย หน่วยรับสัญญาณ และส่งสัญญาณของสัญญาณชนิดอนาล็อกและสัญญาณชนิดดิจิทัล รวมถึงส่วนเก็บประวัติ History และอื่นๆ

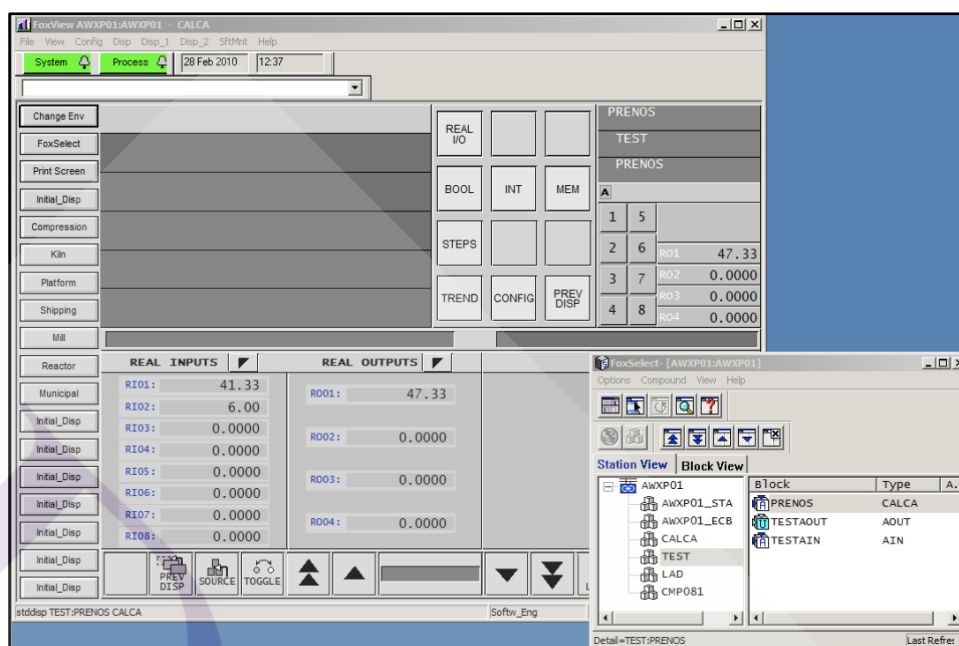

ภาพที่ 3.18 Overview Foxselect Software Foxboro Distributed Control System (DCS) Solutions by Schneider Electric Foxboro Evo Process Automation System

3.5.2.3 เครื่องมือคุณภาพ 7 ชนิด (7 QC Tools)

ผังแสดงเหตุและผล (Cause-and-Effect Diagram) ใช้ในการวิเคราะห์หาความสำคัญและที่มาของปัญหา, กราฟ (Graph) ใช้ในการเปรียบเทียบข้อมูลผลการทดลอง ก่อนปรับปรุงและหลังปรับปรุง รวมถึงสรุปผลการทดลอง, ใบตรวจสอบ (Check Sheet) ใช้ในการเก็บรวบรวมข้อมูลในช่วงการทดลอง ก่อนปรับปรุงและหลังปรับปรุง และแผนภูมิควบคุม (Control Chart) ใช้ในการวิเคราะห์ข้อมูลในช่วงการทดลอง ก่อนปรับปรุงและหลังปรับปรุง

3.5.3 การวิเคราะห์ข้อมูล

ในขั้นตอนของการวิเคราะห์ข้อมูลที่ได้จากการสำรวจแนวคิดและการปรับปรุงปัญหา โดยใช้ซอฟต์แวร์ Software SCADA Wonderware Intouch by Schneider Electric และ Software Foxboro Distributed Control System (DCS) Solutions by Schneider Electric Foxboro Evo Process Automation System โดยโหลดข้อมูลค่าพลังงานไฟฟ้าที่ใช้จริง ผ่าน Software รวมถึงบันทึกข้อมูลในขณะที่โรงไฟฟ้าเดินเครื่องเต็มประสิทธิภาพของกำลังการผลิต (Base load operation) ตามชั่วโมงการทำงานที่ได้วางแผนเดินเครื่องไว้ เพื่อนำข้อมูลทั้งหมดมาทำการวิเคราะห์ในการปรับปรุงการลดพลังงานไฟฟ้าที่ใช้ขับเคลื่อนมอเตอร์ของชุดเครื่องอัดและเพิ่มความดันก๊าซ ในการเดินเครื่องผลิตกระแสไฟฟ้า ของโรงไฟฟ้า อ่างทอง เพาเวอร์ เพื่อให้ทราบถึงประโยชน์ที่จะได้รับสูงสุด ทำการ

เปรียบเทียบข้อมูลก่อนและหลังปรับปรุง โดยนำไปประยุกต์ใช้กับเครื่องมือวัดคุณภาพ 7 ชนิด (7 QC Tools)



ภาพที่ 3.19 Software SCADA Wonderware Intouch by Schneider Electric

ที่มา: http://smartadeco.com/?page_id=103



ภาพที่ 3.20 Foxboro Distributed Control System (DCS) Solutions by Schneider Electric

ที่มา: <https://www.schneider-electric.com/en/work/products/industrial-automation-control/foxboro-dcs/>

3.5.4 วิธีการรวบรวมข้อมูล

ในแต่ละวันการเดินเครื่องของโรงไฟฟ้า อ่างทอง จะมีรูปแบบการเดินเครื่องที่ไม่แตกต่างกัน เนื่องจากการขายไฟฟ้าให้กับ กฟผ. นั้น จะมีรูปแบบการขายไฟฟ้าที่เป็นช่วงเวลา ที่กำหนดแผนการจาก กฟผ. คือ ช่วง PEAK หรือช่วงเวลาที่มีการใช้ไฟฟ้าสูงสุด ช่วงเวลา 08:00 – 22:00 น. และ ช่วง OFF PEAK หรือช่วงเวลาที่มีการใช้ไฟฟ้าลดลง ช่วงเวลา 22:00 – 08:00 น. ดังนั้นเอง ทางโรงไฟฟ้าจึงต้องปฏิบัติงานตลอด 24 ชั่วโมง เพื่อขายไฟฟ้าให้กับ กฟผ. ได้ตามสัญญาซื้อขายไฟฟ้า ทางโรงไฟฟ้า อ่างทอง จึงต้องมีการตรวจสอบเครื่องจักรและจุดบันทึกพารามิเตอร์ต่างๆที่สำคัญในการเดินเครื่องโรงไฟฟ้า เพื่อตรวจสอบความผิดปกติ และตรวจสอบการทำงานของเครื่องจักร เพื่อไม่ให้ส่งผลกระทบต่อกรเดินเครื่อง เพื่อขายไฟฟ้าให้กับ กฟผ. และลูกค้าในพื้นที่

ข้างเคียง ได้อย่างมั่นคงและเป็นการสร้างความน่าเชื่อถือและความไว้วางใจต่อลูกค้า ซึ่งการตรวจสอบจะดำเนินการทุกๆ 4 ชั่วโมง โดยแผนกเดินเครื่อง และทุกๆ ที่ขงคืนของทุกวันจะทำการสรุปการใช้พลังงานแต่ละวันหรือ Daily Consumption เพื่อทำรายงาน Daily Report ต่อผู้จัดการโรงไฟฟ้าและเป็นข้อมูลให้กับแผนกประสิทธิภาพ ในการนำไปดำเนินการรวบรวมสรุปผลต่อไป




ภาพที่ 3.21 ภาพแสดงการรวบรวมข้อมูลก่อนการปรับปรุง ข้อมูลจากหน้างาน ข้อมูลจากการตรวจสอบการทำงานของเครื่องจักรที่ห้อง Control Room

3.5.5 การตัดแยกระบบและปรับตั้งสปริงของชุดวาล์วควบคุมความดันก๊าซธรรมชาติ ที่สถานีควบคุมความดันและวัดปริมาณก๊าซธรรมชาติของ ปตท. ในเขตพื้นที่โรงไฟฟ้าอ่างทอง และระบบเครื่องอัดและเพิ่มความดันก๊าซธรรมชาติ (Gas Compressor System) และ Pressure and Leak Testing with official test report with R-Stamp และ Re-Test and Certificate suction Piping N2 Flushing and Blanking of Gas Compressor Long Term Preservation.



ภาพที่ 3.22 ภาพแสดงการตัดแยกระบบและปรับตั้งสปริงของชุดวาล์วควบคุมความดันก๊าซธรรมชาติ และ Pressure and Leak Testing with official test report with R-Stamp และ Re-Test and Certificate suction Piping N2 Flushing and Blanking of Gas Compressor Long Term Preservation.


ปรับตั้งสปริงที่ชุดวาล์วควบคุมความดันก๊าซธรรมชาติ (Downstream) ที่สถานีควบคุมความดันและวัดปริมาณก๊าซธรรมชาติจาก ปตท. ในเขตพื้นที่โรงไฟฟ้าอ่างทอง เพาเวอร์ จากเดิมที่แรงดัน 20 Bar(a) ไปที่แรงดัน 30 Bar(a) (ตามที่ผู้ผลิตได้ออกแบบ (SIEMENS SGT-800)) คือ 27-30 Bar(a)) เพื่อให้ค่าความดันดังกล่าวผ่านไปยังห้องเผาไหม้ของเครื่องกังหันก๊าซได้โดยตรง โดยที่ไม่จำเป็นต้องผ่านไปยังระบบของชุดเครื่องอัดและเพิ่มความดันก๊าซธรรมชาติ (Gas Compressor System) และ Pressure and Leak Testing และ Official test report with R-Stamp และ Re-Test and Certificate suction Piping N2 Flushing and Blanking of Gas Compressor Long Term Preservation.

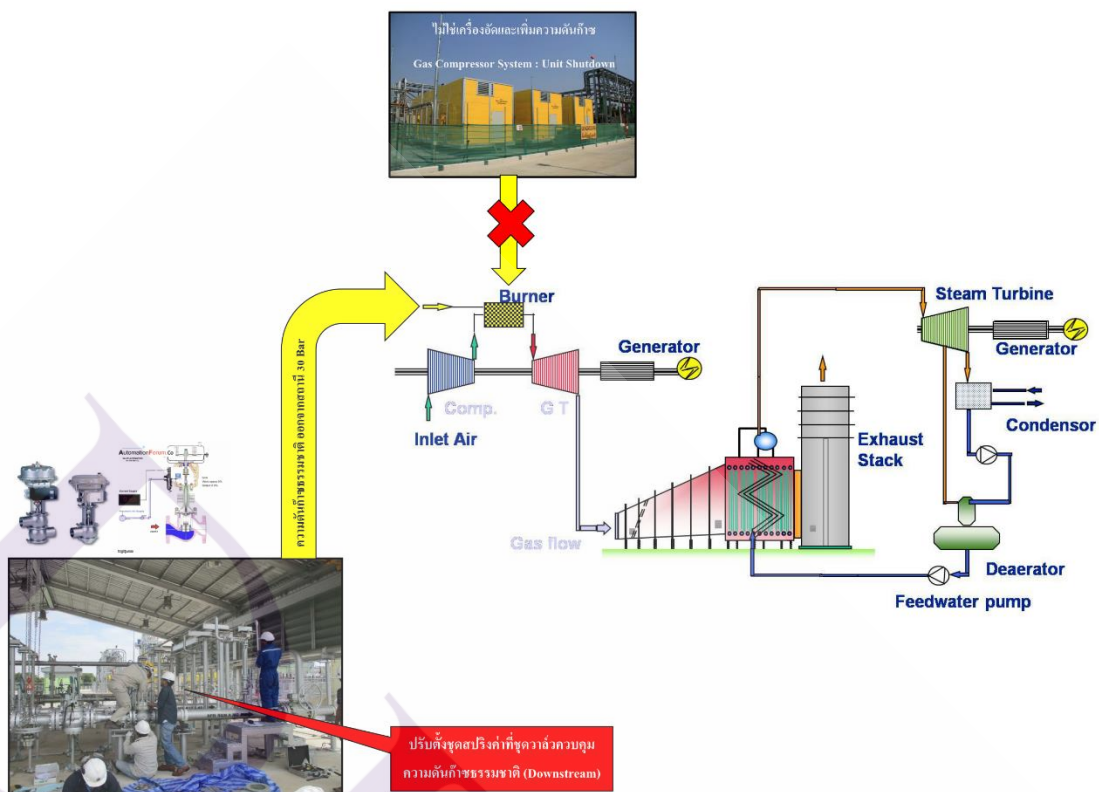

ภาพที่ 3.23 ภาพแสดงวงจรการทำงานของโรงไฟฟ้าพลังความร้อนร่วม หลังการปรับปรุง


3.5.6 รวบรวมข้อมูลก่อนดำเนินการปรับปรุง ในช่วงเดือน มิ.ย. 2559 – พ.ย. 2559 เพื่อเป็นค่าตั้งต้นสำหรับเปรียบเทียบกับค่าหลังการปรับปรุง โดยใช้เครื่องมือ คือ กราฟ (Graph) ใบตรวจสอบ (Check Sheet) และแผนภูมิควบคุม (Control Chart) ซึ่งจะจำแนกกลุ่มตัวอย่างที่นำมาวิเคราะห์และรวบรวมข้อมูลก่อนดำเนินการปรับปรุงทั้ง 5 ส่วน ได้ดังนี้

3.5.6.1 ข้อมูลค่าความดันเชื้อเพลิงก๊าซธรรมชาติต้นทาง (Upstream) ก่อนทำการปรับปรุง โดยการรวบรวมและการวิเคราะห์ข้อมูลทางสถิติของค่าความดันเฉลี่ยต่อเดือน ในช่วงเดือน มิ.ย. 2559 – พ.ย. 2559 ของการเดินเครื่องโรงไฟฟ้า ที่สถานีควบคุมความดันและวัดปริมาณก๊าซธรรมชาติจาก ปตท. ในเขตพื้นที่โรงไฟฟ้าอ่างทอง เพาเวอร์ ในขณะที่เดินเครื่องอัดและเพิ่มความดันก๊าซธรรมชาติ (Gas Compressor System)

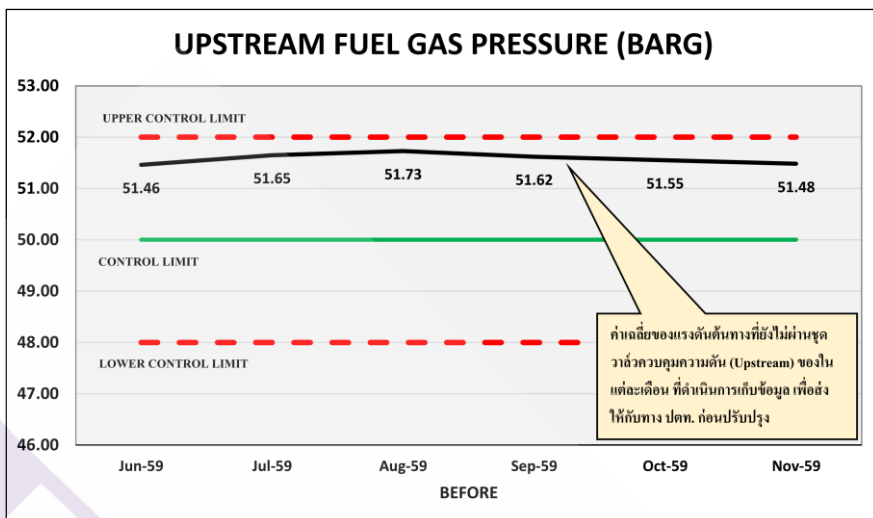


ภาพที่ 3.24 แสดงค่าเฉลี่ยแรงดันขาเข้า (Upstream) ก่อนทำการปรับปรุง

3.5.6.2 ข้อมูลค่าความดันเชื้อเพลิงก๊าซธรรมชาติ ก่อนปรับตั้งค่าแรงดันที่ชุดวาล์วควบคุมความดันก๊าซธรรมชาติ (Downstream) ก่อนทำการปรับปรุง โดยการรวบรวมและการวิเคราะห์ข้อมูลทางสถิติของค่าความดันเฉลี่ยต่อเดือน ในช่วงเดือน มิ.ย. 2559 – พ.ย. 2559 ของการเดินเครื่องโรงไฟฟ้า ที่สถานีควบคุมความดันและวัดปริมาณก๊าซธรรมชาติจาก ปตท. ในเขตพื้นที่โรงไฟฟ้าอ่างทอง เพาเวอร์ ในขณะที่เดินเครื่องอัดและเพิ่มความดันก๊าซธรรมชาติ (Gas Compressor System)

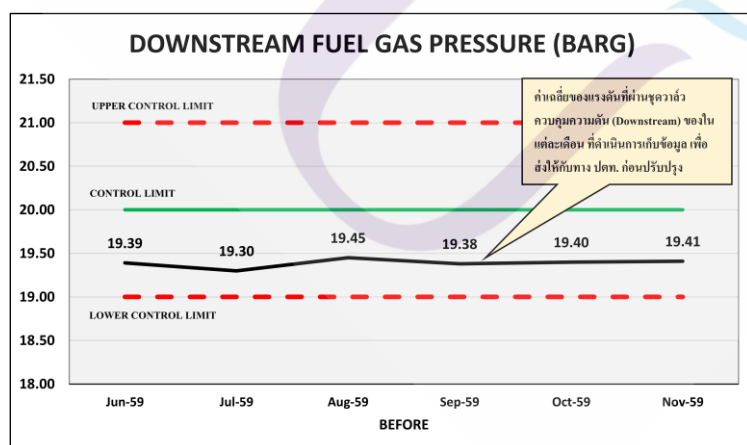


ภาพที่ 3.25 แสดงค่าเฉลี่ยแรงดันขาออกของชุดวาล์วควบคุมความดันก๊าซธรรมชาติ (Downstream) ก่อนทำการปรับปรุง

3.5.6.3 ข้อมูลการใช้พลังงานไฟฟ้า (Plant Station Service Energy (kWh)) ก่อนทำการปรับปรุง โดยการรวบรวมและการวิเคราะห์ข้อมูลทางสถิติของค่าเฉลี่ยต่อเดือน ในช่วงเดือน มิ.ย. 2559 – พ.ย. 2559 ของโรงไฟฟ้า อ่างทอง เพาเวอร์ ในขณะที่เดินเครื่องอัดและเพิ่มความดันก๊าซธรรมชาติ (Gas Compressor System)

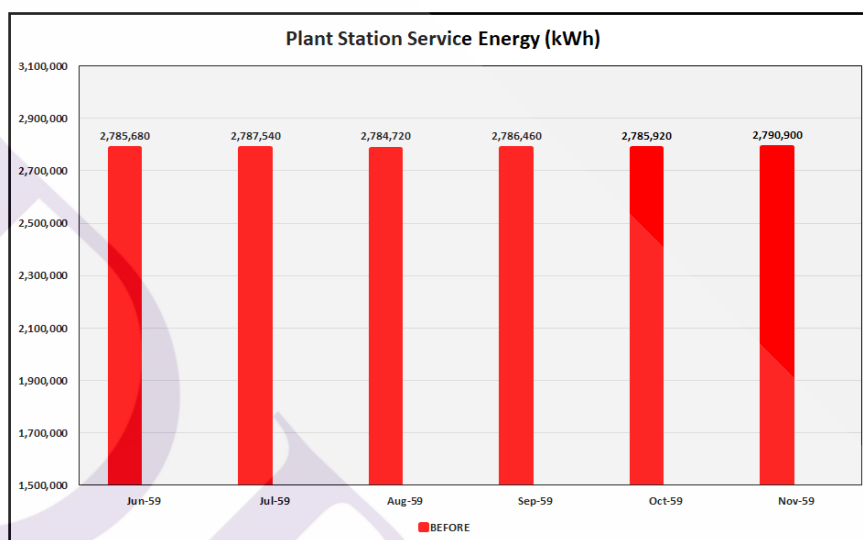


ภาพที่ 3.26 แสดงค่าเฉลี่ยการใช้พลังงานไฟฟ้า ก่อนทำการปรับปรุง

3.5.6.4 ข้อมูลการใช้ปริมาณเชื้อเพลิงก๊าซธรรมชาติ ในการผลิตกระแสไฟฟ้า (Fuel Gas Consumption (MMBTU)) ก่อนทำการปรับปรุง โดยการรวบรวมและการวิเคราะห์ข้อมูลทางสถิติของค่าเฉลี่ยต่อเดือน ในช่วงเดือน มิ.ย. 2559 – พ.ย. 2559 ของโรงไฟฟ้า อ่างทอง เพาเวอร์ ในขณะที่เดินเครื่องอัดและเพิ่มความดันก๊าซธรรมชาติ (Gas Compressor System)

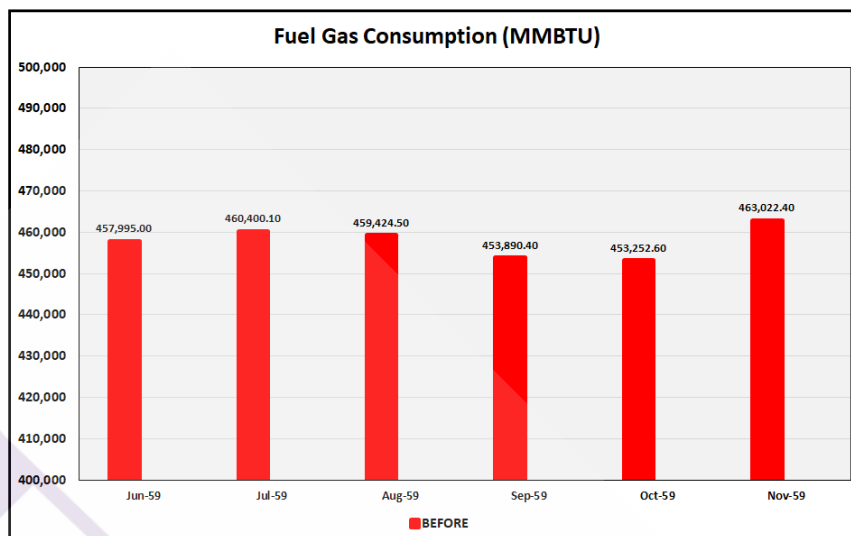

ภาพที่ 3.27 แสดงค่าเฉลี่ยการใช้ปริมาณเชื้อเพลิงก๊าซธรรมชาติ ก่อนทำการปรับปรุง

3.5.6.5 ข้อมูลประสิทธิภาพโดยรวมระบบโคเจนเนอเรชัน (Cogeneration Overall Efficiency) ของ โรงไฟฟ้าพลังความร้อนร่วม ก่อนทำการปรับปรุง โดยการรวบรวมและการวิเคราะห์ข้อมูลทางสถิติของค่าเฉลี่ยต่อเดือน ในช่วงเดือน มิ.ย. 2559 – พ.ย. 2559 ของการเดินเครื่องโรงไฟฟ้าพลังความร้อนร่วม ในขณะที่เดินเครื่องอัดและเพิ่มความดันก๊าซธรรมชาติ (Gas Compressor System)

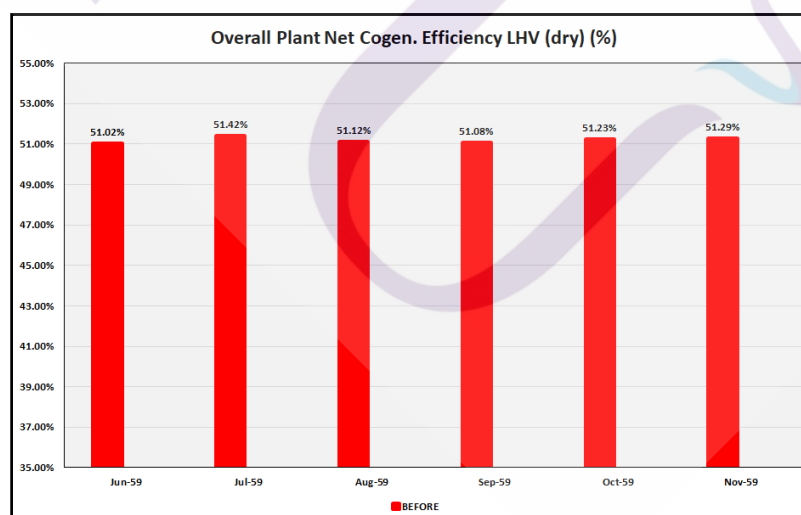

ภาพที่ 3.28 แสดงค่าเฉลี่ยประสิทธิภาพการเดินเครื่องโดยรวมระบบโคเจนเนอเรชัน (Cogeneration Overall Efficiency) ก่อนทำการปรับปรุง

3.6 การสรุปผล

หลังจากดำเนินการเก็บรวบรวมข้อมูลและวิเคราะห์ข้อมูลในรูปแบบเชิงสถิติ ทำให้ทราบว่าค่าความดันเชื้อเพลิงก๊าซธรรมชาติขาเข้าต้นทาง (Upstream) และค่าความดันที่ผ่านชุดวาล์วควบคุมความดัน (Downstream) ในช่วง 6 เดือนแรก ก่อนทำการปรับปรุง มีค่าความดันที่คงที่อย่างมีนัยสำคัญ และเป็นค่าความดันที่เหมาะสมที่จะนำไปประกอบการดำเนินงานในโครงการนี้ และในส่วนของข้อมูลหลักๆ ในการเดินเครื่องผลิตกระแสไฟฟ้าของโรงไฟฟ้า อ่างทอง นั้น สามารถสรุปใจความสำคัญ เพื่อดำเนินการตั้งเป็นข้อมูลฐานก่อนดำเนินการปรับปรุงโครงการนี้ได้ โดยที่จะเห็นได้จากข้อมูล ดังนี้ 1. ข้อมูลการใช้พลังงานไฟฟ้ารวม (Plant Station Service Energy (kWh)) เฉลี่ยต่อเดือน ของโรงไฟฟ้า อ่างทอง เพาเวอร์ ในขณะที่เดินเครื่องอัดและเพิ่มความดันก๊าซธรรมชาติ (Gas Compressor System) ก่อนทำการปรับปรุง 2. ข้อมูลการใช้ปริมาณเชื้อเพลิงก๊าซธรรมชาติ (Fuel Gas Consumption (MMBTU)) ในการผลิตกระแสไฟฟ้าเฉลี่ยต่อเดือน ของโรงไฟฟ้า อ่างทอง เพาเวอร์ ในขณะที่เดินเครื่องอัดและเพิ่มความดันก๊าซธรรมชาติ (Gas Compressor System) ก่อนทำการปรับปรุง และ 3. ข้อมูลประสิทธิภาพโดยรวมระบบโคเจนเนอเรชัน (Cogeneration Overall Efficiency) ของ โรงไฟฟ้าพลังความร้อนร่วม ในการผลิตกระแสไฟฟ้าเฉลี่ยต่อเดือน ของโรงไฟฟ้า อ่างทอง เพาเวอร์ ในขณะที่เดินเครื่องอัดและเพิ่มความดันก๊าซธรรมชาติ (Gas Compressor System) ก่อนทำการปรับปรุง

จะเห็นว่าตัวเลขของข้อมูลทั้ง 3 ข้อมูลข้างต้น สามารถนำไปวิเคราะห์และเปรียบเทียบข้อมูลก่อนและหลังปรับปรุง เพื่อบรรลุวัตถุประสงค์การลดการใช้พลังงานไฟฟ้าเฉลี่ยรวมต่อเดือน (kWh) ของโรงไฟฟ้าอ่างทอง เพาเวอร์ ได้ ประสิทธิภาพโดยรวมระบบโคเจนเนอเรชัน (Cogeneration Overall Efficiency) ของ โรงไฟฟ้าพลังความร้อนร่วม ไม่ลดลง และการใช้ปริมาณเชื้อเพลิงก๊าซธรรมชาติ (Fuel Gas Consumption (MMBTU)) ในการผลิตกระแสไฟฟ้า ของโรงไฟฟ้าอ่างทอง เพาเวอร์ ต่อเดือนลดลง โดยที่ยังคงผลิตกระแสไฟฟ้าและไอน้ำได้ในอัตราการผลิตเท่าเดิม


บทที่ 4

ผลการวิจัย

การศึกษาวิจัยเรื่อง การลดการใช้พลังงานในการเดินเครื่องโรงไฟฟ้าพลังความร้อนร่วม กรณีศึกษา โรงไฟฟ้า อ่างทอง เพาเวอร์ มีวัตถุประสงค์เพื่อลดการใช้พลังงานในกระบวนการผลิตไฟฟ้าและเพิ่มประสิทธิภาพโดยรวมระบบโคเจนเนอเรชัน (Cogeneration Overall Efficiency) ของ โรงไฟฟ้าพลังความร้อนร่วม ผู้วิจัยได้ทำการศึกษาด้วยระเบียบวิธีการวิจัยดังแสดงไว้ในบทที่ 3 และวิเคราะห์ข้อมูลจากการเก็บรวบรวมข้อมูลหลังการปรับปรุงในช่วงเดือน ม.ค. 2560 – มิ.ย. 2560 ในกระบวนการผลิตไฟฟ้าของโรงไฟฟ้าพลังความร้อนร่วม ในช่วงขณะที่ไม่เดินเครื่องอัดและเพิ่มความดันก๊าซธรรมชาติ ซึ่งสามารถวิเคราะห์ผลการศึกษาและสรุปผลโดยจำแนกแบ่งออกเป็น 5 ส่วน ได้ดังต่อไปนี้

4.1 ข้อมูลค่าความดันเชื้อเพลิงก๊าซธรรมชาติต้นทาง (Upstream) หลังทำการปรับปรุง

โดยการรวบรวมและการวิเคราะห์ข้อมูลทางสถิติของค่าความดันเฉลี่ยต่อเดือน ในช่วงเดือน ม.ค. 2560 - มิ.ย. 2560 ของการเดินเครื่องโรงไฟฟ้า ที่สถานีควบคุมความดันและวัดปริมาณก๊าซธรรมชาติจาก ปตท. ในเขตพื้นที่โรงไฟฟ้าอ่างทอง เพาเวอร์ ในขณะที่ไม่เดินเครื่องอัดและเพิ่มความดันก๊าซธรรมชาติ (Gas Compressor System) สามารถสรุปข้อมูลได้ดังภาพที่ 4.1

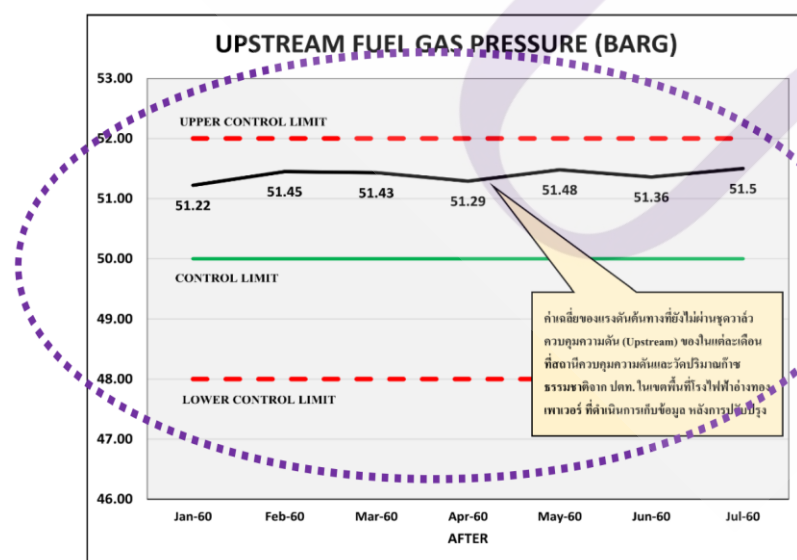


ความดันต้นทางขาเข้า อยู่ในเกณฑ์ปกติ มีความเสถียรและอยู่ในเกณฑ์ค่าควบคุม

ภาพที่ 4.1 แสดงค่าเฉลี่ยแรงดันขาเข้า (Upstream) หลังทำการปรับปรุง

4.2 ข้อมูลค่าความดันเชื้อเพลิงก๊าซธรรมชาติ หลังจากที่ตั้งค่าแรงดันที่ชุดควบคุมความดันก๊าซธรรมชาติ (Downstream) หลังทำการปรับปรุง

โดยการรวบรวมและการวิเคราะห์ข้อมูลทางสถิติของค่าความดันเฉลี่ยต่อเดือน ในช่วงเดือน ม.ค. 2560 – มิ.ย. 2560 ของการเดินเครื่องโรงไฟฟ้า ที่สถานีควบคุมความดันและวัดปริมาณก๊าซธรรมชาติจาก ปตท. ในเขตพื้นที่โรงไฟฟ้าอ่างทอง เพาเวอร์ ในขณะที่ไม่เดินเครื่องอัดและเพิ่มความดันก๊าซธรรมชาติ (Gas Compressor System) สามารถสรุปข้อมูลได้ดังภาพที่ 4.2

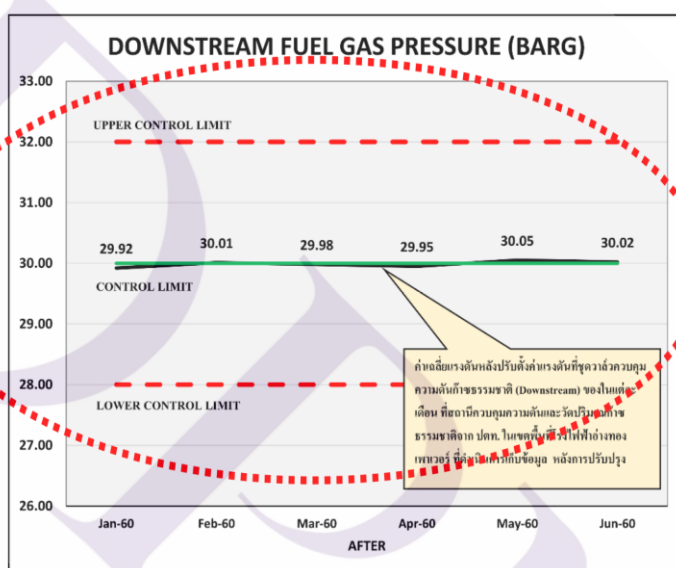


ความดันที่ผ่านชุดควบคุมความดันขาออก อยู่ในเกณฑ์ที่ปกติ หลังจากปรับตั้งสปริง เพื่อให้ควบคุมที่ 30 Bar(a) มีความเสถียรและอยู่ในเกณฑ์ค่าควบคุม

ภาพที่ 4.2 แสดงค่าเฉลี่ยแรงดันขาออกของชุดควบคุมความดันก๊าซธรรมชาติ (Downstream) หลังทำการปรับปรุง

4.3 ข้อมูลการใช้พลังงานไฟฟ้า (Plant Station Service Energy (kWh)) ก่อน-หลังทำการปรับปรุง

โดยการรวบรวมและการวิเคราะห์ข้อมูลทางสถิติของค่าเฉลี่ยต่อเดือน ในช่วงเดือน ม.ค. 2560 – มิ.ย. 2560 ของการเดินเครื่องโรงไฟฟ้าพลังความร้อนร่วม ในขณะที่ไม่เดินเครื่องอัดและเพิ่มความดันก๊าซธรรมชาติ (Gas Compressor System) สามารถสรุปข้อมูลได้ดังภาพที่ 4.3

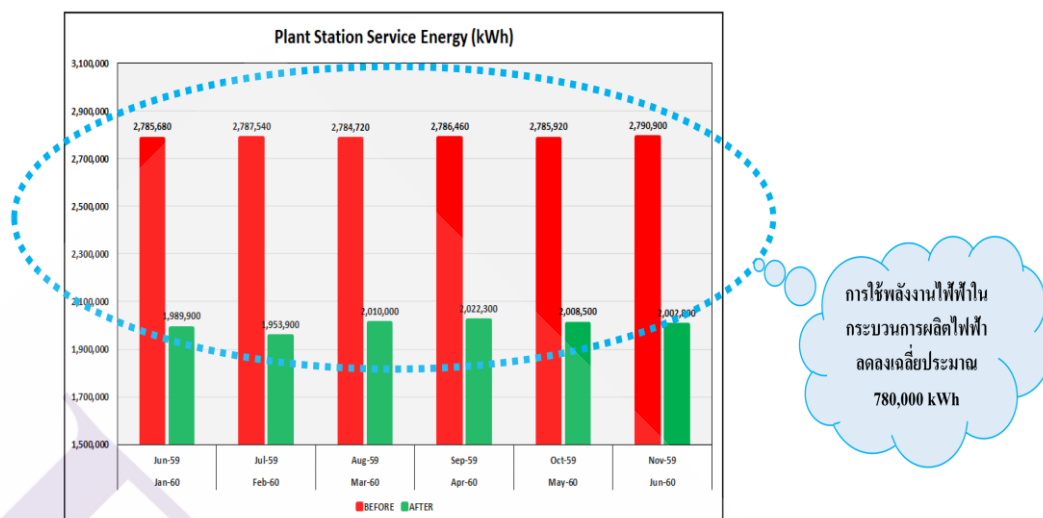


ภาพที่ 4.3 แสดงค่าเฉลี่ยการใช้พลังงานไฟฟ้า ก่อน-หลังทำการปรับปรุง

จากผลการวิเคราะห์ข้อมูลการใช้พลังงานไฟฟ้ารวม (Plant Station Service Energy (kWh)) หลังทำการปรับปรุง จากการดำเนินโครงการนี้จะทำให้สามารถทราบถึงข้อมูลหลักจาก 2 ข้อมูลของในแต่ละเดือน ในช่วง 6 เดือนแรก และในช่วง 6 เดือนหลัง ก่อนทำการปรับปรุงและหลังทำการปรับปรุง โดยนำข้อมูลดังกล่าวมาเปรียบเทียบกับในแต่ละเดือน เพื่อนำข้อมูลที่เปรียบเทียบได้นั้น ของในแต่ละเดือนของการดำเนินโครงการ มาหาค่าเฉลี่ยของผลการวิเคราะห์ข้อมูลการใช้พลังงานไฟฟ้าเฉลี่ยรวมต่อเดือน ในช่วงก่อนทำการปรับปรุงและหลังทำการปรับปรุง ด้วยวิธีการสำรวจหน้างานจริง ประกอบกับการเก็บรวบรวมข้อมูลและการวิเคราะห์ข้อมูลทางสถิติ โดยใช้เครื่องมือตรวจวัดนั้น จากการดำเนินโครงการแล้วจะทำให้สามารถลดการใช้พลังงานไฟฟ้าเฉลี่ยรวมต่อเดือน ได้ถึง 788,970 kWh/month หรือ 9,467,640 kWh/year ซึ่งจะสามารถคิดเป็นเงินได้ถึง 22,936,304.664 บาทต่อปี (*Assumption PEA Rate charge ประเภทการใช้พลังงานไฟฟ้าเกินกว่า 400 หน่วย (kWh) คิดที่อัตราหน่วยละ 2.4226 บาท) (อ้างอิง ปี พ.ศ. 2559)

4.4 ข้อมูลการใช้ปริมาณเชื้อเพลิงก๊าซธรรมชาติ ในการผลิตกระแสไฟฟ้า (Fuel Gas Consumption (MMBTU)) ก่อน-หลังทำการปรับปรุง

โดยการรวบรวมและการวิเคราะห์ข้อมูลทางสถิติของค่าเฉลี่ยต่อเดือน ในช่วงเดือน ม.ค. 2560 – มิ.ย. 2560 ของการเดินเครื่องโรงไฟฟ้าพลังความร้อนร่วม ในขณะที่ไม่เดินเครื่องอัดและเพิ่มความดันก๊าซธรรมชาติ (Gas Compressor System)สามารถสรุปข้อมูลได้ดังภาพที่ 4.4

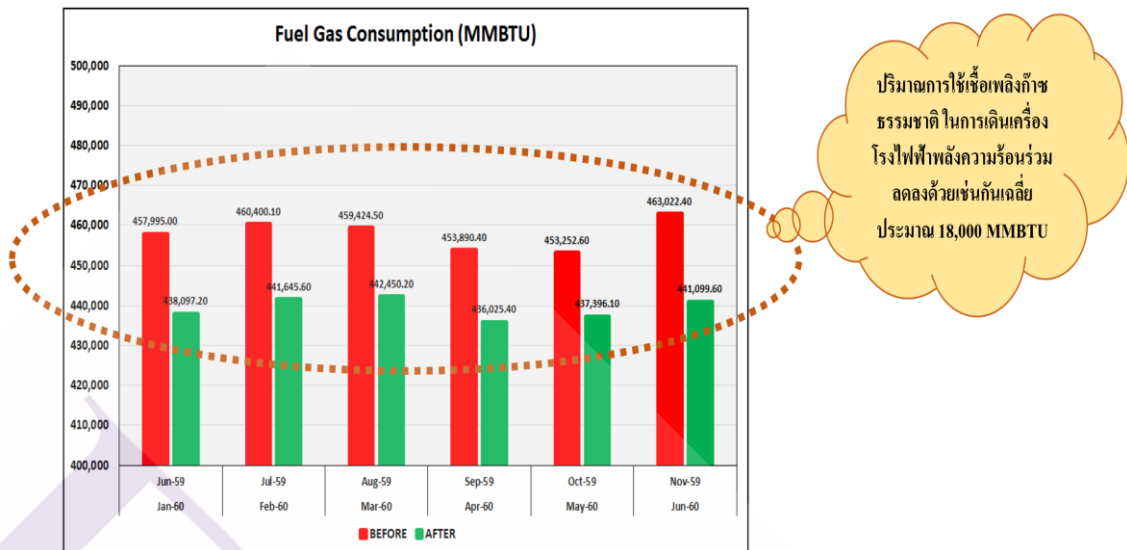


ภาพที่ 4.4 แสดงค่าเฉลี่ยการใช้ปริมาณเชื้อเพลิงก๊าซธรรมชาติ ก่อน-หลังทำการปรับปรุง

จากผลการวิเคราะห์ข้อมูลการใช้ปริมาณเชื้อเพลิงก๊าซธรรมชาติ ในการผลิตกระแสไฟฟ้า (Fuel Gas Consumption (MMBTU)) ก่อน-หลังทำการปรับปรุง จากการดำเนินโครงการนี้จะทำให้สามารถทราบถึงข้อมูลหลักจาก 2 ข้อมูลของในแต่ละเดือน ในช่วง 6 เดือนแรก และในช่วง 6 เดือนหลัง ก่อนทำการปรับปรุงและหลังทำการปรับปรุง โดยนำข้อมูลดังกล่าวมาเปรียบเทียบกันในแต่ละเดือน เพื่อนำข้อมูลที่เปรียบเทียบได้นั้น ของในแต่ละเดือนของการดำเนินโครงการ มาหาค่าเฉลี่ยของผลการวิเคราะห์ข้อมูลการใช้ปริมาณเชื้อเพลิงก๊าซธรรมชาติ ในการผลิตกระแสไฟฟ้า เฉลี่ยรวมต่อเดือน ในช่วงก่อนทำการปรับปรุงและหลังทำการปรับปรุง ด้วยวิธีการสำรวจหน้างานจริง ประกอบกับการเก็บรวบรวมข้อมูลและการวิเคราะห์ข้อมูลทางสถิติ โดยใช้เครื่องมือตรวจวัดนั้น จากการดำเนินโครงการแล้ว จะทำให้สามารถลดการใช้ปริมาณเชื้อเพลิงก๊าซธรรมชาติ ในการผลิตกระแสไฟฟ้า เฉลี่ยรวมต่อเดือน ได้ถึง 18,545.15 MMBTU /month หรือ 222,541.8 MMBTU /year ซึ่งจะสามารถคิดเป็นเงินในการประหยัดการใช้ปริมาณเชื้อเพลิงก๊าซธรรมชาติ ได้ถึง 53,410,032 บาทต่อปี (* Assumptions การซื้อขายเชื้อเพลิงก๊าซธรรมชาติ ระหว่าง ปตท. กับผู้ผลิตไฟฟ้ารายเล็ก (SPP) Natural Fuel Gas Capacity Rate Charge from PTT price 240 Baht/MMBTU) (อ้างอิง ปี พ.ศ. 2559)

4.5 ข้อมูลประสิทธิภาพโดยรวมระบบโคเจนเนอเรชัน (Cogeneration Overall Efficiency) ของ โรงไฟฟ้าพลังความร้อนร่วม ก่อน-หลังทำการปรับปรุง

โดยการรวบรวมและการวิเคราะห์ข้อมูลทางสถิติของค่าเฉลี่ยต่อเดือน ในช่วงเดือน ม.ค. 2560 – มิ.ย. 2560 ของการเดินเครื่องโรงไฟฟ้าพลังความร้อนร่วม ในขณะที่ไม่เดินเครื่องอัด และเพิ่มความดันก๊าซธรรมชาติ (Gas Compressor System) สามารถสรุปข้อมูลได้ดังภาพที่ 4.5

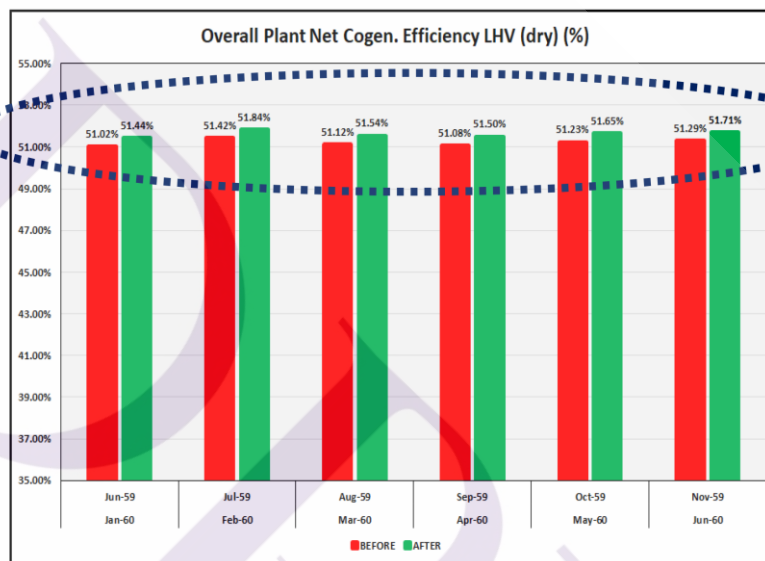

ประสิทธิภาพการเดินเครื่องเพิ่มขึ้นประมาณ 0.36 %

ภาพที่ 4.5 แสดงค่าเฉลี่ยประสิทธิภาพการเดินเครื่องโดยรวมระบบโคเจนเนอเรชัน (Cogeneration Overall Efficiency) ก่อน-หลังทำการปรับปรุง

จากผลการวิเคราะห์ข้อมูลประสิทธิภาพโดยรวมของระบบโคเจนเนอเรชัน (Cogeneration Overall Efficiency) ของ โรงไฟฟ้าพลังความร้อนร่วม หลังทำการปรับปรุง ดีขึ้นกว่าเดิมเฉลี่ยประมาณ 0.36 %

จากผลการศึกษาและการเก็บข้อมูลหลังการปรับปรุงดังกล่าวข้างต้นนั้น ทำให้ทราบถึงการใช้พลังงานไฟฟ้าในกระบวนการผลิตกระแสไฟฟ้าลดลงเฉลี่ยประมาณ 780,000 kWh และประสิทธิภาพโดยรวมระบบโคเจนเนอเรชัน (Cogeneration Overall Efficiency) ของ โรงไฟฟ้าพลังความร้อนร่วม ดีขึ้นกว่าเดิมเฉลี่ยประมาณ 0.36 % รวมถึงปริมาณการใช้เชื้อเพลิงก๊าซธรรมชาติ ในการเดินเครื่องโรงไฟฟ้าพลังความร้อนร่วม ลดลงด้วยเช่นกันเฉลี่ยประมาณ 18,000 MMBTU และที่

สำคัญยังคงสามารถผลิตกระแสไฟฟ้าและไอน้ำได้ในอัตราการผลิตเท่าเดิมไม่ลดลงและไม่ส่งผลกระทบต่อ การเดินเครื่องกังหันก๊าซโดยรวมอีกด้วยเช่นกัน



บทที่ 5

สรุปและอภิปรายผลงานวิจัย

5.1 สรุปผลการวิจัย

การศึกษาวิจัยเรื่อง การลดการใช้พลังงานในการเดินเครื่องโรงไฟฟ้าพลังความร้อนร่วม กรณีศึกษา โรงไฟฟ้า อ่างทอง เพาเวอร์ โดยการศึกษาครั้งนี้มีวัตถุประสงค์เพื่อลดการใช้พลังงานในกระบวนการผลิตไฟฟ้าและเพิ่มประสิทธิภาพโดยรวมระบบโคเจนเนอเรชัน (Cogeneration Overall Efficiency) ในกระบวนการผลิตไฟฟ้าของโรงไฟฟ้าพลังความร้อนร่วม การศึกษานี้แสดงให้เห็นว่าสามารถลดการใช้พลังงานไฟฟ้าและเพิ่มประสิทธิภาพโดยรวมระบบโคเจนเนอเรชัน (Cogeneration Overall Efficiency) ได้ และยังคงสามารถผลิตไฟฟ้าและไอน้ำได้ในอัตราการผลิตเท่าเดิมไม่ลดลงและไม่ส่งผลกระทบต่อเครื่องกังหันก๊าซโดยรวมด้วยเช่นกัน จากผลการวิจัยทั้งหมดสามารถสรุปได้ดังนี้

ผลจากการศึกษาด้านเทคนิคพบว่า การเดินเครื่องโรงไฟฟ้าพลังความร้อนร่วม โดยไม่ใช้ชุดเครื่องอัดและเพิ่มความดันก๊าซธรรมชาติ เพื่อลดการใช้พลังงานในการเดินเครื่องโรงไฟฟ้าพลังความร้อนร่วม กรณีศึกษา โรงไฟฟ้า อ่างทอง เพาเวอร์ สามารถลดการใช้พลังงานในกระบวนการผลิตกระแสไฟฟ้าและเพิ่มประสิทธิภาพโดยรวมระบบโคเจนเนอเรชัน (Cogeneration Overall Efficiency) จากผลการวิจัยทั้งหมดสามารถสรุปได้ดังนี้

5.1.1 สามารถลดการใช้พลังงานไฟฟ้าได้ประมาณ 788,970 kWh/เดือน หรือ 9,467,640 kWh/ปี ซึ่งสามารถคิดเป็นเงินประมาณ 22,936,304.664 บาทต่อปี *

5.1.2 สามารถลดการใช้ปริมาณเชื้อเพลิงก๊าซธรรมชาติ ในกระบวนการผลิตไฟฟ้าของโรงไฟฟ้าพลังความร้อนร่วม ได้ประมาณ 18,545.15 MMBTU/เดือน หรือ 222,541.80 MMBTU/ปี ซึ่งสามารถคิดเป็นเงินประมาณ 53,410,032 บาทต่อปี **

5.1.3 ประสิทธิภาพโดยรวมระบบโคเจนเนอเรชัน (Cogeneration Overall Efficiency) ของโรงไฟฟ้าพลังความร้อนร่วม มีประสิทธิภาพเพิ่มขึ้นเท่ากับ 0.36 %

หมายเหตุ. Assumption PEA Rate charge ประเภทการใช้พลังงานไฟฟ้าเกินกว่า 400 หน่วย (kWh) คิดที่อัตราหน่วยละ 2.4226 บาท (อ้างอิง ปี พ.ศ. 2559)

** Assumptions การซื้อขายเชื้อเพลิงก๊าซธรรมชาติ ระหว่าง ปตท. กับผู้ผลิตไฟฟ้ารายเล็ก (SPP) Natural Fuel Gas Capacity Rate Charge from PTT price 240 Baht/MMBTU (อ้างอิง ปี พ.ศ. 2559)

5.2 ข้อเสนอแนะและข้อจำกัด

5.2.1 การศึกษางานวิจัยนี้ไม่เหมาะสมที่จะนำไปใช้กับโรงไฟฟ้าประเภทเชื้อเพลิงชีวมวล (Biomass Power Plant) ซึ่งเป็นโรงไฟฟ้าที่ใช้เศษวัสดุจากเชื้อเพลิงชีวมวล ได้แก่ กากหรือเศษวัสดุเหลือใช้ทางการเกษตร กากจากผลผลิตทางการเกษตรที่ผ่านการแปรรูปแล้ว เช่น แกลบ ชานอ้อย เศษไม้ กากปาล์ม กากมันสำปะหลัง ชังข้าวโพด กากและกะลามะพร้าว ส่าเหล้า เป็นต้น นำมาเป็นเชื้อเพลิงในการผลิตไฟฟ้า และพลังไอน้ำ ซึ่งอาจเป็นเศษวัสดุชนิดเดียว หรือหลายชนิดรวมกันก็ได้ ซึ่งข้อมูลดังกล่าวข้างต้นนั้น ไม่สามารถนำมาประยุกต์และปรับใช้ได้ เนื่องจากมีวัตถุดิบที่นำมาเข้าสู่กระบวนการผลิตไฟฟ้าที่แตกต่างกัน รวมถึงอัตราค่าความร้อนของการใช้เชื้อเพลิงในการผลิตไฟฟ้าต่อกิโลวัตต์ (Heat Rate : BTU/kWh) ย่อมแตกต่างกัน เนื่องจากชนิดของเชื้อเพลิงที่นำมาผลิตไฟฟ้าอยู่ในประเภท คุณสมบัติทางเคมี เชื้อเพลิงที่ใช้ถูกจำกัดชนิด จะมีเศษสกปรก หรือเถ้าถ่านไม่ได้ เพราะความร้อนที่เกิดจากการเผาไหม้ของเชื้อเพลิงจะผสมกับอากาศอัดเข้าสู่เครื่องกังหันก๊าซโดยตรง ประสิทธิภาพของเครื่องเปลี่ยนแปลงไปได้ง่าย เพราะอากาศที่ถูกเครื่องอัดอากาศดูดเข้าไปในวงจรการทำงาน จะมีความชื้น ไอน้ำประปนอยู่รวมทั้งความหนาแน่นและอุณหภูมิที่เปลี่ยนแปลงไป ทำให้เครื่องอัดอากาศทำงานไม่คงที่แน่นอน และอื่นๆ อีกมากมายที่ต่างกัน จึงไม่สามารถนำมาปรับใช้ได้

5.2.2 การศึกษางานวิจัยนี้ไม่เหมาะสมที่จะนำไปใช้กับโรงไฟฟ้าพลังงานขยะ (Incinerary Power Plant) ใช้ขยะเป็นเชื้อเพลิงในการผลิตไฟฟ้า โดยขยะส่วนใหญ่เป็นมวลชีวภาพ เช่น กระดาษ เศษอาหาร และไม้ ฯลฯ โรงไฟฟ้าพลังงานขยะมีวิธีการทำงานเหมือนกับโรงไฟฟ้าอื่นๆ โดยจะนำขยะมาเผาจนตะแกรง แล้วนำความร้อนที่เกิดขึ้นมาใช้ต้มน้ำในหม้อน้ำจนกลายเป็นไอน้ำเดือด ซึ่งจะไปหมุนกังหันของเครื่องกำเนิดไฟฟ้า ซึ่งข้อมูลดังกล่าวข้างต้นนั้น ไม่สามารถนำมาประยุกต์และปรับใช้ได้ เนื่องจากมีวัตถุดิบที่นำมาเข้าสู่กระบวนการผลิตไฟฟ้าที่แตกต่างกัน รวมถึงอัตราค่าความร้อนของการใช้เชื้อเพลิงในการผลิตไฟฟ้าต่อกิโลวัตต์ (Heat Rate : BTU/kWh) ย่อมแตกต่างกัน เนื่องจากชนิดของเชื้อเพลิงที่นำมาผลิตไฟฟ้าอยู่ในประเภท คุณสมบัติทางเคมี เชื้อเพลิงที่ใช้ถูกจำกัดชนิด จะมีเศษสกปรก หรือเถ้าถ่านไม่ได้ เพราะความร้อนที่เกิดจากการเผาไหม้ของเชื้อเพลิงจะผสมกับอากาศอัดเข้าสู่เครื่องกังหันก๊าซโดยตรง ประสิทธิภาพของเครื่องเปลี่ยนแปลงไปได้ง่าย เพราะอากาศที่ถูกเครื่องอัดอากาศดูดเข้าไปในวงจรการทำงาน จะมีความชื้น ไอน้ำประปนอยู่

รวมทั้งความหนาแน่นและอุณหภูมิที่เปลี่ยนแปลงไป ทำให้เครื่องอัดอากาศทำงานไม่คงที่แน่นอน และอื่นๆ อีกมากมายที่ต่างกัน จึงไม่สามารถนำมาปรับใช้ได้

5.2.3 การศึกษางานวิจัยนี้ไม่เหมาะสมที่จะนำไปใช้กับโรงไฟฟ้าพลังความร้อน (Thermal Power Plant) เป็นโรงไฟฟ้าที่ใช้น้ำมันเตา หรือถ่านหิน เป็นเชื้อเพลิงในการผลิตไฟฟ้า อาศัยความร้อนจากการเผาไหม้เชื้อเพลิงไปต้มน้ำให้เป็นไอน้ำที่มีแรงดันและมี อุณหภูมิสูง เพื่อไปขับเคลื่อนกังหันไอน้ำ ซึ่งจะมีเพลาคู่เชื่อมกับเครื่องกำเนิดไฟฟ้า จากนั้น ไอน้ำจะผ่านไประบายตัวเป็นน้ำที่เครื่องควบแน่น และถูกส่งกลับมารับความร้อนในหม้อน้ำ (Boiler) อีกครั้ง ซึ่งข้อมูลดังกล่าวข้างต้นนั้น ไม่สามารถนำมาประยุกต์และปรับใช้ได้ เนื่องจากมีวัตถุดิบที่นำมาเข้าสู่กระบวนการผลิตไฟฟ้าที่แตกต่างกัน รวมถึงอัตราค่าความร้อนของการใช้เชื้อเพลิงในการผลิตไฟฟ้าต่อกิโวลต์ (Heat Rate : BTU/kWh) ย่อมแตกต่างกัน เนื่องจากชนิดของเชื้อเพลิงที่นำมาผลิตไฟฟ้าอยู่ในประเภทคุณสมบัติทางเคมี เชื้อเพลิงที่ใช้ถูกจำกัดชนิด จะมีเศษสกปรก หรือเถ้าถ่านไม่ได้ เพราะความร้อนที่เกิดจากการเผาไหม้ของเชื้อเพลิงจะผสมกับอากาศอัดเข้าสู่เครื่องกังหันก๊าซโดยตรง ประสิทธิภาพของเครื่องเปลี่ยนแปลงไปได้ง่าย เพราะอากาศที่ถูกเครื่องอัดอากาศดูดเข้าไปในวงจรการทำงาน จะมีความชื้น ไอน้ำประปนอยู่รวมทั้งความหนาแน่นและอุณหภูมิที่เปลี่ยนแปลงไป ทำให้เครื่องอัดอากาศทำงานไม่คงที่แน่นอน และอื่นๆ อีกมากมายที่ต่างกัน จึงไม่สามารถนำมาปรับใช้ได้

5.2.4 การศึกษางานวิจัยนี้ไม่เหมาะสมที่จะนำไปใช้กับโรงไฟฟ้านิวเคลียร์ (Nuclear Power Plant) เป็นโรงไฟฟ้าพลังความร้อนประเภทหนึ่ง อาศัยพลังความร้อนที่เกิดขึ้นจากปฏิกิริยาการแตกตัวของธาตุยูเรเนียม แล้วนำไปใช้ในกระบวนการผลิตไอน้ำที่ใช้ในการเดินเครื่องกำเนิดไฟฟ้า ซึ่งข้อมูลดังกล่าวข้างต้นนั้น ไม่สามารถนำมาประยุกต์และปรับใช้ได้ เนื่องจากมีวัตถุดิบที่นำมาเข้าสู่กระบวนการผลิตไฟฟ้าที่แตกต่างกัน รวมถึงอัตราค่าความร้อนของการใช้เชื้อเพลิงในการผลิตไฟฟ้าต่อกิโวลต์ (Heat Rate : BTU/kWh) ย่อมแตกต่างกัน เนื่องจากชนิดของเชื้อเพลิงที่นำมาผลิตไฟฟ้าอยู่ในประเภท คุณสมบัติทางเคมี เชื้อเพลิงที่ใช้ถูกจำกัดชนิด จะมีเศษสกปรก หรือเถ้าถ่านไม่ได้ เพราะความร้อนที่เกิดจากการเผาไหม้ของเชื้อเพลิงจะผสมกับอากาศอัดเข้าสู่เครื่องกังหันก๊าซโดยตรง ประสิทธิภาพของเครื่องเปลี่ยนแปลงไปได้ง่าย เพราะอากาศที่ถูกเครื่องอัดอากาศดูดเข้าไปในวงจรการทำงาน จะมีความชื้น ไอน้ำประปนอยู่รวมทั้งความหนาแน่นและอุณหภูมิที่เปลี่ยนแปลงไป ทำให้เครื่องอัดอากาศทำงานไม่คงที่แน่นอน และอื่นๆ อีกมากมายที่ต่างกัน จึงไม่สามารถนำมาปรับใช้ได้

5.2.5 การศึกษางานวิจัยนี้ไม่เหมาะสมที่จะนำไปใช้กับโรงไฟฟ้าประเภทพลังงานหมุนเวียน (Renewable Energy) เป็นพลังงานทดแทนที่ได้จากแหล่งที่สามารถหมุนเวียนมาใช้โดยไม่มีวันหมดมักเป็นพลังงานสะอาด และไม่สร้างผลกระทบต่อสิ่งแวดล้อม เช่น พลังงานลม พลังงานแสงอาทิตย์

อย่างไรก็ตาม พลังงานหมุนเวียนมีต้นทุนการผลิตสูง และไม่สม่ำเสมอ จึงมีการผลิตไฟฟ้าในปริมาณน้อย

5.2.6 ศึกษาเพิ่มเติมในการปรับปรุงประสิทธิภาพของโรงไฟฟ้าพลังความร้อนร่วม ในประเด็นของการลด Plant Net Heat Rate ได้อย่างไร เพื่อที่จะสามารถลดการใช้ปริมาณเชื้อเพลิงก๊าซธรรมชาติได้ดีขึ้นกว่าปัจจุบัน

5.2.7 ศึกษาถึงการติดตั้งระบบ Fuel Gas Heater System เพื่อลดปริมาณ Fuel Gas Mass Flow เพื่อมุ่งเน้นการลด Plant Net Heat Rate ว่ามีข้อดี ข้อเสียอย่างไร

5.2.8 ศึกษาถึงการ Startup and Shutdown During Time of Power Plant ในช่วงของ Peak Period และ Off Peak Period เพื่อมุ่งเน้นการประหยัดการใช้ปริมาณเชื้อเพลิงก๊าซธรรมชาติ

5.2.9 ศึกษาเพิ่มเติมในการปรับปรุงประสิทธิภาพของโรงไฟฟ้าพลังความร้อนร่วม ผลของการลดอุณหภูมิก่อนเข้าเครื่องอัดอากาศของเครื่องกังหันก๊าซ ระบบ Absorption Chiller System.



บรรณานุกรม

บรรณานุกรม

ภาษาไทย

- สถานี อุตสาหกรรม. (2553). การศึกษาความเป็นไปได้ในการนำความร้อนทิ้งของแก๊สเทอร์ไบน์มาใช้ งาน ในสถานีเพิ่มความดันแก๊สธรรมชาติ. กรุงเทพฯ : มหาวิทยาลัยศรีนครินทรวิโรฒ
- ชลวิทย์ เพ็ญผาสุก. (2554). การจัดการพลังงานไฟฟ้าในอาคารแบบบูรณาการ กรณีศึกษาอาคารกรมการกงสุล. กรุงเทพฯ : มหาวิทยาลัยธุรกิจบัณฑิต
- สุรินทร์ จันทสุริยวิช. (2546). การจัดการด้านการใช้ไฟฟ้า คณะแพทยศาสตร์ มหาวิทยาลัยเชียงใหม่. เชียงใหม่ : มหาวิทยาลัยเชียงใหม่
- ซัชชัย จันทะลีลา. (2549). ศึกษาการใช้พลังงาน และหาค่าดัชนีการใช้พลังงานไฟฟ้า ในอาคารสิรินธร โรงพยาบาลขอนแก่น. กรุงเทพฯ : มหาวิทยาลัยราชภัฏสวนสุนันทา
- วัชรระ จำปาดิษฐ์. (2550). การพัฒนาระบบสารสนเทศเพื่อการจัดการพลังงาน ในอาคารโรงแรมโดยวิธีแผนที่พลังงาน. กรุงเทพฯ : มหาวิทยาลัยธุรกิจบัณฑิต
- สุวเดช แก้วช่วย. (2552). ศึกษาการจัดการใช้พลังงานในอาคารหอสมุดสุรรัตน์ โอทยานุเคราะห์ ที่มหาวิทยาลัยกรุงเทพ วิทยาเขตรังสิต. กรุงเทพฯ : มหาวิทยาลัยธุรกิจบัณฑิต
- อักรพันธ์ ธรรมไพศาล (2554). เภณฑ์การใช้พลังงานใน โรงไฟฟ้าประเภท โคอเจนเนอเรชั่น โรงงานตัวอย่างสมุทรปราการ. กรุงเทพฯ : จุฬาลงกรณ์มหาวิทยาลัย
- กรเทวินทร์ บุญช่วย (2559). มาตรการค่าไฟฟ้าช่วงวิกฤติที่เหมาะสมสำหรับการตอบสนองของความต้องการใช้ไฟฟ้าโดยการ พิจารณาด้านทุนการผลิตไฟฟ้าหน่วยสุดท้ายในประเทศไทย. กรุงเทพฯ : จุฬาลงกรณ์มหาวิทยาลัย
- สุธิ เหลืองรัตนเจริญ (2552). การลดต้นทุนพลังงานในกระบวนการผลิตของโรงงานประเภทการผลิตขึ้นรูป. กรุงเทพฯ : จุฬาลงกรณ์มหาวิทยาลัย
- PTT DISTRIBUTION SERVICE CENTER (2555). สถานีควบคุมและวัดปริมาณก๊าซธรรมชาติ หรือสถานีก๊าซธรรมชาติ (Metering and Regulation Station; MRS). สืบค้น จาก [https://dscng.pttplc.com/\(S\(sw4d31d4mllfau5gtb3y4tlt\)\)/Knowledge/Knowledge-inside?p=Metering_and_Regulation_Station](https://dscng.pttplc.com/(S(sw4d31d4mllfau5gtb3y4tlt))/Knowledge/Knowledge-inside?p=Metering_and_Regulation_Station)

ภาษาต่างประเทศ

Yogesh S Pednekar. (2016). *SPR-DI-JE-M-0022_Rev 0_Gas Turbine &*

Auxiliaries - Instruction Manual. Siemens Industrial Turbomachinery AB.

Technical Asia Pte Ltd. (2015). *SPR-DI-JE-M-0010_Rev 1_Installation, O&M Instruction*

Manual for Gas Compressor. Technical Asia at 19 Tuas View Close Singapore

637483. Invensys Process Systems (S) Pte Ltd. (2015). *DCS-Operation and Maintenance Manual*. foxboro by schneider electric.

Thai Jurong Engineering Limited (TJEL). (2014). *SPR-10-AAA-PN-M8603_Rev 1_Process*

Description - Natural Gas System. Jurong Engineering Limited.

Thai Jurong Engineering Limited (TJEL). (2014). *Heat & Mass Balance Diagram (Sheet 1-8)*.

Jurong Engineering Limited.

Thai Jurong Engineering Limited (TJEL). (2014). *SPR-10-AAA-PB-M8605_Rev 1_Process*

Flow Diagram Case-1 (East Gas). Jurong Engineering Limited.



ข้อมูลการดำเนินงานวิจัย ก่อนการปรับปรุง

ข้อมูลในช่วงเดือน มิถุนายน พ.ศ. 2559 ถึง เดือน พฤศจิกายน พ.ศ. 2559 ระยะเวลา 6 เดือน

1. เดือนมิถุนายน พ.ศ. 2559

ATP Performance Statistics							
June-2016						Rev.1	
Description	Unit	Plant	GT11	GT12	ST10		
GENERAL							
1.1	Gross Maximum Power Output	MW	116.67	39.82	39.88	36.97	
1.2	Net Maximum Power Output	MW	113.71				
1.3	Industrial User Steam Capacity (Peak)	T/Hr					
1.4	Net Plant Load Factor	%	64.61%				
1.5	Net Output Factor (Service Period Only)	%	79.06%				
OPERATING							
2.1	Gross Electrical Energy Generation	MWh	64,247.21	22,707.01	21,400.25	20,139.95	
2.2	Gross Elec. Energy + Equiv. Energy Generation	MWh	64,247.21	22,707.01	21,400.25	20,139.95	
2.3	Net Elec Energy Generation	MWh	62,296.84				
2.4	Aux. Power Consumption Station Service	MWh	2,785.68				
2.5	Energy Sale to EGAT	MWh	55,157.53				
2.6	Net Elec. Energy Sale to IUs@ Power Plant Meter	MWh	7,440.37				
2.7	Total Imported Energy from PEA	MWh	4.80				
2.8	Export to (Import from) Interco	MWh	201.37				
2.9	Max. Imported Power form PEA (PEA Peak)	MW	0.00				
2.10	PEA Back up Power Contract	MW	17.37				
2.11	Equivalent Operating Hours	hours		657.00	637.00	735.00	
2.12	Equivalent Operating Hours acc.	hours		4,996.00	4,923.00	4,577.00	
2.13	Equivalent Operating Cycle, EOC acc.			204.00	216.00		
2.14	Start up Time Number @ Machine Panel	times		15.00	17.00	1.00	
STEAM							
3.1	Gross Steam Production	HP	Tons	64,616.13			
		LP	Tons	10,296.19			
3.2	Process Steam Production to IU@Power Plant Meter	Mass	Tons	0.00			
		Energy	MMBTU	0.00			
3.3	Equivalent Electrical Energy of Item 3.2	MWh	0.00				
PERFORMANCE INDEX FACTORS							
4.1	Weighted Equivalent Availability Factor	%	99.70%	99.40%	100.00%	99.70%	
4.2	Weighted Equivalent Planned Outage Factor	%	0.00%	0.00%	0.00%	0.00%	
4.3	Weighted Equivalent Maint. Outage Factor	%	0.30%	0.60%	0.00%	0.30%	
4.4	Weighted Equivalent Forced Outage Factor	%	0.00%	0.00%	0.00%	0.00%	
4.5	IUs Availability Factor (Electricity)	%	100.00%				
4.6	IUs Availability Factor (Steam)@Power Plant Meter	%					
4.7	EGAT Availability Factor	%	98.87%				
4.8	PM Plan Achievement	%	65.67%				
EFFICIENCY							
5.1	Gross Efficiency. (Including Item No. 3.3)	acc. LHV (dry)	%	52.76%	35.99%	36.47%	28.47%
		acc. HHV (sat)	%	47.54%			
5.2	Net Efficiency (Including Item No. 3.3)	acc. LHV (dry)	%	51.16%			
		acc. HHV (sat)	%	46.10%			
5.3	Net Cogen. Efficiency	acc. LHV (dry)	%	51.02%			
5.4	Gross Cogen. Efficiency	acc. LHV (dry)	%	52.76%			
5.5	Gross Heat Rate (Including Item No. 3.3)	acc. LHV (dry)	BTU/KWh	6,467.62	9,481.84	9,356.08	
		acc. HHV (sat)	BTU/KWh	7,177.31			
5.6	Net Heat Rate (Including Item No. 3.3)	acc. LHV (dry)	BTU/KWh	6,669.59			
		acc. HHV (sat)	BTU/KWh	7,401.44			
5.7	SPP Criteria as PPA	PES	%	14.17%			
		Thermal Ratio	%	0.00%			
		MCF	%				
Consumption							
6.1	PTT Invoice	Volumn(sat)	MMSCF	465.79321			
		Energy(LHVdry)	MMBTU	415,526.61	215,304.24	200,222.37	
		Energy(HHVsat)	MMBTU	457,995.00	235,802.40	222,192.60	
6.2	Water Supply	Raw Water	m3	85,332.00			
		Tap Water	m3	0.00			
ENVIRONMENT							
7.1	NOx Emission Gas (max) at 7% O2	ppm		53.69	46.96		
7.2	NOx Emission Gas (mean) at 7% O2	ppm		28.84	31.34		

2. เดือนกรกฎาคม พ.ศ. 2559

ATP Performance Statistics							
July-2016						Rev.1	
Description	Unit	Plant	GT11	GT12	ST10		
GENERAL							
1.1	Gross Maximum Power Output	MW	116.17	39.65	39.65	36.87	
1.2	Net Maximum Power Output	MW	113.27				
1.3	Industrial User Steam Capacity (Peak)	T/Hr					
1.4	Net Plant Load Factor	%	66.46%				
1.5	Net Output Factor (Service Period Only)	%	79.64%				
OPERATING							
2.1	Gross Electrical Energy Generation	MWh	66,071.67	24,163.11	21,061.11	20,847.46	
2.2	Gross Elec. Energy + Equiv. Energy Generation	MWh	66,071.67	24,163.11	21,061.11	20,847.46	
2.3	Net Elec Energy Generation	MWh	64,093.28				
2.4	Aux. Power Consumption Station Service	MWh	2,787.54				
2.5	Energy Sale to EGAT	MWh	56,476.48				
2.6	Net Elec. Energy Sale to IUs@ Power Plant Meter	MWh	7,673.94				
2.7	Total Imported Energy from PEA	MWh	19.21				
2.8	Export to (Import from) Interco	MWh	-115.95				
2.9	Max. Imported Power form PEA (PEA Peak)	MW	2.40				
2.10	PEA Back up Power Contract	MW	17.37				
2.11	Equivalent Operating Hours	hours		681.00	670.00	729.00	
2.12	Equivalent Operating Hours acc.	hours		3,675.00	3,654.00	3,122.00	
2.13	Equivalent Operating Cycle, EOC acc.			176.00	182.00		
2.14	Start up Time Number @ Machine Panel	times		9.00	23.00	3.00	
STEAM							
3.1	Gross Steam Production	HP	Tons	66,721.50			
		LP	Tons	10,569.04			
3.2	Process Steam Production to IU@Power Plant Meter	Mass	Tons	0.00			
		Energy	MMBTU	0.00			
3.3	Equivalent Electrical Energy of Item 3.2	MWh	0.00				
PERFORMANCE INDEX FACTORS							
4.1	Weighted Equivalent Availability Factor	%	100.00%	100.00%	100.00%	100.00%	
4.2	Weighted Equivalent Planned Outage Factor	%	0.00%	0.00%	0.00%	0.00%	
4.3	Weighted Equivalent Maint. Outage Factor	%	0.00%	0.00%	0.00%	0.00%	
4.4	Weighted Equivalent Forced Outage Factor	%	0.00%	0.00%	0.00%	0.00%	
4.5	IUs Availability Factor (Electricity)	%	100.00%				
4.6	IUs Availability Factor (Steam)@Power Plant Meter	%					
4.7	EGAT Availability Factor	%	100.00%				
4.8	PM Plan Achievement	%	71.67%				
EFFICIENCY							
5.1	Gross Efficiency. (Including Item No. 3.3)	acc. LHV (dry)	%	52.69%	35.93%	36.22%	28.55%
		acc. HHV (sat)	%	47.49%			
5.2	Net Efficiency (Including Item No. 3.3)	acc. LHV (dry)	%	51.11%			
		acc. HHV (sat)	%	46.07%			
5.3	Net Cogen. Efficiency	acc. LHV (dry)	%	51.42%			
5.4	Gross Cogen. Efficiency	acc. LHV (dry)	%	52.69%			
5.5	Gross Heat Rate (Including Item No. 3.3)	acc. LHV (dry)	BTU/KWh	6,476.07	9,496.01	9,421.71	
		acc. HHV (sat)	BTU/KWh	7,185.33			
5.6	Net Heat Rate (Including Item No. 3.3)	acc. LHV (dry)	BTU/KWh	6,675.97			
		acc. HHV (sat)	BTU/KWh	7,407.13			
5.7	SPP Criteria as PPA	PES	%	14.06%			
		Thermal Ratio	%	0.00%			
		MCF	%				
Consumption							
6.1	PTT Invoice	Volumn(sat)	MMSCF	481.33919			
		Energy(LHVdry)	MMBTU	427,884.76	229,453.20	198,431.56	
		Energy(HHVsat)	MMBTU	460,400.10	240,236.18	220,163.92	
6.2	Water Supply	Raw Water	m3	95,047.00			
		Tap Water	m3	0.00			
ENVIRONMENT							
7.1	NOx Emission Gas (max) at 7% O2	ppm		51.96	51.42		
7.2	NOx Emission Gas (mean) at 7% O2	ppm		29.78	29.60		

3. เดือนสิงหาคม พ.ศ. 2559

ATP Performance Statistics							
August-2016						Rev.1	
Description	Unit	Plant	GT11	GT12	ST10		
GENERAL							
1.1	Gross Maximum Power Output	MW	116.80	39.96	39.95	36.89	
1.2	Net Maximum Power Output	MW	114.21				
1.3	Industrial User Steam Capacity (Peak)	T/Hr	0.00				
1.4	Net Plant Load Factor	%	66.63%				
1.5	Net Output Factor (Service Period Only)	%	79.07%				
OPERATING							
2.1	Gross Electrical Energy Generation	MWh	66,152.37	24,555.77	20,633.40	20,963.21	
2.2	Gross Elec. Energy + Equiv. Energy Generation	MWh	66,152.37	24,555.77	20,633.40	20,963.21	
2.3	Net Elec Energy Generation	MWh	64,093.28				
2.4	Aux. Power Consumption Station Service	MWh	2,784.72				
2.5	Energy Sale to EGAT	MWh	56,960.71				
2.6	Net Elec. Energy Sale to IUs@ Power Plant Meter	MWh	8,427.06				
2.7	Total Imported Energy from PEA	MWh	0.00				
2.8	Export to (Import from) Interco	MWh	-1,356.64				
2.9	Max. Imported Power form PEA (PEA Peak)	MW	0.00				
2.10	PEA Back up Power Contract	MW	17.37				
2.11	Equivalent Operating Hours	hours		692.00	642.00	744.00	
2.12	Equivalent Operating Hours acc.	hours		5,688.00	5,565.00	5,320.00	
2.13	Equivalent Operating Cycle, EOC acc.			218.00	234.00		
2.14	Start up Time Number @ Machine Panel	times		13.00	19.00	0.00	
STEAM							
3.1	Gross Steam Production	HP	Tons	67,227.00			
		LP	Tons	10,546.52			
3.2	Process Steam Production to IU@Power Plant Meter	Mass	Tons	0.00			
		Energy	MMBTU	0.00			
3.3	Equivalent Electrical Energy of Item 3.2	MWh	0.00				
PERFORMANCE INDEX FACTORS							
4.1	Weighted Equivalent Availability Factor	%	98.26%	98.14%	98.57%	98.05%	
4.2	Weighted Equivalent Planned Outage Factor	%	0.00%	0.00%	0.00%	0.00%	
4.3	Weighted Equivalent Maint. Outage Factor	%	1.41%	1.36%	1.27%	1.62%	
4.4	Weighted Equivalent Forced Outage Factor	%	0.33%	0.50%	0.17%	0.32%	
4.5	IUs Availability Factor (Electricity)	%	100.00%				
4.6	IUs Availability Factor (Steam)@Power Plant Meter	%	100.00%				
4.7	EGAT Availability Factor	%	99.86%				
4.8	PM Plan Achievement	%	32.14%				
EFFICIENCY							
5.1	Gross Efficiency. (Including Item No. 3.3)	acc. LHV (dry)	%	52.47%	35.81%	35.88%	28.34%
		acc. HHV (sat)	%	47.30%			
5.2	Net Efficiency (Including Item No. 3.3)	acc. LHV (dry)	%	50.96%			
		acc. HHV (sat)	%	45.95%			
5.3	Net Cogen. Efficiency	acc. LHV (dry)	%	51.12%			
5.4	Gross Cogen. Efficiency	acc. LHV (dry)	%	52.47%			
5.5	Gross Heat Rate (Including Item No. 3.3)	acc. LHV (dry)	BTU/KWh	6,503.22	9,529.68	9,508.61	
		acc. HHV (sat)	BTU/KWh	7,213.17			
5.6	Net Heat Rate (Including Item No. 3.3)	acc. LHV (dry)	BTU/KWh	6,695.48			
		acc. HHV (sat)	BTU/KWh	7,426.42			
5.7	SPP Criteria as PPA	PES	%	13.70%			
		Thermal Ratio	%	0.00%			
		MCF	%				
Consumption							
6.1	PTT Invoice	Volumn(sat)	MMSCF	481.04330			
		Energy(LHVdry)	MMBTU	430,203.46	234,008.47	196,194.99	
		Energy(HHVsat)	MMBTU	459,424.50	239,260.58	220,163.92	
6.2	Water Supply	Raw Water	m3	53,007.00			
		Tap Water	m3	0.00			
ENVIRONMENT							
7.1	NOx Emission Gas (max) at 7% O2	ppm		50.16	50.47		
7.2	NOx Emission Gas (mean) at 7% O2	ppm		30.98	30.94		

4. เดือนกันยายน พ.ศ. 2559

ATP Performance Statistics							
September-2016						Rev.1	
Description	Unit	Plant	GT11	GT12	ST10		
GENERAL							
1.1	Gross Maximum Power Output	MW	116.47	39.75	39.76	36.96	
1.2	Net Maximum Power Output	MW	113.53				
1.3	Industrial User Steam Capacity (Peak)	T/Hr	0.00				
1.4	Net Plant Load Factor	%	67.21%				
1.5	Net Output Factor (Service Period Only)	%	79.81%				
OPERATING							
2.1	Gross Electrical Energy Generation	MWh	64,647.12	23,277.91	20,987.76	20,381.44	
2.2	Gross Elec. Energy + Equiv. Energy Generation	MWh	64,647.12	23,277.91	20,987.76	20,381.44	
2.3	Net Elec Energy Generation	MWh	62,721.70				
2.4	Aux. Power Consumption Station Service	MWh	2,786.46				
2.5	Energy Sale to EGAT	MWh	55,209.76				
2.6	Net Elec. Energy Sale to IUs@ Power Plant Meter	MWh	7,219.12				
2.7	Total Imported Energy from PEA	MWh	0.00				
2.8	Export to (Import from) Interco	MWh	201.88				
2.9	Max. Imported Power form PEA (PEA Peak)	MW	0.00				
2.10	PEA Back up Power Contract	MW	17.37				
2.11	Equivalent Operating Hours	hours		664.00	632.00	720.00	
2.12	Equivalent Operating Hours acc.	hours		4,339.00	4,286.00	3,842.00	
2.13	Equivalent Operating Cycle, EOC acc.			189.00	199.00		
2.14	Start up Time Number @ Machine Panel	times		13.00	17.00	1.00	
STEAM							
3.1	Gross Steam Production	HP	Tons	65,217.40			
		LP	Tons	10,318.33			
3.2	Process Steam Production to IU@Power Plant Meter	Mass	Tons	0.00			
		Energy	MMBTU	0.00			
3.3	Equivalent Electrical Energy of Item 3.2	MWh	0.00				
PERFORMANCE INDEX FACTORS							
4.1	Weighted Equivalent Availability Factor	%	99.95%	99.91%	99.99%	99.95%	
4.2	Weighted Equivalent Planned Outage Factor	%	0.00%	0.00%	0.00%	0.00%	
4.3	Weighted Equivalent Maint. Outage Factor	%	0.03%	0.09%	0.00%	0.00%	
4.4	Weighted Equivalent Forced Outage Factor	%	0.02%	0.00%	0.01%	0.05%	
4.5	IUs Availability Factor (Electricity)	%	100.00%				
4.6	IUs Availability Factor (Steam)@Power Plant Meter	%	100.00%				
4.7	EGAT Availability Factor	%	99.98%				
4.8	PM Plan Achievement	%	57.14%				
EFFICIENCY							
5.1	Gross Efficiency. (Including Item No. 3.3)	acc. LHV (dry)	%	52.70%	35.92%	36.27%	28.77%
		acc. HHV (sat)	%	47.51%			
5.2	Net Efficiency (Including Item No. 3.3)	acc. LHV (dry)	%	51.13%			
		acc. HHV (sat)	%	46.09%			
5.3	Net Cogen. Efficiency	acc. LHV (dry)	%	51.08%			
5.4	Gross Cogen. Efficiency	acc. LHV (dry)	%	52.70%			
5.5	Gross Heat Rate (Including Item No. 3.3)	acc. LHV (dry)	BTU/KWh	6,474.89	9,499.48	9,408.10	
		acc. HHV (sat)	BTU/KWh	7,182.33			
5.6	Net Heat Rate (Including Item No. 3.3)	acc. LHV (dry)	BTU/KWh	6,673.66			
		acc. HHV (sat)	BTU/KWh	7,402.81			
5.7	SPP Criteria as PPA	PES	%	14.08%			
		Thermal Ratio	%	0.00%			
		MCF	%				
Consumption							
6.1	PTT Invoice	Volumn(sat)	MMSCF	471.86803			
		Energy(LHVdry)	MMBTU	418,583.06	221,128.07	197,454.99	
		Energy(HHVsat)	MMBTU	453,890.40	233,726.48	220,163.92	
6.2	Water Supply	Raw Water	m3	87,581.00			
		Tap Water	m3	0.00			
ENVIRONMENT							
7.1	NOx Emission Gas (max) at 7% O2	ppm		47.02	45.70		
7.2	NOx Emission Gas (mean) at 7% O2	ppm		30.10	31.17		

5. เดือนตุลาคม พ.ศ. 2559

ATP Performance Statistics							
October-2016						Rev.1	
Description	Unit	Plant	GT11	GT12	ST10		
GENERAL							
1.1	Gross Maximum Power Output	MW	96.51	31.58	31.56	33.37	
1.2	Net Maximum Power Output	MW	93.90				
1.3	Industrial User Steam Capacity (Peak)	T/Hr	0.00				
1.4	Net Plant Load Factor	%	59.43%				
1.5	Net Output Factor (Service Period Only)	%	69.99%				
OPERATING							
2.1	Gross Electrical Energy Generation	MWh	59,370.39	20,156.68	19,484.84	19,728.87	
2.2	Gross Elec. Energy + Equiv. Energy Generation	MWh	59,370.39	20,156.68	19,484.84	19,728.87	
2.3	Net Elec Energy Generation	MWh	57,313.72				
2.4	Aux. Power Consumption Station Service	MWh	2,785.92				
2.5	Energy Sale to EGAT	MWh	57,313.72				
2.6	Net Elec. Energy Sale to IUs@ Power Plant Meter	MWh	4,755.69				
2.7	Total Imported Energy from PEA	MWh	10.80				
2.8	Export to (Import from) Interco	MWh	-4,566.22				
2.9	Max. Imported Power form PEA (PEA Peak)	MW	1.68				
2.10	PEA Back up Power Contract	MW	17.37				
2.11	Equivalent Operating Hours	hours		673.00	731.00	731.00	
2.12	Equivalent Operating Hours acc.	hours		2,364.00	2,368.00	1,673.00	
2.13	Equivalent Operating Cycle, EOC acc.			149.00	174.00		
2.14	Start up Time Number @ Machine Panel	times		14.00	20.00	2.00	
STEAM							
3.1	Gross Steam Production	HP	Tons	63,409.22			
		LP	Tons	9,411.56			
3.2	Process Steam Production to IU@Power Plant Meter	Mass	Tons	0.00			
		Energy	MMBTU	0.00			
3.3	Equivalent Electrical Energy of Item 3.2	MWh	0.00				
PERFORMANCE INDEX FACTORS							
4.1	Weighted Equivalent Availability Factor	%	99.49%	100.00%	98.73%	99.76%	
4.2	Weighted Equivalent Planned Outage Factor	%	0.00%	0.00%	0.00%	0.00%	
4.3	Weighted Equivalent Maint. Outage Factor	%	0.00%	0.00%	0.00%	0.00%	
4.4	Weighted Equivalent Forced Outage Factor	%	0.51%	0.00%	1.27%	0.24%	
4.5	IUs Availability Factor (Electricity)	%	100.00%				
4.6	IUs Availability Factor (Steam)@Power Plant Meter	%	100.00%				
4.7	EGAT Availability Factor	%	100.00%				
4.8	PM Plan Achievement	%	0.00%				
EFFICIENCY							
5.1	Gross Efficiency. (Including Item No. 3.3)	acc. LHV (dry)	%	51.34%	34.14%	34.42%	28.58%
		acc. HHV (sat)	%	46.30%			
5.2	Net Efficiency (Including Item No. 3.3)	acc. LHV (dry)	%	49.56%			
		acc. HHV (sat)	%	44.70%			
5.3	Net Cogen. Efficiency	acc. LHV (dry)	%	51.23%			
5.4	Gross Cogen. Efficiency	acc. LHV (dry)	%	51.34%			
5.5	Gross Heat Rate (Including Item No. 3.3)	acc. LHV (dry)	BTU/KWh	6,646.71	9,993.45	9,914.52	
		acc. HHV (sat)	BTU/KWh	7,369.45			
5.6	Net Heat Rate (Including Item No. 3.3)	acc. LHV (dry)	BTU/KWh	6,885.22			
		acc. HHV (sat)	BTU/KWh	7,633.90			
5.7	SPP Criteria as PPA	PES	%	11.80%			
		Thermal Ratio	%	0.00%			
		MCF	%				
Consumption							
6.1	PTT Invoice	Volumn(sat)	MMSCF	446.43516			
		Energy(LHVdry)	MMBTU	394,617.55	201,434.79	193,182.76	
		Energy(HHVsat)	MMBTU	453,252.60	233,088.68	220,163.92	
6.2	Water Supply	Raw Water	m3	62,742.00			
		Tap Water	m3	0.00			
ENVIRONMENT							
7.1	NOx Emission Gas (max) at 7% O2	ppm		59.69	55.40		
7.2	NOx Emission Gas (mean) at 7% O2	ppm		32.63	32.44		

6. เดือนพฤศจิกายน พ.ศ. 2559

ATP Performance Statistics							
November-2016						Rev.1	
Description	Unit	Plant	GT11	GT12	ST10		
GENERAL							
1.1	Gross Maximum Power Output	MW	94.96	30.95	30.93	33.09	
1.2	Net Maximum Power Output	MW	92.24				
1.3	Industrial User Steam Capacity (Peak)	T/Hr	0.00				
1.4	Net Plant Load Factor	%	55.45%				
1.5	Net Output Factor (Service Period Only)	%	69.31%				
OPERATING							
2.1	Gross Electrical Energy Generation	MWh	49,966.12	16,021.58	17,551.24	16,393.30	
2.2	Gross Elec. Energy + Equiv. Energy Generation	MWh	49,966.12	16,021.58	17,551.24	16,393.30	
2.3	Net Elec Energy Generation	MWh	48,299.40				
2.4	Aux. Power Consumption Station Service	MWh	2,790.90				
2.5	Energy Sale to EGAT	MWh	48,299.40				
2.6	Net Elec. Energy Sale to IUs@ Power Plant Meter	MWh	4,713.64				
2.7	Total Imported Energy from PEA	MWh	26.40				
2.8	Export to (Import from) Interco	MWh	-4,687.29				
2.9	Max. Imported Power form PEA (PEA Peak)	MW	3.12				
2.10	PEA Back up Power Contract	MW	17.37				
2.11	Equivalent Operating Hours	hours		560.00	618.00	651.00	
2.12	Equivalent Operating Hours acc.	hours		1,691.00	1,637.00	942.00	
2.13	Equivalent Operating Cycle, EOC acc.			135.00	119.00		
2.14	Start up Time Number @ Machine Panel	times		17.00	14.00	2.00	
STEAM							
3.1	Gross Steam Production	HP	Tons	52,785.84			
		LP	Tons	7,815.15			
3.2	Process Steam Production to IU@Power Plant Meter	Mass	Tons	0.00			
		Energy	MMBTU	0.00			
3.3	Equivalent Electrical Energy of Item 3.2	MWh	0.00				
PERFORMANCE INDEX FACTORS							
4.1	Weighted Equivalent Availability Factor	%	99.56%	99.88%	99.10%	99.70%	
4.2	Weighted Equivalent Planned Outage Factor	%	0.00%	0.00%	0.00%	0.00%	
4.3	Weighted Equivalent Maint. Outage Factor	%	0.00%	0.00%	0.00%	0.00%	
4.4	Weighted Equivalent Forced Outage Factor	%	0.44%	0.12%	0.90%	0.30%	
4.5	IUs Availability Factor (Electricity)	%	100.00%				
4.6	IUs Availability Factor (Steam)@Power Plant Meter	%	100.00%				
4.7	EGAT Availability Factor	%	100.00%				
4.8	PM Plan Achievement	%	0.00%				
EFFICIENCY							
5.1	Gross Efficiency. (Including Item No. 3.3)	acc. LHV (dry)	%	51.31%	34.22%	34.72%	28.53%
		acc. HHV (sat)	%	46.28%			
5.2	Net Efficiency (Including Item No. 3.3)	acc. LHV (dry)	%	49.60%			
		acc. HHV (sat)	%	44.74%			
5.3	Net Cogen. Efficiency	acc. LHV (dry)	%	51.29%			
5.4	Gross Cogen. Efficiency	acc. LHV (dry)	%	51.31%			
5.5	Gross Heat Rate (Including Item No. 3.3)	acc. LHV (dry)	BTU/KWh	6,649.83	9,971.27	9,828.98	
		acc. HHV (sat)	BTU/KWh	7,372.11			
5.6	Net Heat Rate (Including Item No. 3.3)	acc. LHV (dry)	BTU/KWh	6,879.31			
		acc. HHV (sat)	BTU/KWh	7,626.51			
5.7	SPP Criteria as PPA	PES	%	11.76%			
		Thermal Ratio	%	0.00%			
		MCF	%				
Consumption							
6.1	PTT Invoice	Volumn(sat)	MMSCF	481.33919			
		Energy(LHVdry)	MMBTU	427,884.76	229,453.20	198,431.56	
		Energy(HHVsat)	MMBTU	463,022.40	242,858.48	220,163.92	
6.2	Water Supply	Raw Water	m3	62,742.00			
		Tap Water	m3	0.00			
ENVIRONMENT							
7.1	NOx Emission Gas (max) at 7% O2	ppm		59.69	55.40		
7.2	NOx Emission Gas (mean) at 7% O2	ppm		32.63	32.44		

ข้อมูลการดำเนินงานวิจัย หลังการปรับปรุง

ข้อมูลในช่วงเดือน มกราคม พ.ศ. 2560 ถึง เดือน มิถุนายน พ.ศ. 2560 ระยะเวลา 6 เดือน

1. เดือนมกราคม พ.ศ. 2560

ATP Performance Statistics							
January-2017						Rev.1	
Description	Unit	Plant	GT11	GT12	ST10		
GENERAL							
1.1	Gross Maximum Power Output	MW	116.28	39.65	39.58	37.05	
1.2	Net Maximum Power Output	MW	113.76				
1.3	Industrial User Steam Capacity (Peak)	T/Hr	0.00				
1.4	Net Plant Load Factor	%	59.31%				
1.5	Net Output Factor (Service Period Only)	%	77.42%				
OPERATING							
2.1	Gross Electrical Energy Generation	MWh	58,805.23	18,008.65	21,981.85	18,814.74	
2.2	Gross Elec. Energy + Equiv. Energy Generation	MWh	58,805.23	18,008.65	21,981.85	18,814.74	
2.3	Net Elec Energy Generation	MWh	57,170.34				
2.4	Aux. Power Consumption Station Service	MWh	1,989.90				
2.5	Energy Sale to EGAT	MWh	53,615.29				
2.6	Net Elec. Energy Sale to IUs@ Power Plant Meter	MWh	2,416.01				
2.7	Total Imported Energy from PEA	MWh	1.20				
2.8	Export to (Import from) Interco	MWh	1,171.00				
2.9	Max. Imported Power form PEA (PEA Peak)	MW	0.00				
2.10	PEA Back up Power Contract	MW	17.37				
2.11	Equivalent Operating Hours	hours		637.00	673.00	736.00	
2.12	Equivalent Operating Hours acc.	hours		5,567.00	5,319.00	5,381.00	
2.13	Equivalent Operating Cycle, EOC acc.			202.00	208.00		
2.14	Start up Time Number @ Machine Panel	times		22.00	9.00	2.00	
STEAM							
3.1	Gross Steam Production	HP	Tons	60,183.53			
		LP	Tons	9,469.84			
3.2	Process Steam Production to IU@Power Plant Meter	Mass	Tons	0.00			
		Energy	MMBTU	0.00			
3.3	Equivalent Electrical Energy of Item 3.2	MWh	0.00				
PERFORMANCE INDEX FACTORS							
4.1	Weighted Equivalent Availability Factor	%	97.56%	99.87%	93.29%	99.79%	
4.2	Weighted Equivalent Planned Outage Factor	%	0.00%	0.00%	0.00%	0.00%	
4.3	Weighted Equivalent Maint. Outage Factor	%	2.31%	0.00%	6.67%	0.00%	
4.4	Weighted Equivalent Forced Outage Factor	%	0.12%	0.13%	0.04%	0.21%	
4.5	IUs Availability Factor (Electricity)	%	100.00%				
4.6	IUs Availability Factor (Steam)@Power Plant Meter	%					
4.7	EGAT Availability Factor	%	99.22%				
4.8	PM Plan Achievement	%	100.00%				
EFFICIENCY							
5.1	Gross Efficiency. (Including Item No. 3.3)	acc. LHV (dry)	%	52.38%	35.17%	35.99%	28.55%
		acc. HHV (sat)	%	47.21%			
5.2	Net Efficiency (Including Item No. 3.3)	acc. LHV (dry)	%	50.92%			
		acc. HHV (sat)	%	45.90%			
5.3	Net Cogen. Efficiency	acc. LHV (dry)	%	51.44%			
5.4	Gross Cogen. Efficiency	acc. LHV (dry)	%	52.38%			
5.5	Gross Heat Rate (Including Item No. 3.3)	acc. LHV (dry)	BTU/KWh	6,514.80	9,701.73	9,480.05	
		acc. HHV (sat)	BTU/KWh	7,227.49			
5.6	Net Heat Rate (Including Item No. 3.3)	acc. LHV (dry)	BTU/KWh	6,701.10			
		acc. HHV (sat)	BTU/KWh	7,434.17			
5.7	SPP Criteria as PPA	PES	%	13.55%			
		Thermal Ratio	%	0.00%			
		MCF	%				
Consumption							
6.1	PTT Invoice	Volumn(sat)	MMSCF	436.79809			
		Energy(LHVdry)	MMBTU	383,104.10	174,715.00	208,389.11	
		Energy(HHVsat)	MMBTU	438,097.20	206,911.25	231,185.95	
6.2	Water Supply	Raw Water	m3	89,790.50			
		Tap Water	m3	0.00			
ENVIRONMENT							
7.1	NOx Emission Gas (max) at 7% O2	ppm		32.71	41.01		
7.2	NOx Emission Gas (mean) at 7% O2	ppm		14.90	25.36		

2. เดือนกุมภาพันธ์ พ.ศ. 2560

ATP Performance Statistics							
February-2017						Rev.1	
Description	Unit	Plant	GT11	GT12	ST10		
GENERAL							
1.1	Gross Maximum Power Output	MW	115.58	39.33	39.30	36.95	
1.2	Net Maximum Power Output	MW	113.17				
1.3	Industrial User Steam Capacity (Peak)	T/Hr	0.00				
1.4	Net Plant Load Factor	%	61.81%				
1.5	Net Output Factor (Service Period Only)	%	78.21%				
OPERATING							
2.1	Gross Electrical Energy Generation	MWh	59,255.90	18,583.82	21,834.83	18,837.26	
2.2	Gross Elec. Energy + Equiv. Energy Generation	MWh	59,255.90	18,583.82	21,834.83	18,837.26	
2.3	Net Elec Energy Generation	MWh	57,659.05				
2.4	Aux. Power Consumption Station Service	MWh	1,953.90				
2.5	Energy Sale to EGAT	MWh	52,478.91				
2.6	Net Elec. Energy Sale to IUs@ Power Plant Meter	MWh	2,600.47				
2.7	Total Imported Energy from PEA	MWh	1.20				
2.8	Export to (Import from) Interco	MWh	2,528.03				
2.9	Max. Imported Power form PEA (PEA Peak)	MW	0.00				
2.10	PEA Back up Power Contract	MW	17.37				
2.11	Equivalent Operating Hours	hours		591.00	629.00	710.00	
2.12	Equivalent Operating Hours acc.	hours		4,930.00	4,646.00	4,645.00	
2.13	Equivalent Operating Cycle, EOC acc.			173.00	190.00		
2.14	Start up Time Number @ Machine Panel	times		18.00	13.00	1.00	
STEAM							
3.1	Gross Steam Production	HP	Tons	60,102.06			
		LP	Tons	9,498.19			
3.2	Process Steam Production to IU@Power Plant Meter	Mass	Tons	0.00			
		Energy	MMBTU	0.00			
3.3	Equivalent Electrical Energy of Item 3.2	MWh	0.00				
PERFORMANCE INDEX FACTORS							
4.1	Weighted Equivalent Availability Factor	%	100.00%	100.00%	100.00%	100.00%	
4.2	Weighted Equivalent Planned Outage Factor	%	0.00%	0.00%	0.00%	0.00%	
4.3	Weighted Equivalent Maint. Outage Factor	%	0.00%	0.00%	0.00%	0.00%	
4.4	Weighted Equivalent Forced Outage Factor	%	0.00%	0.00%	0.00%	0.00%	
4.5	IUs Availability Factor (Electricity)	%	100.00%				
4.6	IUs Availability Factor (Steam)@Power Plant Meter	%					
4.7	EGAT Availability Factor	%	98.70%				
4.8	PM Plan Achievement	%	50.00%				
EFFICIENCY							
5.1	Gross Efficiency. (Including Item No. 3.3)	acc. LHV (dry)	%	52.50%	35.45%	36.12%	28.62%
		acc. HHV (sat)	%	47.36%			
5.2	Net Efficiency (Including Item No. 3.3)	acc. LHV (dry)	%	51.08%			
		acc. HHV (sat)	%	46.08%			
5.3	Net Cogen. Efficiency	acc. LHV (dry)	%	51.84%			
5.4	Gross Cogen. Efficiency	acc. LHV (dry)	%	52.50%			
5.5	Gross Heat Rate (Including Item No. 3.3)	acc. LHV (dry)	BTU/KWh	6,499.75	9,625.10	9,447.18	
		acc. HHV (sat)	BTU/KWh	7,204.65			
5.6	Net Heat Rate (Including Item No. 3.3)	acc. LHV (dry)	BTU/KWh	6,679.76			
		acc. HHV (sat)	BTU/KWh	7,404.18			
5.7	SPP Criteria as PPA	PES	%	13.75%			
		Thermal Ratio	%	0.00%			
		MCF	%				
Consumption							
6.1	PTT Invoice	Volumn(sat)	MMSCF	435.98357			
		Energy(LHVdry)	MMBTU	385,148.59	178,871.15	206,277.44	
		Energy(HHVsat)	MMBTU	441,645.60	212,997.35	228,648.25	
6.2	Water Supply	Raw Water	m3	88,472.00			
		Tap Water	m3	0.00			
ENVIRONMENT							
7.1	NOx Emission Gas (max) at 7% O2	ppm		36.09	37.08		
7.2	NOx Emission Gas (mean) at 7% O2	ppm		18.89	24.64		

3. เดือนมีนาคม พ.ศ. 2560

ATP Performance Statistics							
March-2017						Rev.1	
Description	Unit	Plant	GT11	GT12	ST10		
GENERAL							
1.1	Gross Maximum Power Output	MW	115.77	39.41	39.35	37.01	
1.2	Net Maximum Power Output	MW	113.34				
1.3	Industrial User Steam Capacity (Peak)	T/Hr	18.76				
1.4	Net Plant Load Factor	%	57.77%				
1.5	Net Output Factor (Service Period Only)	%	72.38%				
OPERATING							
2.1	Gross Electrical Energy Generation	MWh	57,319.38	21,477.01	17,177.42	18,664.95	
2.2	Gross Elec. Energy + Equiv. Energy Generation	MWh	57,319.38	21,477.01	17,177.42	18,664.95	
2.3	Net Elec Energy Generation	MWh	55,689.11				
2.4	Aux. Power Consumption Station Service	MWh	2,010.00				
2.5	Energy Sale to EGAT	MWh	54,130.64				
2.6	Net Elec. Energy Sale to IUs@ Power Plant Meter	MWh	2,783.48				
2.7	Total Imported Energy from PEA	MWh	3.60				
2.8	Export to (Import from) Interco	MWh	-1,230.30				
2.9	Max. Imported Power form PEA (PEA Peak)	MW	2.52				
2.10	PEA Back up Power Contract	MW	17.37				
2.11	Equivalent Operating Hours	hours		662.00	615.00	724.00	
2.12	Equivalent Operating Hours acc.	hours		4,339.00	4,017.00	3,935.00	
2.13	Equivalent Operating Cycle, EOC acc.			154.00	178.00		
2.14	Start up Time Number @ Machine Panel	times		12.00	22.00	8.00	
STEAM							
3.1	Gross Steam Production	HP	Tons	60,229.22			
		LP	Tons	8,796.61			
3.2	Process Steam Production to IU@Power Plant Meter	Mass	Tons	0.00			
		Energy	MMBTU	0.00			
3.3	Equivalent Electrical Energy of Item 3.2	MWh	0.00				
PERFORMANCE INDEX FACTORS							
4.1	Weighted Equivalent Availability Factor	%	99.74%	100.00%	100.00%	99.16%	
4.2	Weighted Equivalent Planned Outage Factor	%	0.00%	0.00%	0.00%	0.00%	
4.3	Weighted Equivalent Maint. Outage Factor	%	0.00%	0.00%	0.00%	0.00%	
4.4	Weighted Equivalent Forced Outage Factor	%	0.26%	0.00%	0.00%	0.84%	
4.5	IUs Availability Factor (Electricity)	%	100.00%				
4.6	IUs Availability Factor (Steam)@Power Plant Meter	%					
4.7	EGAT Availability Factor	%	97.86%				
4.8	PM Plan Achievement	%	83.33%				
EFFICIENCY							
5.1	Gross Efficiency. (Including Item No. 3.3)	acc. LHV (dry)	%	51.74%	34.92%	34.85%	28.47%
		acc. HHV (sat)	%	46.67%			
5.2	Net Efficiency (Including Item No. 3.3)	acc. LHV (dry)	%	50.26%			
		acc. HHV (sat)	%	45.34%			
5.3	Net Cogen. Efficiency	acc. LHV (dry)	%	51.54%			
5.4	Gross Cogen. Efficiency	acc. LHV (dry)	%	51.74%			
5.5	Gross Heat Rate (Including Item No. 3.3)	acc. LHV (dry)	BTU/KWh	6,595.37	9,771.76	9,790.43	
		acc. HHV (sat)	BTU/KWh	7,311.87			
5.6	Net Heat Rate (Including Item No. 3.3)	acc. LHV (dry)	BTU/KWh	6,788.45			
		acc. HHV (sat)	BTU/KWh	7,525.92			
5.7	SPP Criteria as PPA	PES	%	12.48%			
		Thermal Ratio	%	0.00%			
		MCF	%				
Consumption							
6.1	PTT Invoice	Volumn(sat)	MMSCF	427.87490			
		Energy(LHVdry)	MMBTU	378,042.56	209,868.27	168,174.29	
		Energy(HHVsat)	MMBTU	442,450.20	232,667.75	209,782.45	
6.2	Water Supply	Raw Water	m3	94,854.00			
		Tap Water	m3	0.00			
ENVIRONMENT							
7.1	NOx Emission Gas (max) at 7% O2	ppm		49.80	48.05		
7.2	NOx Emission Gas (mean) at 7% O2	ppm		25.32	22.30		

4. เดือนเมษายน พ.ศ. 2560


ATP Performance Statistics							
April-2017						Rev.1	
Description	Unit	Plant	GT11	GT12	ST10		
GENERAL							
1.1	Gross Maximum Power Output	MW	115.60	39.35	39.29	36.96	
1.2	Net Maximum Power Output	MW	113.04				
1.3	Industrial User Steam Capacity (Peak)	T/Hr	0.00				
1.4	Net Plant Load Factor	%	60.86%				
1.5	Net Output Factor (Service Period Only)	%	73.85%				
OPERATING							
2.1	Gross Electrical Energy Generation	MWh	60,314.75	25,486.34	15,127.33	19,701.08	
2.2	Gross Elec. Energy + Equiv. Energy Generation	MWh	60,314.75	25,486.34	15,127.33	19,701.08	
2.3	Net Elec Energy Generation	MWh	58,660.46				
2.4	Aux. Power Consumption Station Service	MWh	2,022.30				
2.5	Energy Sale to EGAT	MWh	55,953.41				
2.6	Net Elec. Energy Sale to IUs@ Power Plant Meter	MWh	2,633.23				
2.7	Total Imported Energy from PEA	MWh	0.00				
2.8	Export to (Import from) Interco	MWh	63.98				
2.9	Max. Imported Power form PEA (PEA Peak)	MW	0.00				
2.10	PEA Back up Power Contract	MW	17.37				
2.11	Equivalent Operating Hours	hours		713.00	581.00	744.00	
2.12	Equivalent Operating Hours acc.	hours		6,280.00	5,900.00	6,125.00	
2.13	Equivalent Operating Cycle, EOC acc.			207.00	234.00		
2.14	Start up Time Number @ Machine Panel	times		5.00	26.00	0.00	
STEAM							
3.1	Gross Steam Production	HP	Tons	62,827.10			
		LP	Tons	9,660.44			
3.2	Process Steam Production to IU@Power Plant Meter	Mass	Tons	0.00			
		Energy	MMBTU	0.00			
3.3	Equivalent Electrical Energy of Item 3.2	MWh	0.00				
PERFORMANCE INDEX FACTORS							
4.1	Weighted Equivalent Availability Factor	%	99.82%	100.00%	99.64%	99.82%	
4.2	Weighted Equivalent Planned Outage Factor	%	0.00%	0.00%	0.00%	0.00%	
4.3	Weighted Equivalent Maint. Outage Factor	%	0.00%	0.00%	0.00%	0.00%	
4.4	Weighted Equivalent Forced Outage Factor	%	0.18%	0.00%	0.36%	0.18%	
4.5	IUs Availability Factor (Electricity)	%	100.00%				
4.6	IUs Availability Factor (Steam)@Power Plant Meter	%					
4.7	EGAT Availability Factor	%	100.00%				
4.8	PM Plan Achievement	%	95.45%				
EFFICIENCY							
5.1	Gross Efficiency. (Including Item No. 3.3)	acc. LHV (dry)	%	52.15%	35.34%	34.73%	28.72%
		acc. HHV (sat)	%	47.01%			
5.2	Net Efficiency (Including Item No. 3.3)	acc. LHV (dry)	%	50.72%			
		acc. HHV (sat)	%	45.72%			
5.3	Net Cogen. Efficiency	acc. LHV (dry)	%	51.50%			
5.4	Gross Cogen. Efficiency	acc. LHV (dry)	%	52.15%			
5.5	Gross Heat Rate (Including Item No. 3.3)	acc. LHV (dry)	BTU/KWh	6,543.40	9,653.99	9,824.51	
		acc. HHV (sat)	BTU/KWh	7,258.01			
5.6	Net Heat Rate (Including Item No. 3.3)	acc. LHV (dry)	BTU/KWh	6,727.93			
		acc. HHV (sat)	BTU/KWh	7,462.69			
5.7	SPP Criteria as PPA	PES	%	13.17%			
		Thermal Ratio	%	0.00%			
		MCF	%				
Consumption							
6.1	PTT Invoice	Volumn(sat)	MMSCF	443.49314			
		Energy(LHVdry)	MMBTU	394,663.47	246,044.89	148,618.59	
		Energy(HHVsat)	MMBTU	436,025.40	271,176.05	164,849.35	
6.2	Water Supply	Raw Water	m3	89,556.00			
		Tap Water	m3	0.00			
ENVIRONMENT							
7.1	NOx Emission Gas (max) at 7% O2	ppm		57.62	44.41		
7.2	NOx Emission Gas (mean) at 7% O2	ppm		27.13	21.85		

5. เดือนพฤษภาคม พ.ศ. 2560

ATP Performance Statistics							
May-2017						Rev.1	
Description	Unit	Plant	GT11	GT12	ST10		
GENERAL							
1.1	Gross Maximum Power Output	MW	117.14	40.04	39.99	37.11	
1.2	Net Maximum Power Output	MW	114.57				
1.3	Industrial User Steam Capacity (Peak)	T/Hr	0.00				
1.4	Net Plant Load Factor	%	61.87%				
1.5	Net Output Factor (Service Period Only)	%	74.65%				
OPERATING							
2.1	Gross Electrical Energy Generation	MWh	55,373.81	20,809.03	16,504.50	18,060.28	
2.2	Gross Elec. Energy + Equiv. Energy Generation	MWh	55,373.81	20,809.03	16,504.50	18,060.28	
2.3	Net Elec Energy Generation	MWh	53,867.50				
2.4	Aux. Power Consumption Station Service	MWh	2,008.50				
2.5	Energy Sale to EGAT	MWh	51,055.33				
2.6	Net Elec. Energy Sale to IUs@ Power Plant Meter	MWh	2,567.11				
2.7	Total Imported Energy from PEA	MWh	0.00				
2.8	Export to (Import from) Interco	MWh	279.65				
2.9	Max. Imported Power form PEA (PEA Peak)	MW	0.00				
2.10	PEA Back up Power Contract	MW	17.37				
2.11	Equivalent Operating Hours	hours		619.00	565.00	672.00	
2.12	Equivalent Operating Hours acc.	hours		6,899.00	6,465.00	6,797.00	
2.13	Equivalent Operating Cycle, EOC acc.			217.00	252.00		
2.14	Start up Time Number @ Machine Panel	times		10.00	18.00	0.00	
STEAM							
3.1	Gross Steam Production	HP	Tons	57,934.37			
		LP	Tons	8,921.45			
3.2	Process Steam Production to IU@Power Plant Meter	Mass	Tons	0.00			
		Energy	MMBTU	0.00			
3.3	Equivalent Electrical Energy of Item 3.2	MWh	0.00				
PERFORMANCE INDEX FACTORS							
4.1	Weighted Equivalent Availability Factor	%	99.98%	100.00%	99.95%	99.98%	
4.2	Weighted Equivalent Planned Outage Factor	%	0.00%	0.00%	0.00%	0.00%	
4.3	Weighted Equivalent Maint. Outage Factor	%	0.00%	0.00%	0.00%	0.00%	
4.4	Weighted Equivalent Forced Outage Factor	%	0.02%	0.00%	0.05%	0.02%	
4.5	IUs Availability Factor (Electricity)	%	100.00%				
4.6	IUs Availability Factor (Steam)@Power Plant Meter	%					
4.7	EGAT Availability Factor	%	100.00%				
4.8	PM Plan Achievement	%	100.00%				
EFFICIENCY							
5.1	Gross Efficiency. (Including Item No. 3.3)	acc. LHV (dry)	%	52.02%	35.05%	35.06%	28.66%
		acc. HHV (sat)	%	46.92%			
5.2	Net Efficiency (Including Item No. 3.3)	acc. LHV (dry)	%	50.60%			
		acc. HHV (sat)	%	45.64%			
5.3	Net Cogen. Efficiency	acc. LHV (dry)	%	51.65%			
5.4	Gross Cogen. Efficiency	acc. LHV (dry)	%	52.02%			
5.5	Gross Heat Rate (Including Item No. 3.3)	acc. LHV (dry)	BTU/KWh	6,559.39	9,735.43	9,732.72	
		acc. HHV (sat)	BTU/KWh	7,272.28			
5.6	Net Heat Rate (Including Item No. 3.3)	acc. LHV (dry)	BTU/KWh	6,742.81			
		acc. HHV (sat)	BTU/KWh	7,475.64			
5.7	SPP Criteria as PPA	PES	%	12.96%			
		Thermal Ratio	%	0.00%			
		MCF	%				
Consumption							
6.1	PTT Invoice	Volumn(sat)	MMSCF	405.13011			
		Energy(LHVdry)	MMBTU	363,218.51	202,584.87	160,633.64	
		Energy(HHVsat)	MMBTU	437,396.10	224,602.29	212,793.81	
6.2	Water Supply	Raw Water	m3	71,207.00			
		Tap Water	m3	0.00			
ENVIRONMENT							
7.1	NOx Emission Gas (max) at 7% O2	ppm		40.10	39.15		
7.2	NOx Emission Gas (mean) at 7% O2	ppm		26.21	22.96		


6. เดือนมิถุนายน พ.ศ. 2560


ATP Performance Statistics							
June-2017						Rev.1	
Description	Unit	Plant	GT11	GT12	ST10		
GENERAL							
1.1	Gross Maximum Power Output	MW	115.03	39.14	39.16	36.73	
1.2	Net Maximum Power Output	MW	112.10				
1.3	Industrial User Steam Capacity (Peak)	T/Hr					
1.4	Net Plant Load Factor	%	62.07%				
1.5	Net Output Factor (Service Period Only)	%	74.24%				
OPERATING							
2.1	Gross Electrical Energy Generation	MWh	61,768.90	26,254.46	15,806.45	19,707.99	
2.2	Gross Elec. Energy + Equiv. Energy Generation	MWh	61,768.90	26,254.46	15,806.45	19,707.99	
2.3	Net Elec Energy Generation	MWh	59,850.70				
2.4	Aux. Power Consumption Station Service	MWh	2,002.80				
2.5	Energy Sale to EGAT	MWh	55,969.98				
2.6	Net Elec. Energy Sale to IUs@ Power Plant Meter	MWh	6,680.61				
2.7	Total Imported Energy from PEA	MWh	0.00				
2.8	Export to (Import from) Interco	MWh	-2,819.34				
2.9	Max. Imported Power form PEA (PEA Peak)	MW	0.00				
2.10	PEA Back up Power Contract	MW	17.37				
2.11	Equivalent Operating Hours	hours		712.00	583.00	743.00	
2.12	Equivalent Operating Hours acc.	hours		8,873.00	8,528.00	8,845.00	
2.13	Equivalent Operating Cycle, EOC acc.			276.00	329.00		
2.14	Start up Time Number @ Machine Panel	times		5.00	26.00	0.00	
STEAM							
3.1	Gross Steam Production	HP	Tons	63,945.99			
		LP	Tons	10,074.51			
3.2	Process Steam Production to IU@Power Plant Meter	Mass	Tons	0.00			
		Energy	MMBTU	0.00			
3.3	Equivalent Electrical Energy of Item 3.2	MWh	0.00				
PERFORMANCE INDEX FACTORS							
4.1	Weighted Equivalent Availability Factor	%	100.00%	100.00%	100.00%	100.00%	
4.2	Weighted Equivalent Planned Outage Factor	%	0.00%	0.00%	0.00%	0.00%	
4.3	Weighted Equivalent Maint. Outage Factor	%	0.00%	0.00%	0.00%	0.00%	
4.4	Weighted Equivalent Forced Outage Factor	%	0.00%	0.00%	0.00%	0.00%	
4.5	IUs Availability Factor (Electricity)	%	100.00%				
4.6	IUs Availability Factor (Steam)@Power Plant Meter	%					
4.7	EGAT Availability Factor	%	100.00%				
4.8	PM Plan Achievement	%	98.90%				
EFFICIENCY							
5.1	Gross Efficiency. (Including Item No. 3.3)	acc. LHV (dry)	%	52.05%	35.62%	35.16%	28.18%
		acc. HHV (sat)	%	46.92%			
5.2	Net Efficiency (Including Item No. 3.3)	acc. LHV (dry)	%	50.44%			
		acc. HHV (sat)	%	45.47%			
5.3	Net Cogen. Efficiency	acc. LHV (dry)	%	51.71%			
5.4	Gross Cogen. Efficiency	acc. LHV (dry)	%	52.05%			
5.5	Gross Heat Rate (Including Item No. 3.3)	acc. LHV (dry)	BTU/KWh	6,555.11	9,578.80	9,705.91	
		acc. HHV (sat)	BTU/KWh	7,271.69			
5.6	Net Heat Rate (Including Item No. 3.3)	acc. LHV (dry)	BTU/KWh	6,765.20			
		acc. HHV (sat)	BTU/KWh	7,504.74			
5.7	SPP Criteria as PPA	PES	%	13.01%			
		Thermal Ratio	%	0.00%			
		MCF	%				
Consumption							
6.1	PTT Invoice	Volumn(sat)	MMSCF	454.99854			
		Energy(LHVdry)	MMBTU	404,902.10	251,486.12	153,415.99	
		Energy(HHVsat)	MMBTU	441,099.60	270,912.94	170,186.66	
6.2	Water Supply	Raw Water	m3	89,556.00			
		Tap Water	m3	0.00			
ENVIRONMENT							
7.1	NOx Emission Gas (max) at 7% O2	ppm		48.49	49.59		
7.2	NOx Emission Gas (mean) at 7% O2	ppm		34.85	24.40		

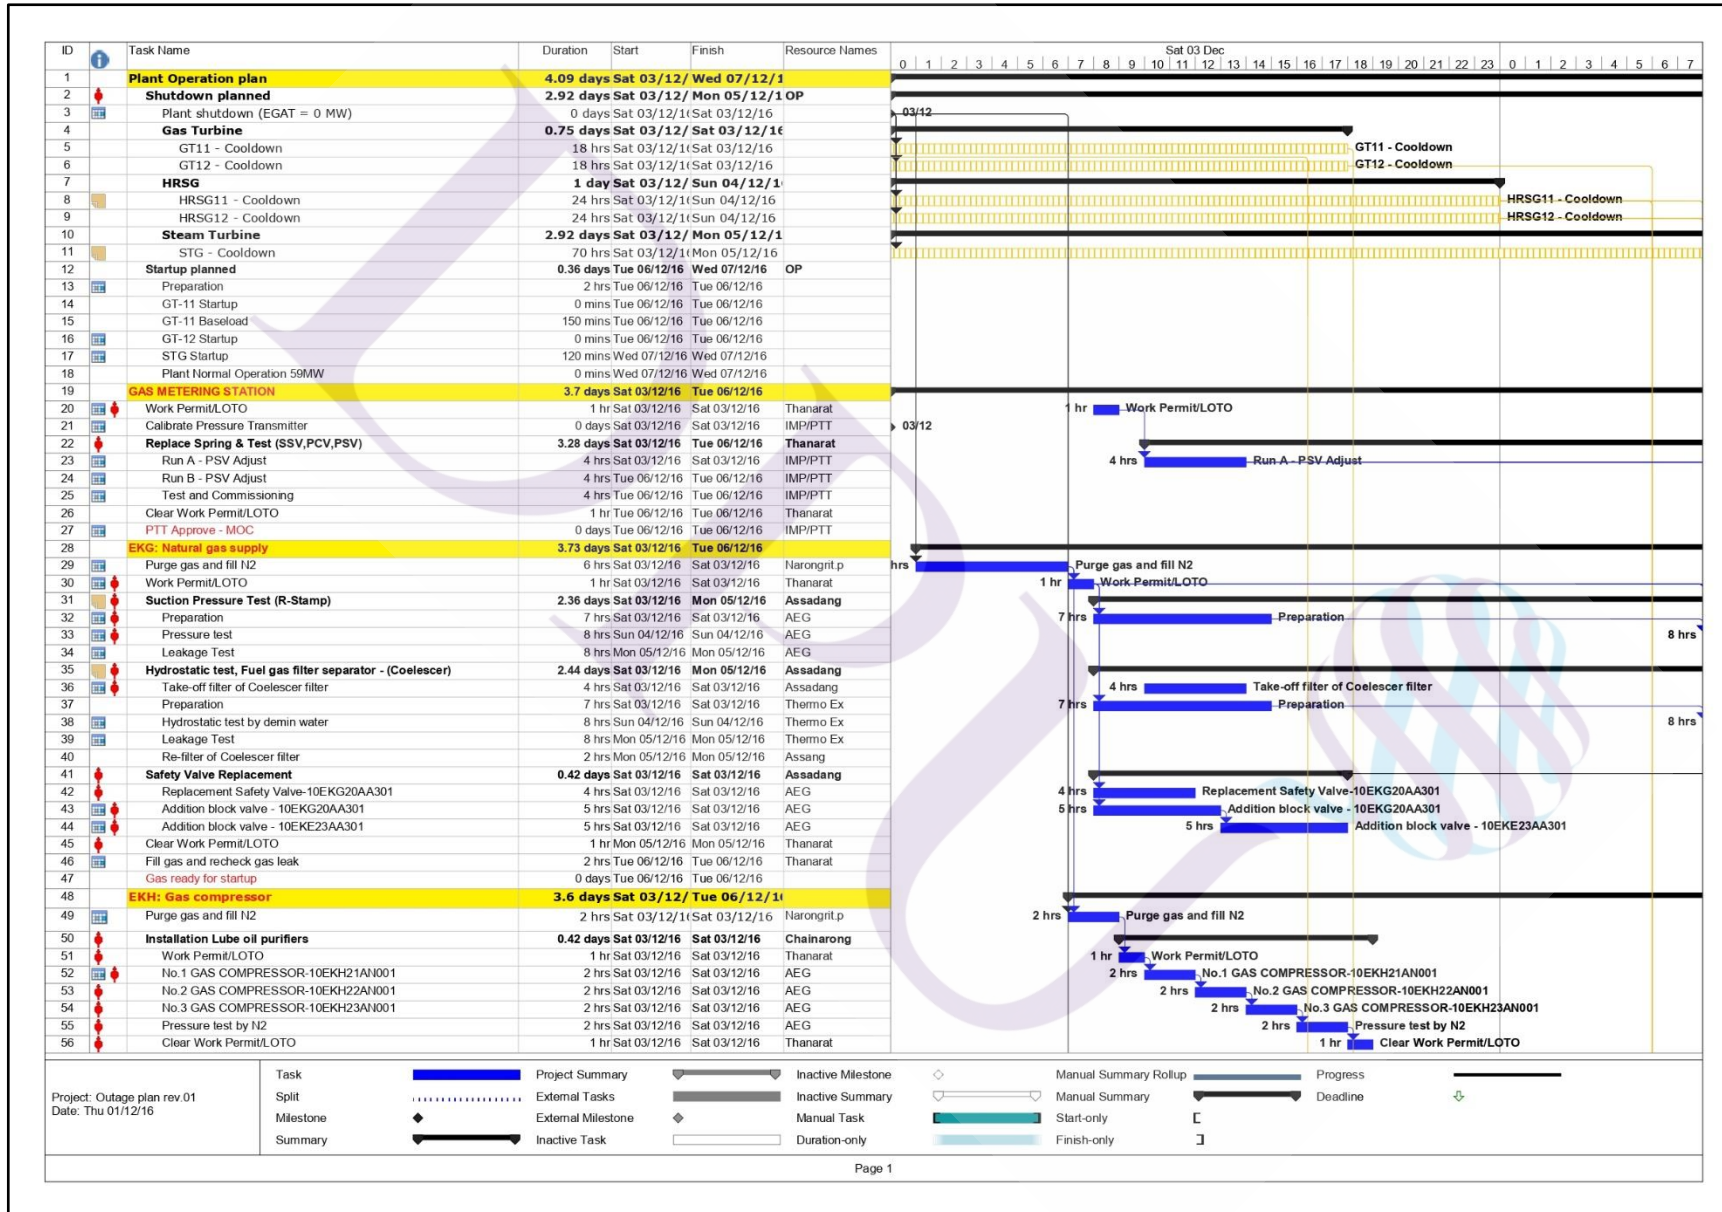


Project: Outage plan rev 01
Date: Thu 01/12/16

Task		Project Summary		Inactive Milestone		Manual Summary Rollup		Progress
Split		External Tasks		Inactive Summary		Manual Summary		Deadline
Milestone		External Milestone		Manual Task		Start-only		
Summary		Inactive Task		Duration-only		Finish-only		

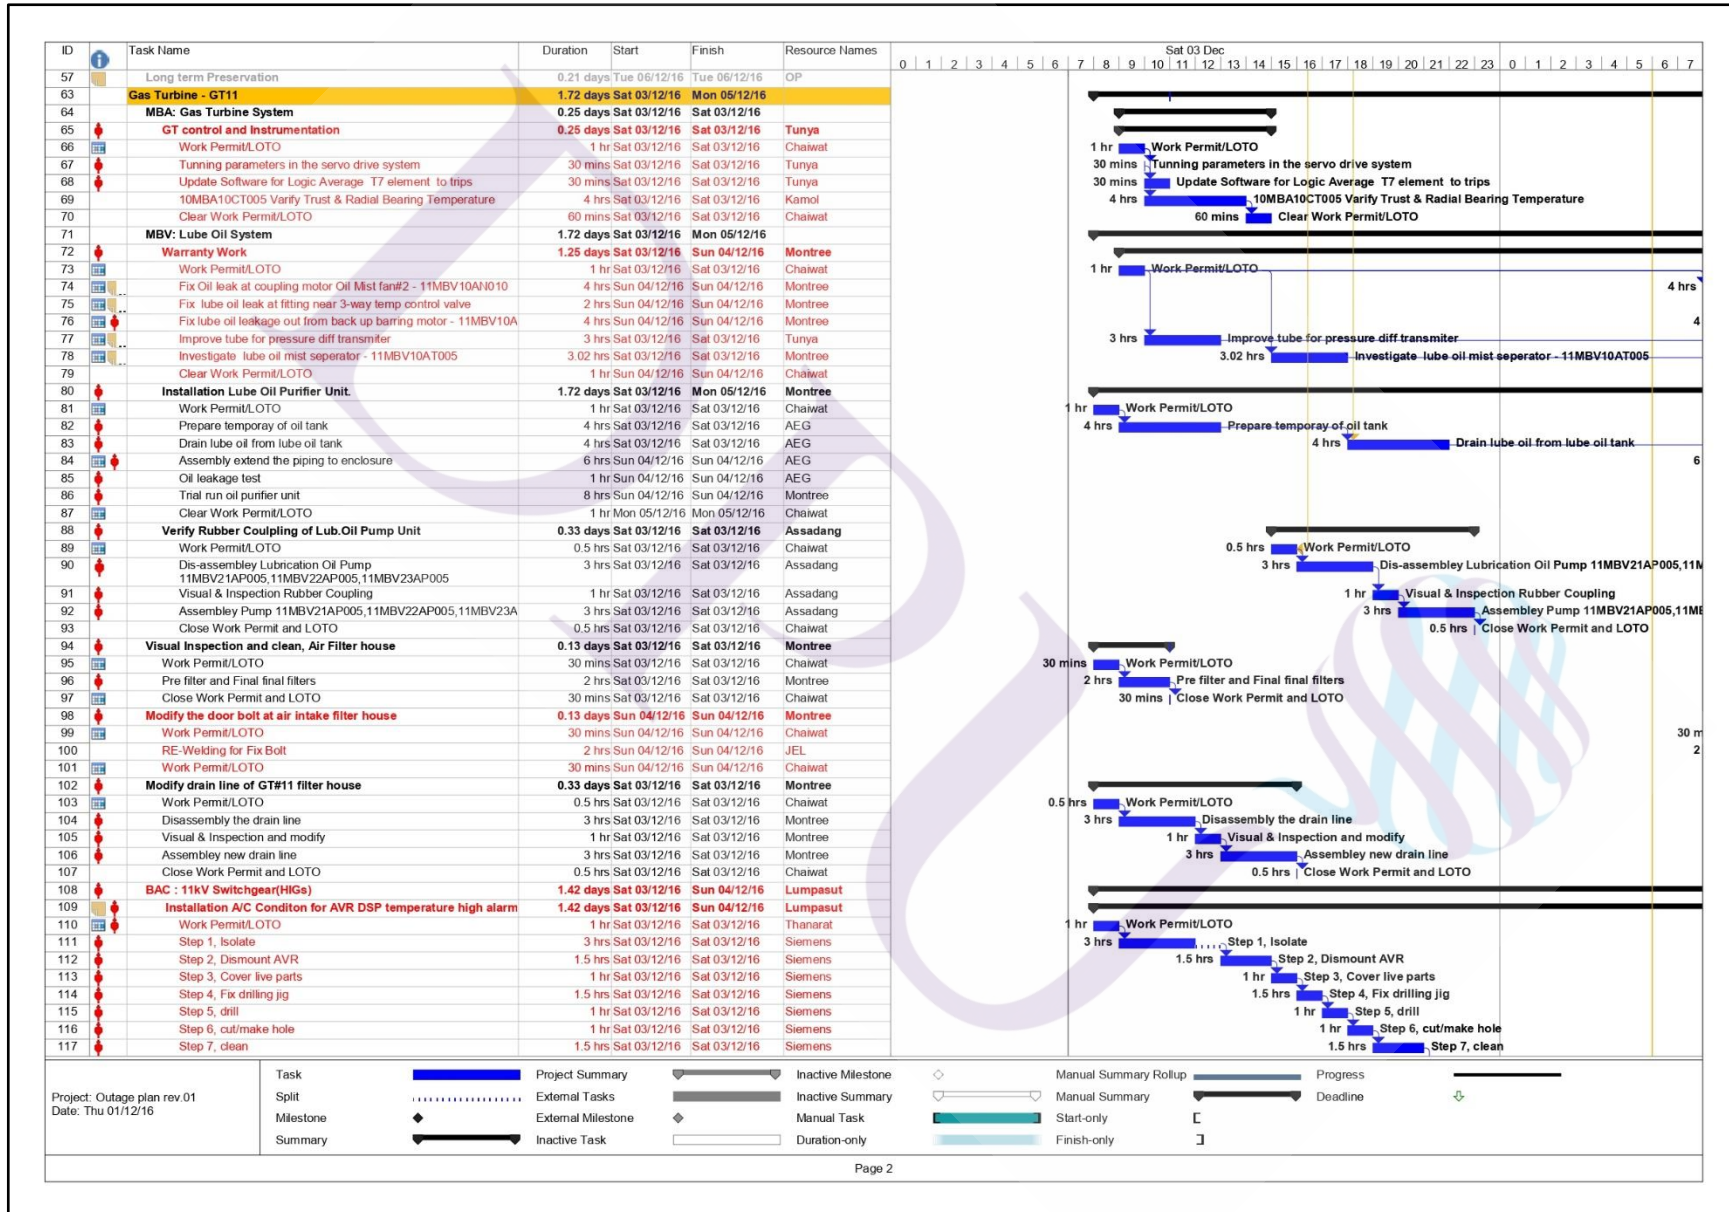

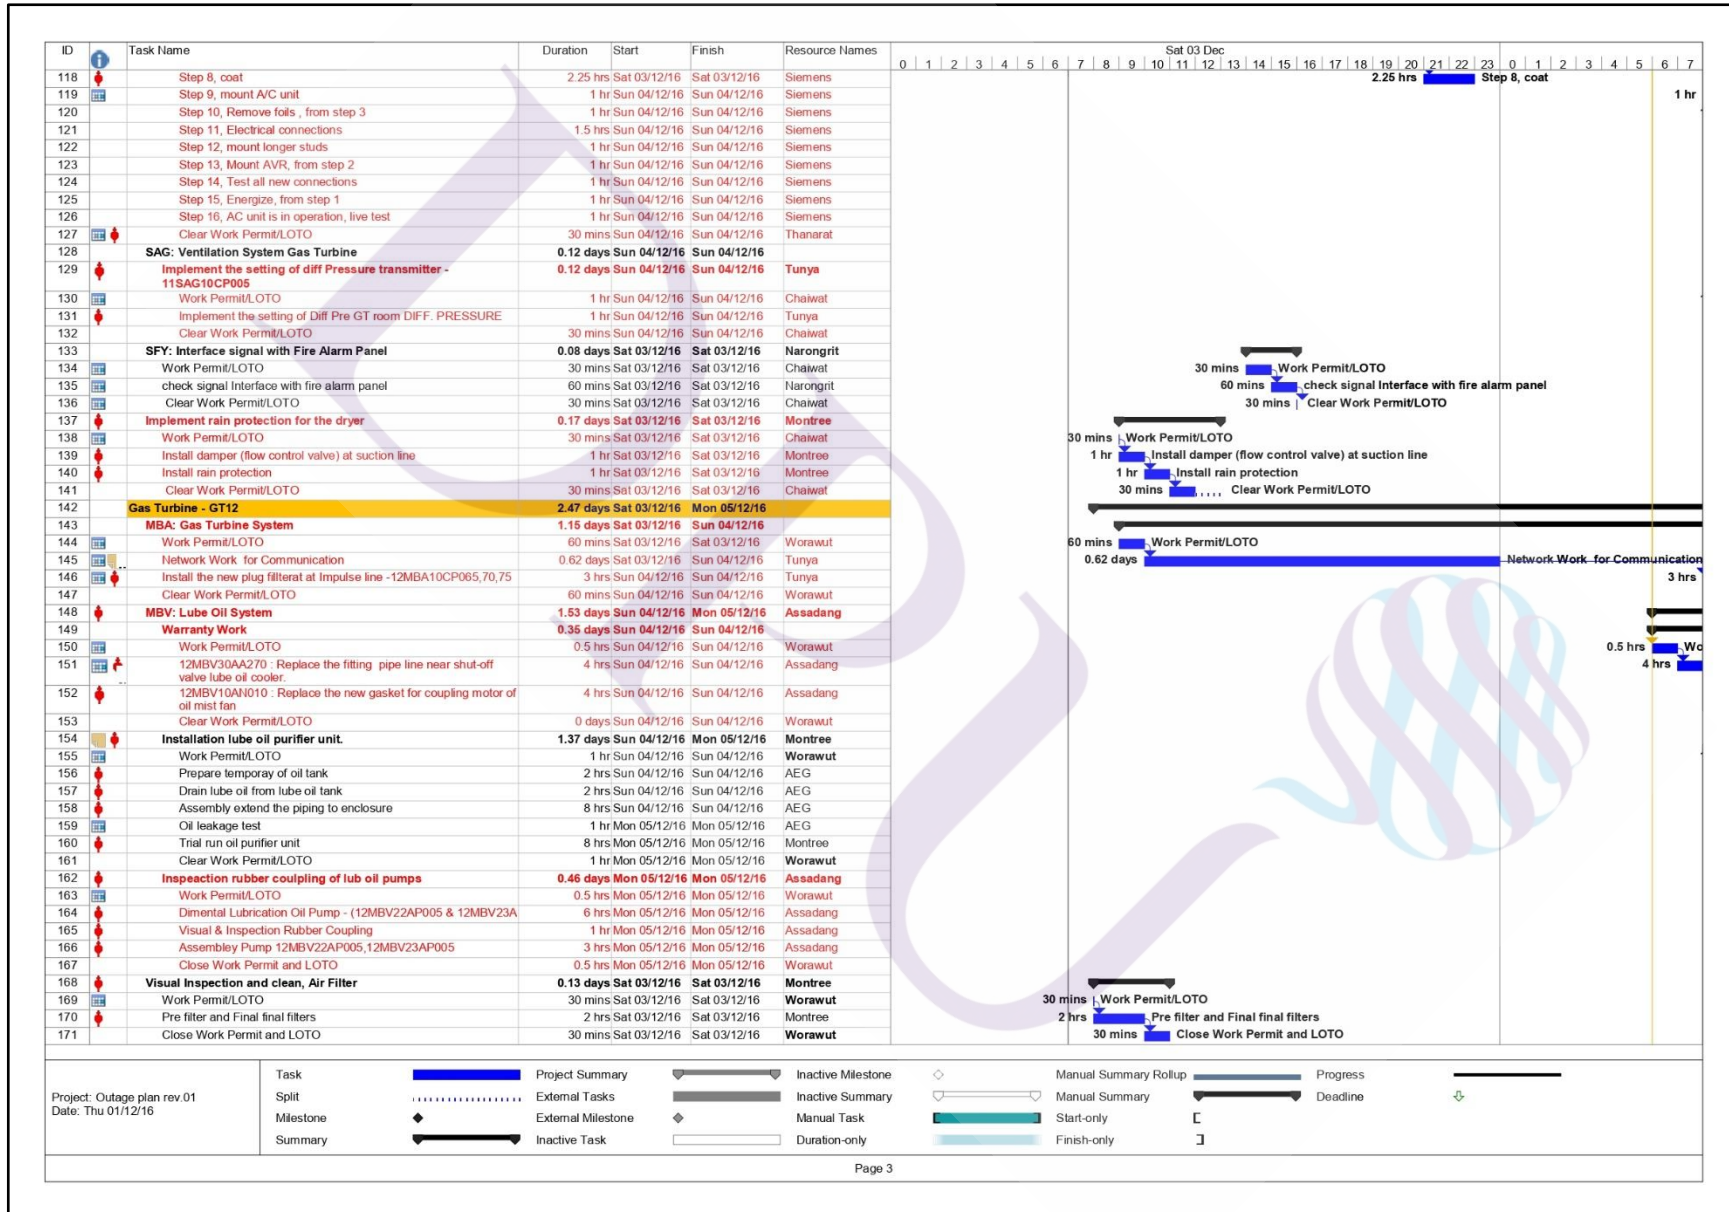


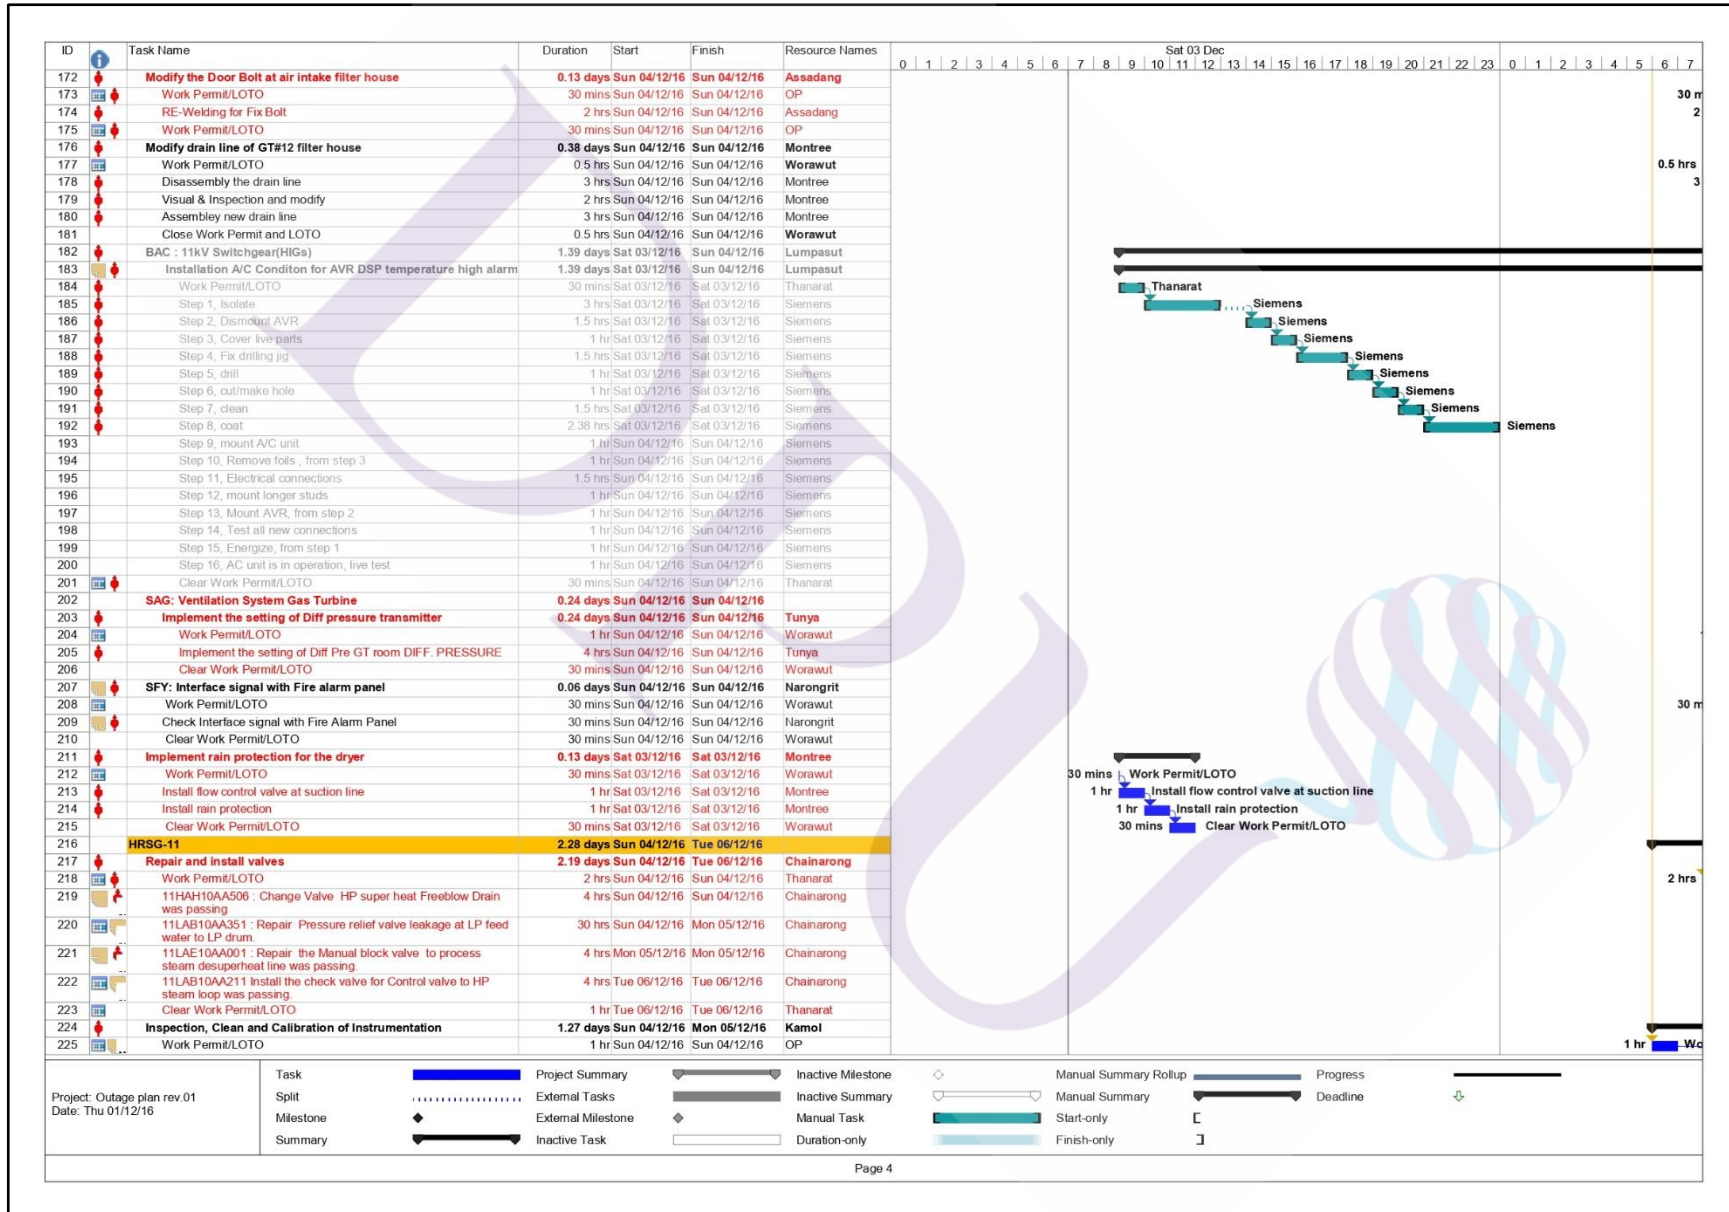



ID	Task Name	Duration	Start	Finish	Resource Names	Set 03 Dec																																	
						0	1	2	3	4	5	6	7	8	9	10	11	12	13	14	15	16	17	18	19	20	21	22	23	0	1	2	3	4	5	6	7		
277	12HAD10CP001A Drum Pressure Transmitter	30 mins	Sun 04/12/16	Sun 04/12/16	ESCO																																		
278	12HAD10CP001B Drum Pressure Transmitter	30 mins	Sun 04/12/16	Sun 04/12/16	ESCO																																		
279	12HAD10CP001C Drum Pressure Transmitter	30 mins	Sun 04/12/16	Sun 04/12/16	ESCO																																		
280	12HAD50CL001A Drum Level Transmitter	30 mins	Sun 04/12/16	Sun 04/12/16	ESCO																																		
281	12HAD50CL001C Drum Level Transmitter	30 mins	Sun 04/12/16	Sun 04/12/16	ESCO																																		
282	12HAD50CP001A Drum Pressure Transmitter	30 mins	Sun 04/12/16	Sun 04/12/16	ESCO																																		
283	12HAD50CP001B Drum Pressure Transmitter	30 mins	Sun 04/12/16	Sun 04/12/16	ESCO																																		
284	12HAD50CP001C Drum Pressure Transmitter	30 mins	Sun 04/12/16	Sun 04/12/16	ESCO																																		
285	12HAD90CL001 Flash Tank Level Transmitter	30 mins	Sun 04/12/16	Sun 04/12/16	ESCO																																		
286	12HAH10CF002 Steam Outlet Flow Transmitter	30 mins	Sun 04/12/16	Sun 04/12/16	ESCO																																		
287	12HAH10CP001 Attemporator Outlet Pressure Transmitter	30 mins	Sun 04/12/16	Sun 04/12/16	ESCO																																		
288	12HAH10CP002 Steam Outlet Pressure Transmitter	30 mins	Sun 04/12/16	Sun 04/12/16	ESCO																																		
289	12HAH10CP003 Steam Outlet Pressure Transmitter	30 mins	Sun 04/12/16	Sun 04/12/16	ESCO																																		
290	12HAH50CF002 Steam Outlet Flow Transmitter	30 mins	Sun 04/12/16	Sun 04/12/16	ESCO																																		
291	12HAH50CP001 Steam Outlet Pressure Transmitter	30 mins	Sun 04/12/16	Sun 04/12/16	ESCO																																		
292	12HIA05CP001 Flue Gas Temp. Into Inlet Duct Pressure Transmitter	30 mins	Sun 04/12/16	Sun 04/12/16	ESCO																																		
293	12HIA05CP002 Flue Gas Temp. HRSG Outlet Pressure Transmitter	30 mins	Sun 04/12/16	Sun 04/12/16	ESCO																																		
294	Clear Work Permit/LOTO	30 mins	Sun 04/12/16	Sun 04/12/16	Worawut																																		
295	Steam Turbine	3.34 days	Sat 03/12/16	Tue 06/12/16																																			
296	MKA: Generator System	0.21 days	Tue 06/12/16	Tue 06/12/16	Lumpasut																																		
297	Investigate the STG Display have alarm Rotor EF test failure.	0.21 days	Tue 06/12/16	Tue 06/12/16	Lumpasut																																		
298	Work Permit/LOTO	30 mins	Tue 06/12/16	Tue 06/12/16	Narongrit.p																																		
299	Check control circuit & earth brush at slip ring box	4 hrs	Tue 06/12/16	Tue 06/12/16	Lumpasut																																		
300	Close Work Permit and LOTO	30 mins	Tue 06/12/16	Tue 06/12/16	Narongrit.p																																		
301	10MKA10 Steam Turbine Generator	0.29 days	Tue 06/12/16	Tue 06/12/16	Narongrit																																		
302	Work Permit/LOTO	30 mins	Tue 06/12/16	Tue 06/12/16	Narongrit.p																																		
303	Stator- Measure insulation resistances of stator winding	30 mins	Tue 06/12/16	Tue 06/12/16	ESCO																																		
304	Stator- Measure insulation resistances of temperature sensor	30 mins	Tue 06/12/16	Tue 06/12/16	ESCO																																		
305	Stator- Measure winding resistances	30 mins	Tue 06/12/16	Tue 06/12/16	ESCO																																		
306	Stator- Measure resistances of temperature sensors	30 mins	Tue 06/12/16	Tue 06/12/16	ESCO																																		
307	Rotor- Measure insulation resistance	60 mins	Tue 06/12/16	Tue 06/12/16	ESCO																																		
308	Exciter- Visual inspection rotating diode & Clean	60 mins	Tue 06/12/16	Tue 06/12/16	ESCO																																		
309	Slip ring- Visual Check slip ring surface condition	30 mins	Tue 06/12/16	Tue 06/12/16	ESCO																																		
310	Slip ring- Cleaning around slip ring	30 mins	Tue 06/12/16	Tue 06/12/16	ESCO																																		
311	Close Work Permit and LOTO	30 mins	Tue 06/12/16	Tue 06/12/16	Narongrit.p																																		
312	10CGA10 Excitation cubicle & AVR	0.1 days	Sun 04/12/16	Sun 04/12/16	TunWA																																		
313	Work Permit/LOTO	30 mins	Sun 04/12/16	Sun 04/12/16	Narongrit.p																																		
314	Visual Inspection inside cubicle	30 mins	Sun 04/12/16	Sun 04/12/16	ESCO																																		
315	Cleaning inside cubicle	47 mins	Sun 04/12/16	Sun 04/12/16	ESCO																																		
316	Close Work Permit and LOTO	30 mins	Sun 04/12/16	Sun 04/12/16	Narongrit.p																																		
317	10CBP10 STG PROTECTION PANEL FOR GEN	0.96 days	Sun 04/12/16	Mon 05/12/16	Lumpasut																																		
318	Work Permit/LOTO	30 mins	Sun 04/12/16	Sun 04/12/16	Narongrit.p																																		
319	-Check of the surface painting and overall visual aspect of the cubicle	15 mins	Sun 04/12/16	Sun 04/12/16	ESCO																																		
320	-Check of the devices concerning their possible mechanical damages	15 mins	Sun 04/12/16	Sun 04/12/16	ESCO																																		
321	-Check of completeness of the cubicle marking, mainly check of manufacturing plate, labelling of devices, terminal boards and internal wiring	15 mins	Sun 04/12/16	Sun 04/12/16	ESCO																																		
322	-Check of the mechanical connections of the cubicle construction	15 mins	Sun 04/12/16	Sun 04/12/16	ESCO																																		
323	-visual check of wiring	36 mins	Sun 04/12/16	Sun 04/12/16	ESCO																																		
324	-Check of the outgoing connections of main, auxiliary and control circuits (fastening of wires in clamps, tightening of screw terminals at the devices etc.)	35 mins	Sun 04/12/16	Sun 04/12/16	ESCO																																		
325	-Check of the cubicle interior, cleaning with a vacuum cleaner if necessary	30 mins	Sun 04/12/16	Sun 04/12/16	ESCO																																		


Project: Outage plan rev 01 Date: Thu 01/12/16	Task		Project Summary		Inactive Milestone		Manual Summary Rollup		Progress	
	Split		External Tasks		Inactive Summary		Manual Summary		Deadline	
	Milestone		External Milestone		Manual Task		Start-only			
	Summary		Inactive Task		Duration-only		Finish-only			

Page 6

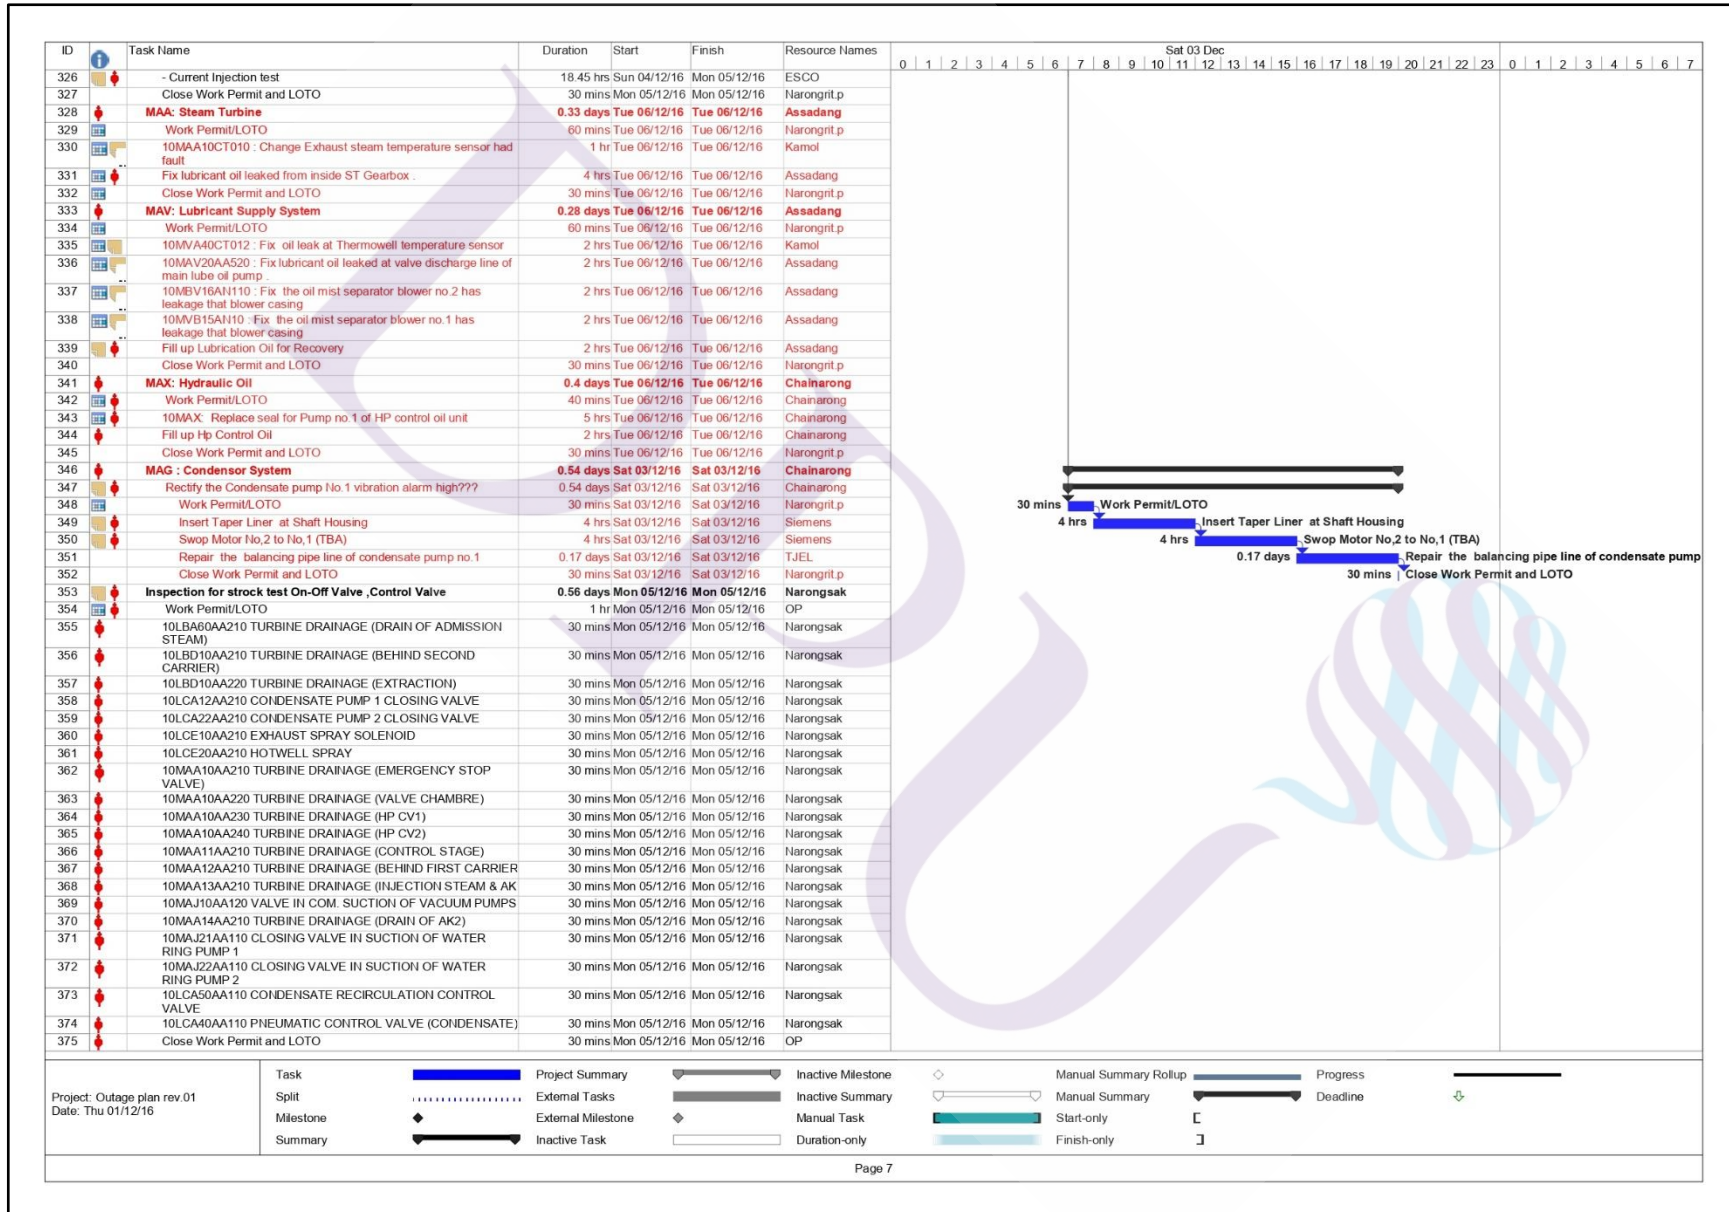

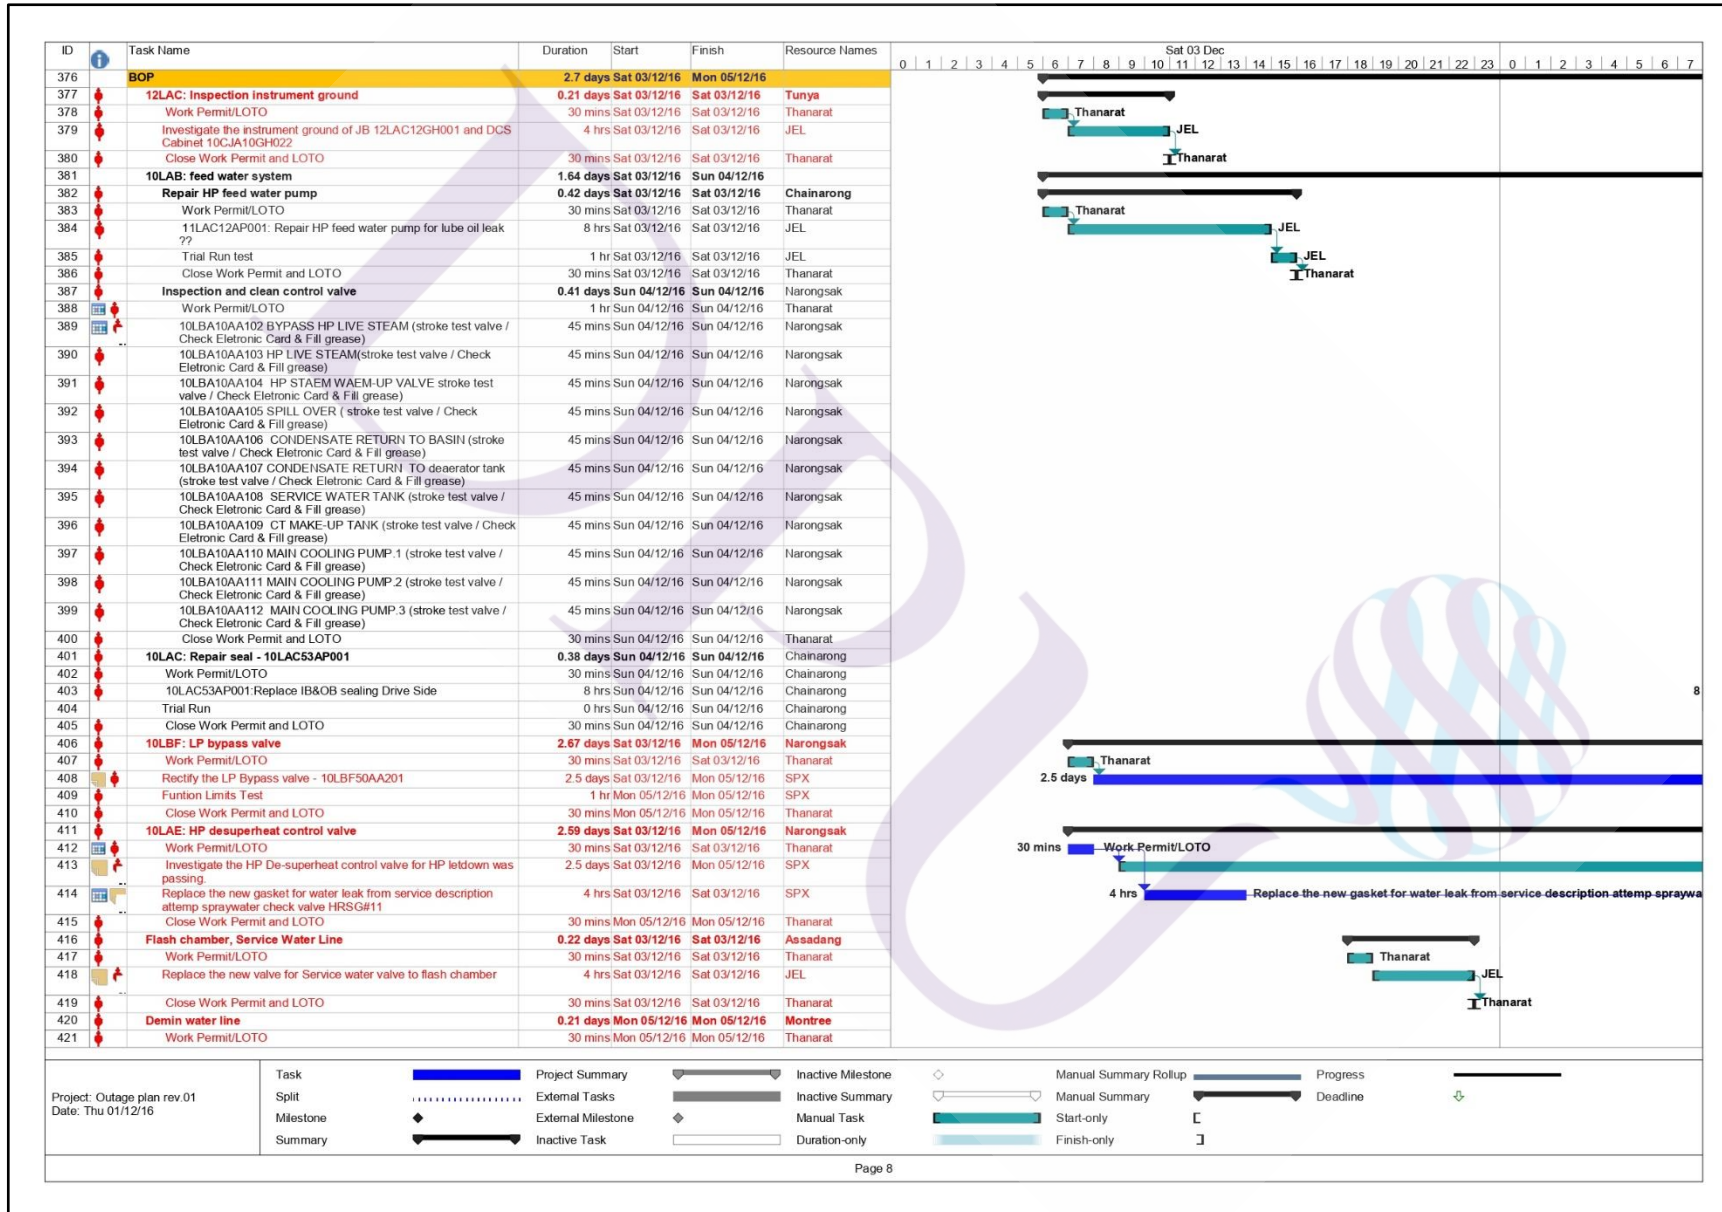

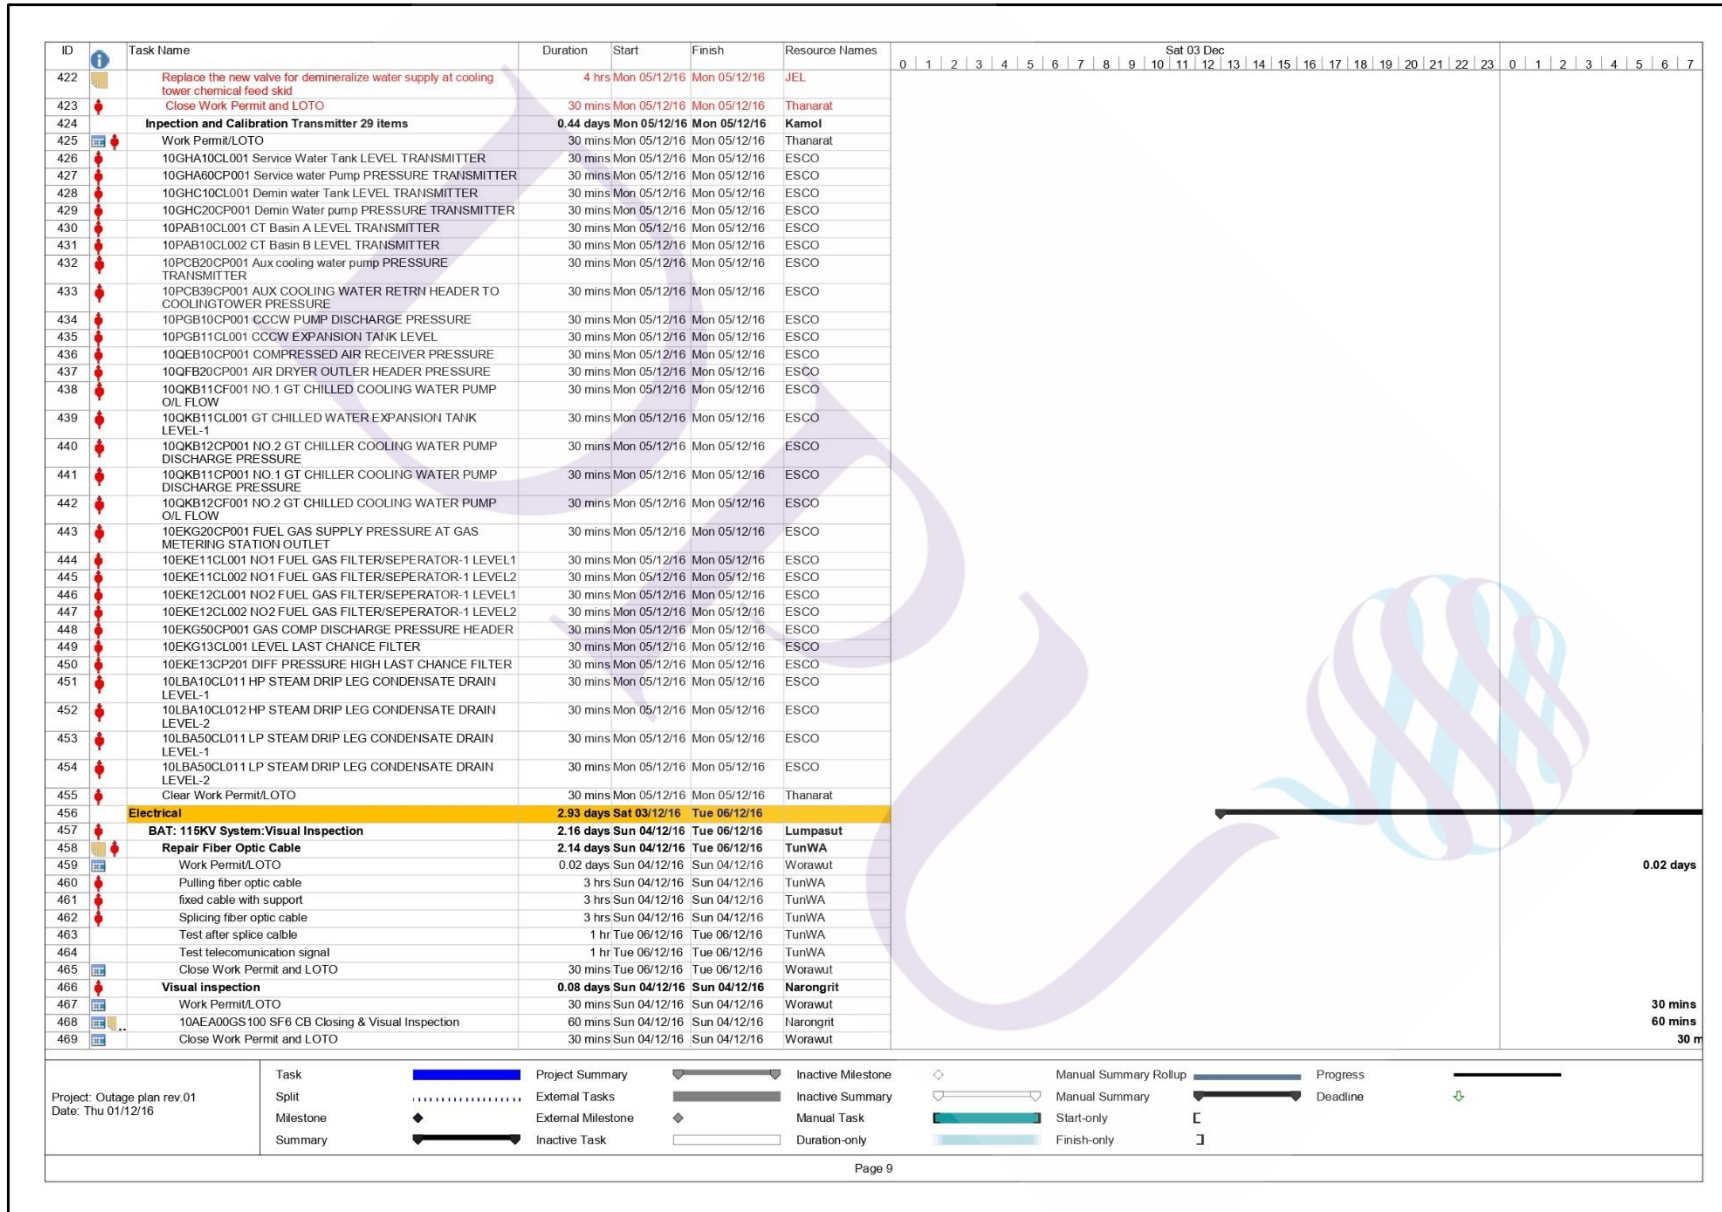

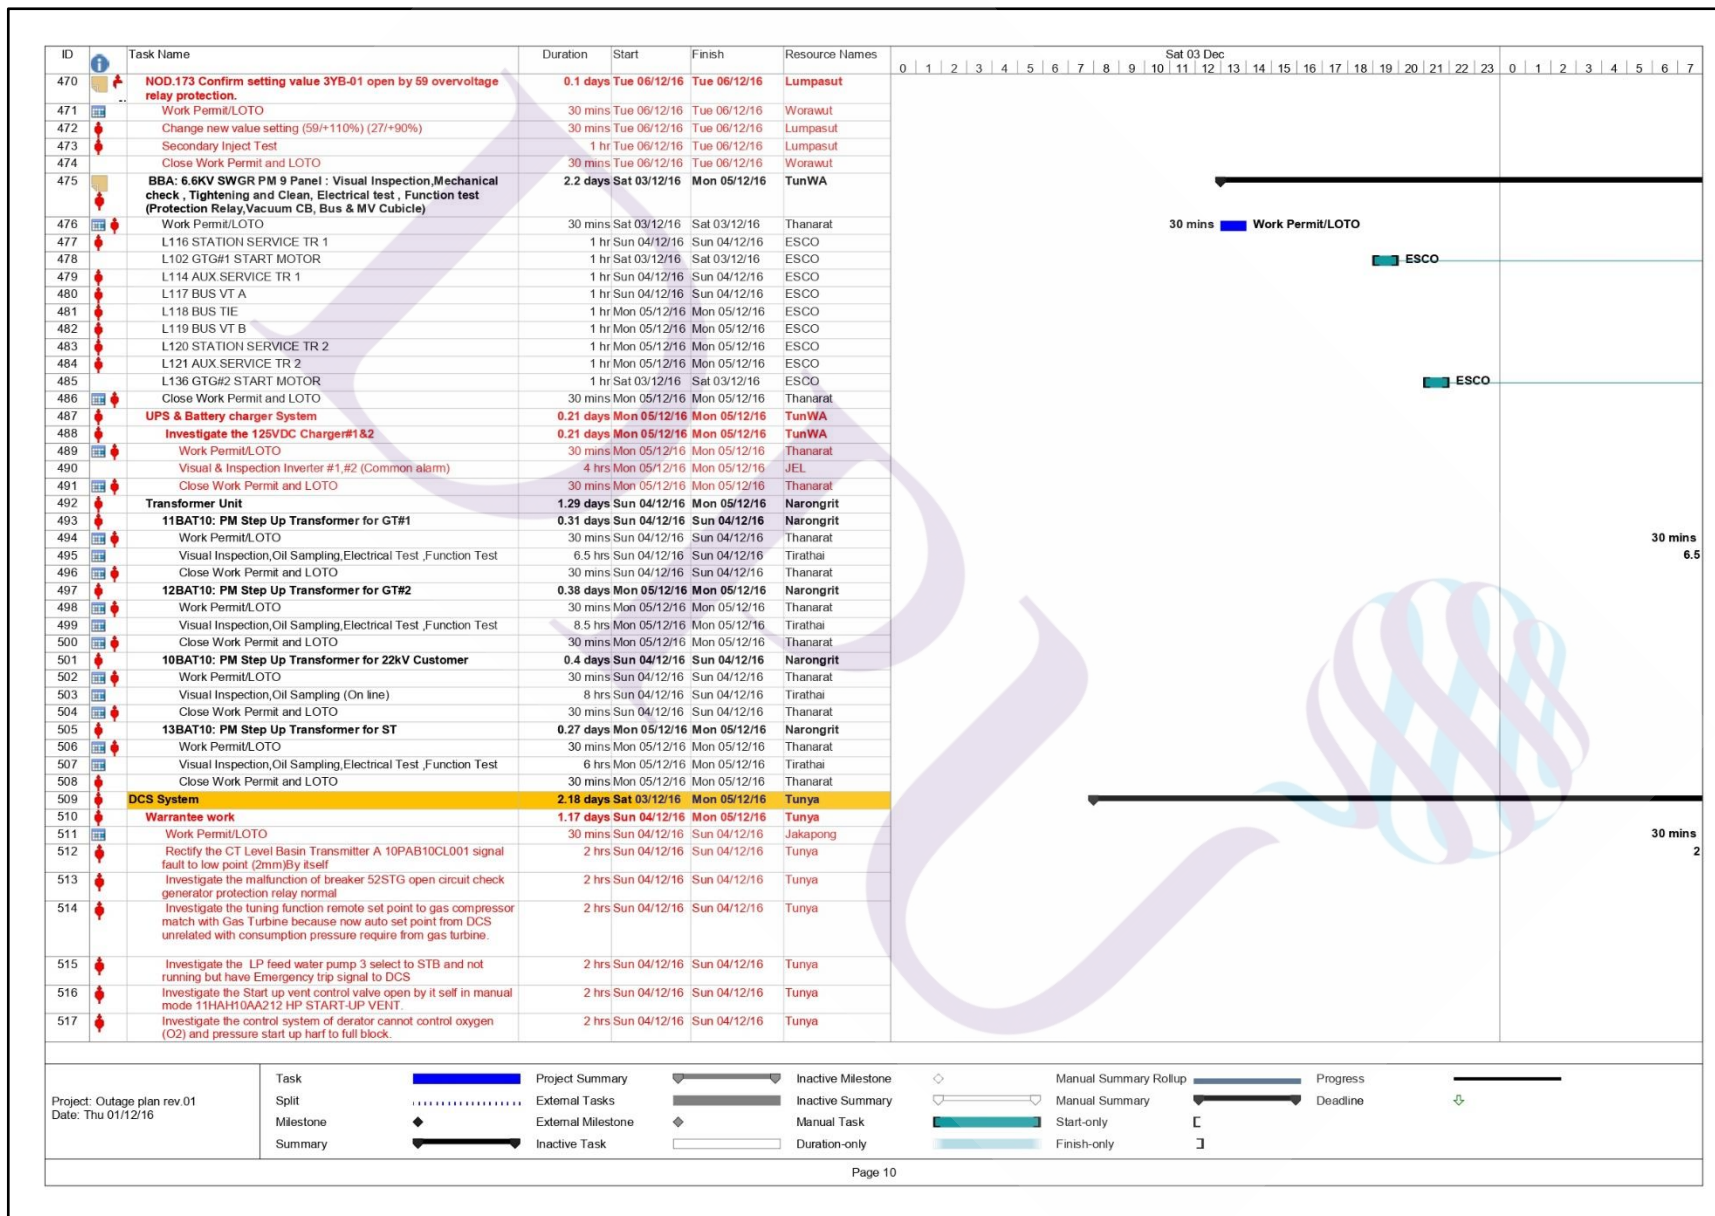



ID	Task Name	Duration	Start	Finish	Resource Names	Sat 03 Dec																											
518	Investigate the LP feed water select before start plant half to full block set by - Pump 1 PRI / Pump 2 PRI / Pump 3 STD	0.5 hrs	Sun 04/12/16	Sun 04/12/16	Tunya	[Gantt bar for 518]																											
519	Check and modify function block scan time, Chang type block in logic BOP	2 hrs	Sun 04/12/16	Sun 04/12/16	Tunya	[Gantt bar for 519]																											
520	Check time syon GPS Main System and Update Firmware DCS system (Requested By Schanider.)	4 hrs	Mon 05/12/16	Mon 05/12/16	Tunya	[Gantt bar for 520]																											
521	Close Work Permit and LOTO	30 mins	Mon 05/12/16	Mon 05/12/16	Jakapong	[Gantt bar for 521]																											
522	DCS Program Improvement	1.19 days	Sat 03/12/16	Sun 04/12/16	Tunya	[Gantt bar for 522]																											
523	Work Permit/LOTO	30 mins	Sat 03/12/16	Sat 03/12/16	Thanarat	[Gantt bar for 523]																											
524	Implement Software	8 hrs	Sat 03/12/16	Sat 03/12/16	JEL	[Gantt bar for 524]																											
525	Dry Testing	4 hrs	Sun 04/12/16	Sun 04/12/16	JEL	[Gantt bar for 525]																											
526	Work Permit/LOTO	30 mins	Sun 04/12/16	Sun 04/12/16	Thanarat	[Gantt bar for 526]																											


Project: Outage plan rev.01
Date: Thu 01/12/16


Task		Project Summary		Inactive Milestone		Manual Summary Rollup		Progress	
Split		External Tasks		Inactive Summary		Manual Summary		Deadline	
Milestone		External Milestone		Manual Task		Start-only			
Summary		Inactive Task		Duration-only		Finish-only			


Page 11

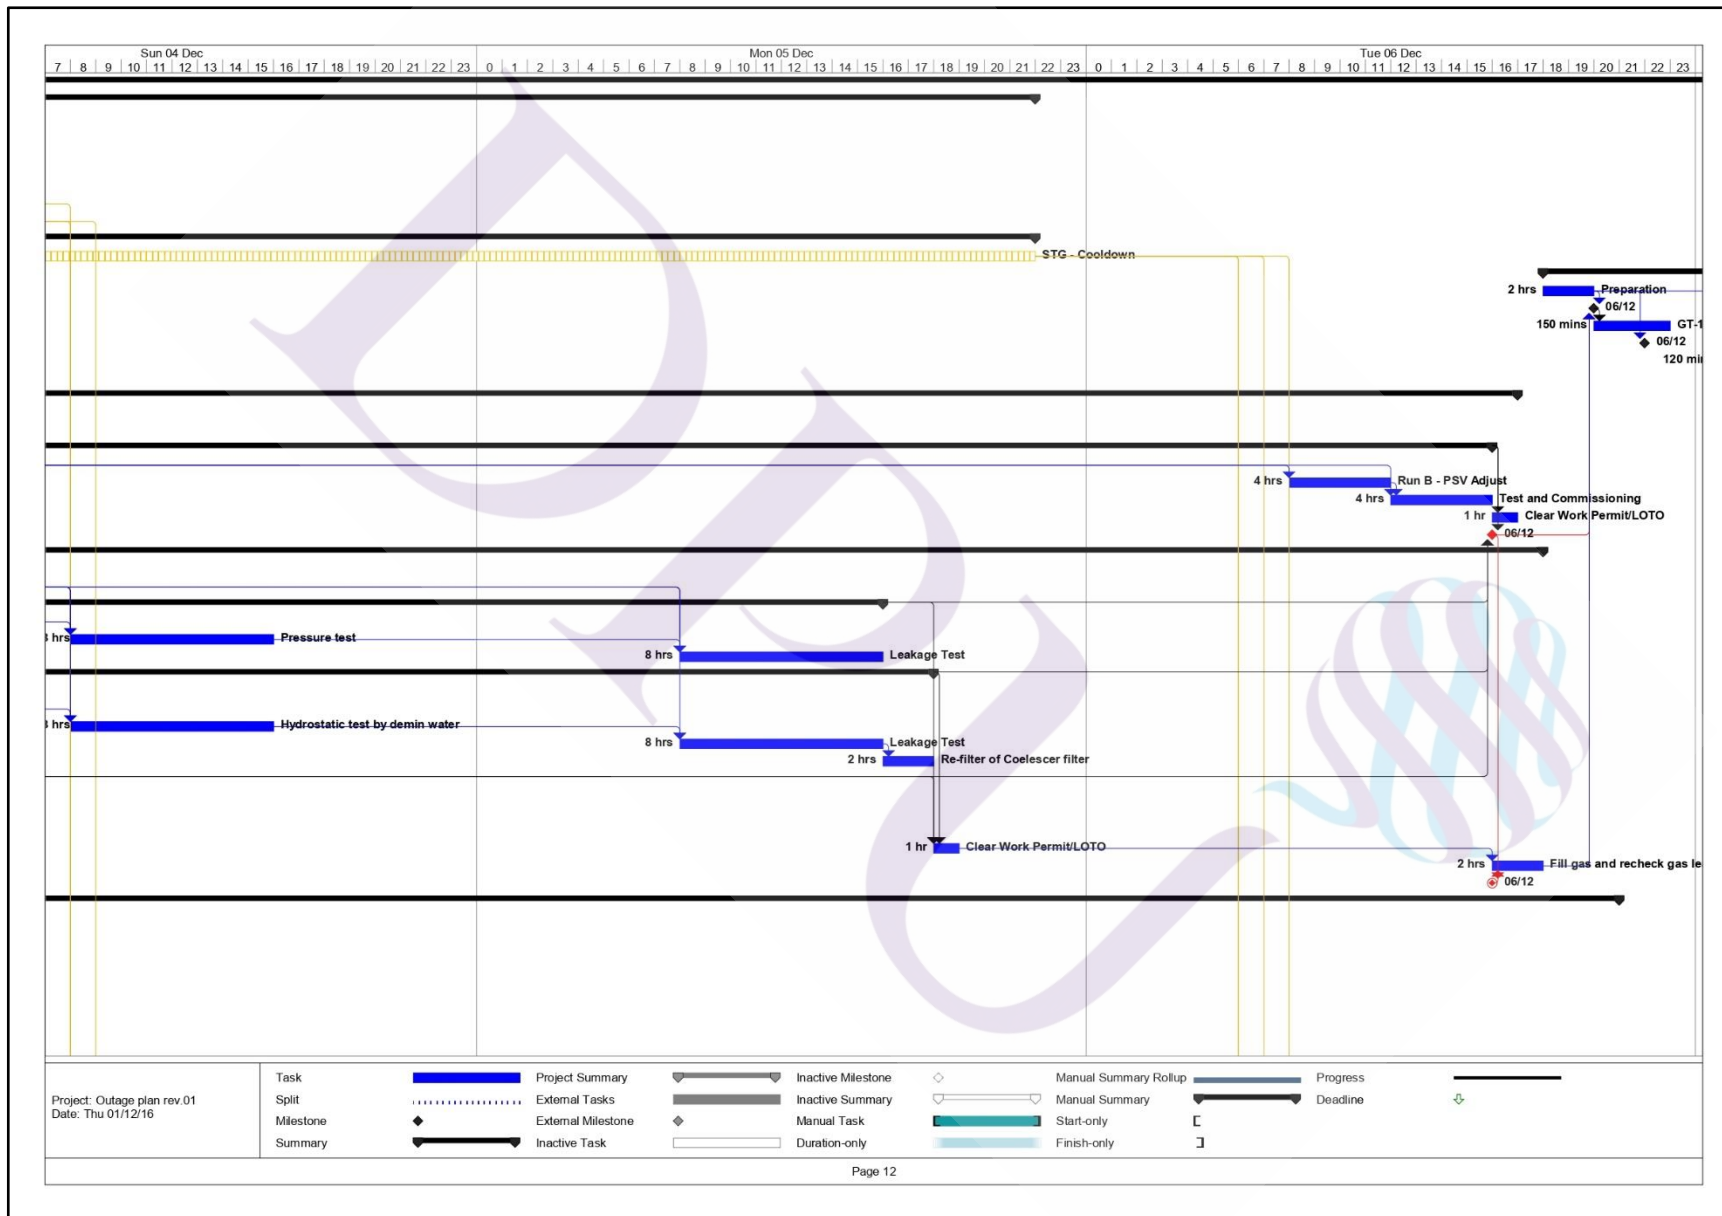


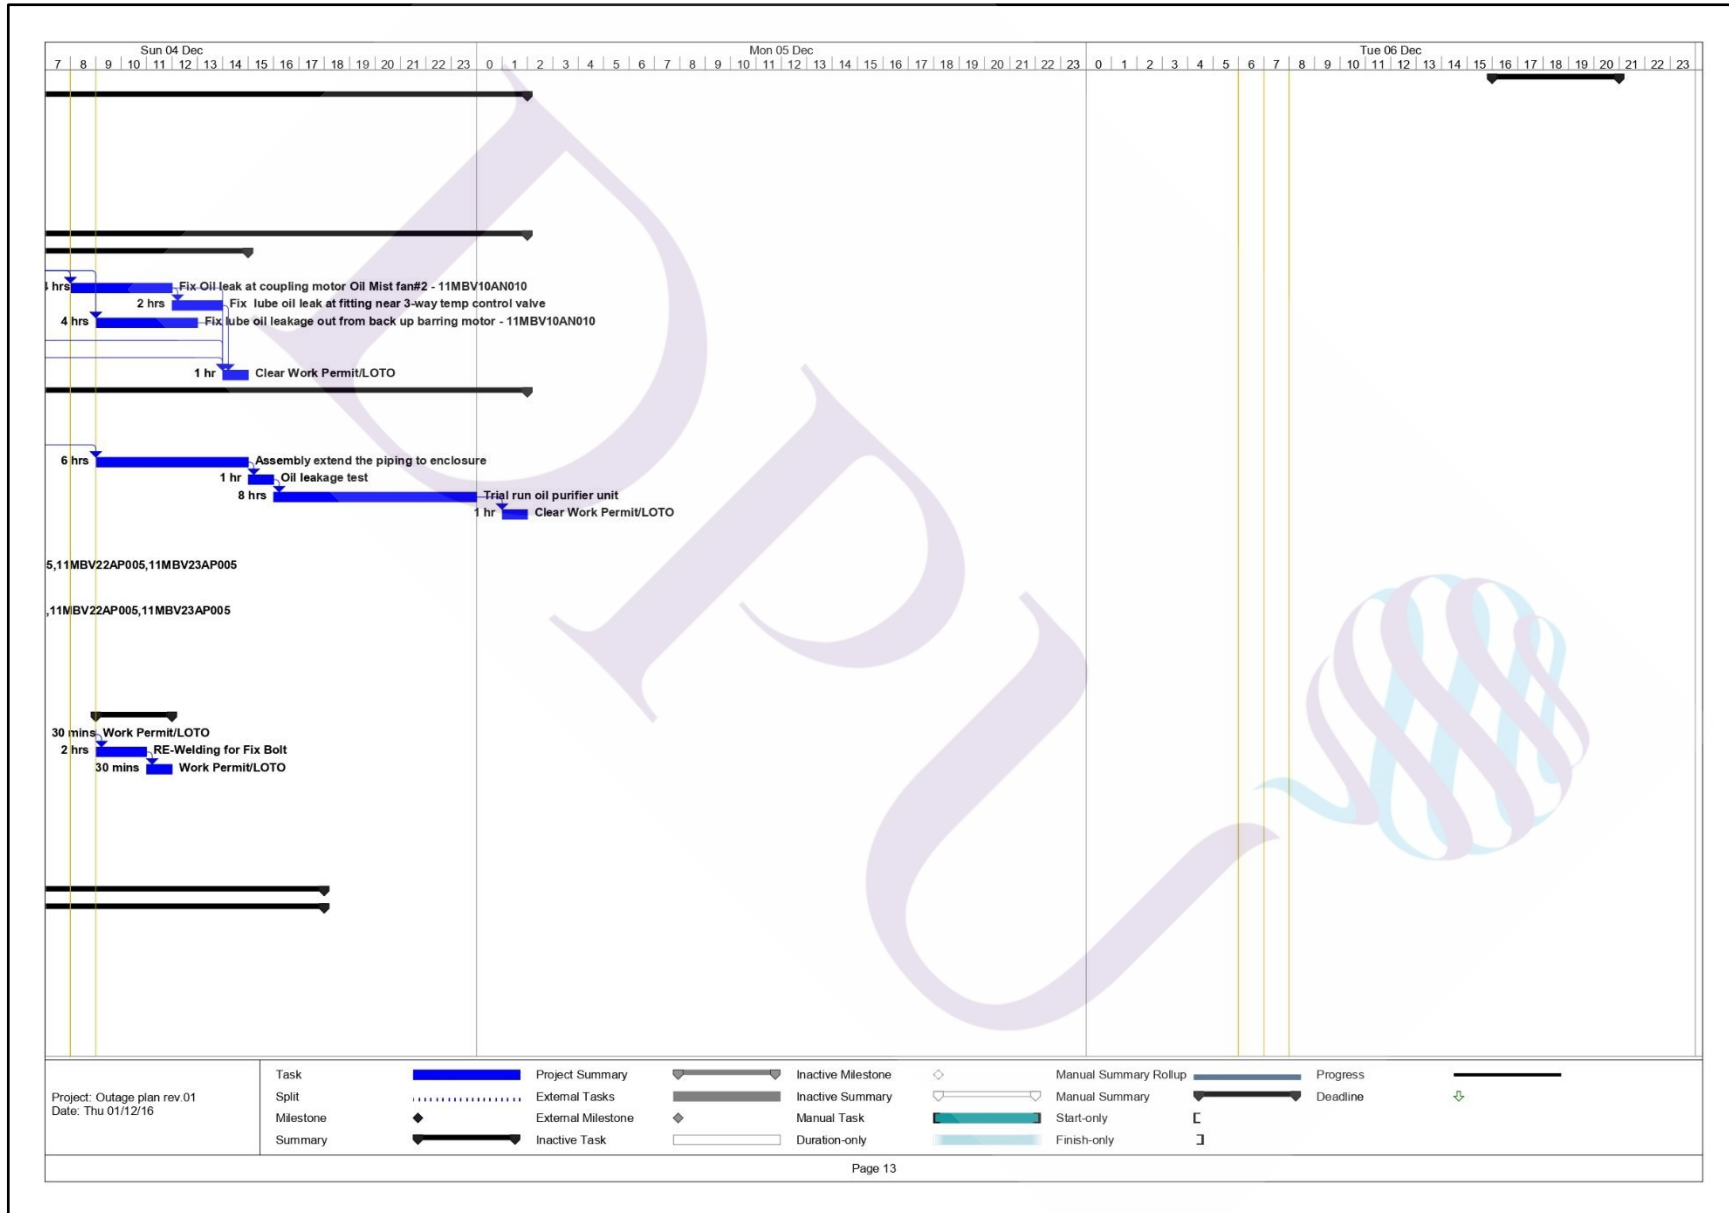


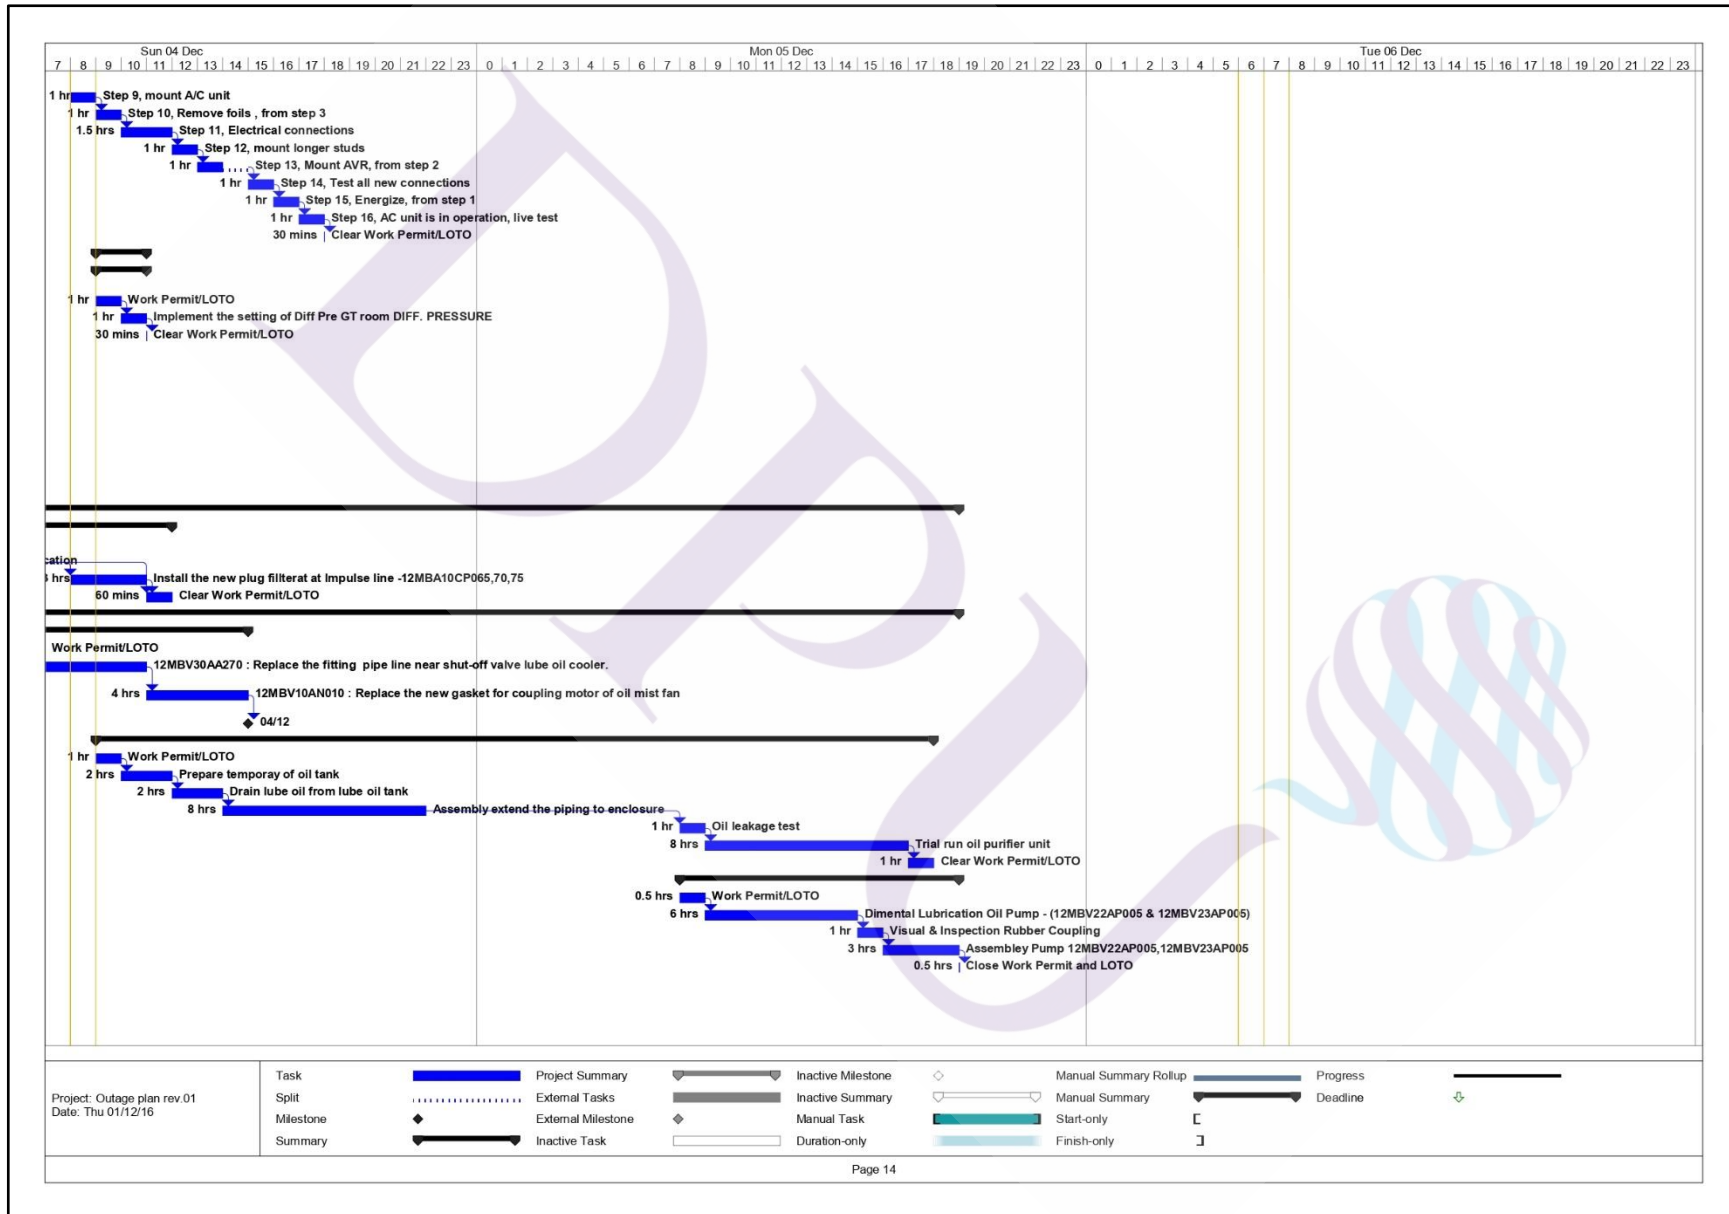


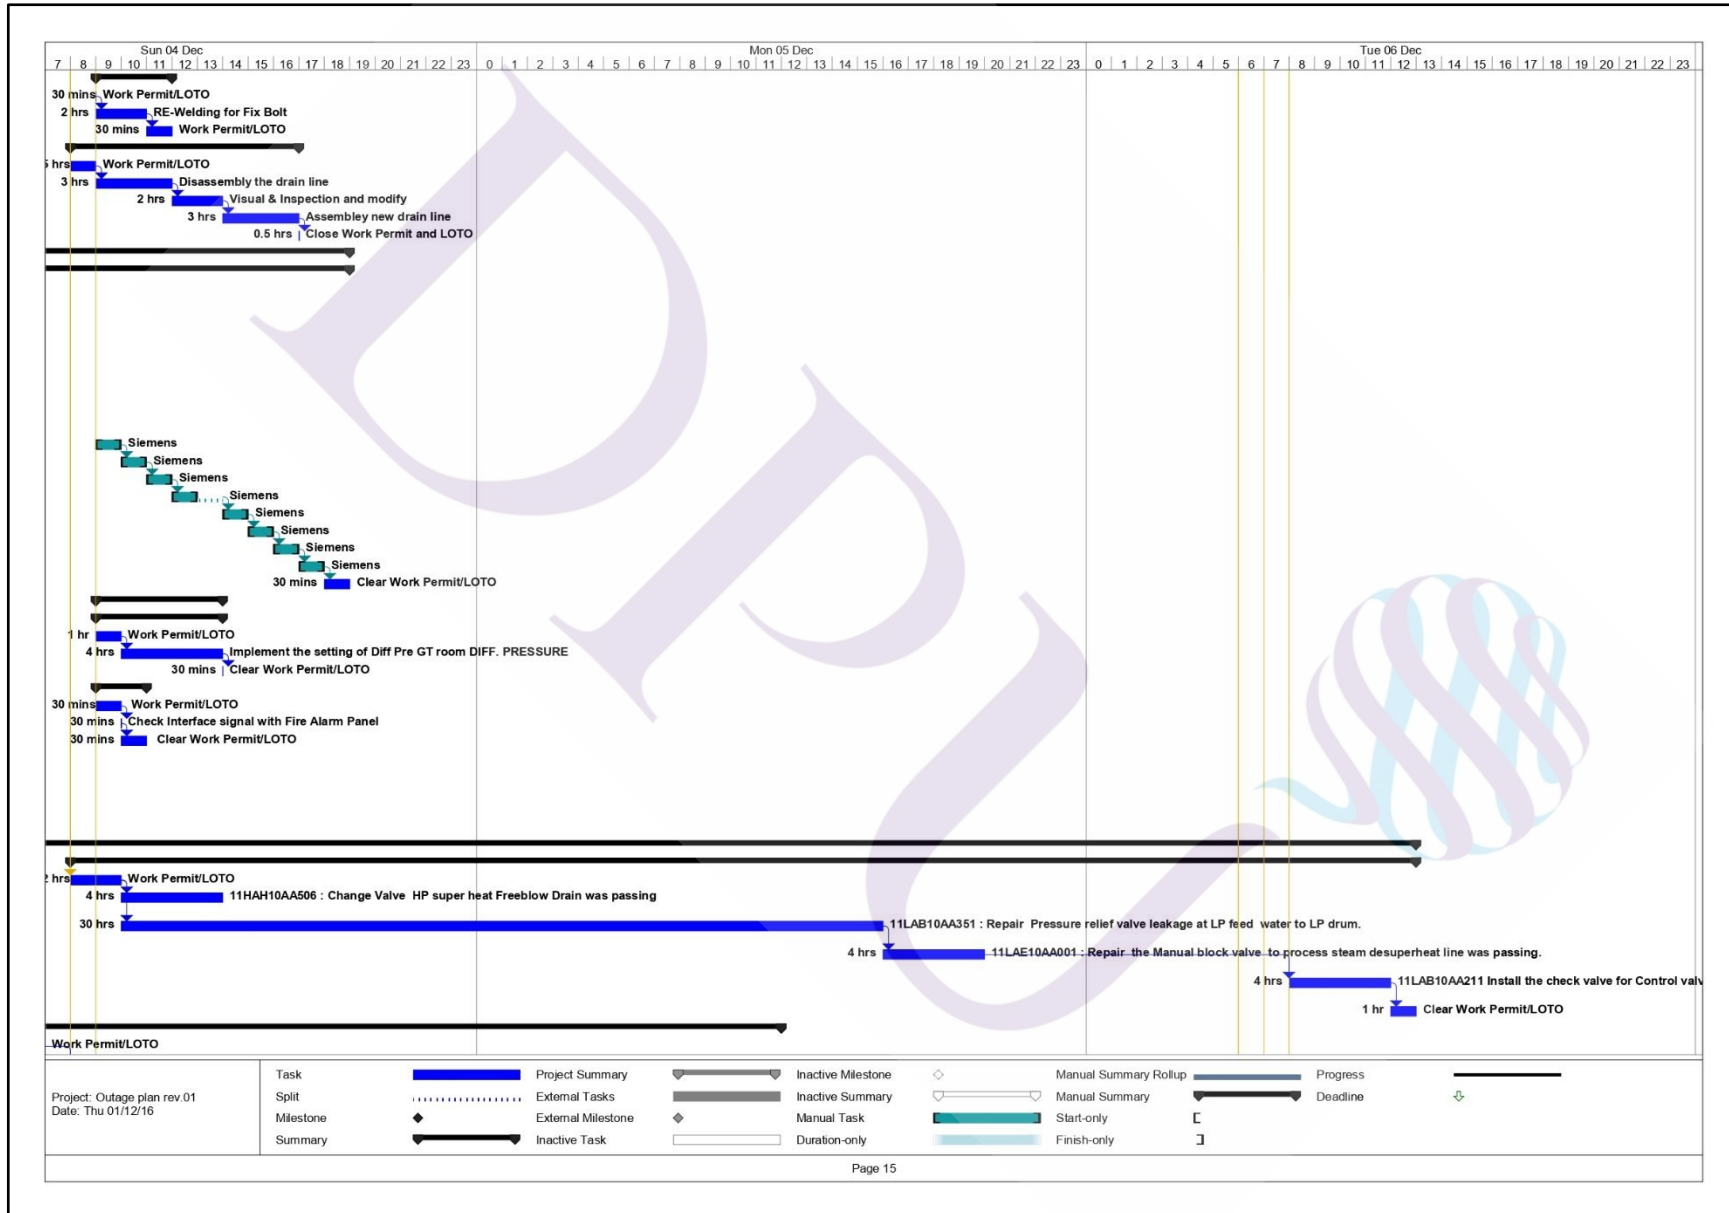


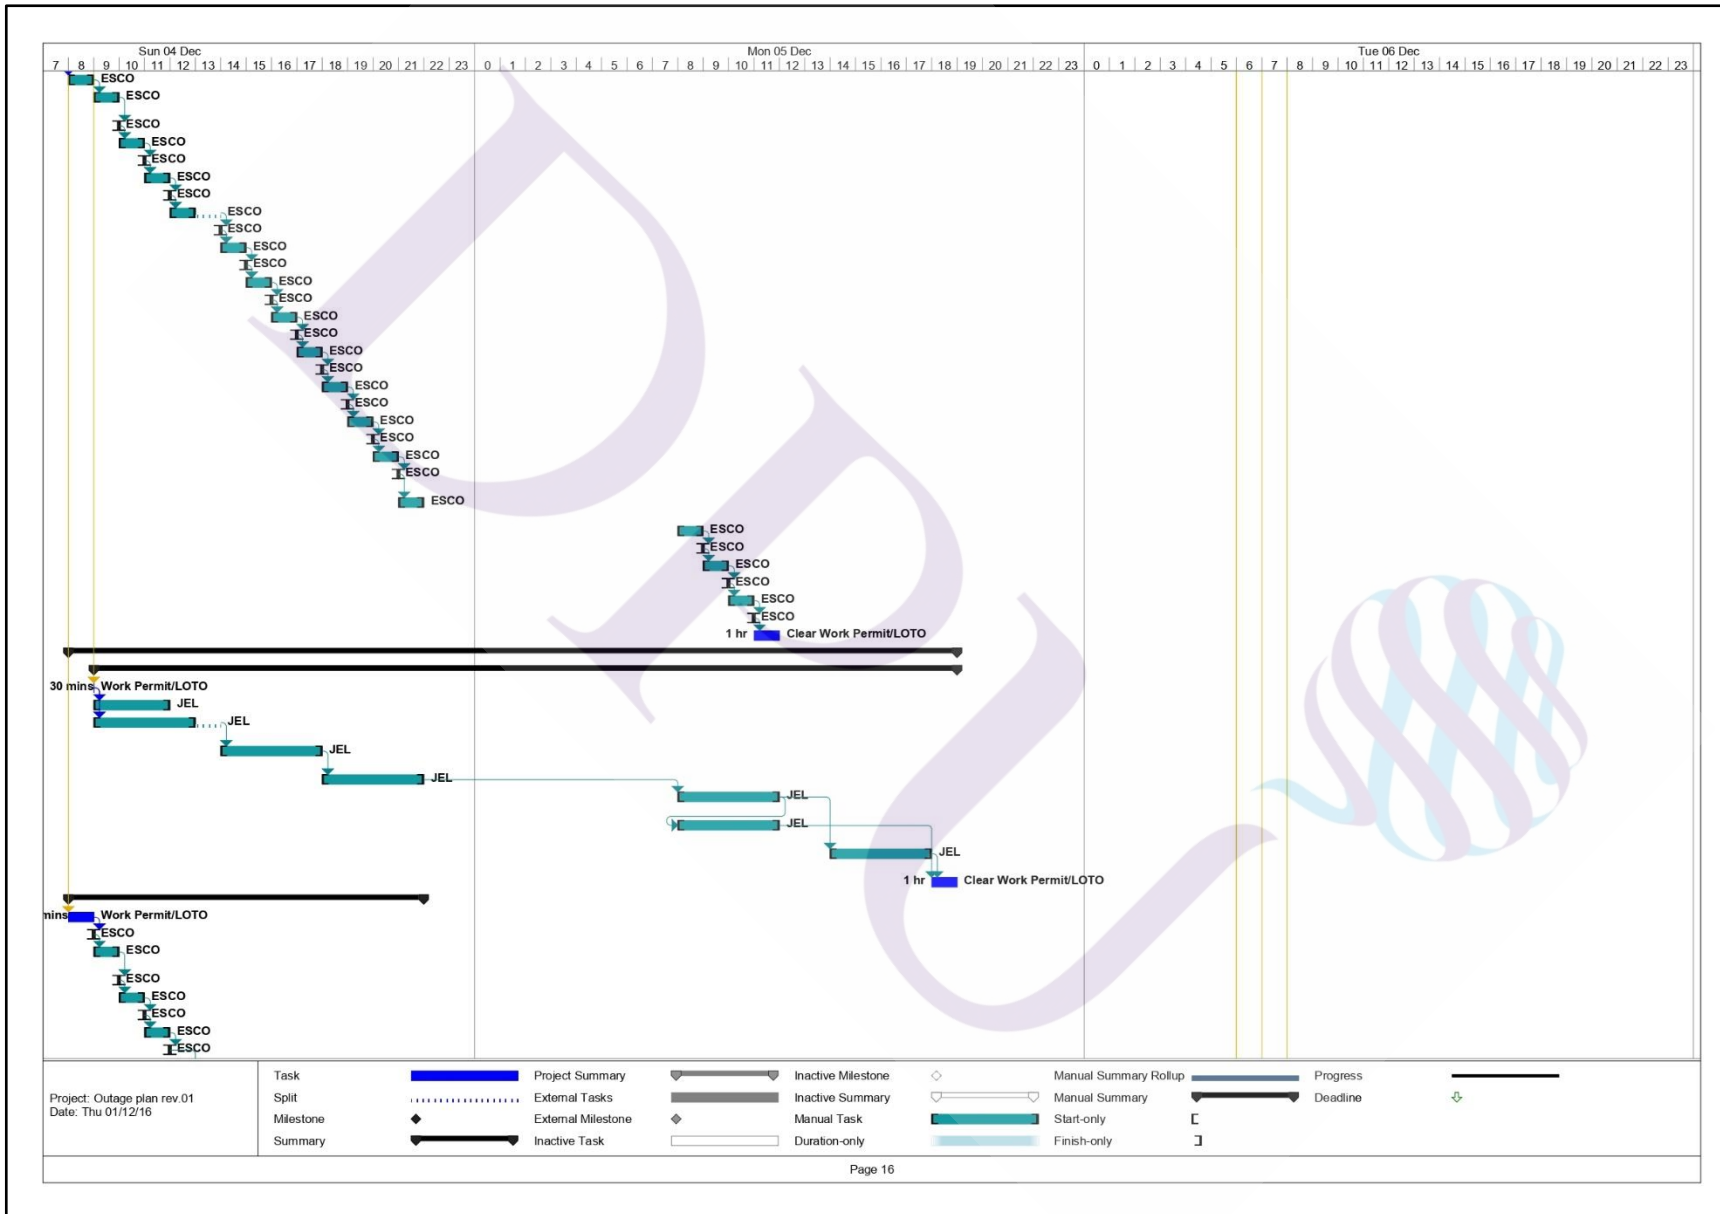


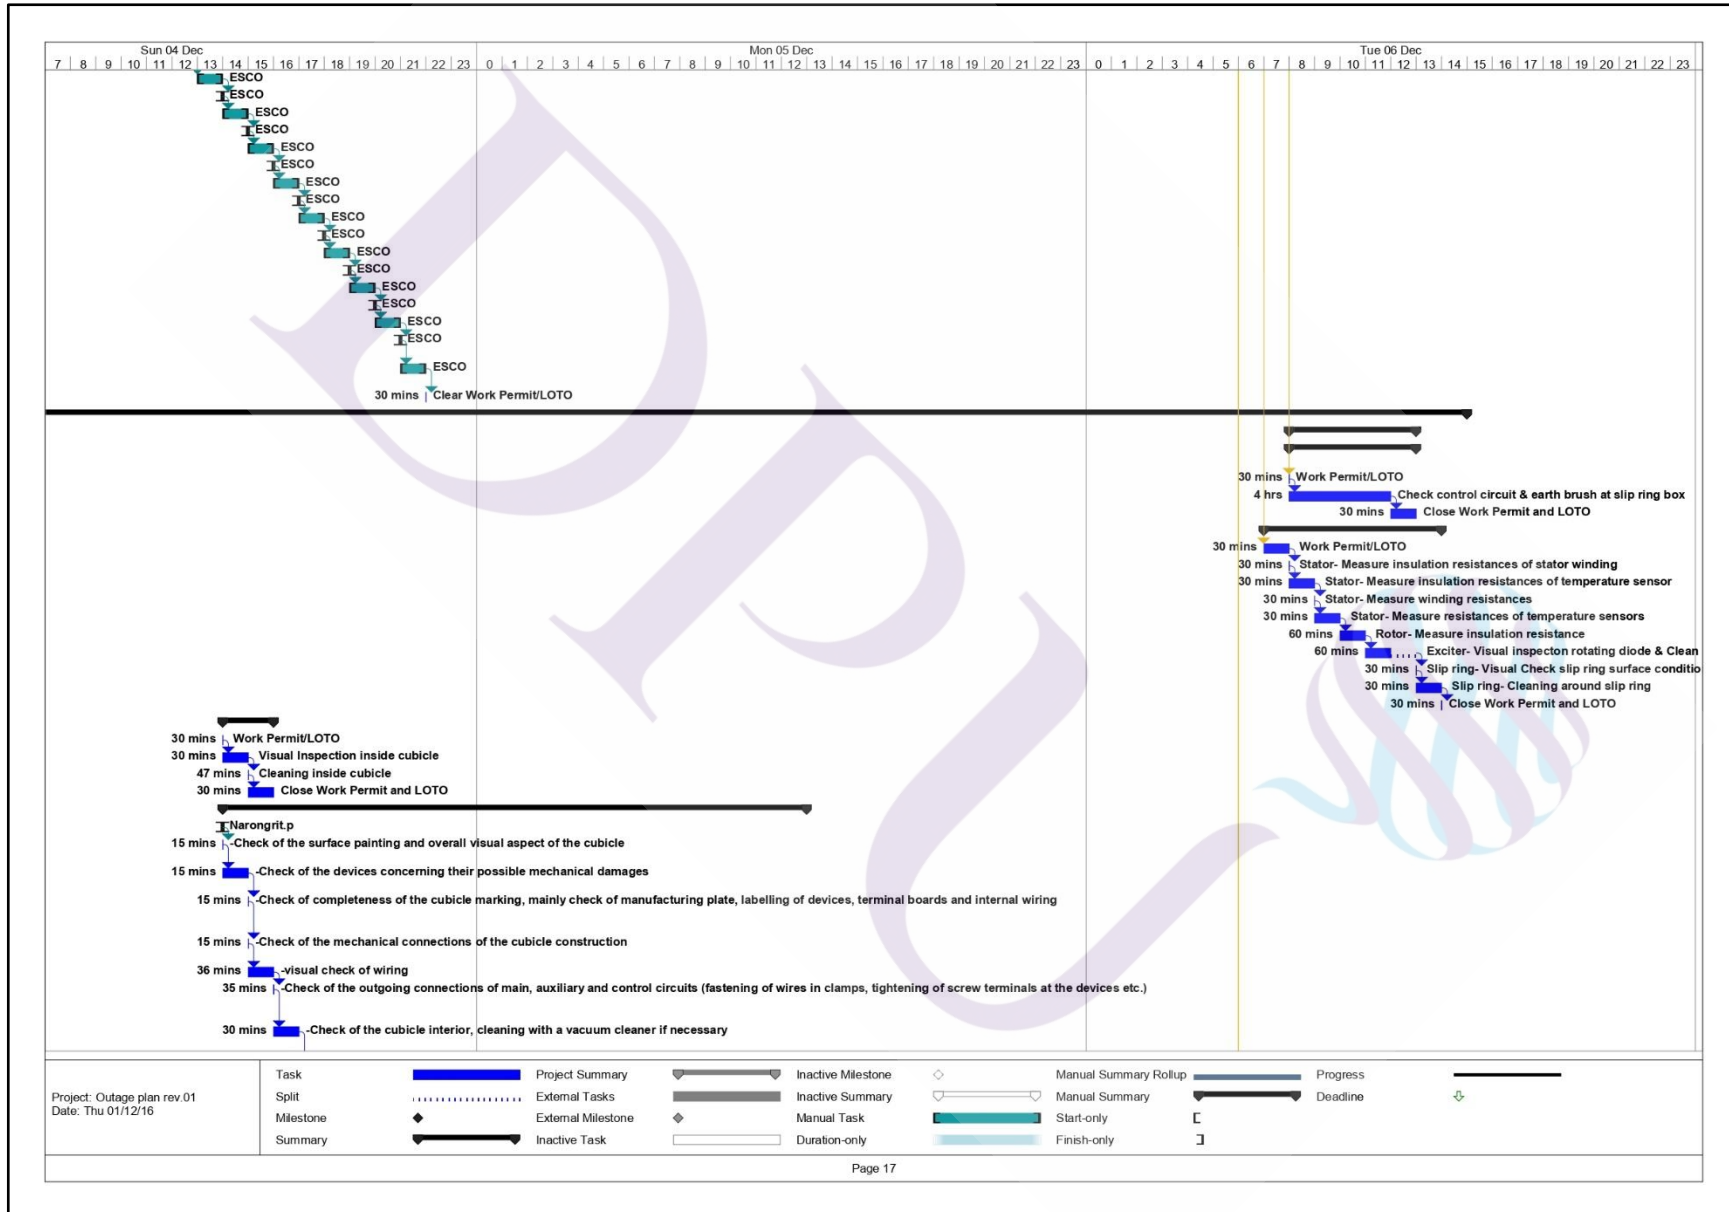

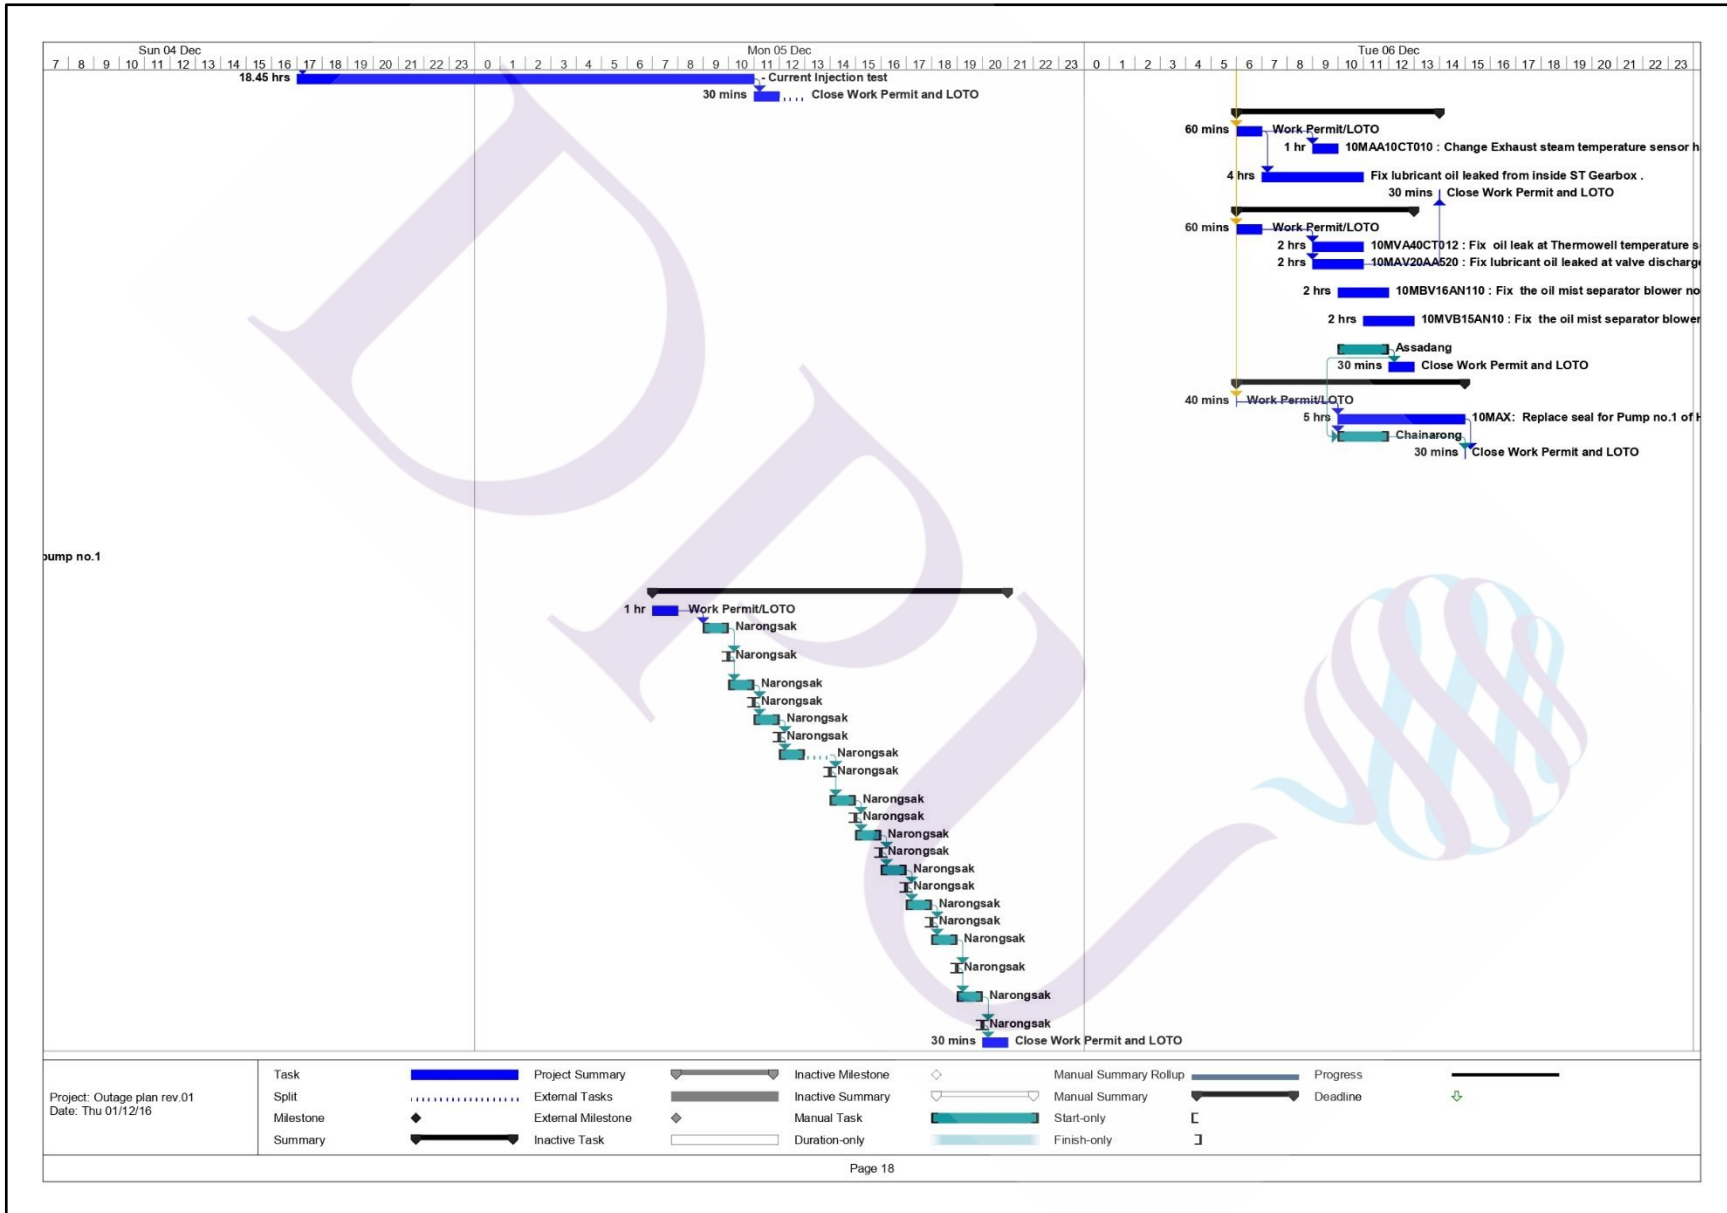

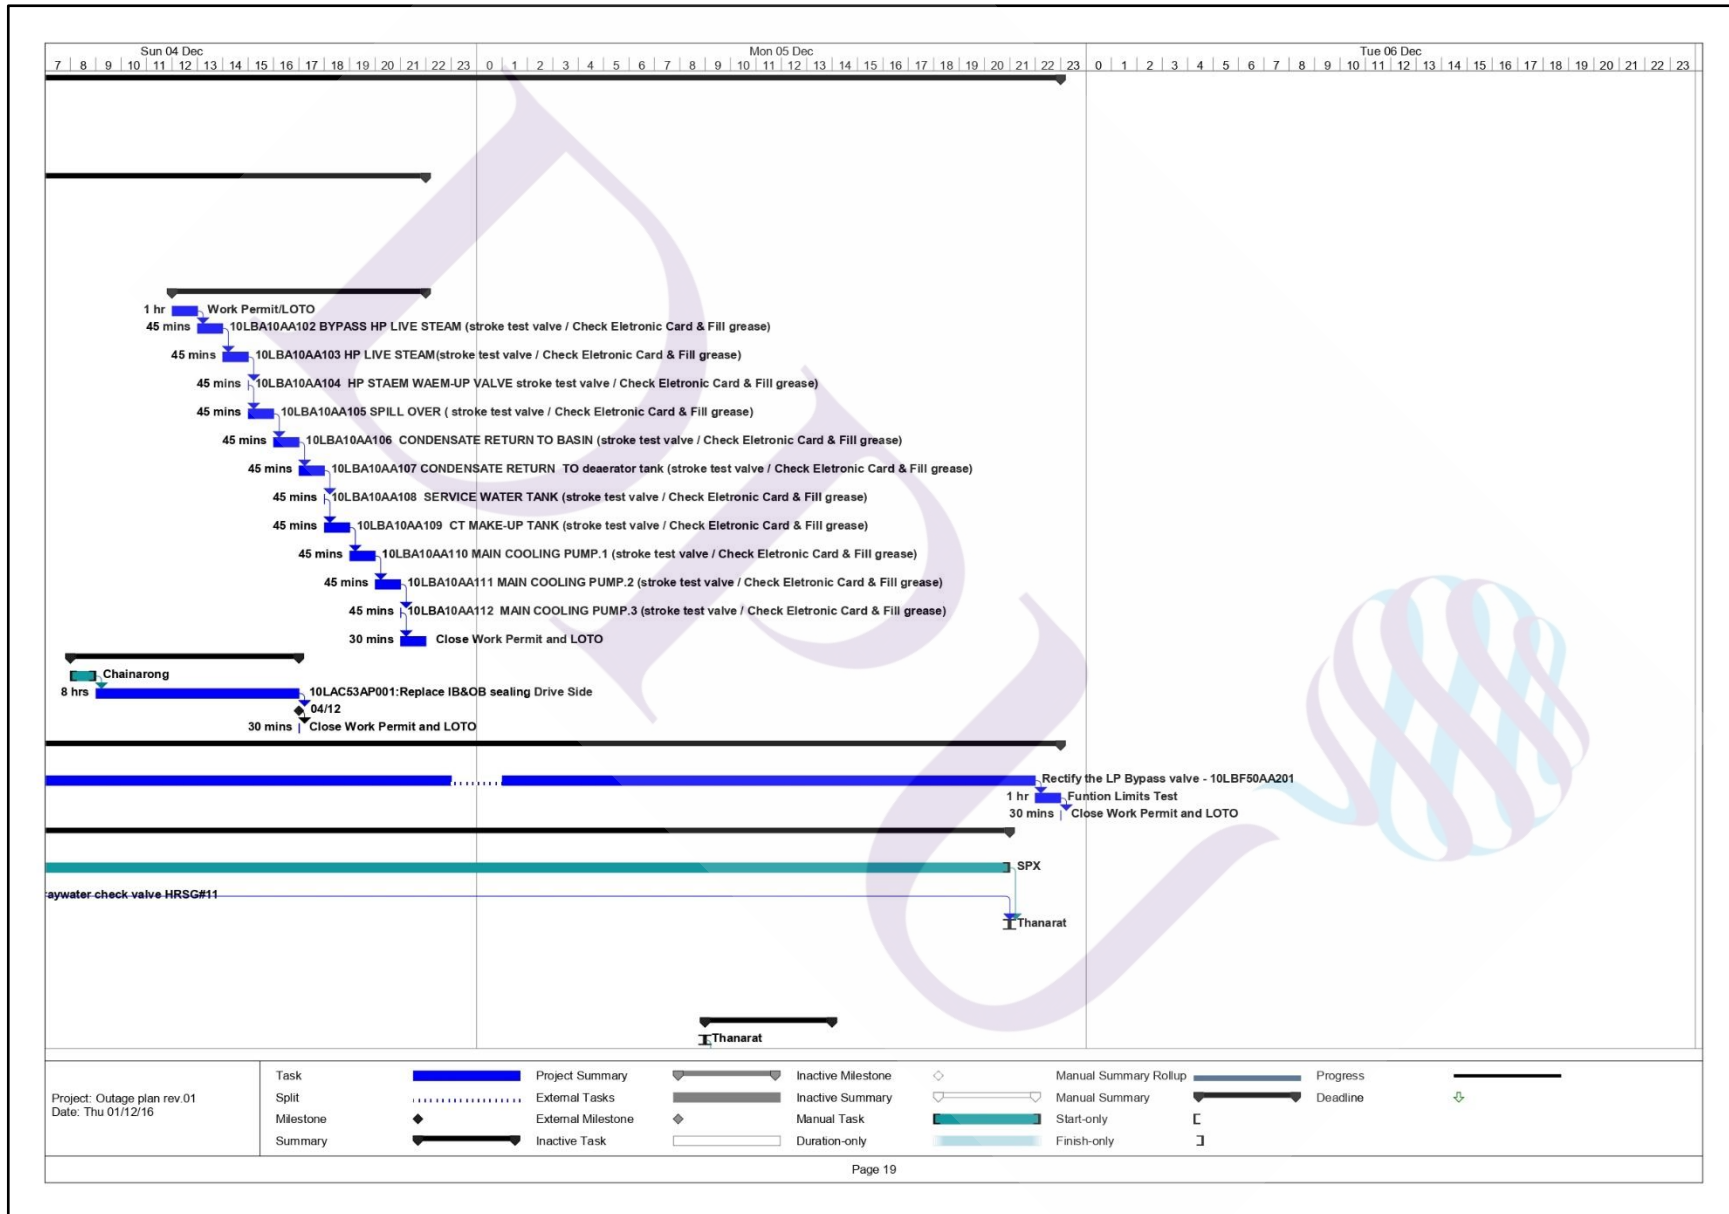

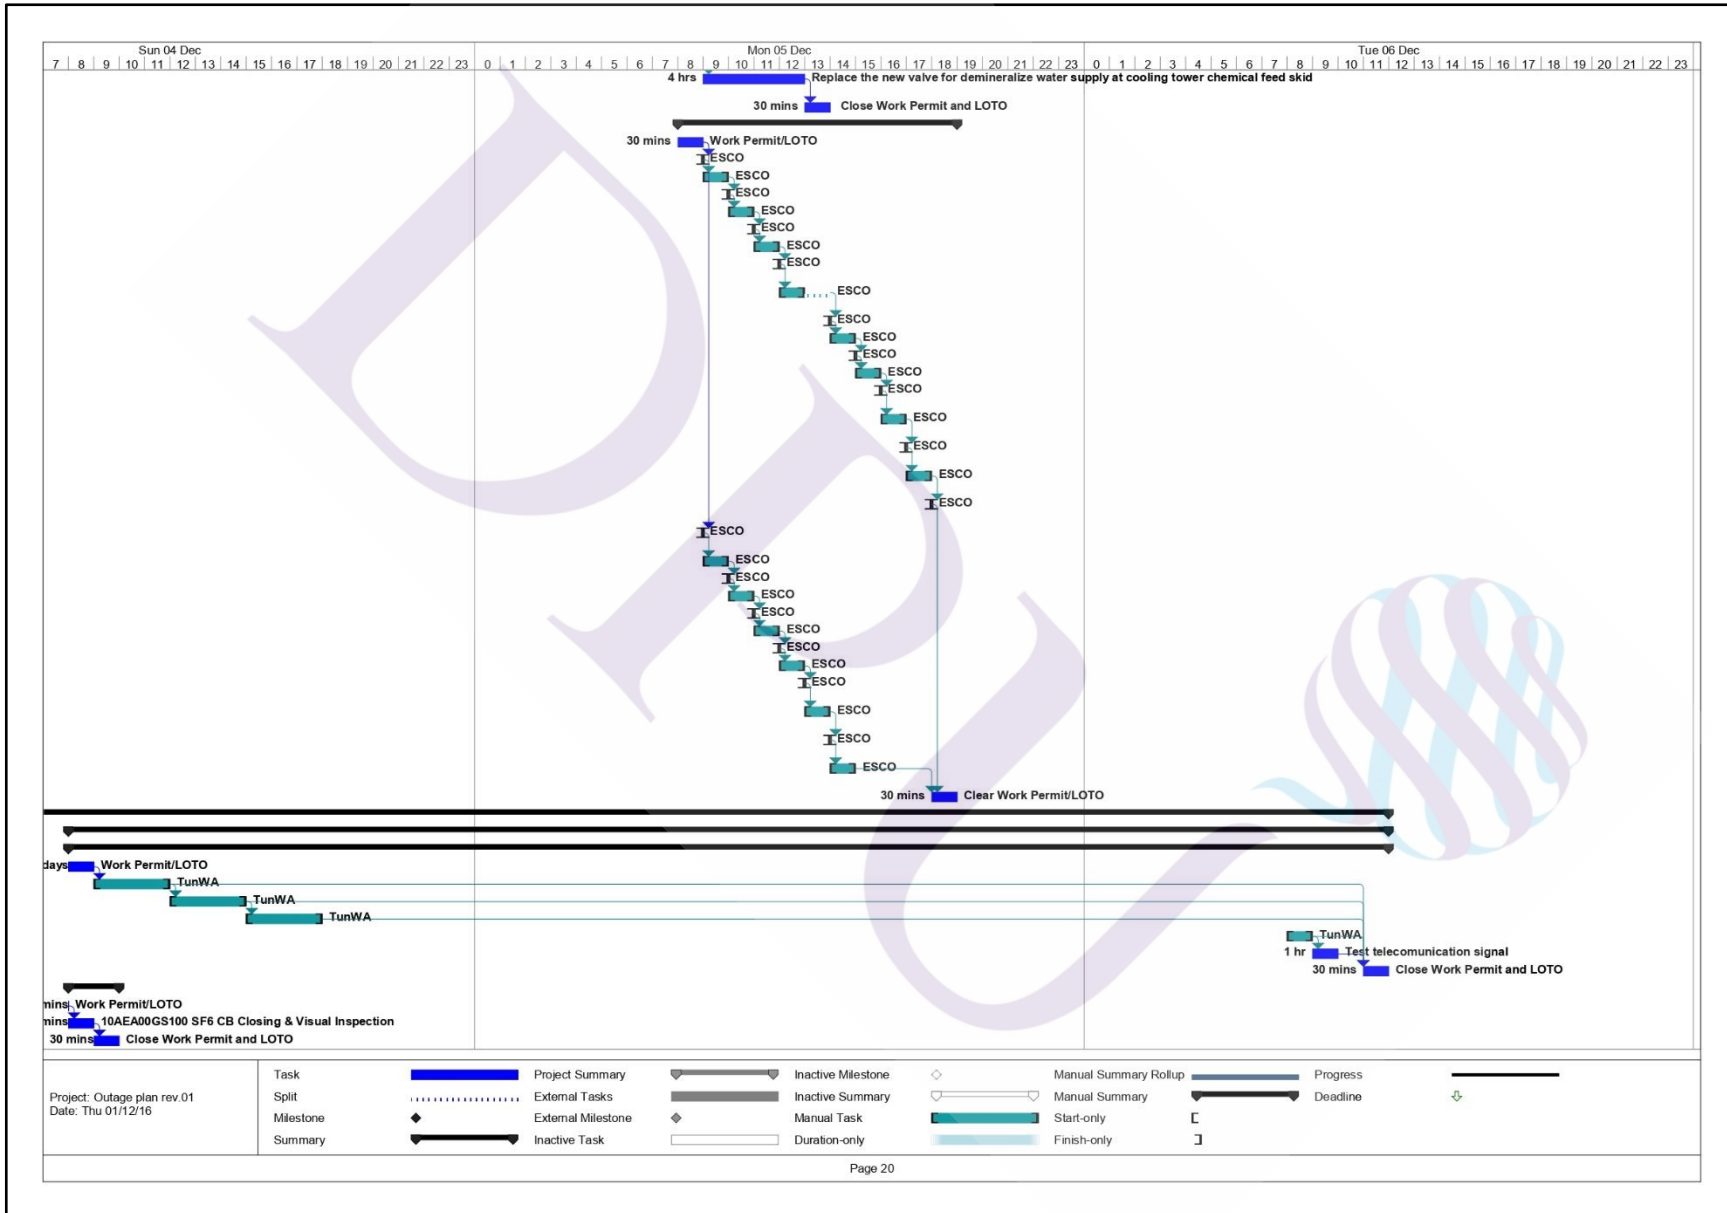


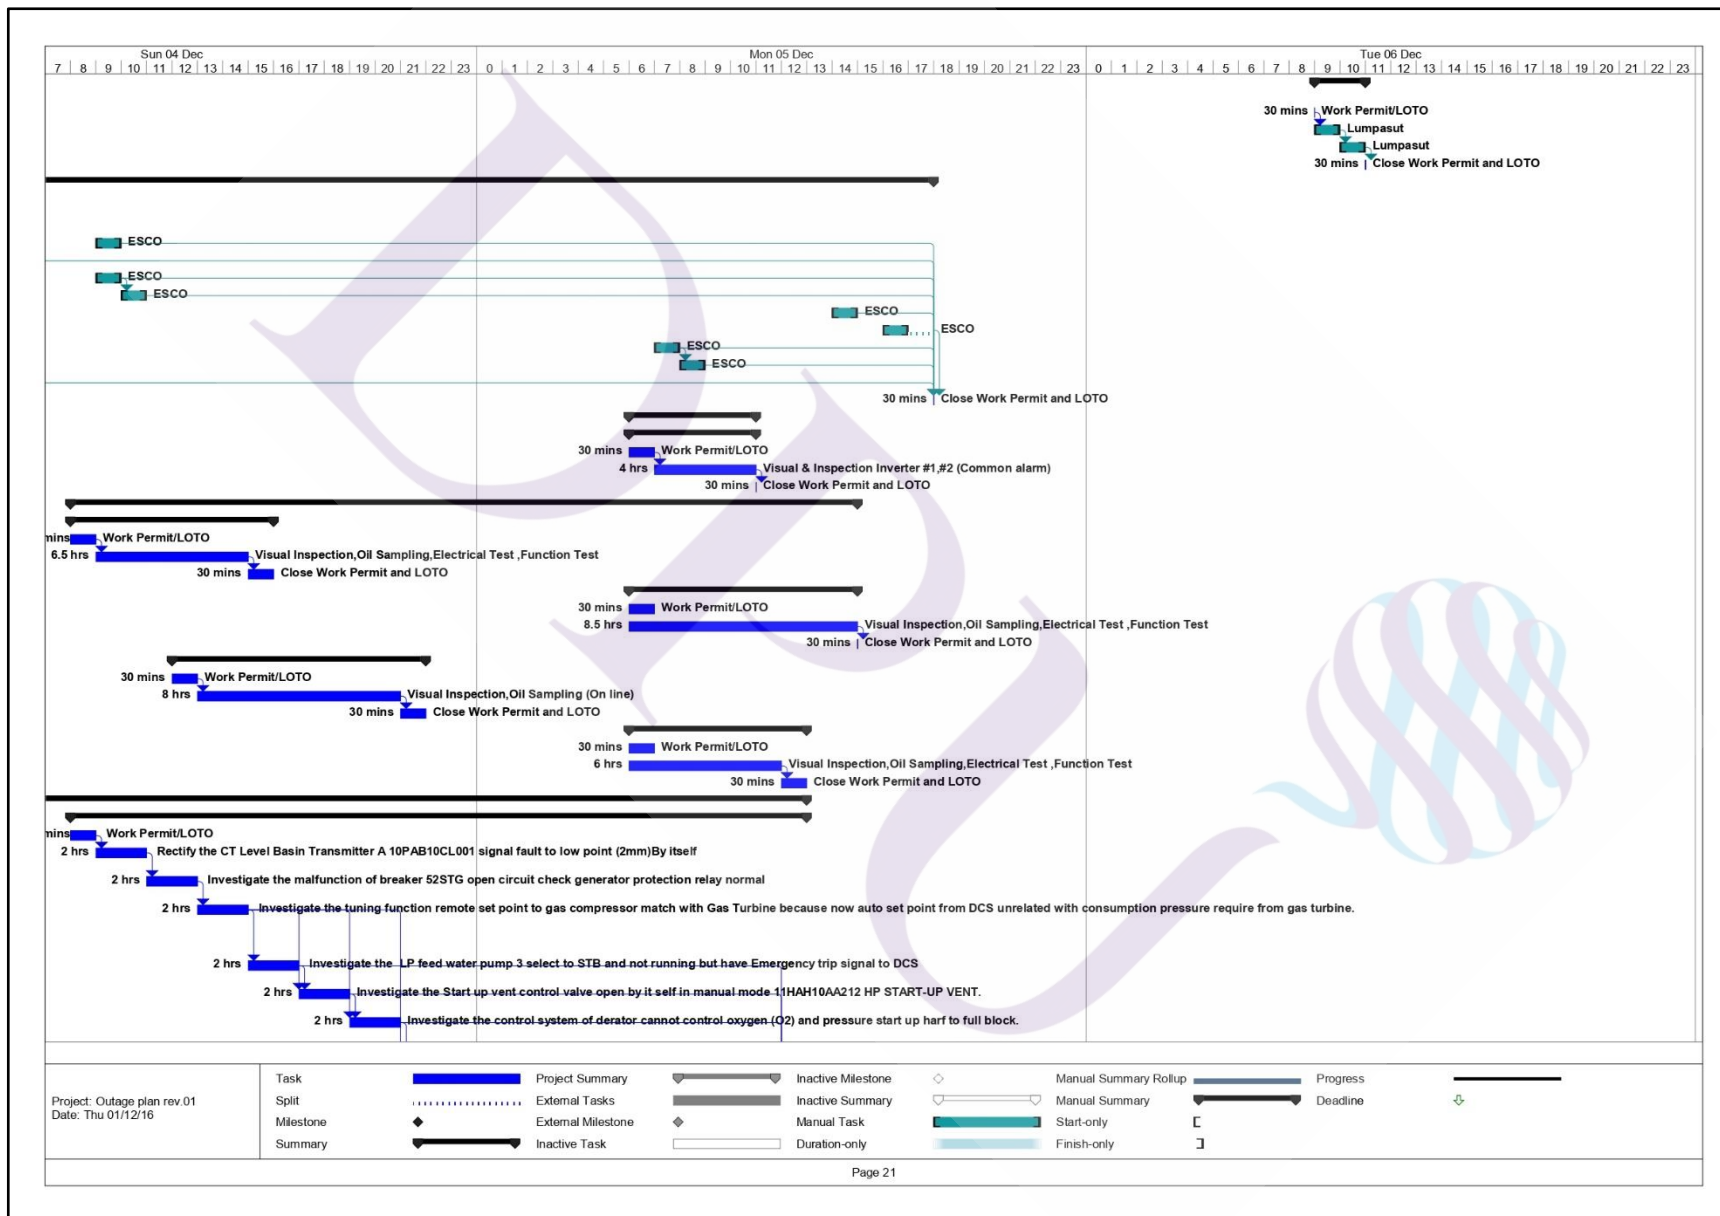



GMRS Presure Re-setting (GPS) Project Schedule								Revision : 00
								Date : 1 December 2016
SHUTDOWN PERIOD		Power Plant Shutdown	DATE	03/12/2016	TIME	00:00		
		Fuel Gas Charging Available	DATE	06/12/2016	TIME	12:00	Under PTT approval	
		Power Plant Re-synchronize	DATE	06/12/2016	TIME	24:00		
ITEM	KEY ACTIVITIES	START	TIME	FINISH	TIME	RESPONSED BY	PORTION	REMARK
1	Calibrate Pressure Transmitter	27/12/2001		30/11/2016		JEL	Suction Line	NOT Required by JEL
2	Replacement Material on site			03/01/2002	08:00	IMC	GMRS	
3	SSV,PCV,PSV Material Replacement and adjusting							
3.1	HOV Valve Closed			03/12/2016	00:00	PTT	GMRS	
3.2	Run A							
	- Piping Inspection & Cleaning	03/12/2016	09:00	03/12/2016	12:00	PTT	GMRS	Sulpher Condition Check
	- Spring valve replacement and adjuston	03/12/2016	13:00	03/12/2016	17:00	IMC	GMRS	
3.3	Run B							
	- Piping Inspection & Cleaning	06/12/2016	09:00	06/12/2016	12:00	PTT	GMRS	
	- Spring valve replacement and adjuston	06/12/2016	09:00	06/12/2016	12:00	IMC	GMRS	
3.4	Flow Comp&SCADA Parameter setting	06/12/2016	09:00	06/12/2016	12:00	PTT	GMRS/OC	
3.5	HOV Valve Open			06/12/2016	12:00	PTT	GMRS	
3.6	GMRS Test&Commissioning	06/12/2016	12:00	06/12/2016	17:00	IMC/PTT	GMRS	Fuel Gas Charging to ATP
4	Fuel Gas Piping System Test and re-Certificate							
4.1	N2 Flushing and Blanking	03/12/2016	08:30	03/12/2016	10:00	ATP	Up to GT	Fuel Gas Suction Piping pass through inlet Gas turbine
4.2	Safety Valve Replacement	03/12/2016	10:00	03/12/2016	11:00	ATP	GC Area	Afte recalibate and re-setting
4.3	Fuel Gas Filter/Seperator 10EKE11AT001&10EKE12AT001							
	- Open QOC to remove Filter Carridge	03/12/2016	11:00	03/12/2016	12:00	ATP	Filters	
	- Close QOC and blind to isolate	03/12/2016	12:00	03/12/2016	13:00	ATP	Filters	
	- Water Fill up to hand over ThermoEX	03/12/2016	13:00	03/12/2016	14:00	ATP	Filters	
	- Hydrotest EQ Preparation	03/12/2016	14:00	03/12/2016	17:00	Thermo EX	Filters	
	- Pressure and Leak Testing	04/12/2016	09:00	04/12/2016	12:00	Thermo EX	Filters	
	- Release Presssure	04/12/2016	12:00	04/12/2016	13:00	Thermo EX	Filters	
	- Official test report with R-stamp	04/12/2016	13:00	05/12/2016	14:00	Thermo EX	Filters	

GMRS Pressure Re-setting (GPS) Project Schedule								Revision :	00
								Date :	1 December 2016
SHUTDOWN PERIOD	Power Plant Shutdown	DATE	03/12/2016	TIME	00:00				
	Fuel Gas Charging Available	DATE	06/12/2016	TIME	12:00	Under PTT approval			
	Power Plant Re-synchronize	DATE	06/12/2016	TIME	24:00				
	- Open QOC to reinstall Filter Cartridge	04/12/2016	14:00	04/12/2016	15:00	ATP	Filters		
	- Remove blind to re-instate	04/12/2016	15:00	04/12/2016	16:00	ATP	Filters		
4.4	Re -Test and Certificate suction Piping								
	- Pneumatic EQ Preparation	03/12/2016	10:00	03/12/2016	17:00	AEG	Suction Line		
	- Pressure and Leak Testing	04/12/2016	09:00	04/12/2016	12:00	AEG	Suction Line		
	- Release Pressure	04/12/2016	12:00	04/12/2016	16:00	AEG	Suction Line		
	- Remove blind to re-instate	04/12/2016	16:00	04/12/2016	17:00	ATP	Suction Line		
	- Official test report with Certificate	04/12/2016	13:00	05/12/2016	14:00	AEG	Suction Line		
4.5	N2 Flushing and Blanking	04/12/2016	16:00	04/12/2016	17:00	ATP	Filters&Suction	Suction Piping with Fuel Filters	
5	Gas Compressor Long term Preservation								
	- Isolate Gas Compressor	06/12/2016	09:00	06/12/2016	12:00	TA/ATP	Gas Comp.		
	- Nitrogen blanking	06/12/2016	12:00	06/12/2016	17:00	TA/ATP	Gas Comp.		
9	DCS Program Improvement								
	- Review and Approve Logic			30/11/2016	17:00	JEL/ ATP	DCS	Done	
	- Implement Software	03/12/2016	09:00	04/12/2016	17:00	JEL	DCS		
	- Testing	05/12/2015	09:00	05/12/2015	17:00	JEL	DCS		
10	Check Leaked with Tapping	06/12/2016	09:00	06/12/2016	12:00	ATP	Up to GT		
11	Fuel Gas System Charging			06/12/2016	12:00	ATP			
	- Official submit test report and certificate			05/12/2016	14:00	ATP	GMRS/ATP		
	- PTT Approve to release Fuel Gas			06/12/2016	12:00	PTT			
12	Start Up Power Plant (Sync to Grid)	06/12/2016	12:00	06/12/2016	24:00	ATP			

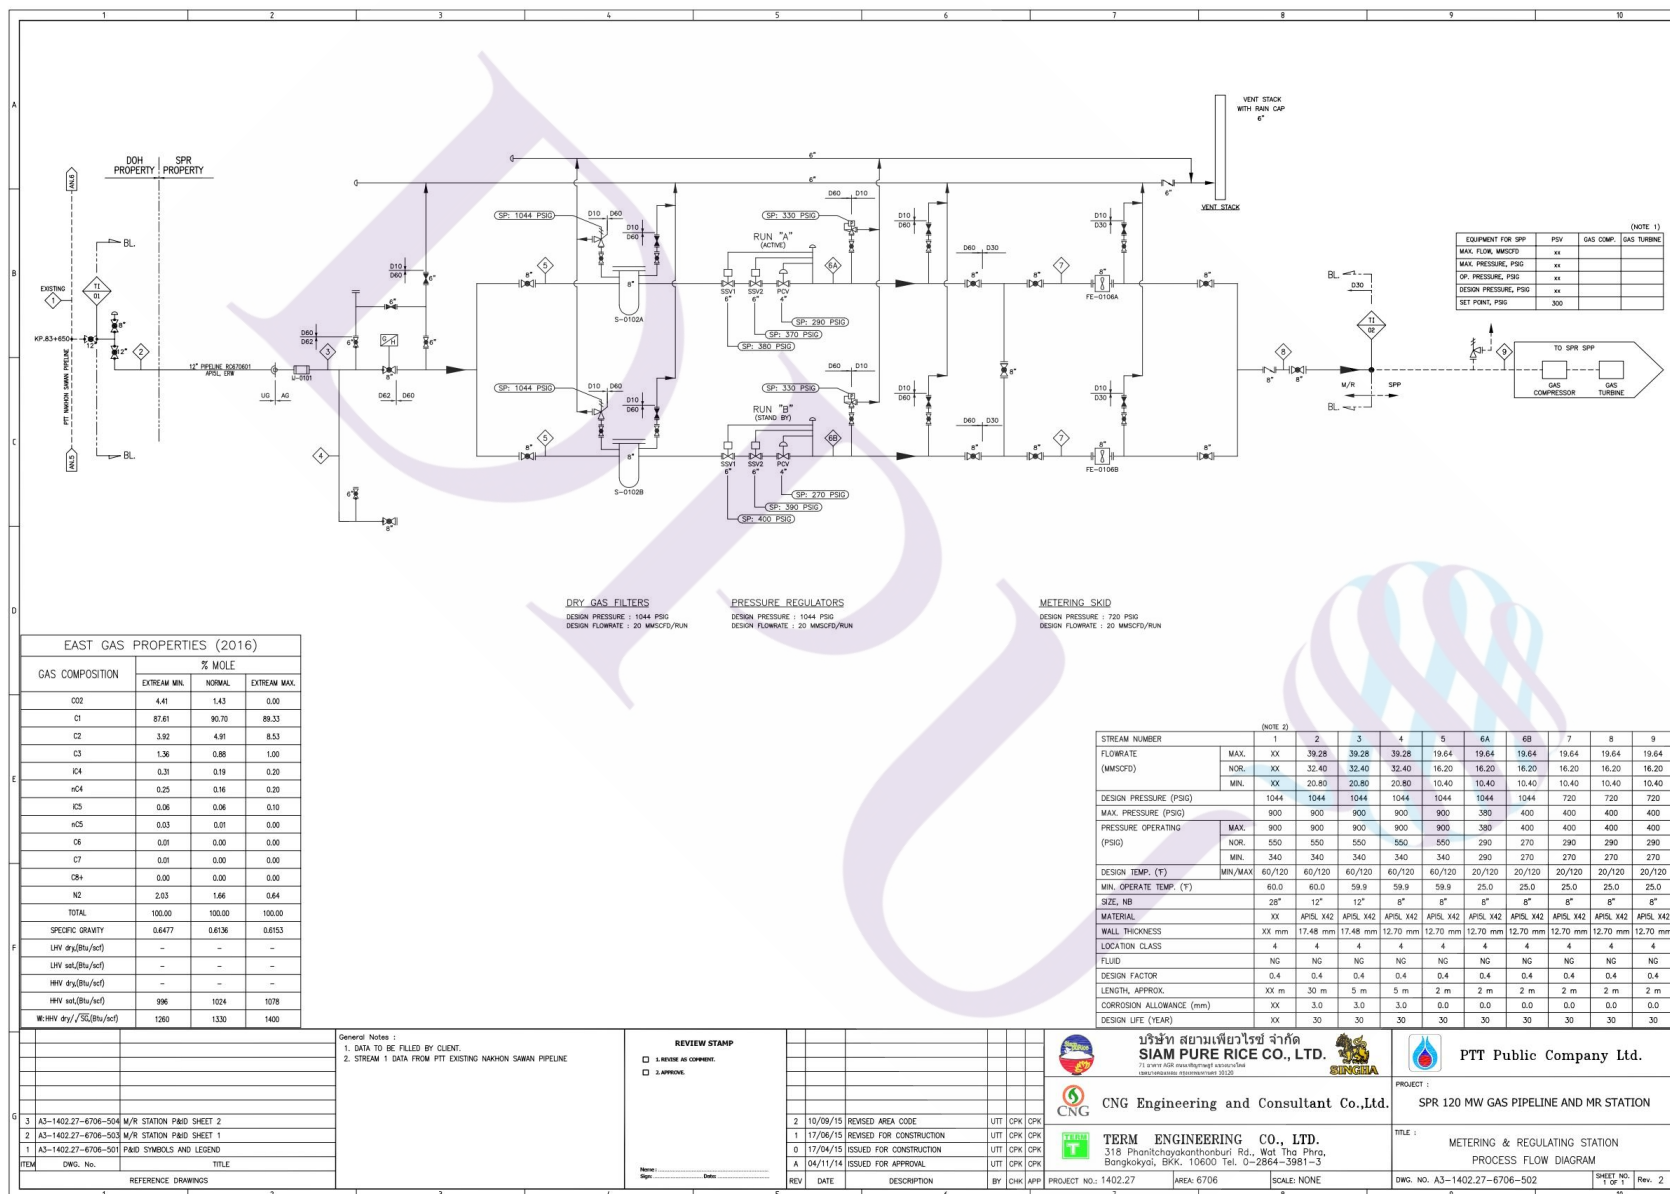

(NOTE 1)

EQUIPMENT FOR SPR	PSV	GAS COMP.	GAS TURBINE
MAX. FLOW, MMSCFD	xx		
MAX. PRESSURE, PSIG	xx		
OP. PRESSURE, PSIG	xx		
DESIGN PRESSURE, PSIG	xx		
SET POINT, PSIG	300		

EAST GAS PROPERTIES (2016)

GAS COMPOSITION	% MOLE		
	EXTREME MIN.	NORMAL	EXTREME MAX.
CO2	4.41	1.43	0.00
C1	87.61	90.70	89.33
C2	3.92	4.91	8.53
C3	1.36	0.86	1.00
iC4	0.31	0.19	0.20
nC4	0.25	0.16	0.20
iC5	0.06	0.06	0.10
nC5	0.03	0.01	0.00
C6	0.01	0.00	0.00
C7	0.01	0.00	0.00
C8+	0.00	0.00	0.00
N2	2.03	1.66	0.64
TOTAL	100.00	100.00	100.00
SPECIFIC GRAVITY	0.6477	0.6136	0.6153
LHV ϕ_H (Btu/scf)	-	-	-
LHV ω_H (Btu/scf)	-	-	-
HV ϕ_H (Btu/scf)	-	-	-
HV ω_H (Btu/scf)	996	1024	1078
WHSV ϕ_H / \sqrt{SG} (Btu/scf)	1260	1330	1400

(NOTE 2)

STREAM NUMBER	1	2	3	4	5	6A	6B	7	8	9
FLOWRATE (MMSCFD)	MAX.	XX	39.28	39.28	39.28	19.64	19.64	19.64	19.64	19.64
	NOR.	XX	32.40	32.40	32.40	16.20	16.20	16.20	16.20	16.20
	MIN.	XX	20.80	20.80	20.80	10.40	10.40	10.40	10.40	10.40
DESIGN PRESSURE (PSIG)	1044	1044	1044	1044	1044	1044	1044	720	720	720
MAX. PRESSURE (PSIG)	900	900	900	900	900	385	400	400	400	400
PRESSURE OPERATING (PSIG)	MAX.	900	900	900	900	385	400	400	400	400
	NOR.	550	550	550	550	290	270	290	290	290
	MIN.	340	340	340	340	290	270	270	270	270
DESIGN TEMP. (°F)	MIN/MAX	60/120	60/120	60/120	60/120	20/120	20/120	20/120	20/120	20/120
MIN. OPERATE TEMP. (°F)		60.0	60.0	59.9	59.9	59.9	25.0	25.0	25.0	25.0
SIZE, NB		28"	12"	12"	8"	8"	8"	8"	8"	8"
MATERIAL		XX	APSL X42	APSL X42	APSL X42	APSL X42	APSL X42	APSL X42	APSL X42	APSL X42
WALL THICKNESS		XX mm	17.48 mm	17.48 mm	12.70 mm	12.70 mm	12.70 mm	12.70 mm	12.70 mm	12.70 mm
LOCATION CLASS		4	4	4	4	4	4	4	4	4
FLUID		NG	NG	NG	NG	NG	NG	NG	NG	NG
DESIGN FACTOR		0.4	0.4	0.4	0.4	0.4	0.4	0.4	0.4	0.4
LENGTH, APPROX.		XX m	30 m	5 m	5 m	2 m	2 m	2 m	2 m	2 m
CORROSION ALLOWANCE (mm)		XX	3.0	3.0	3.0	0.0	0.0	0.0	0.0	0.0
DESIGN LIFE (YEAR)		XX	30	30	30	30	30	30	30	30

General Notes :
 1. DATA TO BE FILLED BY CLIENT.
 2. STREAM 1 DATA FROM PTT EXISTING NAKHON SAWAN PIPELINE

REVIEW STAMP
 1. REVIEW AS COMMENT.
 2. APPROVE.

ITEM	DWG. No.	TITLE
3	A3-1402.27-6706-504	M/R STATION P&ID SHEET 2
2	A3-1402.27-6706-503	M/R STATION P&ID SHEET 1
1	A3-1402.27-6706-501	P&ID SYMBOLS AND LEGEND

REV	DATE	DESCRIPTION	BY	CHK	APP
2	10/09/15	REVISED AREA CODE	UTT	CPK	CPK
1	17/06/15	REVISED FOR CONSTRUCTION	UTT	CPK	CPK
0	17/04/15	ISSUED FOR CONSTRUCTION	UTT	CPK	CPK
A	04/11/14	ISSUED FOR APPROVAL	UTT	CPK	CPK

บริษัท สยามเพียวไรซ์ จำกัด
SIAM PURE RICE CO., LTD.
 318 Phantichayakantornburi Rd., Wat Tho Phra, Bangkokkroy, BKK. 10600 Tel. 0-2864-3981-3

CNG Engineering and Consultant Co., Ltd.

TERM ENGINEERING CO., LTD.
 318 Phantichayakantornburi Rd., Wat Tho Phra, Bangkokkroy, BKK. 10600 Tel. 0-2864-3981-3

PTT Public Company Ltd.


PROJECT : SPR 120 MW GAS PIPELINE AND MR STATION

TITLE : METERING & REGULATING STATION PROCESS FLOW DIAGRAM


DWG. NO. A3-1402.27-6706-502


SHEET NO. 1 OF 1


Rev. 2

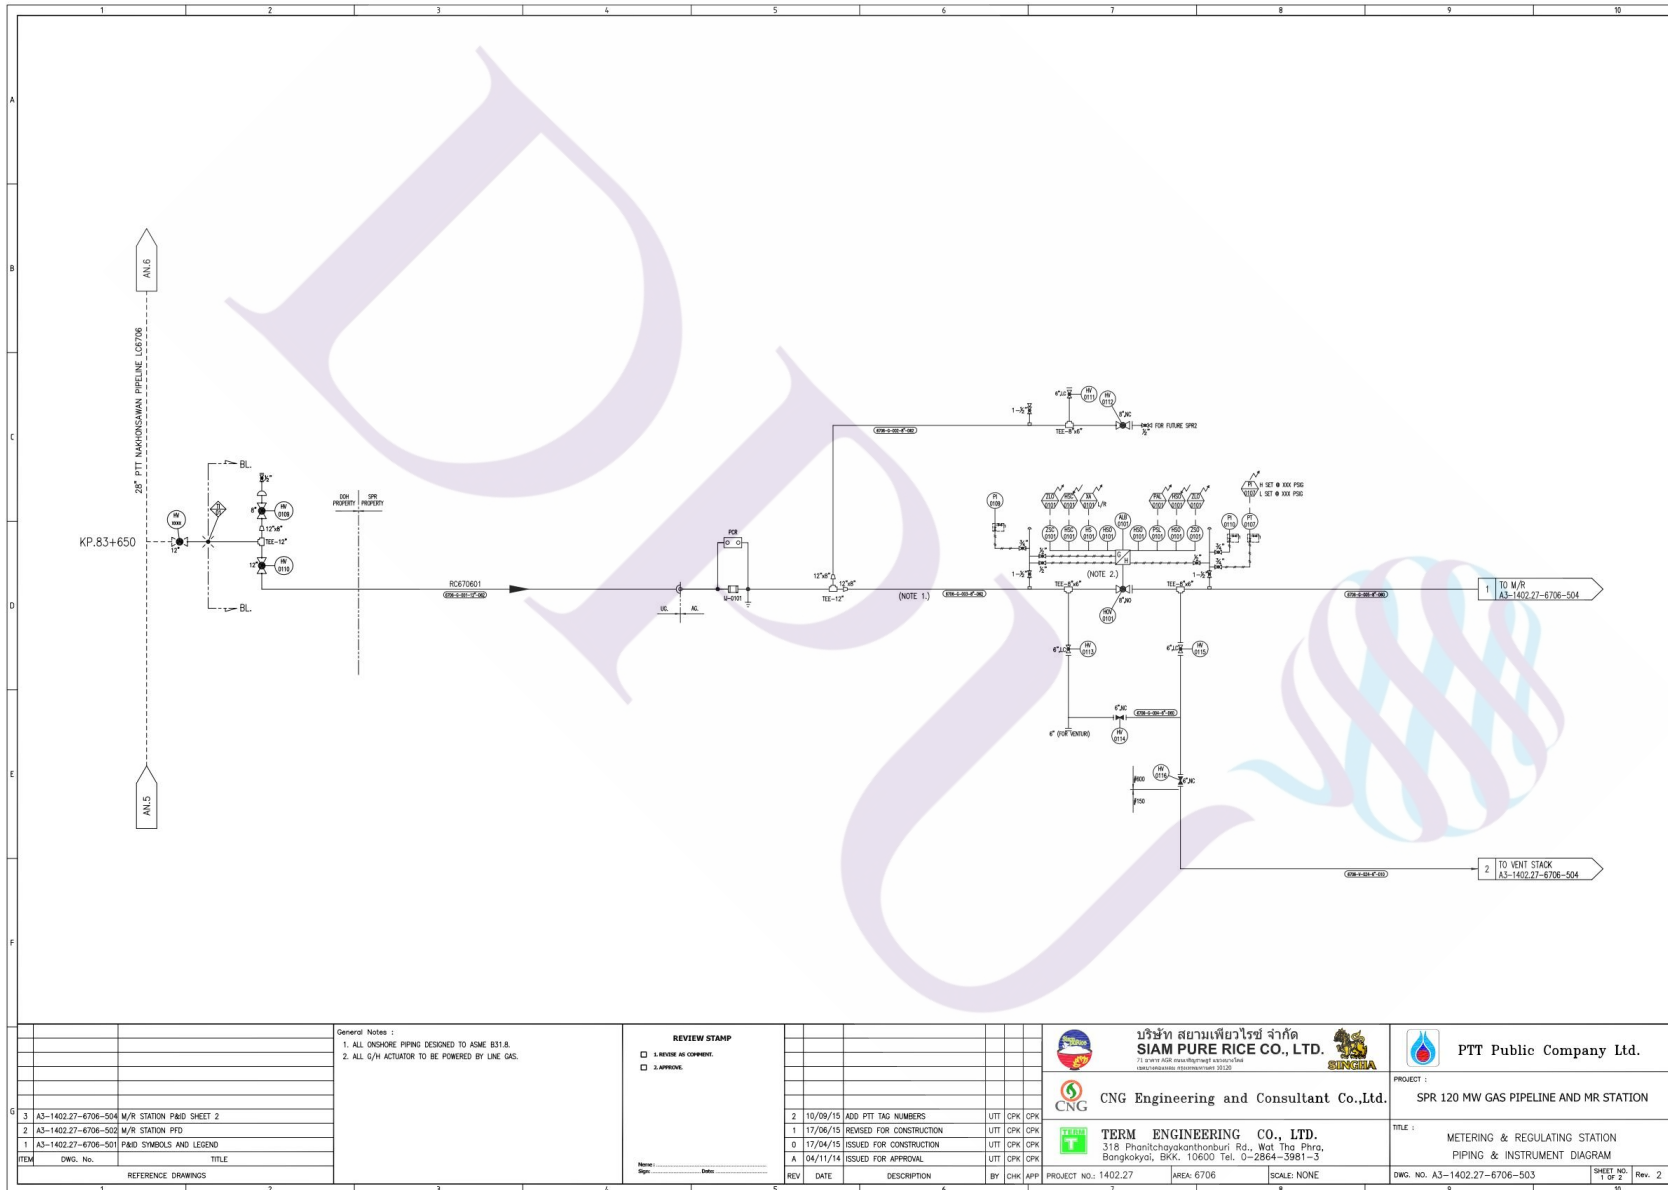

<p>General Notes :</p> <ol style="list-style-type: none"> 1. ALL ONSHORE PIPING DESIGNED TO ASME B31.8. 2. ALL Q/H ACTUATOR TO BE POWERED BY LINE GAS. 		<p>REVIEW STAMP</p> <p><input type="checkbox"/> 1. REVIEW AS COMMENT.</p> <p><input type="checkbox"/> 2. APPROVE.</p> <p>Name: _____ Date: _____</p>		<table border="1"> <tr> <th>REV</th> <th>DATE</th> <th>DESCRIPTION</th> <th>BY</th> <th>CHK</th> <th>APP</th> </tr> <tr> <td>2</td> <td>10/09/15</td> <td>ADD PTT TAG NUMBERS</td> <td>UTT</td> <td>CPK</td> <td>CPK</td> </tr> <tr> <td>1</td> <td>17/06/15</td> <td>REVISED FOR CONSTRUCTION</td> <td>UTT</td> <td>CPK</td> <td>CPK</td> </tr> <tr> <td>0</td> <td>17/04/15</td> <td>ISSUED FOR CONSTRUCTION</td> <td>UTT</td> <td>CPK</td> <td>CPK</td> </tr> <tr> <td>A</td> <td>04/11/14</td> <td>ISSUED FOR APPROVAL</td> <td>UTT</td> <td>CPK</td> <td>CPK</td> </tr> </table>		REV	DATE	DESCRIPTION	BY	CHK	APP	2	10/09/15	ADD PTT TAG NUMBERS	UTT	CPK	CPK	1	17/06/15	REVISED FOR CONSTRUCTION	UTT	CPK	CPK	0	17/04/15	ISSUED FOR CONSTRUCTION	UTT	CPK	CPK	A	04/11/14	ISSUED FOR APPROVAL	UTT	CPK	CPK	<p> บริษัท สยามเพียวไรซ์ จำกัด SIAM PURE RICE CO., LTD. 318 Phantichayakantornburi Rd., Wat Tho Phra, Bangkokyoi, BKK. 10600 Tel. 0-2854-3981-3</p> <p> บริษัท สยามเพียวไรซ์ จำกัด CNG Engineering and Consultant Co., Ltd.</p> <p> บริษัท สยามเพียวไรซ์ จำกัด TERM ENGINEERING CO., LTD. 318 Phantichayakantornburi Rd., Wat Tho Phra, Bangkokyoi, BKK. 10600 Tel. 0-2854-3981-3</p>		<p> PTT Public Company Ltd.</p> <p>PROJECT : SPR 120 MW GAS PIPELINE AND MR STATION</p> <p>TITLE : METERING & REGULATING STATION PIPING & INSTRUMENT DIAGRAM</p> <p>DWG. NO. A3-1402.27-6706-503</p> <p>SHEET NO. 1 of 2 Rev. 2</p>	
REV	DATE	DESCRIPTION	BY	CHK	APP																																		
2	10/09/15	ADD PTT TAG NUMBERS	UTT	CPK	CPK																																		
1	17/06/15	REVISED FOR CONSTRUCTION	UTT	CPK	CPK																																		
0	17/04/15	ISSUED FOR CONSTRUCTION	UTT	CPK	CPK																																		
A	04/11/14	ISSUED FOR APPROVAL	UTT	CPK	CPK																																		
<table border="1"> <tr> <th>ITEM</th> <th>DWG. No.</th> <th>TITLE</th> </tr> <tr> <td>3</td> <td>A3-1402.27-6706-504</td> <td>M/R STATION P&ID SHEET 2</td> </tr> <tr> <td>2</td> <td>A3-1402.27-6706-502</td> <td>M/R STATION PTD</td> </tr> <tr> <td>1</td> <td>A3-1402.27-6706-501</td> <td>P&ID SYMBOLS AND LEGEND</td> </tr> </table>		ITEM	DWG. No.	TITLE	3	A3-1402.27-6706-504	M/R STATION P&ID SHEET 2	2	A3-1402.27-6706-502	M/R STATION PTD	1	A3-1402.27-6706-501	P&ID SYMBOLS AND LEGEND	<p>REFERENCE DRAWINGS</p>		<p>PROJECT NO: 1402.27</p> <p>AREA: 6706</p> <p>SCALE: NONE</p>																							
ITEM	DWG. No.	TITLE																																					
3	A3-1402.27-6706-504	M/R STATION P&ID SHEET 2																																					
2	A3-1402.27-6706-502	M/R STATION PTD																																					
1	A3-1402.27-6706-501	P&ID SYMBOLS AND LEGEND																																					

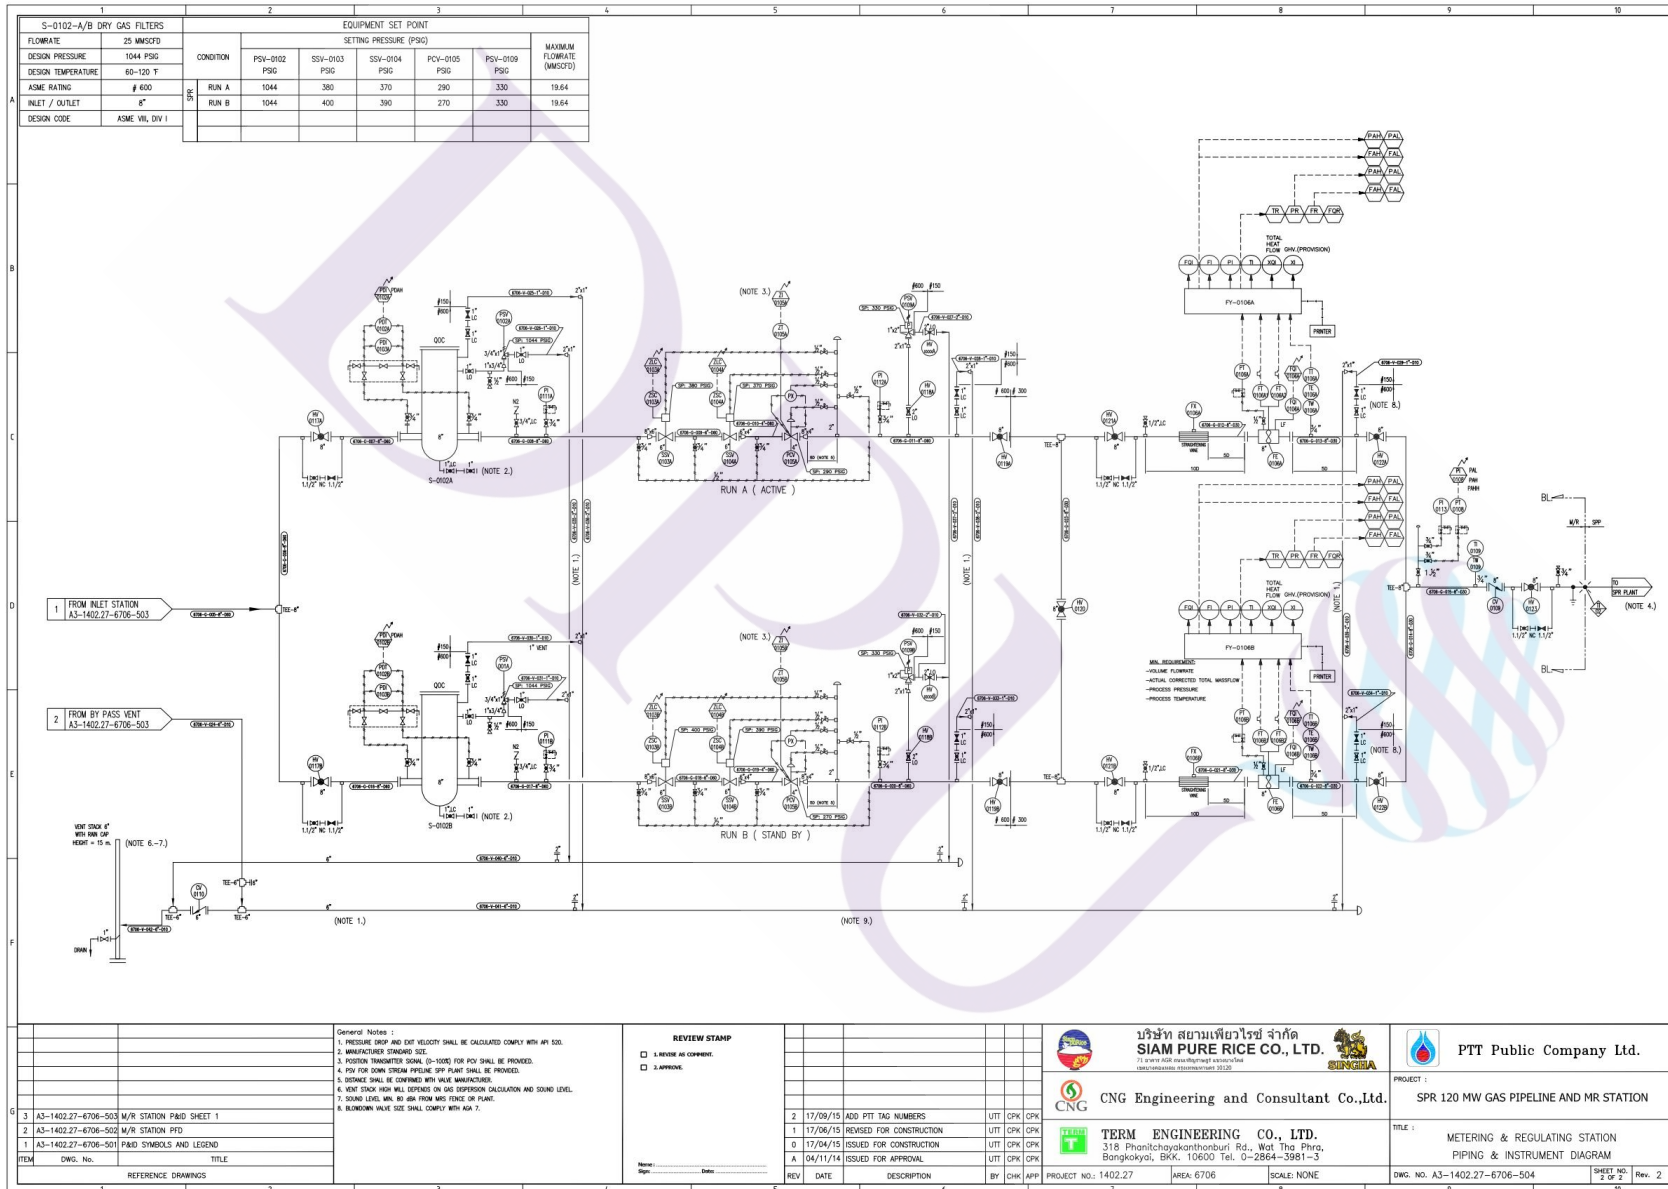


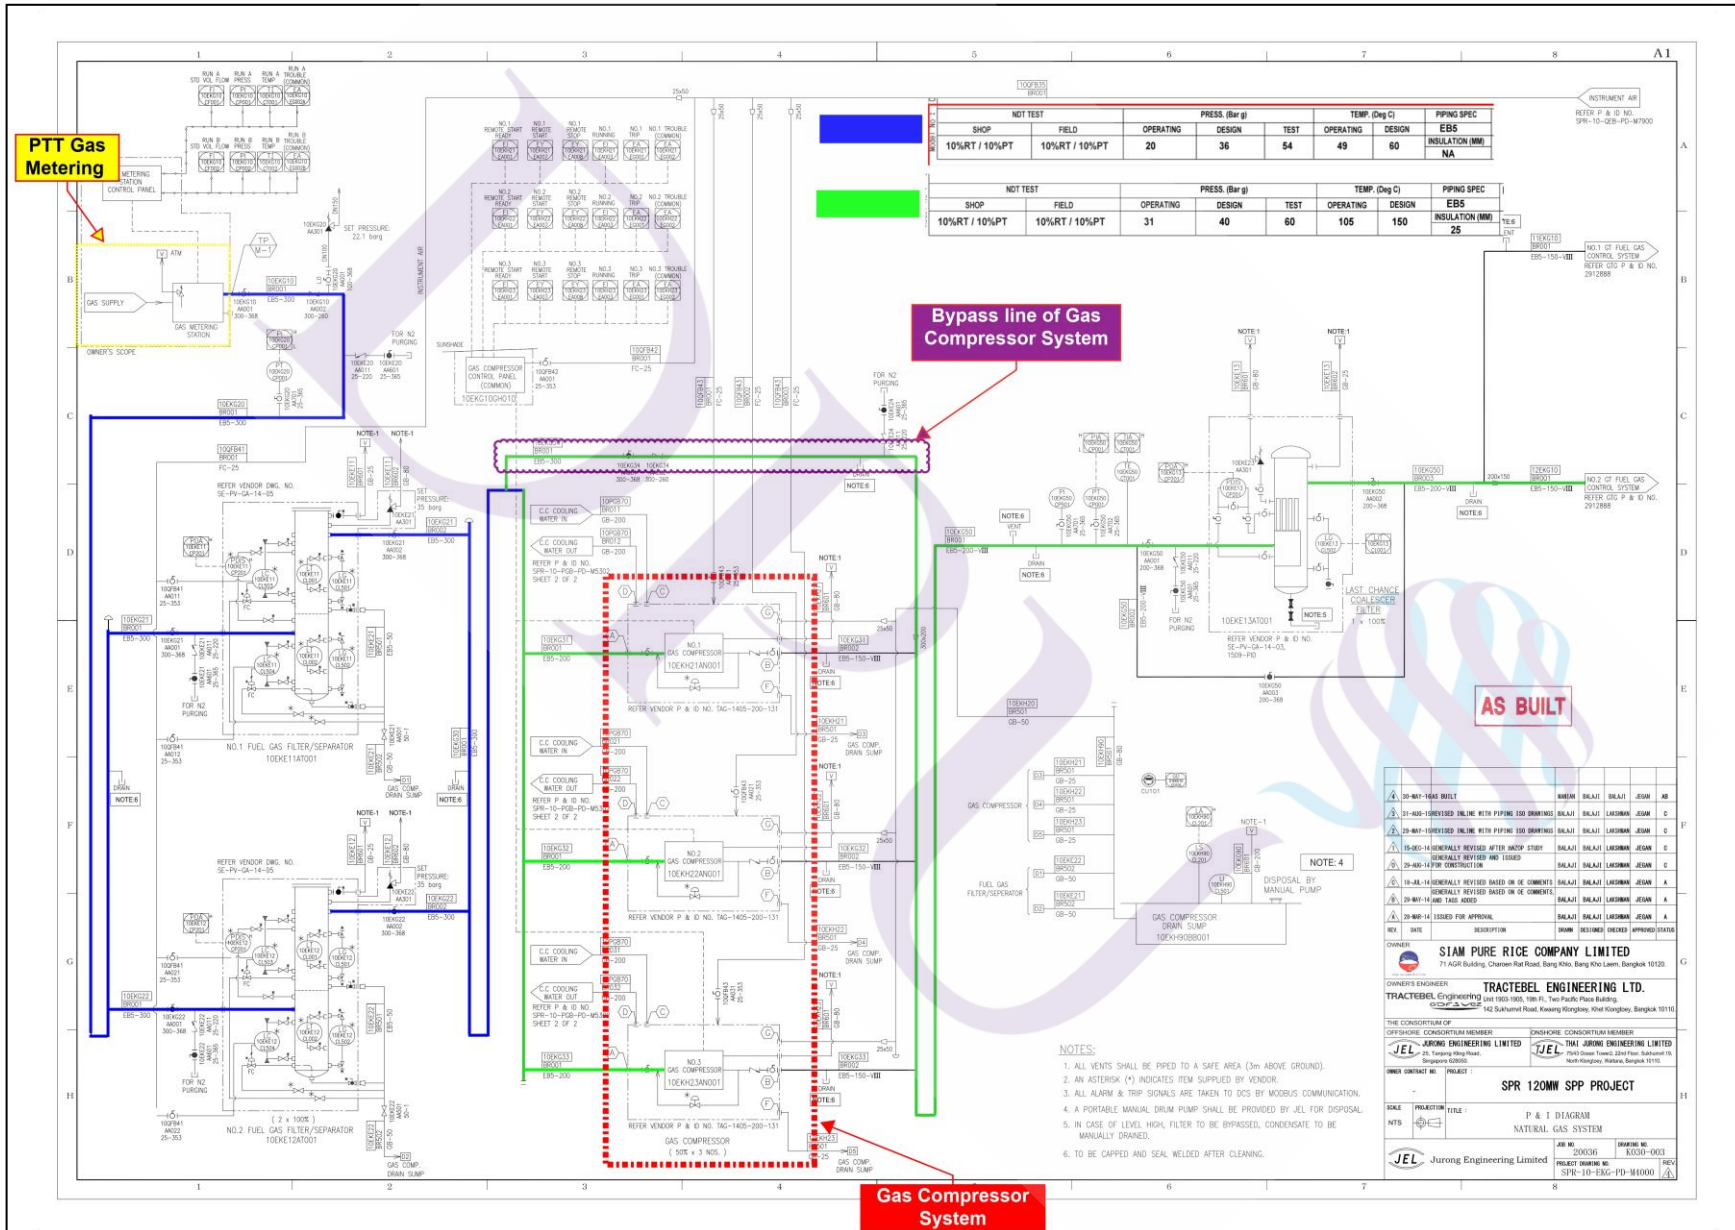

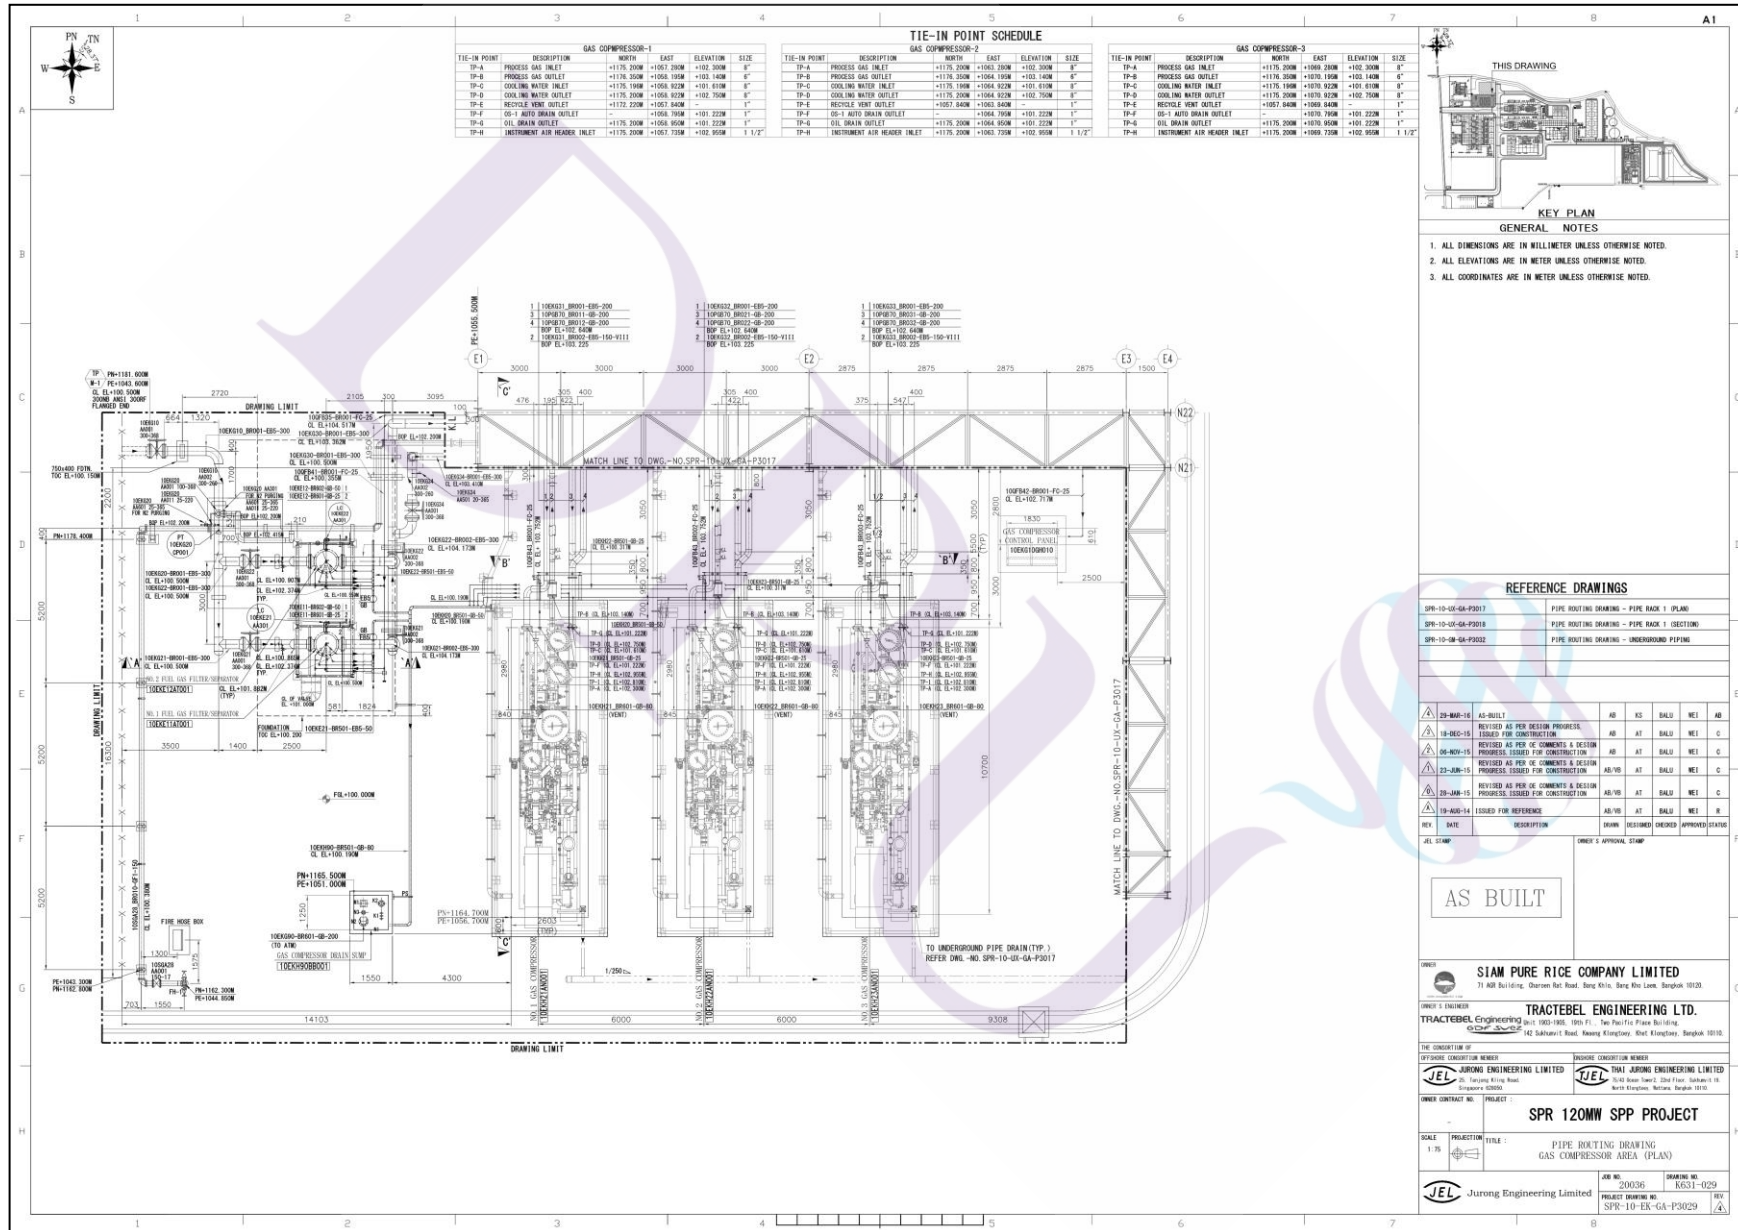

TIE-IN POINT SCHEDULE

GAS COMPRESSOR-1					GAS COMPRESSOR-2					GAS COMPRESSOR-3							
TIE-IN POINT	DESCRIPTION	NORTH	EAST	ELEVATION	SIZE	TIE-IN POINT	DESCRIPTION	NORTH	EAST	ELEVATION	SIZE	TIE-IN POINT	DESCRIPTION	NORTH	EAST	ELEVATION	SIZE

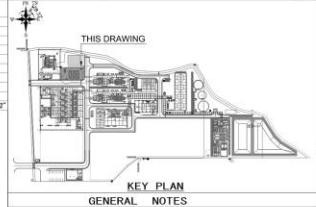

- #### GENERAL NOTES
- ALL DIMENSIONS ARE IN MILLIMETER UNLESS OTHERWISE NOTED.
 - ALL ELEVATIONS ARE IN METER UNLESS OTHERWISE NOTED.
 - ALL COORDINATES ARE IN METER UNLESS OTHERWISE NOTED.

REFERENCE DRAWINGS


NO.	DATE	DESCRIPTION	BY	CHKD	APPROV	REV	

AS BUILT

OWNER
SIAM PURE RICE COMPANY LIMITED




OWNER CONTRACT NO. PROJECT : **SPR 120MW SPP PROJECT**

SCALE 1:75 **PROJECTION** **TITLE** PIPE ROUTING DRAWING GAS COMPRESSOR AREA (PLAN)

JEL Jurong Engineering Limited **JEN** No. 20036 **DRWING NO.** K631-029

PROJECT DRAWING NO. SPR-10-GI-GA-P3029 **REV**

NOTES:

- DESIGN AND CONSTRUCTION SHALL BE IN ACCORDANCE WITH ASME B31.1 LATEST EDITION.
- EACH LONGITUDINAL DIMENSION OF PIPES SHOWS DISTANCE BETWEEN PIPE END(S) AND/ OR WORKING POINT(S).
- DO NOT SCALE THIS DRAWING. USE FIGURE DIMENSIONS ONLY.
- SYMBOLS AND ABBREVIATIONS USED IN THIS DRAWING ARE AS FOLLOWS.

SYMBOL	DESCRIPTION	SYMBOL	DESCRIPTION	SYMBOL	DESCRIPTION	SYMBOL	DESCRIPTION
	FIELD WELD		BLOCK NUMBER		WORKING POINT LEVEL		DIRECTION OF FLUID
	SHOP WELD		INSULATION		SLOPE LINE		SUPPORT POINT

5. DETAIL OF WELDING END GROOVE.


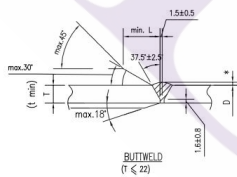


TABLE 127.4.2 REINFORCEMENT OF GIRTH AND LONGITUDINAL BUTT WELDS.


THICKNESS OF BASE METAL, IN. (MM)	MAXIMUM THICKNESS OF REINFORCEMENT FOR DESIGN TEMPERATURE					
	> 750F (400°C)		550F-750F (175°C-400°C)		< 350F (175°C)	
	IN.	MM	IN.	MM	IN.	MM
UP TO 1/8 (3.0), INCL.	1/16	2.0	3/32	2.5	3/16	5.0
OVER 1/8 TO 3/16 (3.0 TO 5.0), INCL.	1/16	2.0	1/8	3.0	3/16	5.0
OVER 3/16 TO 1/2 (5.0 TO 13.0), INCL.	1/16	2.0	5/32	4.0	3/16	5.0
OVER 1/2 TO 1 (13.0 TO 25.0), INCL.	3/32	2.5	3/16	5.0	3/16	5.0
OVER 1 TO 2 (25.0 TO 50.0), INCL.	1/8	3.0	1/4	6.0	1/4	6.0
OVER 2 (50.0)	5/32	4.0	THE GREATER OF 1/4 IN. (6 MM) OR 1/8 TIMES THE WIDTH OF THE WELD IN INCHES (MM)			

* - REFER TO TABLE 127.4.2

6. FLANGE HOLE ORIENTATION, BOLT HOLES SHALL BE STRADDLED TO VERTICAL/HORIZONTAL CENTERLINE OF PIPE UNLESS OTHERWISE STATED.

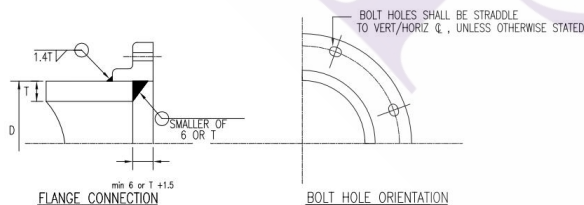

7. DETAIL OF SOCKET WELD JOINT AND BOSS CONNECTION.

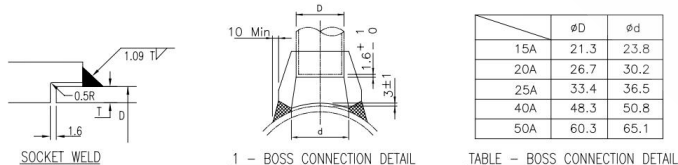

	ØD	Ød
15A	21.3	23.8
20A	26.7	30.2
25A	33.4	36.5
40A	48.3	50.8
50A	60.3	65.1

8. REFERENCE DRAWING

- PIPE MATERIAL SPECIFICATION : SPR-10-AAA-SP-P9001
- PAINTING SPECIFICATION : SPR-10-AAA-SP-P9003
- OVERALL PLANT LAYOUT : SPR-10-UDA-GA-P1001
- PIPING GA PLAN & SECTION GAS COMPRESSOR AREA : SPR-10-EK-GA-P3029
- PIPING GA PLAN & SECTION PIPE RACK-1 : SPR-10-UX-GA-P3017
- PIPING GA PLAN & SECTION PIPE RACK-2 : SPR-10-UX-GA-P3020
- PIPING GA PLAN & SECTION HRSG #11 : SPR-10-HA-GA-P3005
- PIPING GA PLAN & SECTION HRSG #12 : SPR-10-HA-GA-P3006
- P & ID NATURAL GAS SYSTEM : SPR-10-EKG-PD-M4000

9. NOTES TO FABRICATOR/VENDOR

PIPE LENGTH SHOWN IN THE ISOMETRIC DWG IS ONLY INDICATIVE, VENDOR TO SUPPLY AS PER AVAILABILITY OF LONGER PIPE LENGTHS.

10. SUPPORT LEGEND:

- RS = REST SUPPORT LS = LIMIT STOP
- AD = ADJ SUPPORT GS = GUIDE SUPPORT
- AS = ANCHOR SUPPORT
- SP, S = SPRING SUPPORT
- SP, SS = SPECIAL SUPPORT

29-MAR-16	AS BUILT	AB	VRB	BALU	WEI	AB	
20-JUN-15	REVISED AS PER OE COMMENTS & DESIGN PROGRESS. ISSUED FOR CONSTRUCTION.	PP/AB	YG	BALU	WEI	C	
25-FEB-15	REVISED AS PER OE COMMENTS ISSUED FOR CONSTRUCTION	PP	YG	BALU	WEI	C	
05-NOV-14	ISSUED FOR APPROVAL	SPD	AT	BALU	WEI	R	
REV.	DATE	DESCRIPTION	DRAWN	DESIGNED	CHECKED	APPROVED	STATUS
JEL STAMP			OWNER'S APPROVAL STAMP				
AS BUILT							
OWNER SIAM PURE RICE COMPANY LIMITED 71 AGR Building, Charoen Rat Road, Bang Khle, Bang Koo Laem, Bangkok 10120.							
OWNER'S ENGINEER TRACTEBEL ENGINEERING LTD. Unit 1903-1905, 19th Fl., Two Pacific Place Building, 42 Sukhumvit Road, Kwaeng Klongtoey, Khet Klongtoey, Bangkok 10110.							
THE CONSORTIUM OF OFFSHORE CONSORTIUM MEMBER JURONG ENGINEERING LIMITED 25, Tanjong Kling Road, Singapore 628050.							
ONSHORE CONSORTIUM MEMBER THAI JURONG ENGINEERING LIMITED 154/3 Ocean Tower 2, 25th Floor, Sukhumvit 19, North Klongtoey, Wattana, Bangkok 10110.							
OWNER CONTRACT NO.		PROJECT :					
		SPR 120MW SPP PROJECT					
SCALE	PROJECTION	TITLE :					
NTS		ISOMETRIC DRAWING FOR PIPING NATURAL GAS SYSTEM					
Jurong Engineering Limited		JOB NO.	DRAWING NO.		REV		
		20036	X651-018				
		PROJECT DRAWING NO.		SPR-10-EK-PI-P4018			


25 Lines

INDEX SHEET								
SHT No.	LINE NO.	TRAIN NO	TOTAL NO OF TRAINS	REVISION DATE				REMARKS
				A	0	1	2	
1	COVER PAGE/FAB. NOTES			5-Nov-14	14-Feb-15		29-Mar-16	
2	INDEX SHT / VALVES SUMMARY			5-Nov-14	14-Feb-15		29-Mar-16	
3	MATERIAL SUMMARY		2	5-Nov-14	14-Feb-15		29-Mar-16	
4	10EKG10-BR001-EB5-300	TRAIN-01	1	5-Nov-14	14-Feb-15	20-Jun-15	29-Mar-16	
5	10EKG20-BR001-EB5-300	TRAIN-01	2	5-Nov-14	14-Feb-15	20-Jun-15	29-Mar-16	
6	10EKG20-BR001-EB5-300	TRAIN-02	2	5-Nov-14	14-Feb-15		29-Mar-16	
7	10EKG22-BR001-EB5-300	TRAIN-01	1	5-Nov-14	14-Feb-15		29-Mar-16	
8	10EKG21-BR001-EB5-300	TRAIN-01	1	5-Nov-14	14-Feb-15		29-Mar-16	
9	10EKG21-BR002-EB5-300	TRAIN-01	1	5-Nov-14	14-Feb-15		29-Mar-16	
10	10EKG22-BR002-EB5-300	TRAIN-01	1	5-Nov-14	14-Feb-15		29-Mar-16	
11	10EKG30-BR001-EB5-300	TRAIN-01	2	5-Nov-14	14-Feb-15		29-Mar-16	
12	10EKG30-BR001-EB5-300	TRAIN-02	2	5-Nov-14	14-Feb-15	20-Jun-15	29-Mar-16	
13	10EKG34-BR001-EB5-300	TRAIN-01	1	5-Nov-14	14-Feb-15		29-Mar-16	
14	10EKG31-BR001-EB5-200	TRAIN-01	1	5-Nov-14	14-Feb-15	20-Jun-15	29-Mar-16	
15	10EKG32-BR001-EB5-200	TRAIN-01	1	5-Nov-14	14-Feb-15	20-Jun-15	29-Mar-16	
16	10EKG33-BR001-EB5-200	TRAIN-01	1	5-Nov-14	14-Feb-15	20-Jun-15	29-Mar-16	
17	10EKG31-BR002-EB5-150-VIII	TRAIN-01	1	5-Nov-14	14-Feb-15	20-Jun-15	29-Mar-16	
18	10EKG32-BR002-EB5-150-VIII	TRAIN-01	1	5-Nov-14	14-Feb-15	20-Jun-15	29-Mar-16	
19	10EKG33-BR002-EB5-150-VIII	TRAIN-01	1	5-Nov-14	14-Feb-15	20-Jun-15	29-Mar-16	
20	10EKG40-BR001-EB5-200-VIII	TRAIN-01	1	5-Nov-14	14-Feb-15		29-Mar-16	
21	10EKG50-BR001-EB5-200-VIII	TRAIN-01	5	5-Nov-14	14-Feb-15		29-Mar-16	
22	10EKG50-BR001-EB5-200-VIII	TRAIN-02	5	5-Nov-14	14-Feb-15	20-Jun-15	29-Mar-16	
23	10EKG50-BR001-EB5-200-VIII	TRAIN-03	5	5-Nov-14	14-Feb-15	20-Jun-15	29-Mar-16	
24	10EKG50-BR001-EB5-200-VIII	TRAIN-04	5	5-Nov-14	14-Feb-15	20-Jun-15	29-Mar-16	
25	10EKG50-BR001-EB5-200-VIII	TRAIN-05	5	5-Nov-14	14-Feb-15	20-Jun-15	29-Mar-16	
26	11EKG10-BR002-EB5-200	TRAIN-01	1	5-Nov-14	14-Feb-15	20-Jun-15	29-Mar-16	
27	12EKG10-BR001-EB5-150-VIII	TRAIN-01	4	5-Nov-14	14-Feb-15	20-Jun-15	29-Mar-16	
28	12EKG10-BR001-EB5-150-VIII	TRAIN-02	4	5-Nov-14	14-Feb-15	20-Jun-15	29-Mar-16	
29	12EKG10-BR001-EB5-150-VIII	TRAIN-03	4	5-Nov-14	14-Feb-15	20-Jun-15	29-Mar-16	
30	12EKG10-BR001-EB5-150-VIII	TRAIN-04	4	5-Nov-14	14-Feb-15	20-Jun-15	29-Mar-16	
31	11EKG10-BR001-EB5-150-VIII	TRAIN-01	4		14-Feb-15		29-Mar-16	
32	11EKG10-BR001-EB5-150-VIII	TRAIN-02	4		14-Feb-15		29-Mar-16	
33	11EKG10-BR001-EB5-150-VIII	TRAIN-03	4		14-Feb-15	20-Jun-15	29-Mar-16	
34	11EKG10-BR001-EB5-150-VIII	TRAIN-04	4		14-Feb-15	20-Jun-15	29-Mar-16	
35	10EKE21-BR501-EB5-50	TRAIN-01	5		14-Feb-15		29-Mar-16	
36	10EKE21-BR501-EB5-50	TRAIN-02	5		14-Feb-15		29-Mar-16	
37	10EKE21-BR501-EB5-50	TRAIN-03	5		14-Feb-15		29-Mar-16	
38	10EKE21-BR501-EB5-50	TRAIN-04	5		14-Feb-15		29-Mar-16	
39	10EKE21-BR501-EB5-50	TRAIN-05	5		14-Feb-15		29-Mar-16	
40	10EKE21-BR502-GB-50	TRAIN-01	5		14-Feb-15		29-Mar-16	
41	10EKE22-BR501-EB5-50	TRAIN-01	5		14-Feb-15		29-Mar-16	
42	10EKE22-BR501-EB5-50	TRAIN-02	5		14-Feb-15		29-Mar-16	
43	10EKE22-BR501-EB5-50	TRAIN-03	5		14-Feb-15		29-Mar-16	
44	10EKE22-BR501-EB5-50	TRAIN-04	5		14-Feb-15		29-Mar-16	
45	10EKE22-BR501-EB5-50	TRAIN-05	5		14-Feb-15		29-Mar-16	
46	10EKE22-BR502-GB-50	TRAIN-01	1		26-Feb-15		29-Mar-16	

INDEX SHEET								
SHT No.	LINE NO.	TRAIN NO	TOTAL NO OF TRAINS	REVISION DATE				REMARKS
				A	0	1	2	
47	10EKH90-BR501-GB-80	TRAIN-01	1		14-Feb-15	20-Jun-15	29-Mar-16	
48	10EKH21-BR501-GB-25	TRAIN-01	1		14-Feb-15	20-Jun-15	29-Mar-16	
49	10EKH22-BR501-GB-25	TRAIN-01	1		14-Feb-15	20-Jun-15	29-Mar-16	
50	10EKH23-BR501-GB-25	TRAIN-01	2		14-Feb-15	20-Jun-15	29-Mar-16	
51	10EKH23-BR501-GB-25	TRAIN-02	2		14-Feb-15	20-Jun-15	29-Mar-16	
52	10EKE11-BR801-GB-25	TRAIN-01	2		14-Feb-15		29-Mar-16	
53	10EKE11-BR802-GB-50	TRAIN-02	2		14-Feb-15		29-Mar-16	
54	10EKE12-BR801-GB-25	TRAIN-01	2		14-Feb-15		29-Mar-16	
55	10EKE12-BR802-GB-50	TRAIN-02	2		14-Feb-15		29-Mar-16	
56	10EKH21-BR801-GB-80	TRAIN-01	1		14-Feb-15		29-Mar-16	
57	10EKH22-BR801-GB-80	TRAIN-01	1		14-Feb-15		29-Mar-16	
58	10EKH23-BR801-GB-80	TRAIN-01	1		14-Feb-15		29-Mar-16	
59	10EKH20-BR501-GB-50	TRAIN-01	1				29-Mar-16	

VALVES SUMMARY							
SPEC NO	DESCRIPTION	SIZE	QTY				REMARKS
			0	1	2	3	
220	SWING CHECK VALVE CL 800 SW	25	5	5			
368	BALL VALVE CL 300 FLG	300	6	6			
420	GLOBE VALVE CL 800 SW	25	4	4			
368	BALL VALVE CL 300 FLG	100	1	1			
42	GATE VALVE CL 800 SW	25	4	4			
368	BALL VALVE CL 300 FLG	200	3	3			
1	GATE VALVE CL 300 BW	50	2	2			
365	BALL VALVE 1100 psi SW	25	8	8			
260	SWING CHECK VALVE CL 300 BW	300	2	2			
365	BALL VALVE 1100 psi SW	20	19	10			

MATERIAL SUMMARY							
S No.	DESCRIPTION	SIZE (mm)	QTY [(Pipe=Meters) (Fittings=Pcs)]				REMARKS
			0	1	2	3	
1	PIPE ERW S-80 ASTM A53 GR B PBE	25	36.0	36.0			
2	PIPE SMLS S-40 ASTM A106 GR B BBE	50	9.4	9.4			
3	PIPE SMLS S-40 ASTM A106 GR B BBE	200	139.3	135.76			
4	PIPE SMLS S-40 ASTM A106 GR B BBE	100	0.3	0.33			
5	PIPE SMLS S-40 ASTM A106 GR B BBE	150	132.0	129.69			
6	PIPE SMLS S-80 ASTM A106 GR B PBE	25	34.2	34.2			
7	PIPE SMLS S-STD ASTM A106 GR B BBE	300	42.1	42.11			
8	PIPE SMLS S-40 ASTM A106 GR B BBE	80	0.3	0.3			
9	PIPE SMLS S-80 ASTM A106 GR B PBE	20	4	2.3			
10	PIPE ERW S-40 ASTM A53 GR B BBE	80	11	11.3			
11	PIPE ERW S-40 ASTM A53 GR B BBE	50	4	4			
12	45 EL LR CL 3000 ASTM A105 SW	25	2	3			
13	45 EL LR ERW S-40 ASTM A234 WPB BW	80	2	2			
14	45 EL LR SMLS S-40 ASTM A234 WPB BW	200	5	0			
15	45 EL LR SMLS S-40 ASTM A234 WPB BW	150	8	6			
16	90 EL LR SMLS S-40 ASTM A234 WPB BW	150	22	24			
17	90 EL LR CL 3000 ASTM A105 SW	25	45	45			
18	90 EL LR SMLS S-40 ASTM A234 WPB BW	200	23	31			
19	90 EL LR ERW S-40 ASTM A234 WPB BW	50	2	2			
20	90 EL LR CL 3000 ASTM A105 SW	20	6	3			
21	90 EL LR SMLS S-40 ASTM A234 WPB BW	50	4	4			
22	90 EL LR SMLS S-STD ASTM A234 WPB BW	300	11	11			
23	90 EL LR ERW S-40 ASTM A234 WPB BW	80	5	5			
24	90 EL LR SMLS S-40 ASTM A234 WPB BW	80	2	2			
25	TEE EQUAL S-STD ASTM A234 WPB BW	300	5	5			
26	TEE EQUAL S-40 ASTM A234 WPB BW	200	3	3			
27	TEE EQUAL CL3000 ASTM A105 SW	25	2	2			
28	TEE REDUCING S-40 x S-40 ASTM A234 WPB BW	80X50	2	2			
29	TEE REDUCING S-STD x S-40 ASTM A234 WPB BW	300X200	3	3			
30	TEE REDUCING S-40 x S-40 ASTM A234 WPB BW	200X150	2	3			
31	TEE REDUCING S-40 x ASTM A234 WPB BW	200X150	1	0			
32	TEE REDUCING S-40 x NREQD ASTM A234 WPB BW	50X25	8	8			
33	REDUCER ECC S-40 x S-40 bore ASTM A234 WPB BW	200X150	2	2			
34	REDUCER CONC S-40 x S-80 bore ASTM A234 WPB BW	50X25	3	3			
35	REDUCER CONC S-40 x S-40 bore ASTM A234 WPB BW	150X80	2	2			
36	REDUCER CONC S-40 x S-40 bore ASTM A234 WPB BW	80X50	3	3			
37	REDUCER CONC S-STD x S-40 bore ASTM A234 WPB BW	300X200	1	1			
38	SOCKOLET CL 3000 ASTM A105	200X20	9	3			
39	SOCKOLET CL 3000 ASTM A105	150X20	7	4			
40	SOCKOLET CL 3000 ASTM A105	80X25	1	1			
41	SOCKOLET CL 3000 ASTM A105	300X25	5	5			
42	SOCKOLET CL 3000 ASTM A105	300X20	3	3			
43	SOCKOLET CL 3000 ASTM A105	200X25	3	3			
44	SOCKOLET CL 3000 ASTM A105	200x32	0	1			
45	THREDOLET CL 2000 ASTM A105	200X20	1	0			
46	WELDOLET S-STD x S-40 ASTM A105	300X100	1	1			

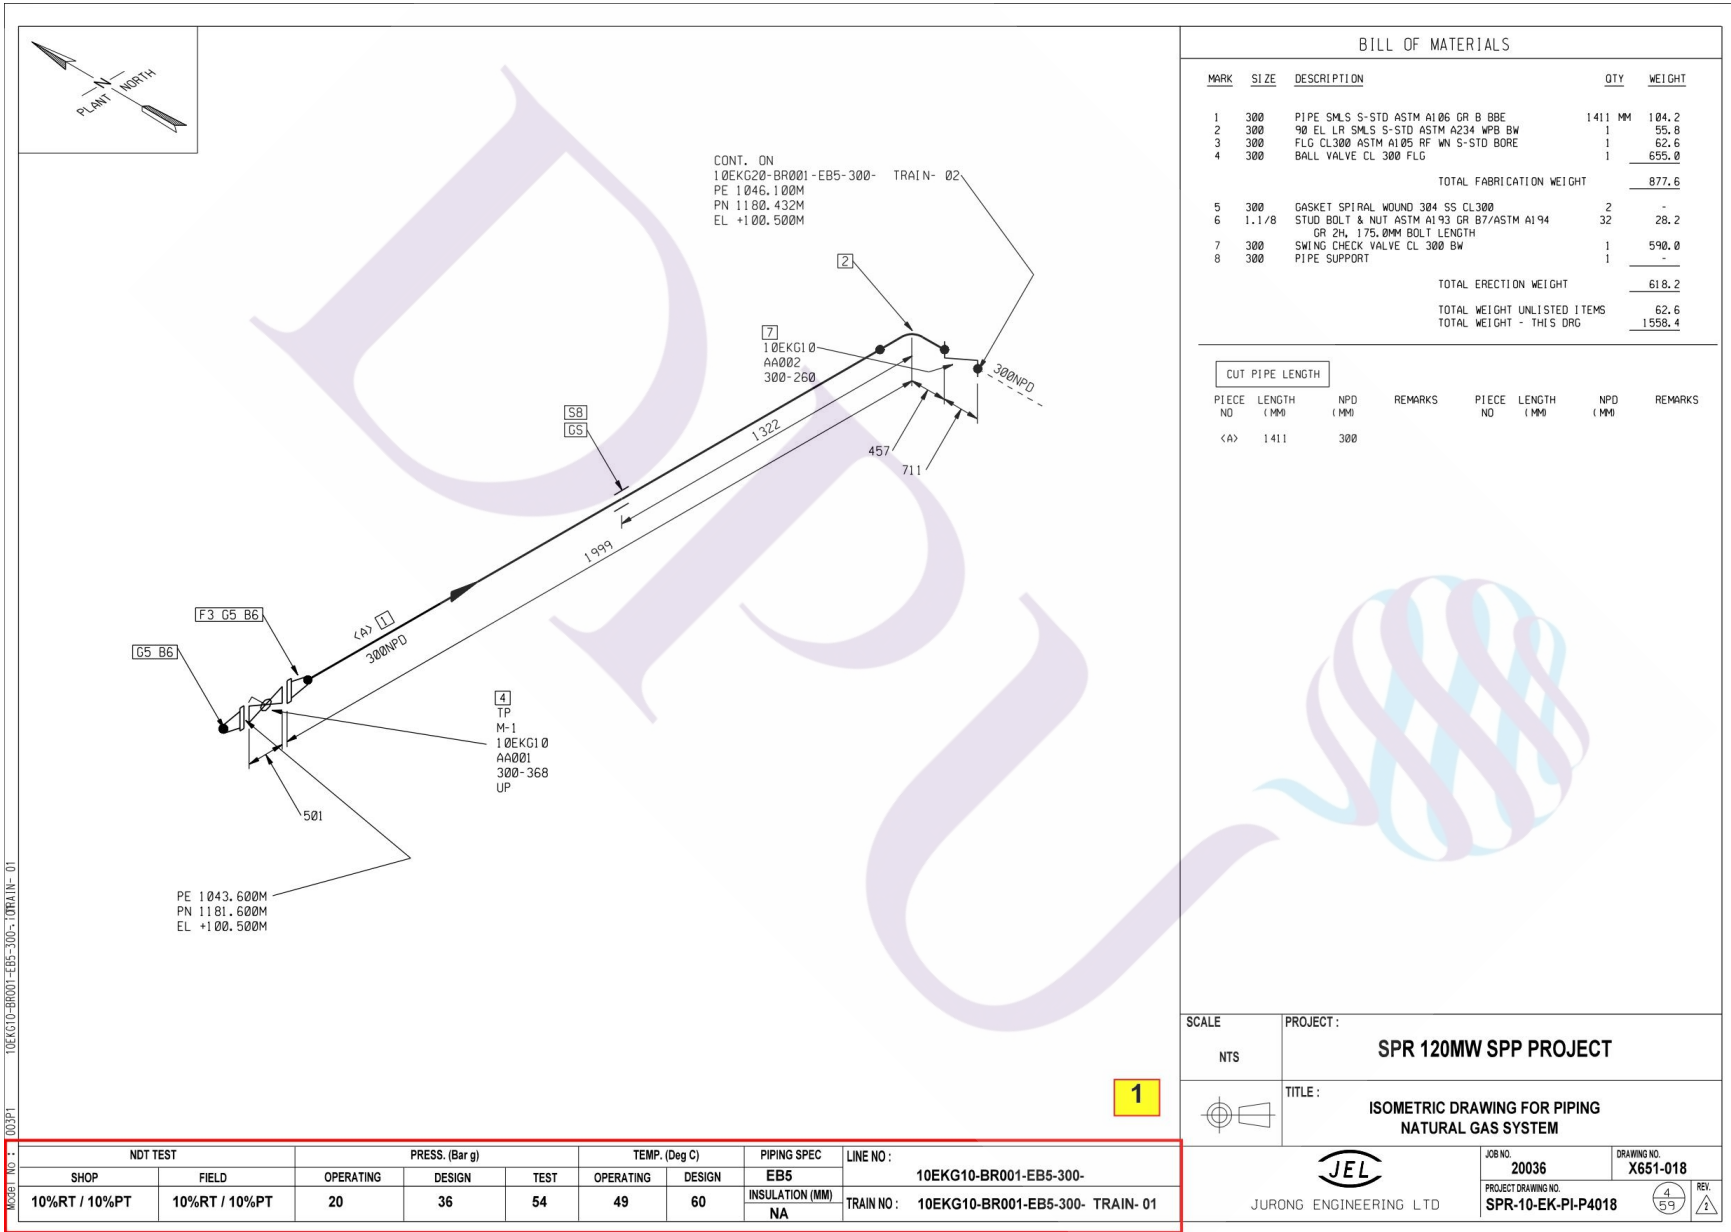

BILL OF MATERIALS

MARK	SIZE	DESCRIPTION	QTY	WEIGHT
1	300	PIPE SMLS S-STD ASTM A106 GR B BBE	1411 MM	104.2
2	300	90 EL LR SMLS S-STD ASTM A234 WPB BW	1	55.8
3	300	FLG CL300 ASTM A105 RF WN S-STD BORE	1	62.6
4	300	BALL VALVE CL 300 FLG	1	655.0
TOTAL FABRICATION WEIGHT				877.6
5	300	GASKET SPIRAL WOUND 304 SS CL300	2	-
6	1.1/8	STUD BOLT & NUT ASTM A193 GR B7/ASTM A194 GR 2H, 175.0MM BOLT LENGTH	32	28.2
7	300	SWING CHECK VALVE CL 300 BW	1	590.0
8	300	PIPE SUPPORT	1	-
TOTAL ERECTION WEIGHT				618.2
TOTAL WEIGHT UNLISTED ITEMS				62.6
TOTAL WEIGHT - THIS DRG				1558.4

CUT PIPE LENGTH

PIECE NO	LENGTH (MM)	NPD (MM)	REMARKS	PIECE NO	LENGTH (MM)	NPD (MM)	REMARKS
<A>	1411	300					

SCALE: NTS PROJECT: **SPR 120MW SPP PROJECT**

TITLE: **ISOMETRIC DRAWING FOR PIPING NATURAL GAS SYSTEM**

JEL
JURONG ENGINEERING LTD

JOB NO: **20036** DRAWING NO: **X651-018**


PROJECT DRAWING NO: **SPR-10-EK-PI-P4018**

REV. 4/59

NDT TEST		PRESS. (Bar g)			TEMP. (Deg C)		PIPING SPEC	LINE NO :
SHOP	FIELD	OPERATING	DESIGN	TEST	OPERATING	DESIGN	EB5	10EKG10-BR001-EB5-300-
10%RT / 10%PT	10%RT / 10%PT	20	36	54	49	60	INSULATION (MM) NA	TRAIN NO : 10EKG10-BR001-EB5-300- TRAIN- 01

MODEL NO : 003PT 10EKG10-BR001-EB5-300- TRAIN- 01

1

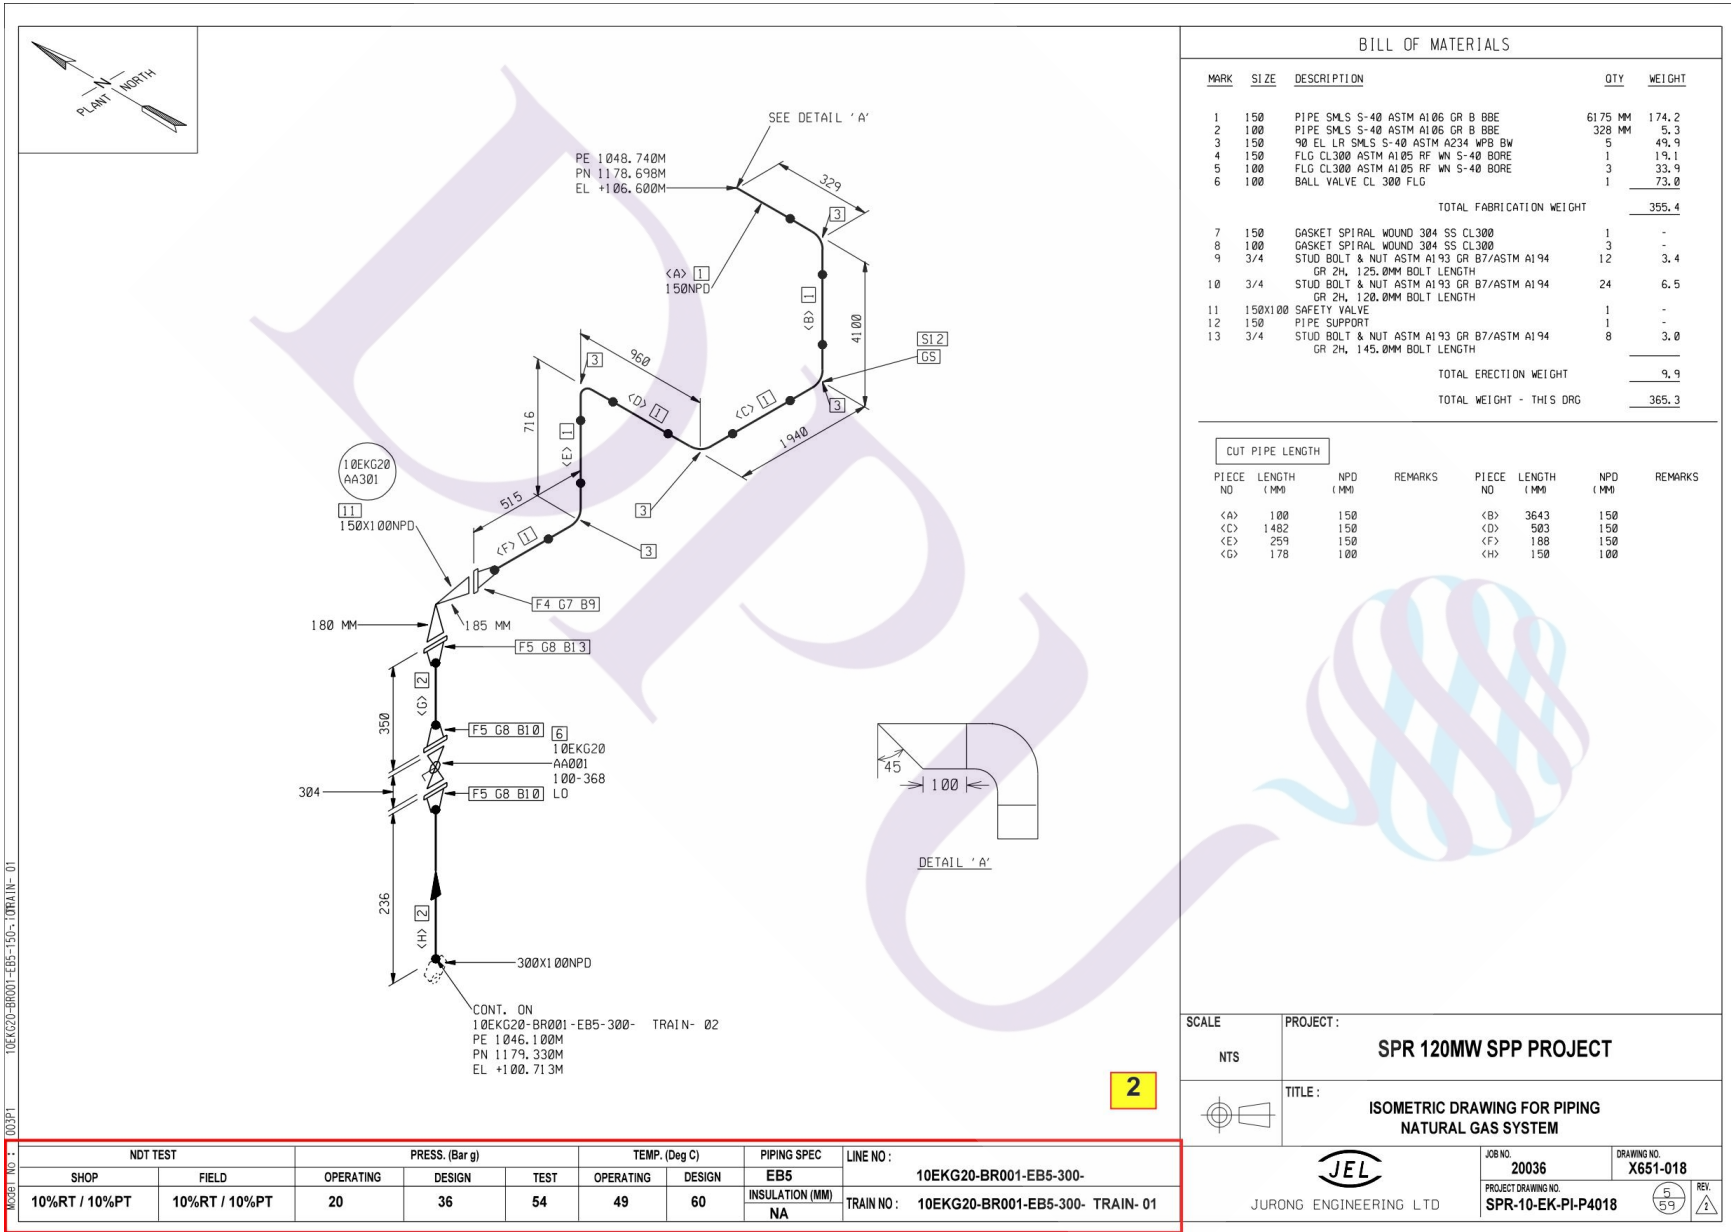

BILL OF MATERIALS

MARK	SIZE	DESCRIPTION	QTY	WEIGHT
1	150	PIPE SMLS S-40 ASTM A106 GR B BBE	6175 MM	174.2
2	100	PIPE SMLS S-40 ASTM A106 GR B BBE	328 MM	5.3
3	150	90 EL L/R SMLS S-40 ASTM A234 WPB BW	5	49.9
4	150	FLG CL300 ASTM A105 RF WN S-40 BORE	1	19.1
5	100	FLG CL300 ASTM A105 RF WN S-40 BORE	3	33.9
6	100	BALL VALVE CL 300 FLG	1	73.0
TOTAL FABRICATION WEIGHT				355.4
7	150	GASKET SPIRAL WOUND 304 SS CL300	1	-
8	100	GASKET SPIRAL WOUND 304 SS CL300	3	-
9	3/4	STUD BOLT & NUT ASTM A193 GR B7/ASTM A194	12	3.4
10	3/4	STUD BOLT & NUT ASTM A193 GR B7/ASTM A194 GR 2H, 125.0MM BOLT LENGTH	24	6.5
11	150X100	SAFETY VALVE	1	-
12	150	PIPE SUPPORT	1	-
13	3/4	STUD BOLT & NUT ASTM A193 GR B7/ASTM A194 GR 2H, 145.0MM BOLT LENGTH	8	3.0
TOTAL ERECTION WEIGHT				9.9
TOTAL WEIGHT - THIS DRG				365.3

CUT PIPE LENGTH

PIECE NO	LENGTH (MM)	NPD (MM)	REMARKS	PIECE NO	LENGTH (MM)	NPD (MM)	REMARKS
<A>	100	150			3643	150	
<C>	1482	150		<D>	503	150	
<E>	259	150		<F>	188	150	
<G>	178	100		<H>	150	100	

SCALE: NTS

PROJECT: **SPR 120MW SPP PROJECT**

TITLE: **ISOMETRIC DRAWING FOR PIPING NATURAL GAS SYSTEM**

JEL

JURONG ENGINEERING LTD

JOB NO. 20036

DRAWING NO. X651-018


PROJECT DRAWING NO. SPR-10-EK-PI-P4018

REV. 5/59

MODEL NO.: 003PT 10EKG20-BR001-EB5-150-TRAIN-01

NDT TEST		PRESS. (Bar g)			TEMP. (Deg C)		PIPING SPEC	LINE NO :
SHOP	FIELD	OPERATING	DESIGN	TEST	OPERATING	DESIGN	EB5	10EKG20-BR001-EB5-300-
10%RT / 10%PT	10%RT / 10%PT	20	36	54	49	60	INSULATION (MM) NA	TRAIN NO: 10EKG20-BR001-EB5-300- TRAIN- 01

2

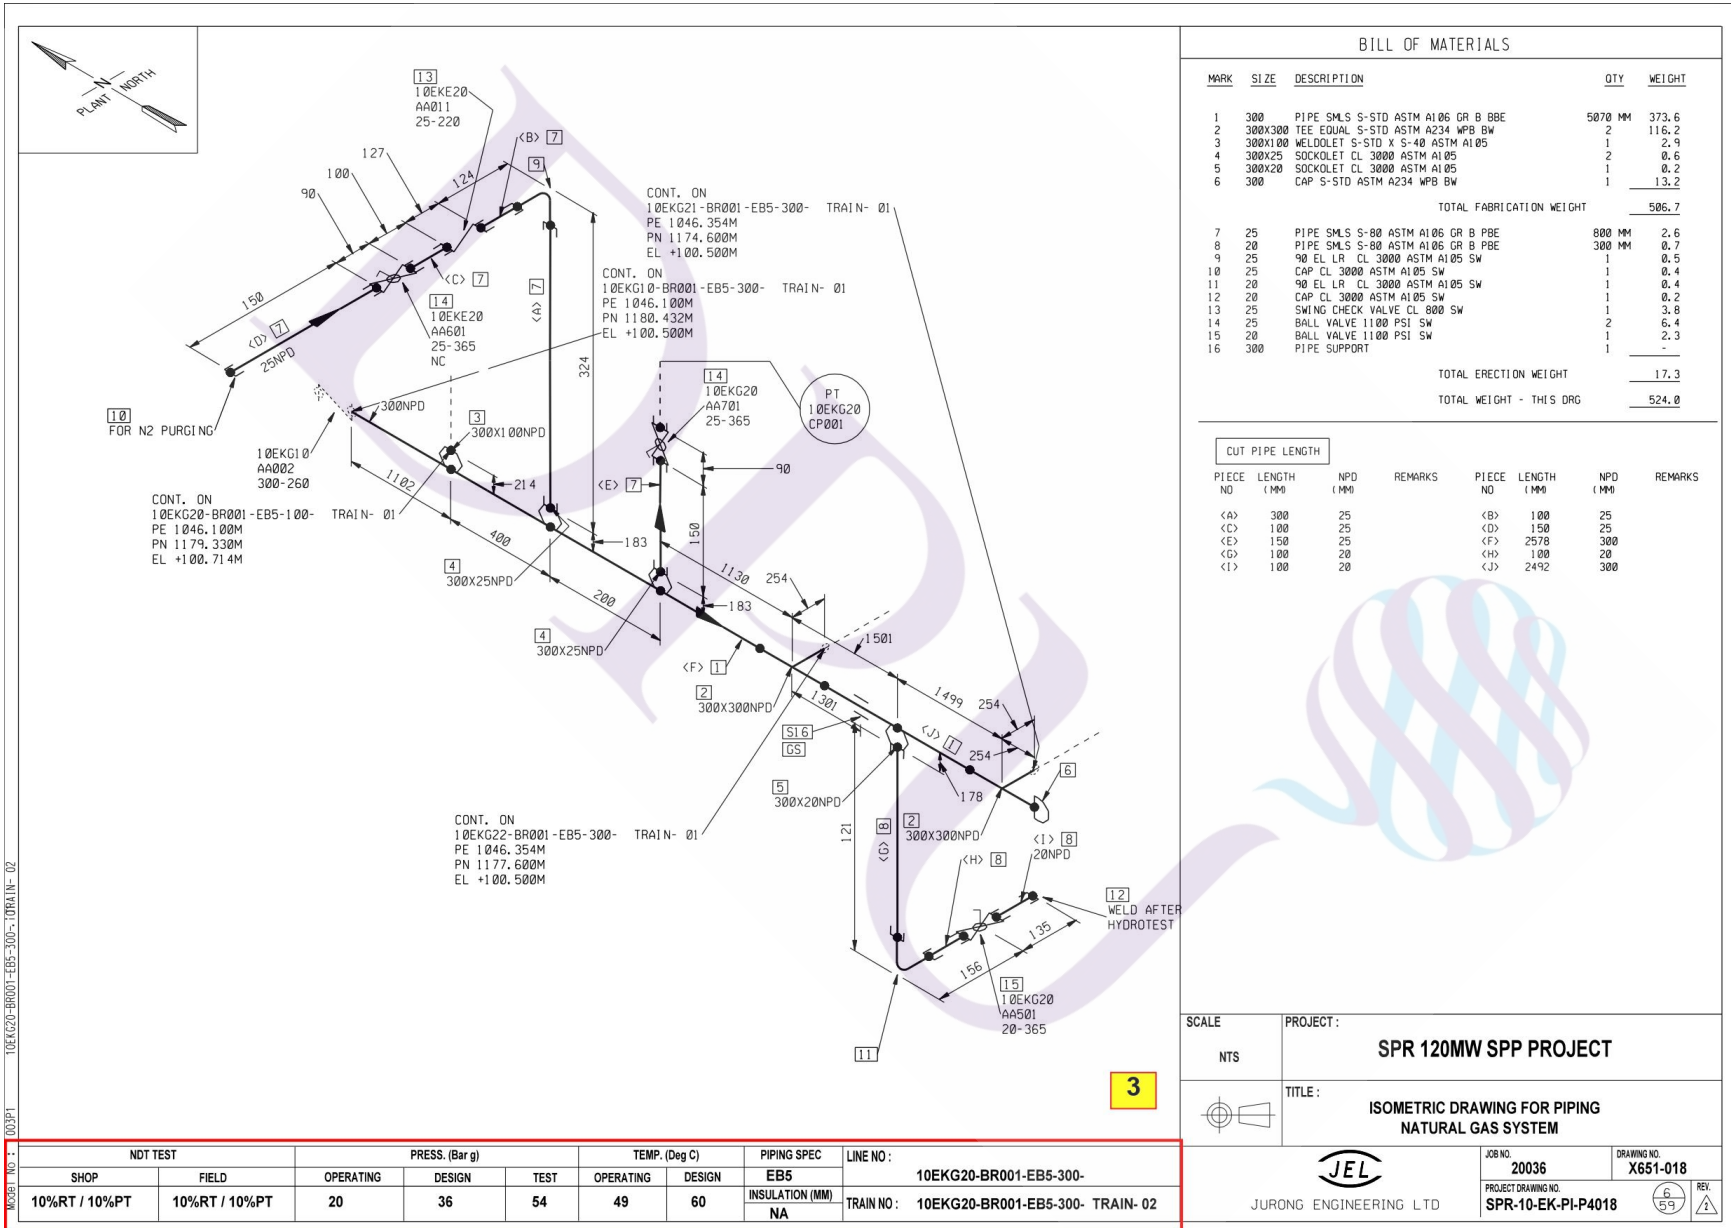

BILL OF MATERIALS

MARK	SIZE	DESCRIPTION	QTY	WEIGHT
1	300	PIPE SMLS S-STD ASTM A106 GR B BBE	5070 MM	373.6
2	300X300	TEE EQUAL S-STD ASTM A234 WPB BW	2	116.2
3	300X100	WELDOLET S-STD X S-40 ASTM A105	1	2.9
4	300X25	SOCKOLET CL 3000 ASTM A105	2	0.6
5	300X20	SOCKOLET CL 3000 ASTM A105	1	0.2
6	300	CAP S-STD ASTM A234 WPB BW	1	13.2
7	25	PIPE SMLS S-80 ASTM A106 GR B PBE	800 MM	2.6
8	20	PIPE SMLS S-80 ASTM A106 GR B PBE	300 MM	0.7
9	25	90 EL LR CL 3000 ASTM A105 SW	1	0.5
10	25	CAP CL 3000 ASTM A105 SW	1	0.4
11	20	90 EL LR CL 3000 ASTM A105 SW	1	0.4
12	20	CAP CL 3000 ASTM A105 SW	1	0.2
13	25	SWING CHECK VALVE CL 800 SW	1	3.8
14	25	BALL VALVE 1100 PSI SW	2	6.4
15	20	BALL VALVE 1100 PSI SW	1	2.3
16	300	PIPE SUPPORT	1	-
TOTAL ERECTION WEIGHT				17.3
TOTAL WEIGHT - THIS DRG				524.0

CUT PIPE LENGTH

PIECE NO	LENGTH (MM)	NPD (MM)	REMARKS	PIECE NO	LENGTH (MM)	NPD (MM)	REMARKS
<A>	300	25			100	25	
<C>	100	25		<D>	150	25	
<E>	150	25		<F>	2578	300	
<G>	100	20		<H>	100	20	
<I>	100	20		<J>	2492	300	

SCALE: NTS PROJECT: SPR 120MW SPP PROJECT

TITLE: ISOMETRIC DRAWING FOR PIPING NATURAL GAS SYSTEM

JEL JURONG ENGINEERING LTD


JOB NO. 20036 DRAWING NO. X651-018

PROJECT DRAWING NO. SPR-10-EK-PI-P4018

REV. 6/59

MODEL NO.: 10EKG20-BR001-EB5-300- TRAIN- 02

NDT TEST		PRESS. (Bar g)			TEMP. (Deg C)		PIPING SPEC	LINE NO :
SHOP	FIELD	OPERATING	DESIGN	TEST	OPERATING	DESIGN	EB5	10EKG20-BR001-EB5-300-
10%RT / 10%PT	10%RT / 10%PT	20	36	54	49	60	INSULATION (MM) NA	TRAIN NO: 10EKG20-BR001-EB5-300- TRAIN- 02

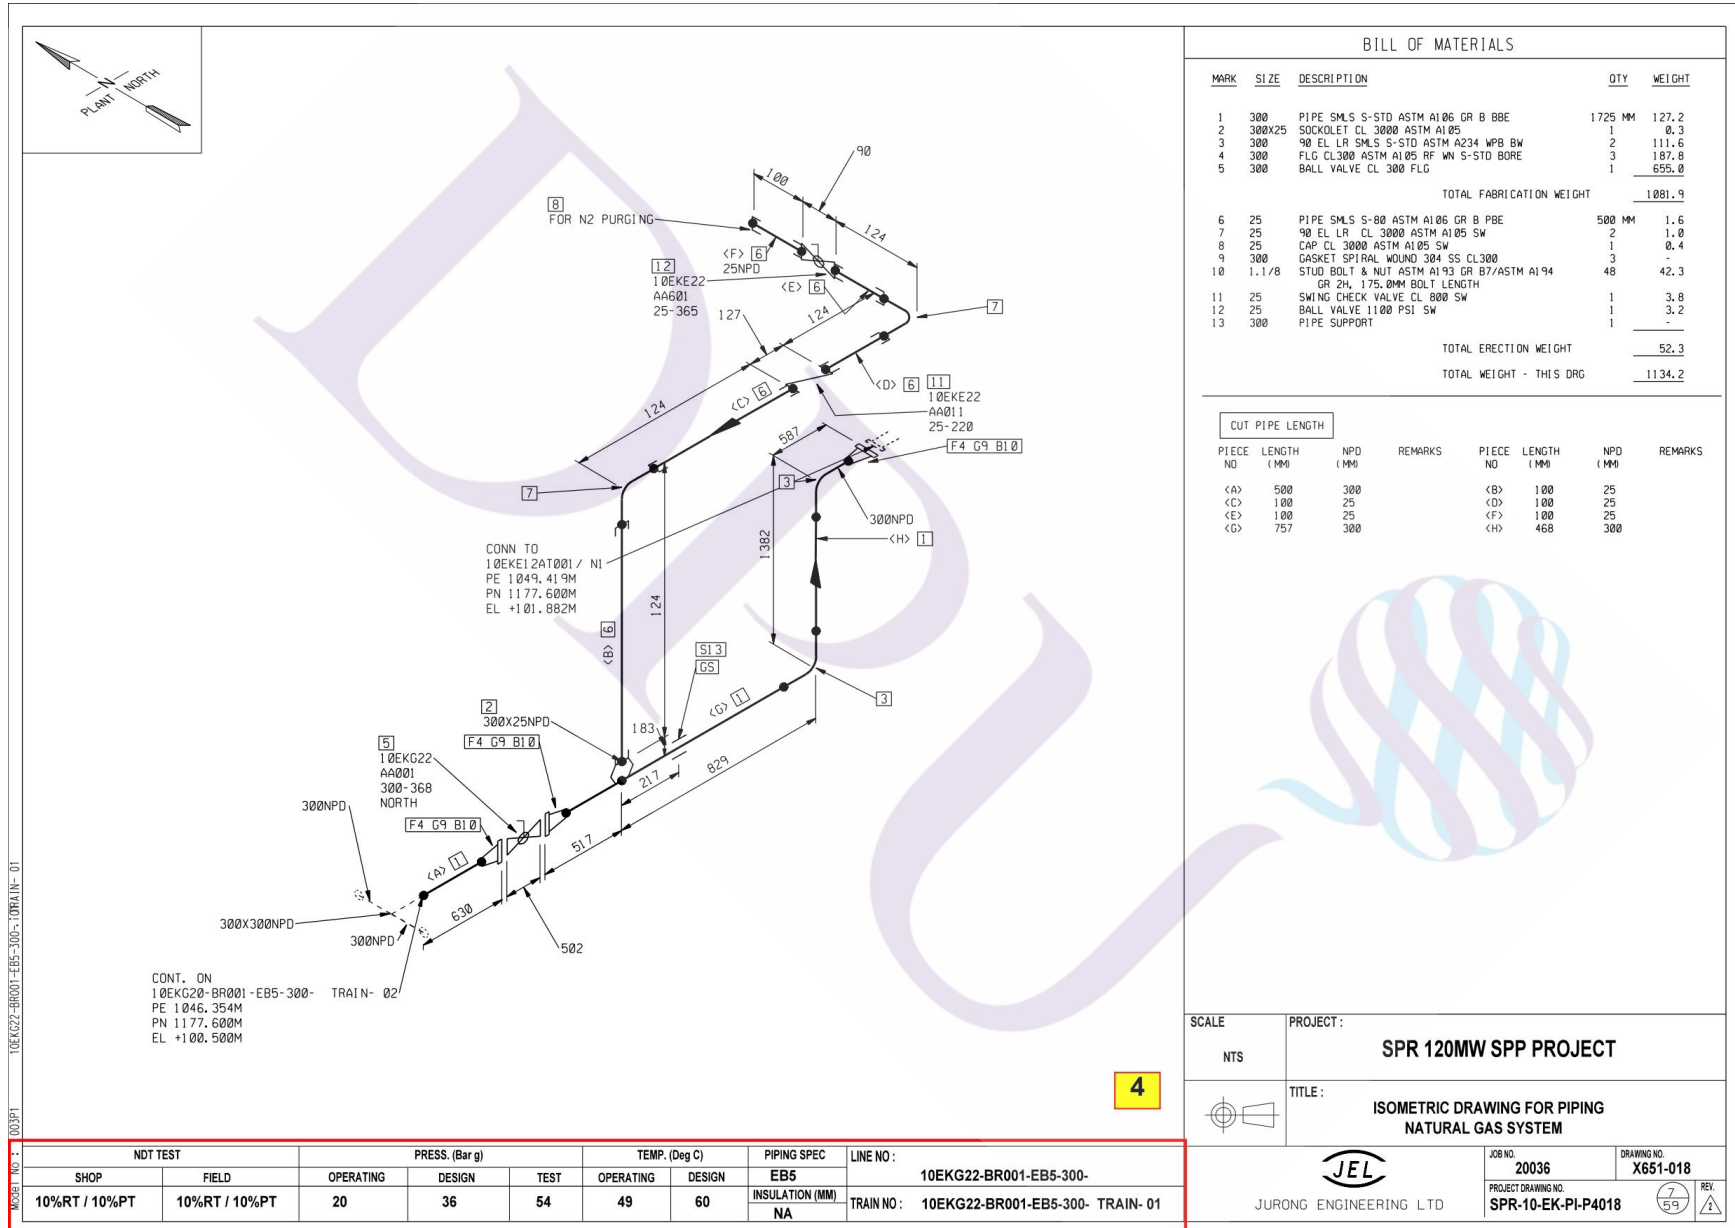

BILL OF MATERIALS

MARK	SIZE	DESCRIPTION	QTY	WEIGHT
1	300	PIPE SMLS S-STD ASTM A106 GR B BBE	1725 MM	127.2
2	300X25	SOCKET CL 3000 ASTM A105	1	0.3
3	300	90 EL LR SMLS S-STD ASTM A234 WPB BW	2	111.6
4	300	FLG CL300 ASTM A105 RF WN S-STD BORE	3	187.8
5	300	BALL VALVE CL 300 FLG	1	655.0
TOTAL FABRICATION WEIGHT				1081.9
6	25	PIPE SMLS S-80 ASTM A106 GR B PBE	500 MM	1.6
7	25	90 EL LR CL 3000 ASTM A105 SW	2	1.0
8	25	CAP CL 3000 ASTM A105 SW	1	0.4
9	300	GASKET SPIRAL WOUND 304 SS CL300	3	-
10	1.1/8	STUD BOLT & NUT ASTM A193 GR B7/ASTM A194 GR 24, 175.0MM BOLT LENGTH	48	42.3
11	25	SWING CHECK VALVE CL 800 SW	1	3.8
12	25	BALL VALVE 1100 PSI SW	1	3.2
13	300	PIPE SUPPORT	1	-
TOTAL ERECTION WEIGHT				52.3
TOTAL WEIGHT - THIS DRG				1134.2

CUT PIPE LENGTH

PIECE NO	LENGTH (MM)	NPD (MM)	REMARKS	PIECE NO	LENGTH (MM)	NPD (MM)	REMARKS
<A>	500	300			100	25	
<C>	100	25		<D>	100	25	
<E>	100	25		<F>	100	25	
<G>	757	300		<H>	468	300	

SCALE: NTS PROJECT: **SPR 120MW SPP PROJECT**

TITLE: **ISOMETRIC DRAWING FOR PIPING NATURAL GAS SYSTEM**

JEL JURONG ENGINEERING LTD

JOB NO: 20036 DRAWING NO: X651-018


PROJECT DRAWING NO: SPR-10-EK-PI-P4018

REV: 7/59

10EKG22-BR001-EB5-300-TORRAIN-01

NDT TEST		PRESS. (Bar g)			TEMP. (Deg C)		PIPING SPEC	LINE NO :
SHOP	FIELD	OPERATING	DESIGN	TEST	OPERATING	DESIGN	EB5	10EKG22-BR001-EB5-300-
10%RT / 10%PT	10%RT / 10%PT	20	36	54	49	60	INSULATION (MM) NA	TRAIN NO : 10EKG22-BR001-EB5-300- TRAIN- 01

4

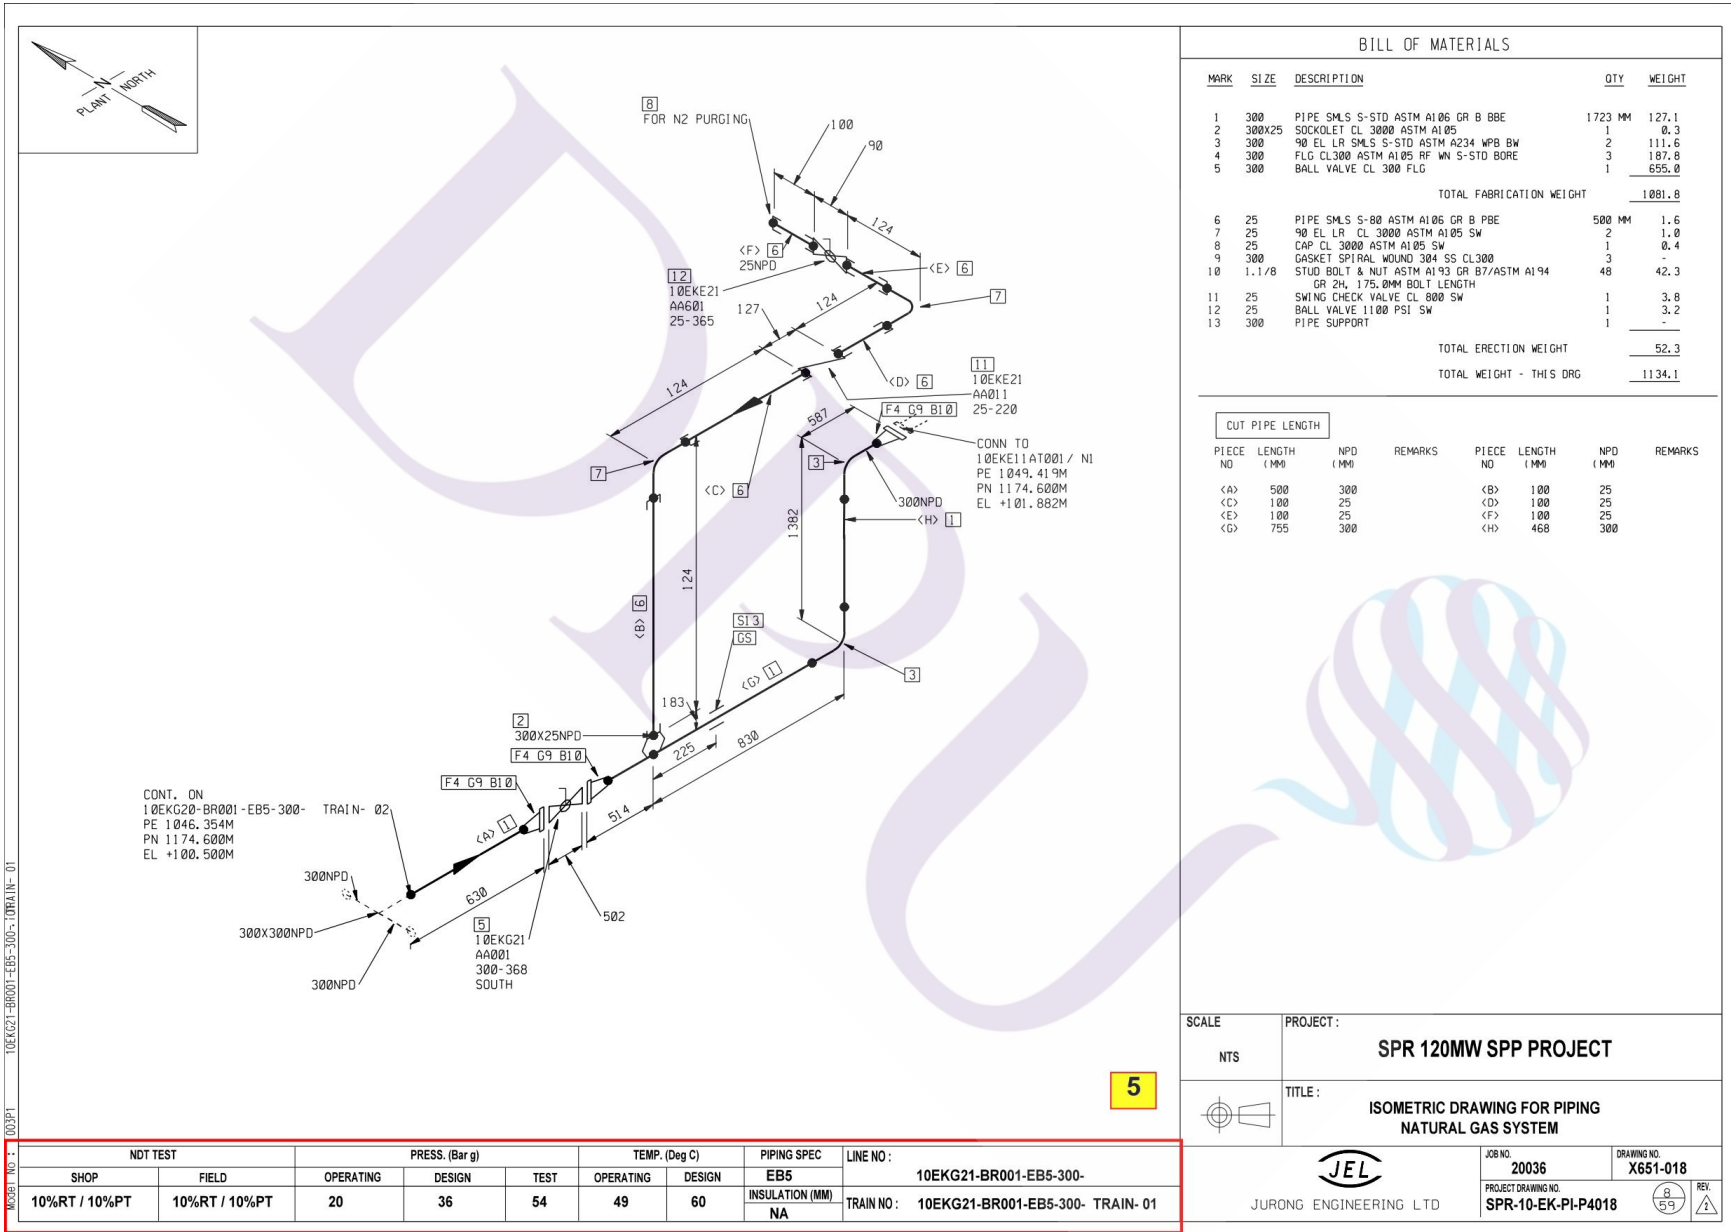

BILL OF MATERIALS

MARK	SIZE	DESCRIPTION	QTY	WEIGHT
1	300	PIPE SMLS S-STD ASTM A106 GR B BBE	1723 MM	127.1
2	300X25	SOCKET CL 3000 ASTM A105	1	0.3
3	300	90 EL LR SMLS S-STD ASTM A234 WPB BW	2	111.6
4	300	FLG CL300 ASTM A105 RF WN S-STD BORE	3	187.8
5	300	BALL VALVE CL 300 FLG	1	655.0
TOTAL FABRICATION WEIGHT				1081.8
6	25	PIPE SMLS S-80 ASTM A106 GR B PBE	500 MM	1.6
7	25	90 EL LR CL 3000 ASTM A105 SW	2	1.0
8	25	CAP CL 3000 ASTM A105 SW	1	0.4
9	300	GASKET SPIRAL WOUND 304 SS CL300	3	-
10	1.1/8	STUD BOLT & NUT ASTM A193 GR B7/ASTM A194 GR 2H 175.0MM BOLT LENGTH	48	42.3
11	25	SWING CHECK VALVE CL 800 SW	1	3.8
12	25	BALL VALVE 1100 PSI SW	1	3.2
13	300	PIPE SUPPORT	1	-
TOTAL ERECTION WEIGHT				52.3
TOTAL WEIGHT - THIS DRG				1134.1

CUT PIPE LENGTH

PIECE NO	LENGTH (MM)	NPD (MM)	REMARKS	PIECE NO	LENGTH (MM)	NPD (MM)	REMARKS
<A>	500	300			100	25	
<C>	100	25		<D>	100	25	
<E>	100	25		<F>	100	25	
<G>	755	300		<H>	468	300	

SCALE: NTS PROJECT: SPR 120MW SPP PROJECT

TITLE: ISOMETRIC DRAWING FOR PIPING NATURAL GAS SYSTEM

JEL JURONG ENGINEERING LTD

JOB NO. 20036 DRAWING NO. X651-018


PROJECT DRAWING NO. SPR-10-EK-PI-P4018

REV. 59

5

10EKG21-BR001-EB5-300- TRAIN-01

NDT TEST		PRESS. (Bar g)			TEMP. (Deg C)		PIPING SPEC	LINE NO :
SHOP	FIELD	OPERATING	DESIGN	TEST	OPERATING	DESIGN	EB5	10EKG21-BR001-EB5-300-
10%RT / 10%PT	10%RT / 10%PT	20	36	54	49	60	INSULATION (MM) NA	TRAIN NO : 10EKG21-BR001-EB5-300- TRAIN-01

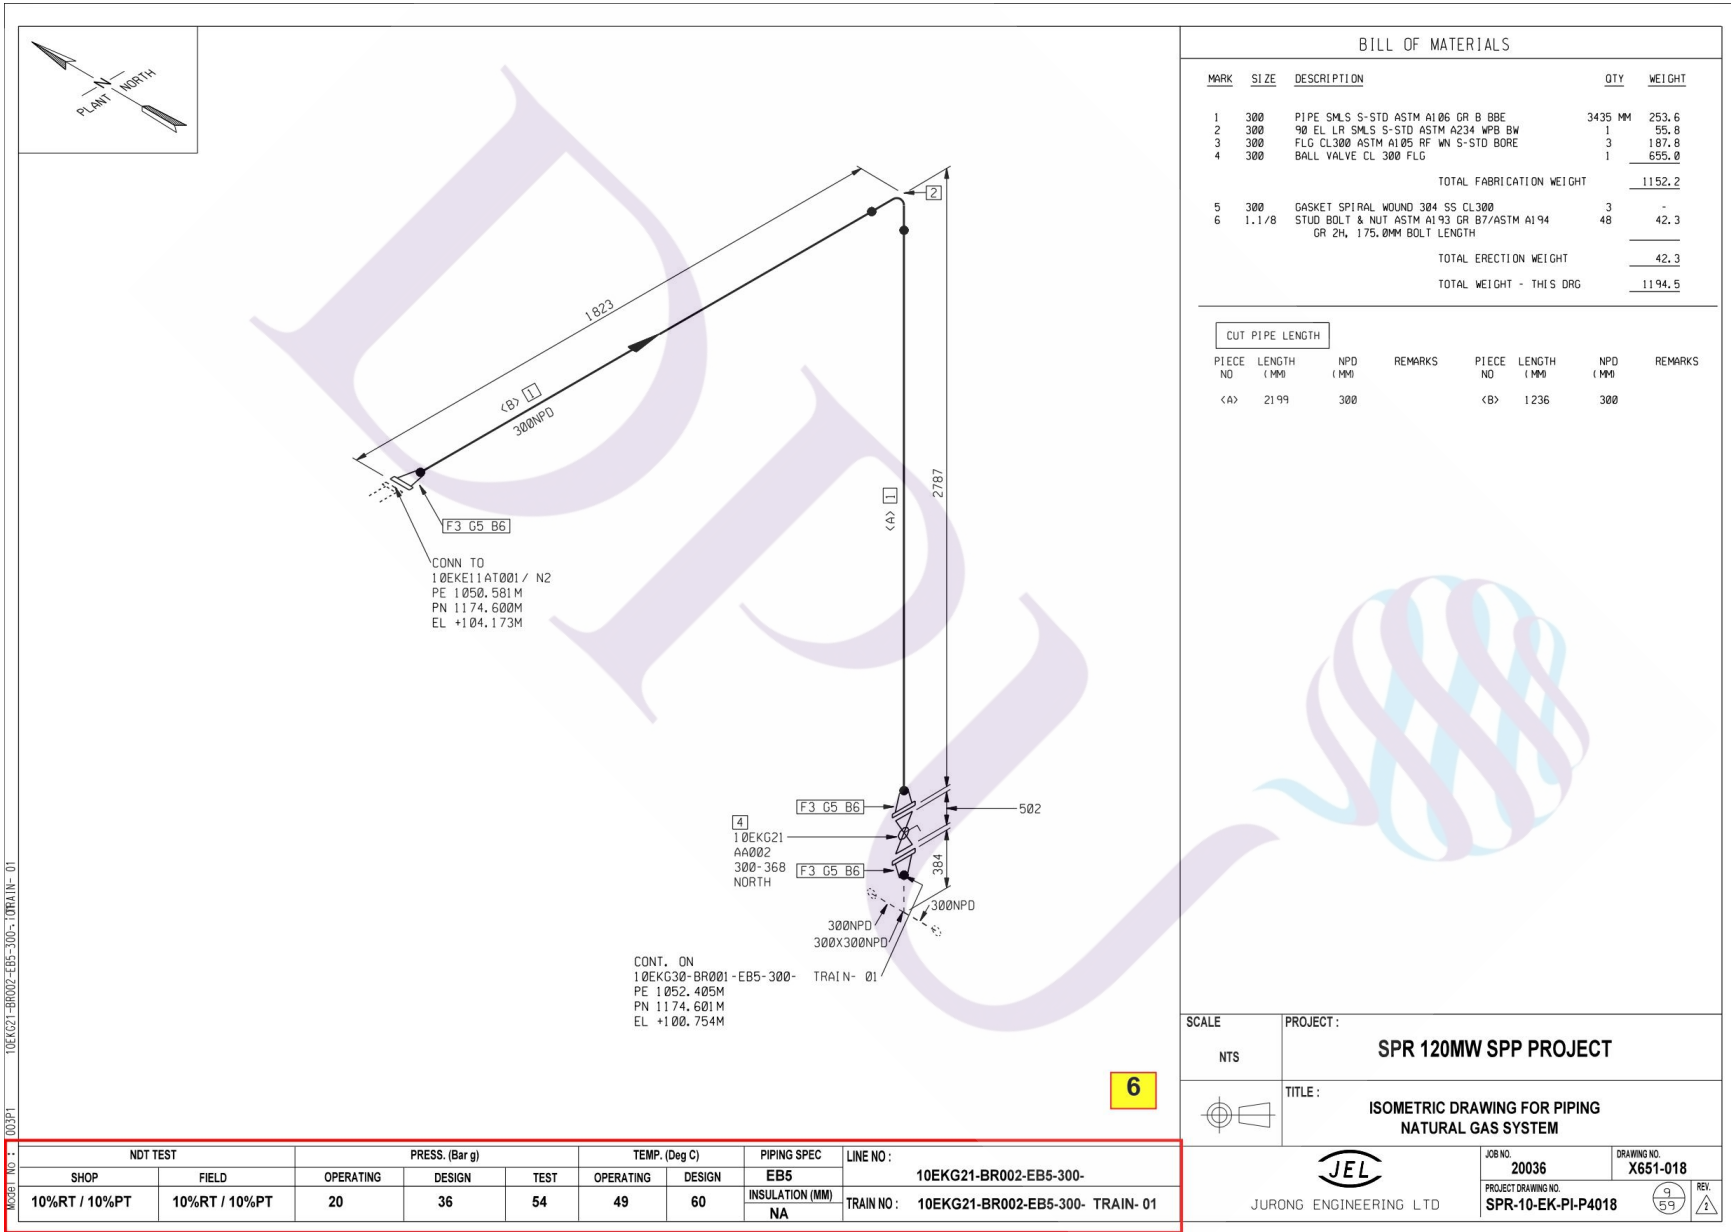

BILL OF MATERIALS

MARK	SIZE	DESCRIPTION	QTY	WEIGHT
1	300	PIPE SMLS S-STD ASTM A106 GR B BBE	3435 MM	253.6
2	300	90 EL. LR SMLS S-STD ASTM A234 WPB BW	1	55.8
3	300	FLG CL300 ASTM A105 RF WN S-STD BORE	3	187.8
4	300	BALL VALVE CL 300 FLG	1	655.0
TOTAL FABRICATION WEIGHT				1152.2
5	300	GASKET SPIRAL WOUND 304 SS CL300	3	-
6	1.1/8	STUD BOLT & NUT ASTM A193 GR B7/ASTM A194 GR 2H, 175.0MM BOLT LENGTH	48	42.3
TOTAL ERECTION WEIGHT				42.3
TOTAL WEIGHT - THIS DRG				1194.5

CUT PIPE LENGTH


PIECE NO	LENGTH (MM)	NPD (MM)	REMARKS	PIECE NO	LENGTH (MM)	NPD (MM)	REMARKS
<A>	2199	300			1236	300	

SCALE: NTS
 PROJECT: SPR 120MW SPP PROJECT
 TITLE: ISOMETRIC DRAWING FOR PIPING NATURAL GAS SYSTEM

JEL JURONG ENGINEERING LTD
 JOB NO. 20036 DRAWING NO. X651-018
 PROJECT DRAWING NO. SPR-10-EK-PI-P4018
 REV. 9/59

MODEL NO.: 10EKG21-BR002-EB5-300-TRAIN-01
 00391

NDT TEST		PRESS. (Bar g)			TEMP. (Deg C)		PIPING SPEC	LINE NO :
SHOP	FIELD	OPERATING	DESIGN	TEST	OPERATING	DESIGN	EB5	10EKG21-BR002-EB5-300-
10%RT / 10%PT	10%RT / 10%PT	20	36	54	49	60	INSULATION (MM) NA	TRAIN NO: 10EKG21-BR002-EB5-300- TRAIN- 01

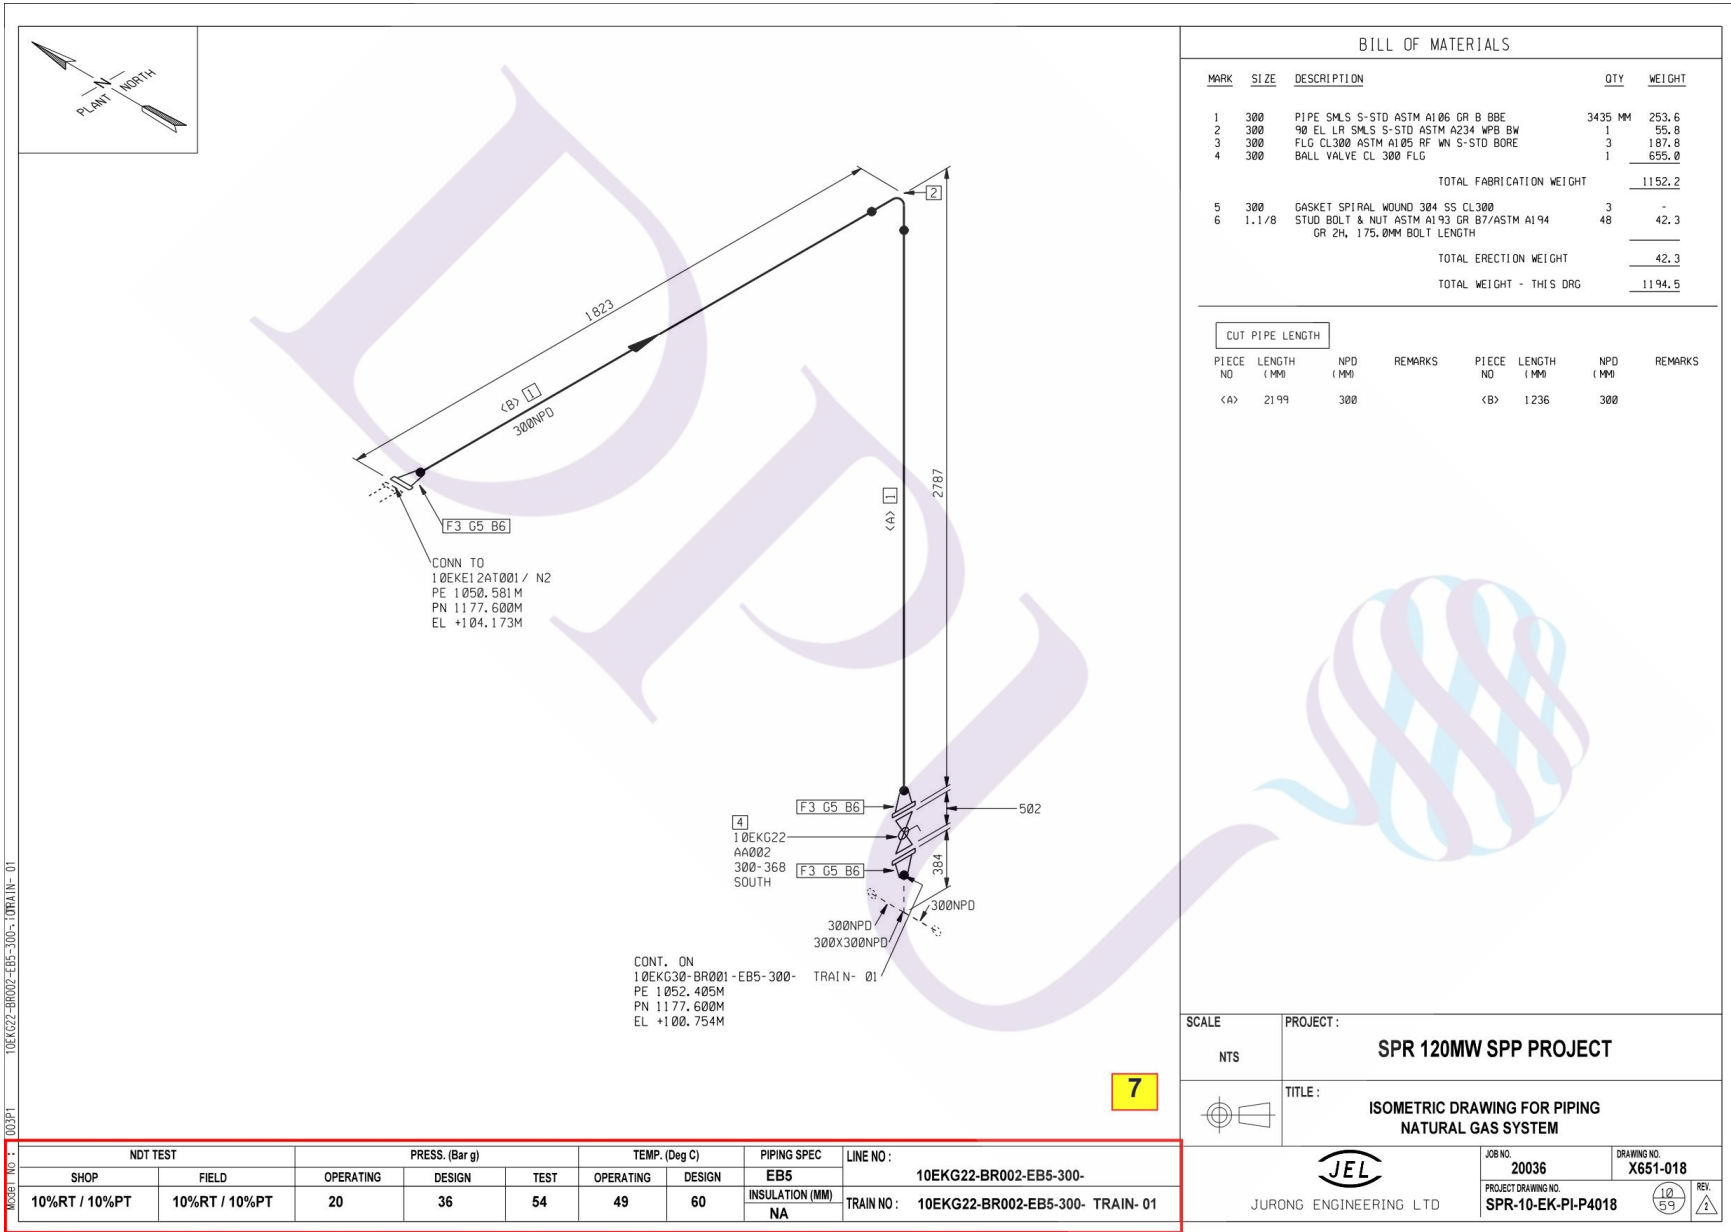

BILL OF MATERIALS

MARK	SIZE	DESCRIPTION	QTY	WEIGHT
1	300	PIPE SMLS S-STD ASTM A106 GR B BBE	3435 MM	253.6
2	300	90 EL LR SMLS S-STD ASTM A234 WPB BW	1	55.8
3	300	FLG CL300 ASTM A105 RF WN S-STD BORE	3	187.8
4	300	BALL VALVE CL 300 FLG	1	655.0
TOTAL FABRICATION WEIGHT				1152.2
5	300	GASKET SPIRAL WOUND 304 SS CL300	3	-
6	1.1/8	STUD BOLT & NUT ASTM A193 GR B7/ASTM A194 GR 2H, 175.0MM BOLT LENGTH	48	42.3
TOTAL ERECTION WEIGHT				42.3
TOTAL WEIGHT - THIS DRG				1194.5

CUT PIPE LENGTH

PIECE NO	LENGTH (MM)	NPD (MM)	REMARKS	PIECE NO	LENGTH (MM)	NPD (MM)	REMARKS
<A>	2199	300			1236	300	

SCALE: NTS PROJECT: **SPR 120MW SPP PROJECT**

TITLE: **ISOMETRIC DRAWING FOR PIPING NATURAL GAS SYSTEM**

JEL

JURONG ENGINEERING LTD


JOB NO. **20036** DRAWING NO. **X651-018**

PROJECT DRAWING NO. **SPR-10-EK-PI-P4018** REV. **1.0**

MODEL NO.: 10EKG22-BR002-EB5-300-TRAIN-01

NDT TEST		PRESS. (Bar g)			TEMP. (Deg C)		PIPING SPEC	LINE NO :
SHOP	FIELD	OPERATING	DESIGN	TEST	OPERATING	DESIGN	EB5	10EKG22-BR002-EB5-300-
10%RT / 10%PT	10%RT / 10%PT	20	36	54	49	60	INSULATION (MM) NA	TRAIN NO: 10EKG22-BR002-EB5-300- TRAIN- 01

7

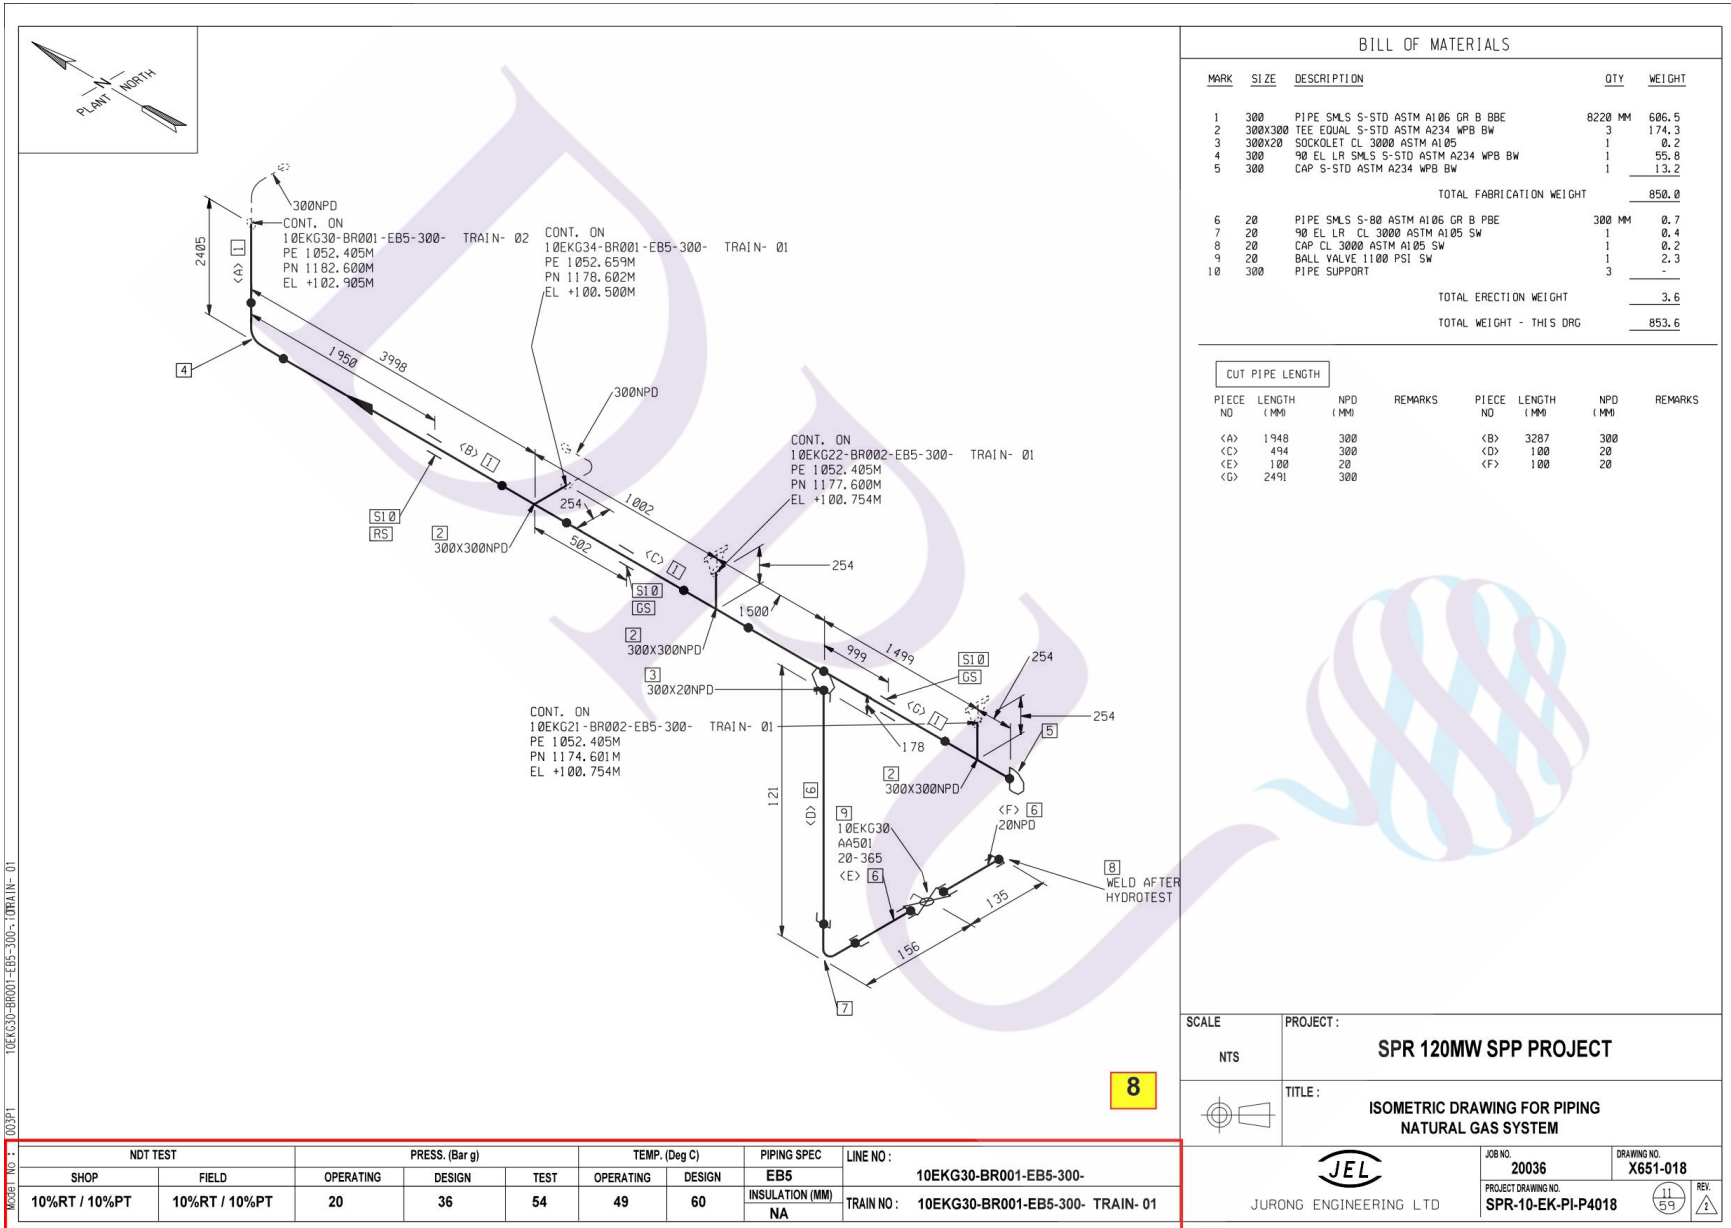

BILL OF MATERIALS

MARK	SIZE	DESCRIPTION	QTY	WEIGHT
1	300	PIPE SMLS S-STD ASTM A106 GR B BBE	8220	MM 606.5
2	300X300	TEE EQUAL S-STD ASTM A234 WPB BW	3	174.3
3	300X20	SOCKET CL 3000 ASTM A105	1	0.2
4	300	90 EL LR SMLS S-STD ASTM A234 WPB BW	1	55.8
5	300	CAP S-STD ASTM A234 WPB BW	1	13.2
TOTAL FABRICATION WEIGHT				850.0
6	20	PIPE SMLS S-80 ASTM A106 GR B PBE	300	MM 0.7
7	20	90 EL LR CL 3000 ASTM A105 SW	1	0.4
8	20	CAP CL 3000 ASTM A105 SW	1	0.2
9	20	BALL VALVE 1100 PSI SW	1	2.3
10	300	PIPE SUPPORT	3	-
TOTAL ERECTION WEIGHT				3.6
TOTAL WEIGHT - THIS DRG				853.6

CUT PIPE LENGTH

PIECE NO	LENGTH (MM)	NPD (MM)	REMARKS	PIECE NO	LENGTH (MM)	NPD (MM)	REMARKS
<A>	1948	300			3287	300	
<C>	494	300		<D>	100	20	
<E>	100	20		<F>	100	20	
<G>	2491	300					

SCALE: NTS PROJECT: **SPR 120MW SPP PROJECT**

TITLE: **ISOMETRIC DRAWING FOR PIPING NATURAL GAS SYSTEM**

JEL JURONG ENGINEERING LTD

JOB NO. 20036 DRAWING NO. X651-018


PROJECT DRAWING NO. SPR-10-EK-PI-P4018

REV. 11/59

MODEL NO.: 10EKG30-BR001-EB5-300- TRAIN- 01

NDT TEST		PRESS. (Bar g)			TEMP. (Deg C)		PIPING SPEC	LINE NO :
SHOP	FIELD	OPERATING	DESIGN	TEST	OPERATING	DESIGN	EB5	10EKG30-BR001-EB5-300-
10%RT / 10%PT	10%RT / 10%PT	20	36	54	49	60	INSULATION (MM) NA	TRAIN NO: 10EKG30-BR001-EB5-300- TRAIN- 01

8

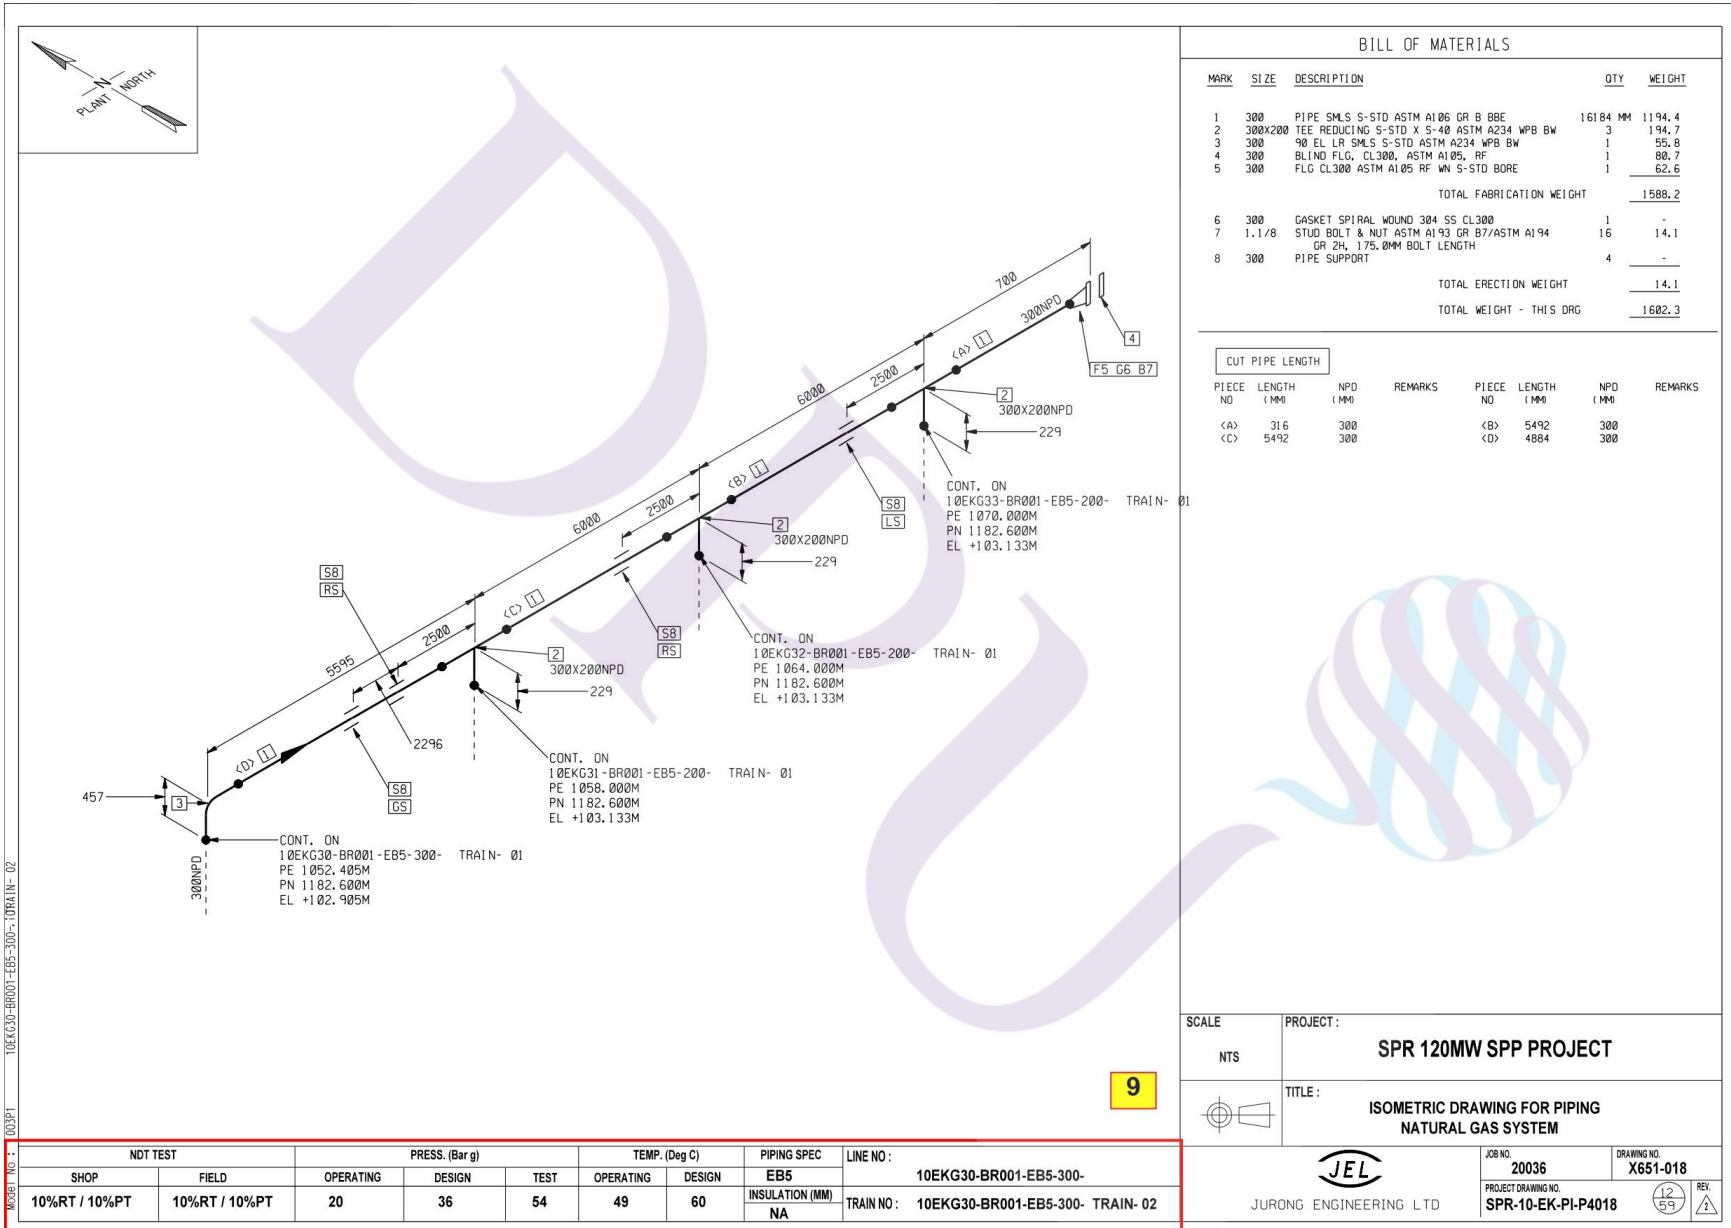

BILL OF MATERIALS

MARK	SIZE	DESCRIPTION	QTY	WEIGHT
1	300	PIPE SMLS S-STD ASTM A106 GR B BBE	16184 MM	1194.4
2	300X200	TEE REDUCING S-STD X S-40 ASTM A234 WPB BW	3	194.7
3	300	90 EL L/R SMLS S-STD ASTM A234 WPB BW	1	55.8
4	300	BLIND FLG. CL300, ASTM A105, RF	1	80.7
5	300	FLG CL300 ASTM A105 RF WN S-STD BORE	1	62.6
TOTAL FABRICATION WEIGHT				1588.2
6	300	GASKET SPIRAL WOUND 304 SS CL300	1	-
7	1.1/8	STUD BOLT & NUT ASTM A193 GR B7/ASTM A194 GR 2H, 175.0MM BOLT LENGTH	16	14.1
8	300	PIPE SUPPORT	4	-
TOTAL ERECTION WEIGHT				14.1
TOTAL WEIGHT - THIS DRG				1602.3

CUT PIPE LENGTH

PIECE NO	LENGTH (MM)	NPD (MM)	REMARKS	PIECE NO	LENGTH (MM)	NPD (MM)	REMARKS
<A>	316	300			5492	300	
<C>	5492	300		<D>	4884	300	

SCALE	PROJECT:
NTS	SPR 120MW SPP PROJECT
TITLE:	ISOMETRIC DRAWING FOR PIPING NATURAL GAS SYSTEM

9


MODEL NO.: 10EKG30-BR001-EB5-300- TRAIN-02

NDT TEST		PRESS. (Bar g)			TEMP. (Deg C)		PIPING SPEC	LINE NO :
SHOP	FIELD	OPERATING	DESIGN	TEST	OPERATING	DESIGN	EB5	10EKG30-BR001-EB5-300-
10%RT / 10%PT	10%RT / 10%PT	20	36	54	49	60	INSULATION (MM) NA	TRAIN NO: 10EKG30-BR001-EB5-300- TRAIN-02



JURONG ENGINEERING LTD

JOB NO.	DRAWING NO.
20036	X651-018
PROJECT DRAWING NO.	REV.
SPR-10-EK-PI-P4018	12/59

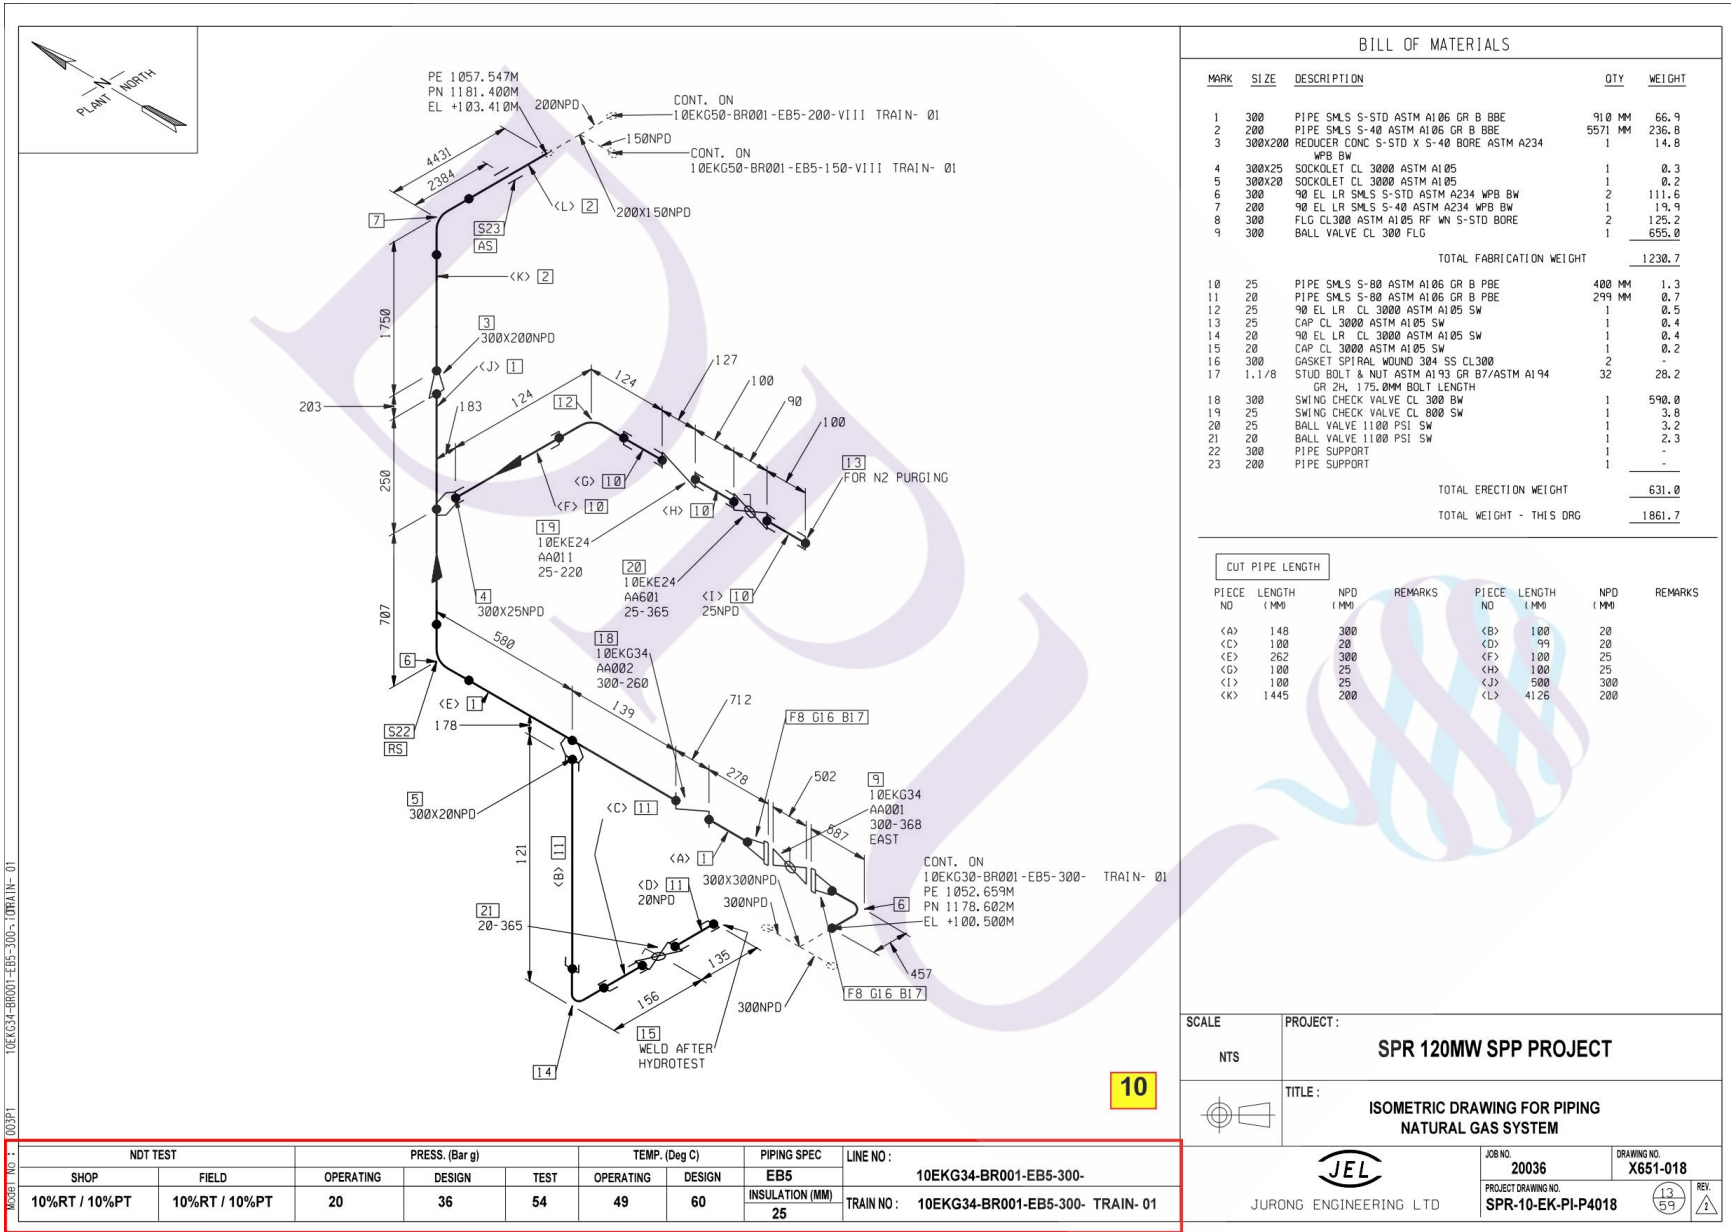

BILL OF MATERIALS

MARK	SIZE	DESCRIPTION	QTY	WEIGHT
1	300	PIPE SMLS S-STD ASTM A106 GR B BBE	910 MM	66.9
2	200	PIPE SMLS S-40 ASTM A106 GR B BBE	5571 MM	236.8
3	300X200	REDUCER CONC S-STD X S-40 BORE ASTM A234 WPB BW	1	14.8
4	300X25	SOCKET CL 3000 ASTM A105	1	0.3
5	300X20	SOCKET CL 3000 ASTM A105	1	0.2
6	300	90 EL LR SMLS S-STD ASTM A234 WPB BW	2	111.6
7	200	90 EL LR SMLS S-40 ASTM A234 WPB BW	1	19.9
8	300	FLG CL300 ASTM A105 RF WN S-STD BORE	2	125.2
9	300	BALL VALVE CL 300 FLG	1	655.0
TOTAL FABRICATION WEIGHT				1230.7
10	25	PIPE SMLS S-80 ASTM A106 GR B PBE	400 MM	1.3
11	20	PIPE SMLS S-80 ASTM A106 GR B PBE	299 MM	0.7
12	25	90 EL LR CL 3000 ASTM A105 SW	1	0.5
13	25	CAP CL 3000 ASTM A105 SW	1	0.4
14	20	90 EL LR CL 3000 ASTM A105 SW	1	0.4
15	20	CAP CL 3000 ASTM A105 SW	1	0.2
16	300	GASKET SPIRAL WOUND 304 SS CL300	2	-
17	1.1/8	STUD BOLT & NUT ASTM A193 GR B7/ASTM A194 GR 2H, 175.0MM BOLT LENGTH	32	28.2
18	300	SWING CHECK VALVE CL 300 BW	1	590.0
19	25	SWING CHECK VALVE CL 800 SW	1	3.8
20	25	BALL VALVE 1100 PSI SW	1	3.2
21	20	BALL VALVE 1100 PSI SW	1	2.3
22	300	PIPE SUPPORT	1	-
23	200	PIPE SUPPORT	1	-
TOTAL ERECTION WEIGHT				631.0
TOTAL WEIGHT - THIS DRG				1861.7

CUT PIPE LENGTH

PIECE NO	LENGTH (MM)	NPD (MM)	REMARKS	PIECE NO	LENGTH (MM)	NPD (MM)	REMARKS
<A>	148	300			100	20	
<C>	100	20		<D>	99	20	
<E>	262	300		<F>	100	25	
<G>	100	25		<H>	100	25	
<I>	100	25		<J>	500	300	
<K>	1445	200		<L>	4126	200	

SCALE: NTS PROJECT: SPR 120MW SPP PROJECT

TITLE: ISOMETRIC DRAWING FOR PIPING NATURAL GAS SYSTEM

JEL JURONG ENGINEERING LTD


JOB NO: 20036 DRAWING NO: X651-018

PROJECT DRAWING NO: SPR-10-EK-PI-P4018

REV. 13/59

MODEL NO.: 10EKG34-BR001-EB5-300-TORRAIN-01

NDT TEST			PRESS. (Bar g)			TEMP. (Deg C)		PIPING SPEC	LINE NO :
SHOP	FIELD	OPERATING	DESIGN	TEST	OPERATING	DESIGN	EB5	INSULATION (MM)	10EKG34-BR001-EB5-300-
10%RT / 10%PT	10%RT / 10%PT	20	36	54	49	60	25		TRAIN NO: 10EKG34-BR001-EB5-300- TRAIN- 01

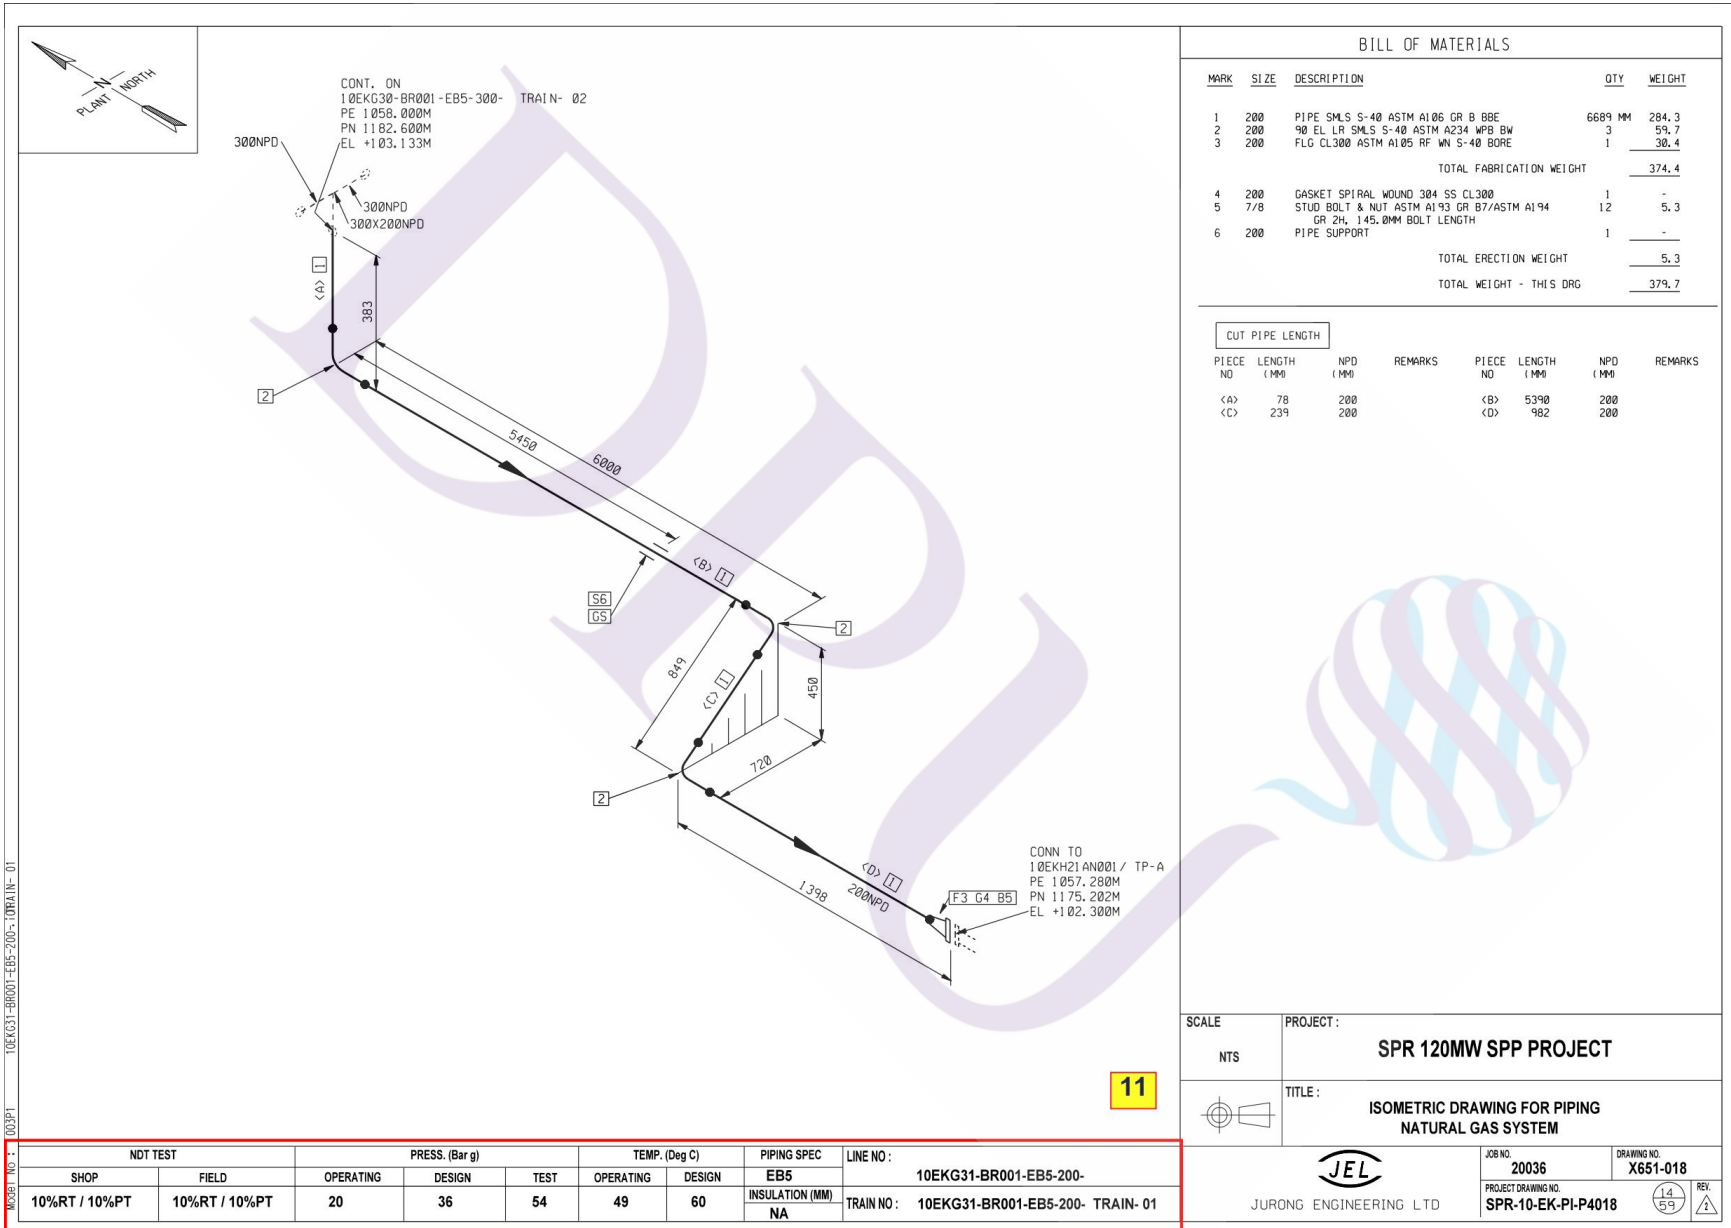

BILL OF MATERIALS

MARK	SIZE	DESCRIPTION	QTY	WEIGHT
1	200	PIPE SMLS S-40 ASTM A106 GR B BBE	6689 MM	284.3
2	200	90 EL LR SMLS S-40 ASTM A234 WPB BW	3	59.7
3	200	FLG CL300 ASTM A105 RF WN S-40 BORE	1	30.4
TOTAL FABRICATION WEIGHT				374.4
4	200	GASKET SPIRAL WOUND 304 SS CL300	1	-
5	7/8	STUD BOLT & NUT ASTM A193 GR B7/ASTM A194 GR 2H, 145.0MM BOLT LENGTH	12	5.3
6	200	PIPE SUPPORT	1	-
TOTAL ERECTION WEIGHT				5.3
TOTAL WEIGHT - THIS DRG				379.7


CUT PIPE LENGTH

PIECE NO	LENGTH (MM)	NPD (MM)	REMARKS	PIECE NO	LENGTH (MM)	NPD (MM)	REMARKS
<A>	78	200			5390	200	
<C>	239	200		<D>	982	200	

SCALE	PROJECT:
NTS	SPR 120MW SPP PROJECT
TITLE:	ISOMETRIC DRAWING FOR PIPING NATURAL GAS SYSTEM
JEL	JOB NO. 20036 DRAWING NO. X651-018
JURONG ENGINEERING LTD	PROJECT DRAWING NO. SPR-10-EK-PI-P4018

10EKG31-BR001-EB5-200-TRAIN-01

NDT TEST		PRESS. (Bar g)			TEMP. (Deg C)		PIPING SPEC	LINE NO :
SHOP	FIELD	OPERATING	DESIGN	TEST	OPERATING	DESIGN	EB5	10EKG31-BR001-EB5-200-
10%RT / 10%PT	10%RT / 10%PT	20	36	54	49	60	INSULATION (MM) NA	TRAIN NO : 10EKG31-BR001-EB5-200- TRAIN- 01

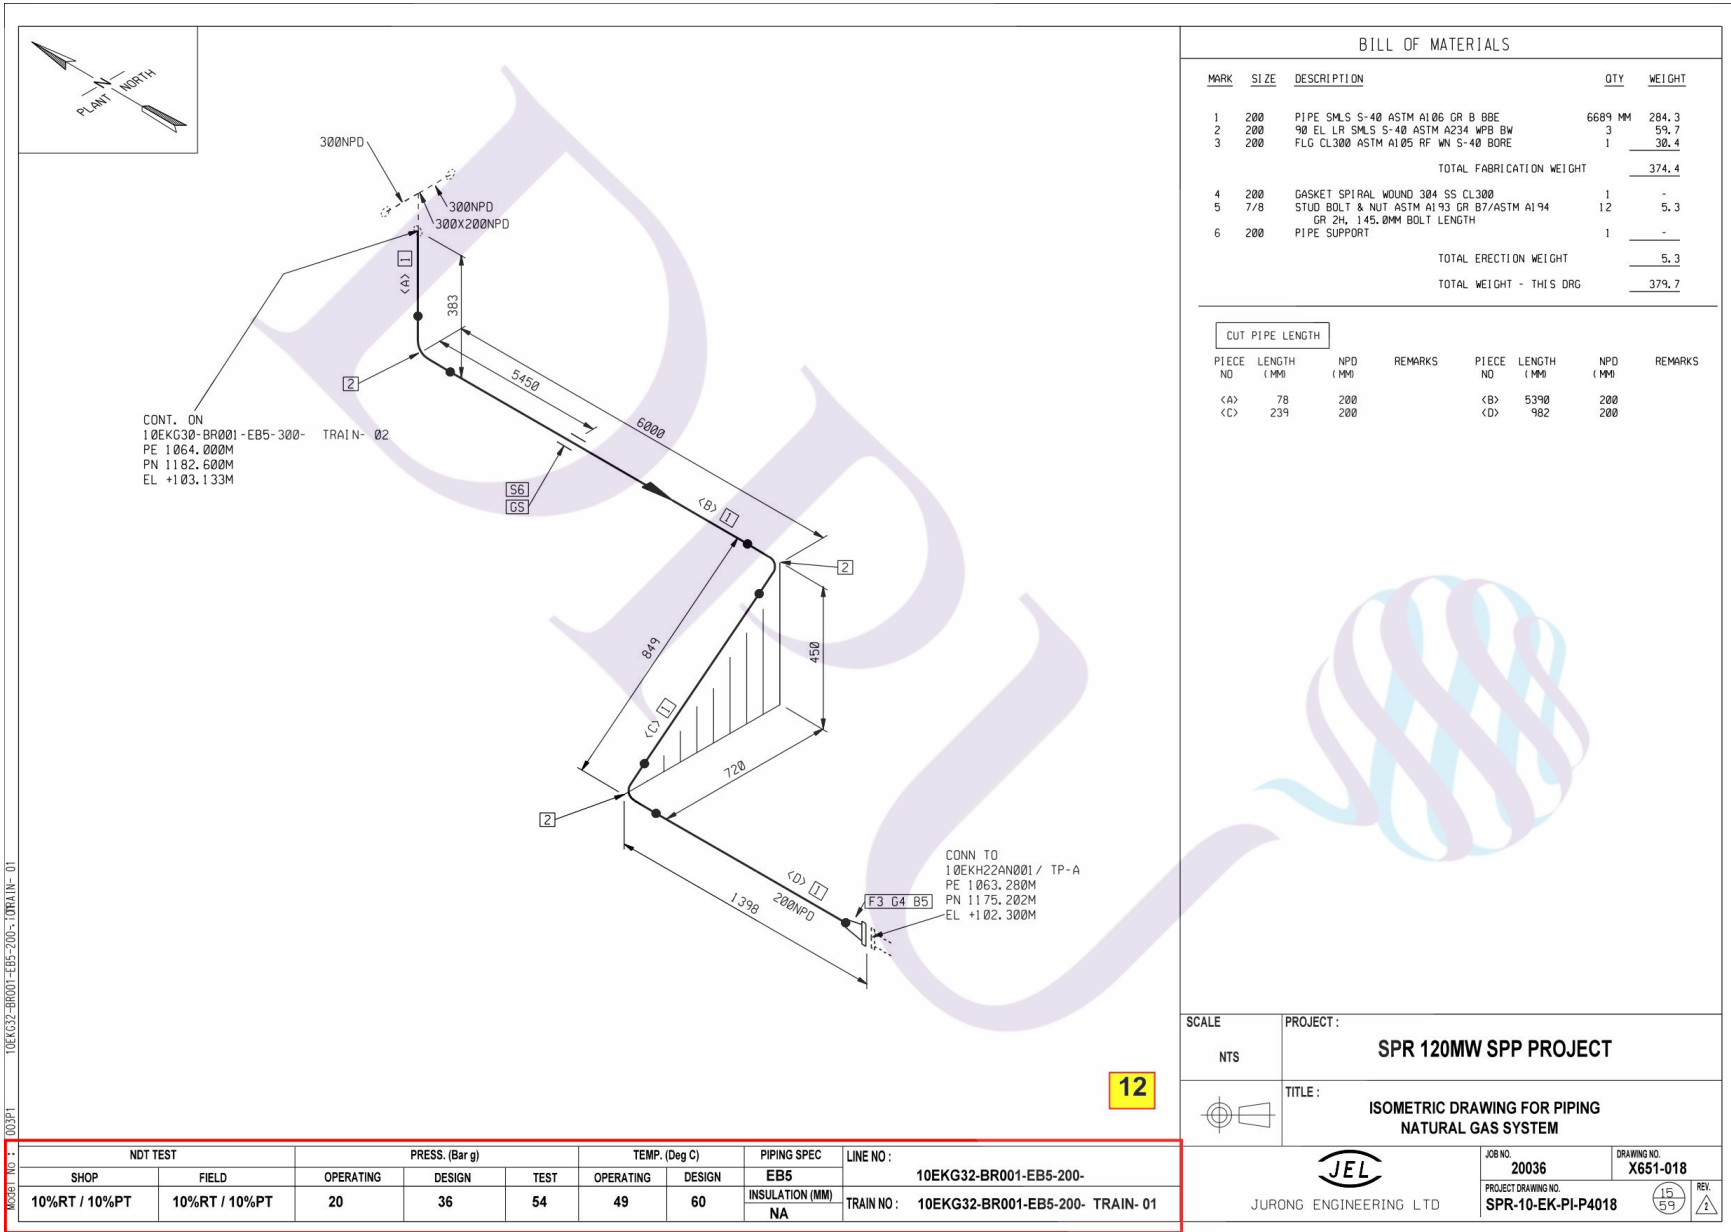

CONT. ON
10EKG30-BR001-EB5-300-
PE 1064.000M
PN 1182.600M
EL +103.133M

TRAIN-02

CONN TO
10EKH22AN001 / TP-A
PE 1063.200M
PN 1175.202M
EL +102.300M

BILL OF MATERIALS

MARK	SIZE	DESCRIPTION	QTY	WEIGHT
1	200	PIPE SMLS S-40 ASTM A106 GR B BBE	6689 MM	284.3
2	200	90 EL LR SMLS S-40 ASTM A234 WPB BW	3	59.7
3	200	FLG CL300 ASTM A105 RF WN S-40 BORE	1	30.4
TOTAL FABRICATION WEIGHT				374.4
4	200	GASKET SPIRAL WOUND 304 SS CL300	1	-
5	7/8	STUD BOLT & NUT ASTM A193 GR B7/ASTM A194 GR 2H, 145.0MM BOLT LENGTH	12	5.3
6	200	PIPE SUPPORT	1	-
TOTAL ERECTION WEIGHT				5.3
TOTAL WEIGHT - THIS DRG				379.7

CUT PIPE LENGTH

PIECE NO	LENGTH (MM)	NPD (MM)	REMARKS	PIECE NO	LENGTH (MM)	NPD (MM)	REMARKS
<A>	78	200			5390	200	
<C>	239	200		<D>	982	200	

SCALE: NTS PROJECT: SPR 120MW SPP PROJECT

TITLE: ISOMETRIC DRAWING FOR PIPING NATURAL GAS SYSTEM

JEL JURONG ENGINEERING LTD


JOB NO. 20036 DRAWING NO. X651-018

PROJECT DRAWING NO. SPR-10-EK-PI-P4018

REV. 15/59

MODEL NO.: 10EKG32-BR001-EB5-200-TRAIN-01

NDT TEST			PRESS. (Bar g)			TEMP. (Deg C)		PIPING SPEC	LINE NO :
SHOP	FIELD	OPERATING	DESIGN	TEST	OPERATING	DESIGN	EB5	10EKG32-BR001-EB5-200-	
10%RT / 10%PT	10%RT / 10%PT	20	36	54	49	60	INSULATION (MM) NA	TRAIN NO : 10EKG32-BR001-EB5-200- TRAIN- 01	

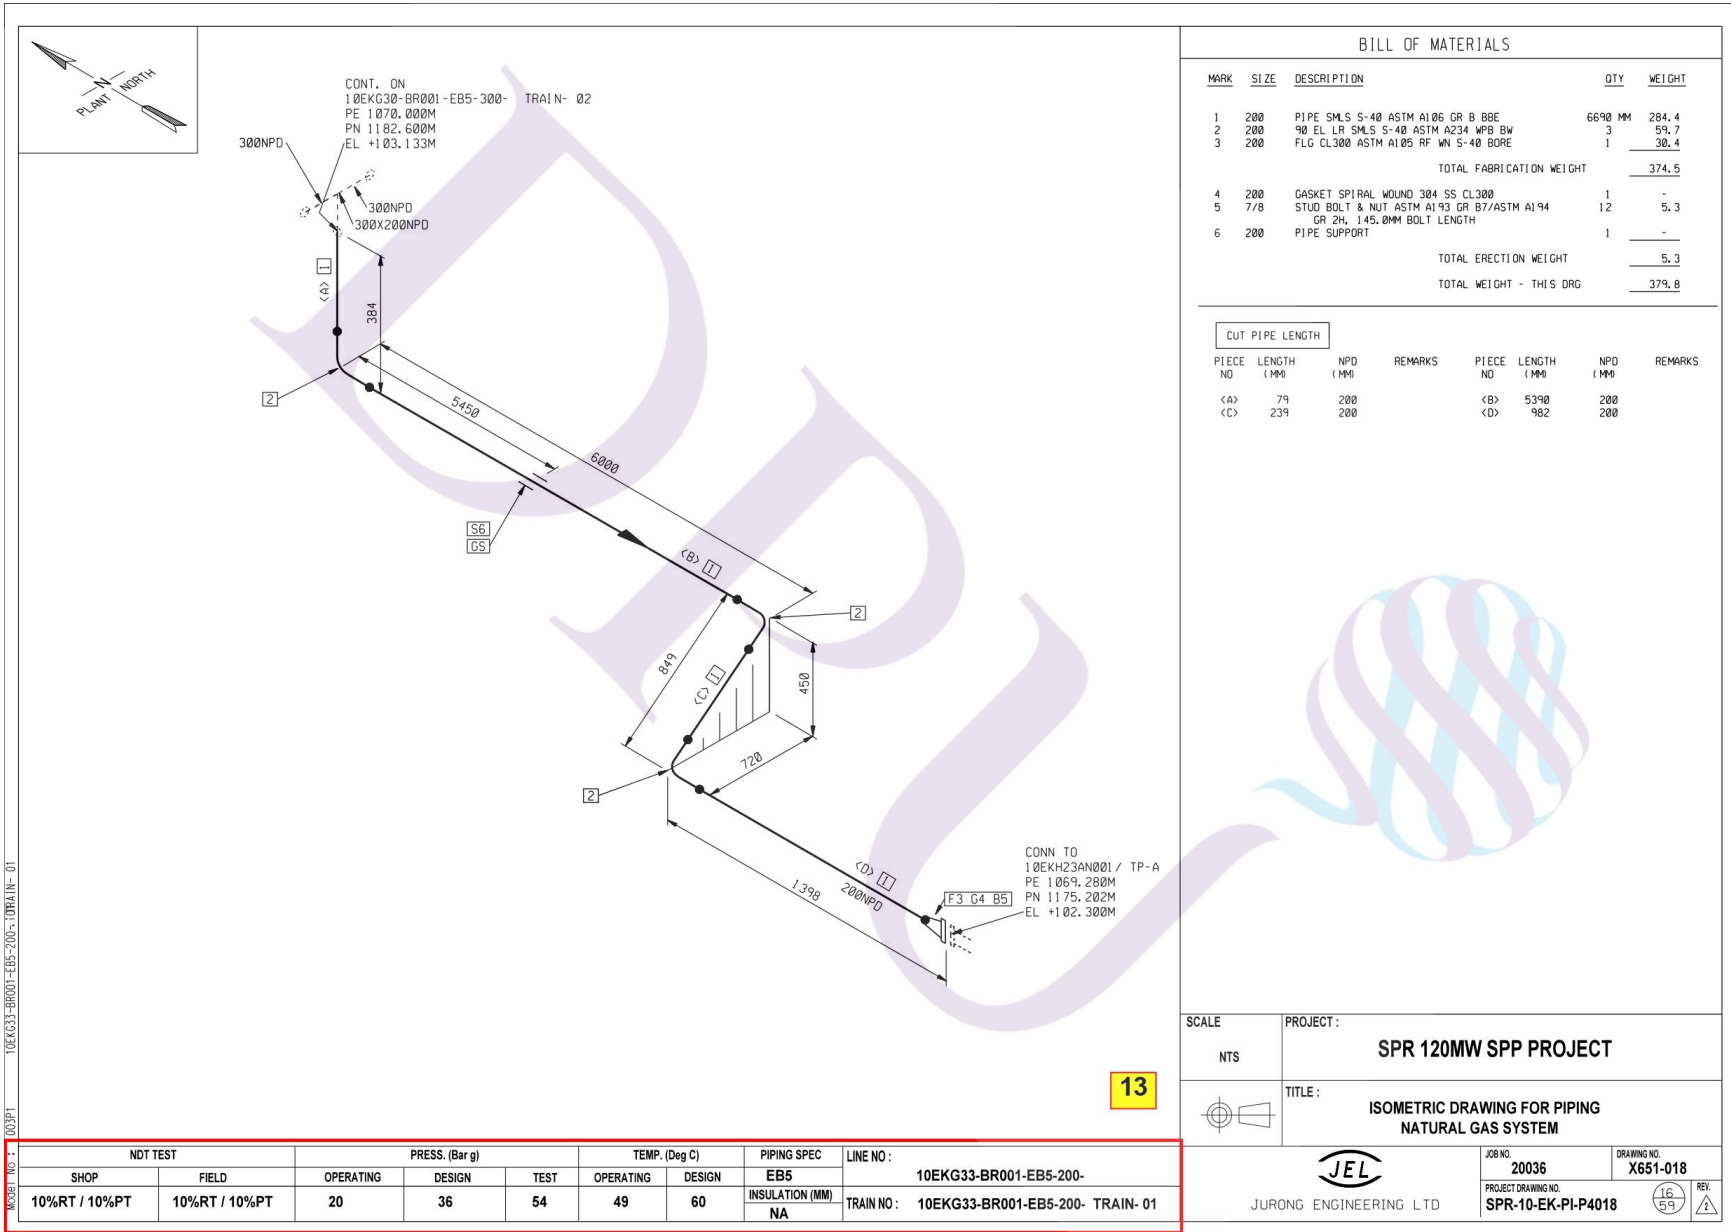

BILL OF MATERIALS

MARK	SIZE	DESCRIPTION	QTY	WEIGHT
1	200	PIPE SMLS S-40 ASTM A106 GR B BBE	6690 MM	284.4
2	200	90 EL LR SMLS S-40 ASTM A234 WPB BW	3	59.7
TOTAL FABRICATION WEIGHT				374.5
4	200	GASKET SPIRAL WOUND 304 SS CL300	1	-
5	7/8	STUD BOLT & NUT ASTM A193 GR B7/ASTM A194 GR 2H, 145.0MM BOLT LENGTH	12	5.3
6	200	PIPE SUPPORT	1	-
TOTAL ERECTION WEIGHT				5.3
TOTAL WEIGHT - THIS DRG				379.8

CUT PIPE LENGTH

PIECE NO	LENGTH (MM)	NPD (MM)	REMARKS	PIECE NO	LENGTH (MM)	NPD (MM)	REMARKS
<A>	79	200			5390	200	
<C>	239	200		<D>	982	200	

SCALE: NTS PROJECT: SPR 120MW SPP PROJECT

TITLE: ISOMETRIC DRAWING FOR PIPING NATURAL GAS SYSTEM

JEL JURONG ENGINEERING LTD


JOB NO: 20036 DRAWING NO: X651-018

PROJECT DRAWING NO: SPR-10-EK-PI-P4018

REV. 1/59

MODEL NO: 10EKG33-BR001-EB5-200-TRAIN-01

NDT TEST		PRESS. (Bar g)			TEMP. (Deg C)		PIPING SPEC	LINE NO :
SHOP	FIELD	OPERATING	DESIGN	TEST	OPERATING	DESIGN	EB5	10EKG33-BR001-EB5-200-
10%RT / 10%PT	10%RT / 10%PT	20	36	54	49	60	INSULATION (MM) NA	TRAIN NO: 10EKG33-BR001-EB5-200- TRAIN- 01

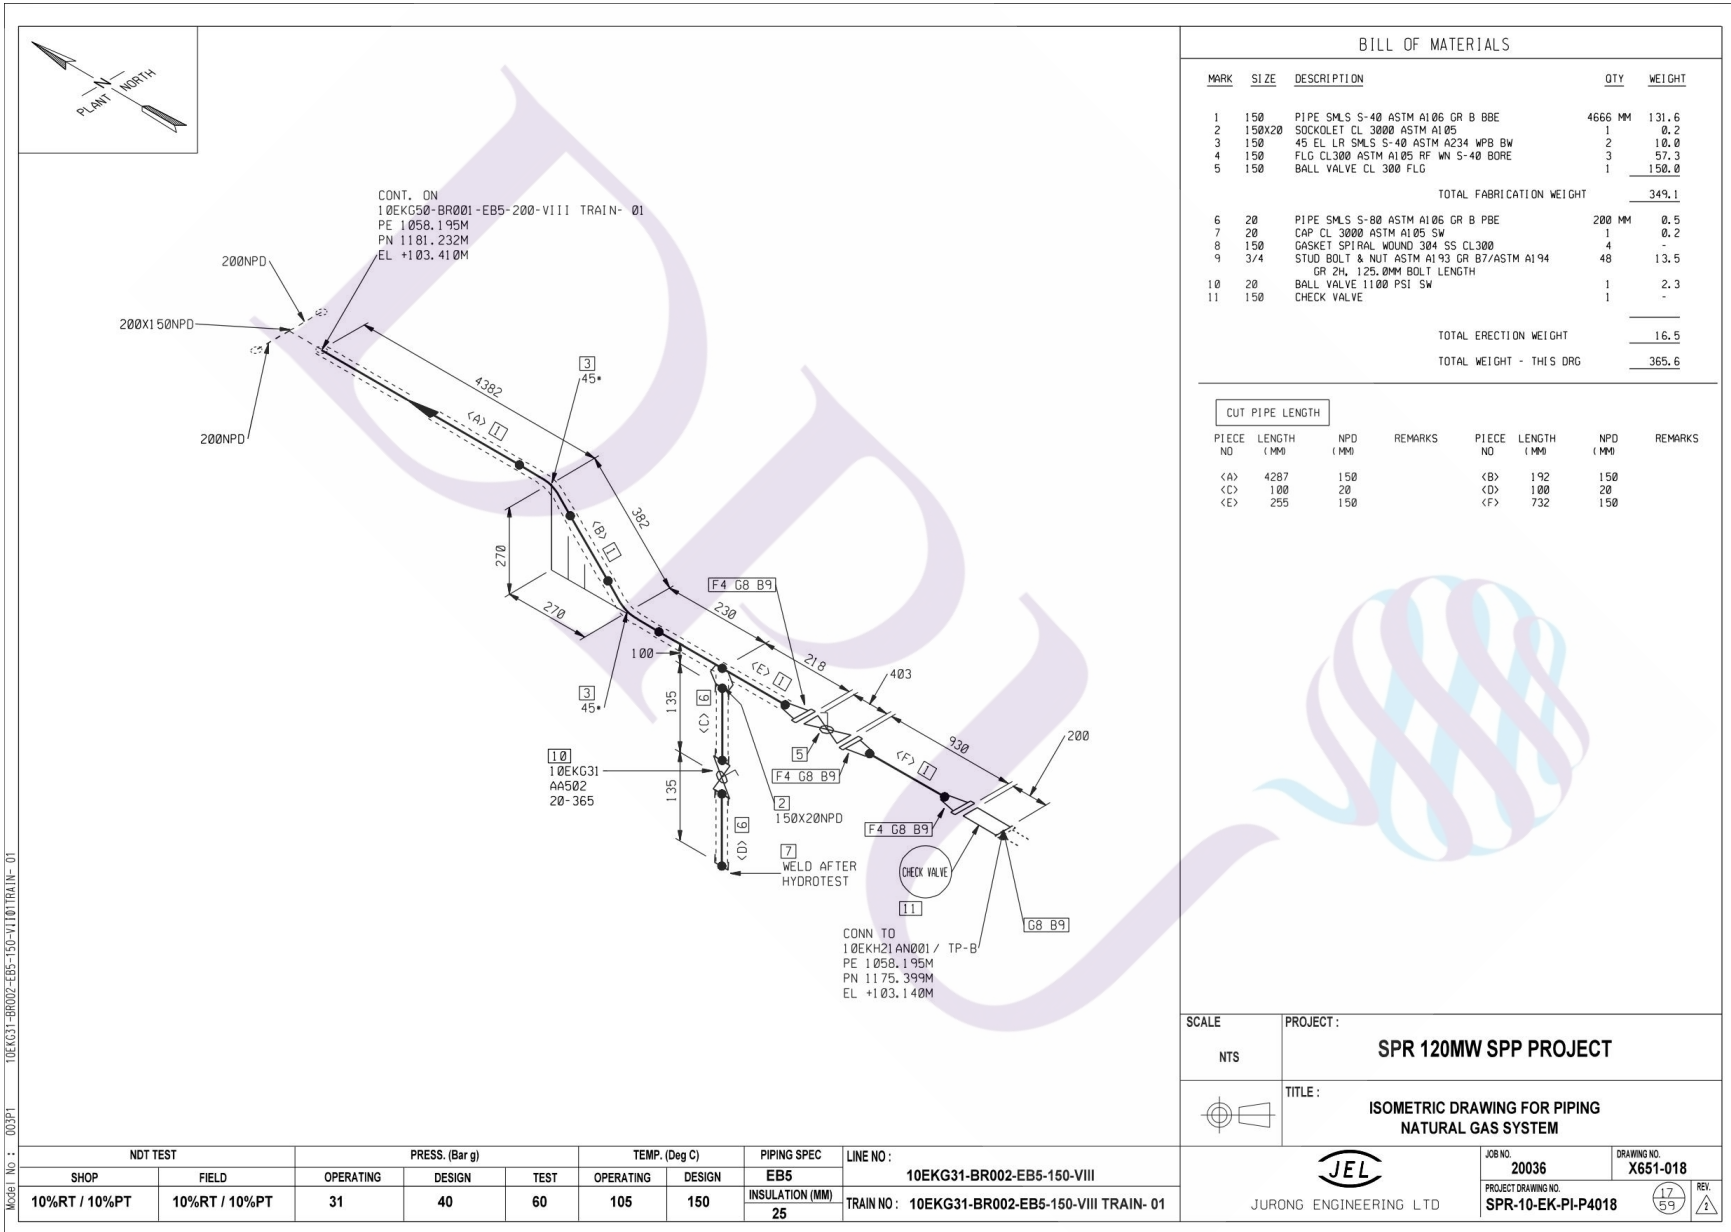

BILL OF MATERIALS

MARK	SIZE	DESCRIPTION	QTY	WEIGHT
1	150	PIPE SMLS S-40 ASTM A106 GR B BBE	4666 MM	131.6
2	150X20	SOCKET CL 3000 ASTM A105	1	0.2
3	150	45 EL L/R SMLS S-40 ASTM A234 WPB BW	2	10.0
4	150	FLG CL300 ASTM A105 RF WN S-40 BORE	3	57.3
5	150	BALL VALVE CL 300 FLG	1	150.0
TOTAL FABRICATION WEIGHT				349.1
6	20	PIPE SMLS S-80 ASTM A106 GR B PBE	200 MM	0.5
7	20	CAP CL 3000 ASTM A105 SW	1	0.2
8	150	GASKET SPIRAL WOUND 304 SS CL300	4	-
9	3/4	STUD BOLT & NUT ASTM A193 GR B7/ASTM A194 GR 2H, 125.0MM BOLT LENGTH	48	13.5
10	20	BALL VALVE 1100 PSI SW	1	2.3
11	150	CHECK VALVE	1	-
TOTAL ERECTION WEIGHT				16.5
TOTAL WEIGHT - THIS DRG				365.6

CUT PIPE LENGTH

PIECE NO	LENGTH (MM)	NPD (MM)	REMARKS	PIECE NO	LENGTH (MM)	NPD (MM)	REMARKS
<A>	4287	150			192	150	
<C>	100	20		<D>	100	20	
<E>	255	150		<F>	732	150	

SCALE: NTS
PROJECT: SPR 120MW SPP PROJECT
TITLE: ISOMETRIC DRAWING FOR PIPING NATURAL GAS SYSTEM




JURONG ENGINEERING LTD

JOB NO. 20036
DRAWING NO. X651-018
PROJECT DRAWING NO. SPR-10-EK-PI-P4018
REV. 17/59

Model No.: 00391 10EKG31-BR002-EB5-150-VIII TRAIN- 01

NDT TEST		PRESS. (Bar g)			TEMP. (Deg C)		PIPING SPEC	LINE NO :
SHOP	FIELD	OPERATING	DESIGN	TEST	OPERATING	DESIGN	EB5	10EKG31-BR002-EB5-150-VIII
10%RT / 10%PT	10%RT / 10%PT	31	40	60	105	150	INSULATION (MM) 25	TRAIN NO: 10EKG31-BR002-EB5-150-VIII TRAIN- 01

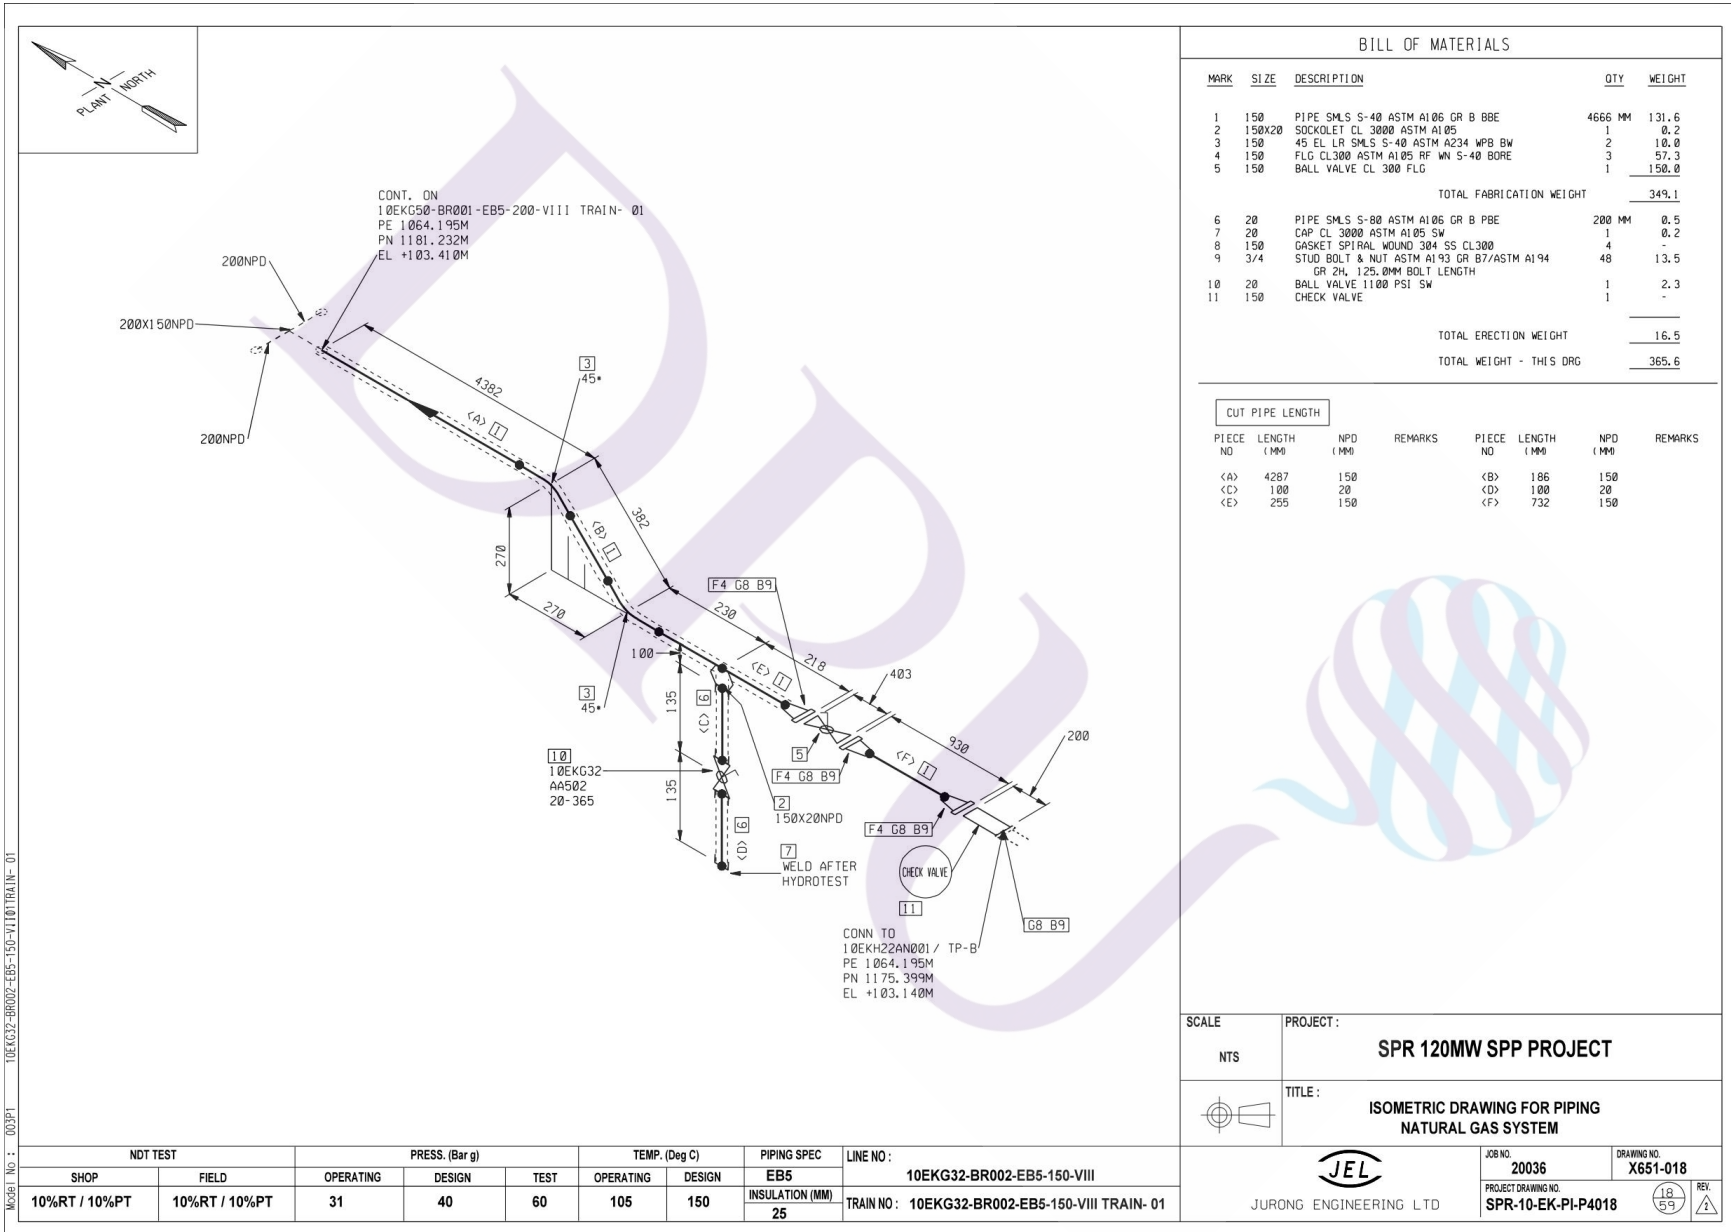

BILL OF MATERIALS

MARK	SIZE	DESCRIPTION	QTY	WEIGHT
1	150	PIPE SMLS S-40 ASTM A106 GR B BBE	4666 MM	131.6
2	150X20	SOCKET CL 3000 ASTM A105	1	0.2
3	150	45 EL L/R SMLS S-40 ASTM A234 WPB BW	2	10.0
4	150	FLG CL300 ASTM A105 RF WN S-40 BORE	3	57.3
5	150	BALL VALVE CL 300 FLG	1	150.0
TOTAL FABRICATION WEIGHT				349.1
6	20	PIPE SMLS S-80 ASTM A106 GR B PBE	200 MM	0.5
7	20	CAP CL 3000 ASTM A105 SW	1	0.2
8	150	GASKET SPIRAL WOUND 304 SS CL300	4	-
9	3/4	STUD BOLT & NUT ASTM A193 GR B7/ASTM A194 GR 2H, 125.0MM BOLT LENGTH	48	13.5
10	20	BALL VALVE 1100 PSI SW	1	2.3
11	150	CHECK VALVE	1	-
TOTAL ERECTION WEIGHT				16.5
TOTAL WEIGHT - THIS DRG				365.6

CUT PIPE LENGTH

PIECE NO	LENGTH (MM)	NPD (MM)	REMARKS	PIECE NO	LENGTH (MM)	NPD (MM)	REMARKS
<A>	4287	150			186	150	
<C>	100	20		<D>	100	20	
<E>	255	150		<F>	732	150	

SCALE: NTS

PROJECT: **SPR 120MW SPP PROJECT**

TITLE: **ISOMETRIC DRAWING FOR PIPING NATURAL GAS SYSTEM**

JEL JURONG ENGINEERING LTD


JOB NO. 20036 DRAWING NO. X651-018

PROJECT DRAWING NO. SPR-10-EK-PI-P4018

REV. 1/59

Model No.: 00391 10EKG32-BR002-EB5-150-VIII TRAIN- 01

NDT TEST		PRESS. (Bar g)			TEMP. (Deg C)		PIPING SPEC	LINE NO :
SHOP	FIELD	OPERATING	DESIGN	TEST	OPERATING	DESIGN	EB5	10EKG32-BR002-EB5-150-VIII
10%RT / 10%PT	10%RT / 10%PT	31	40	60	105	150	INSULATION (MM) 25	TRAIN NO : 10EKG32-BR002-EB5-150-VIII TRAIN- 01

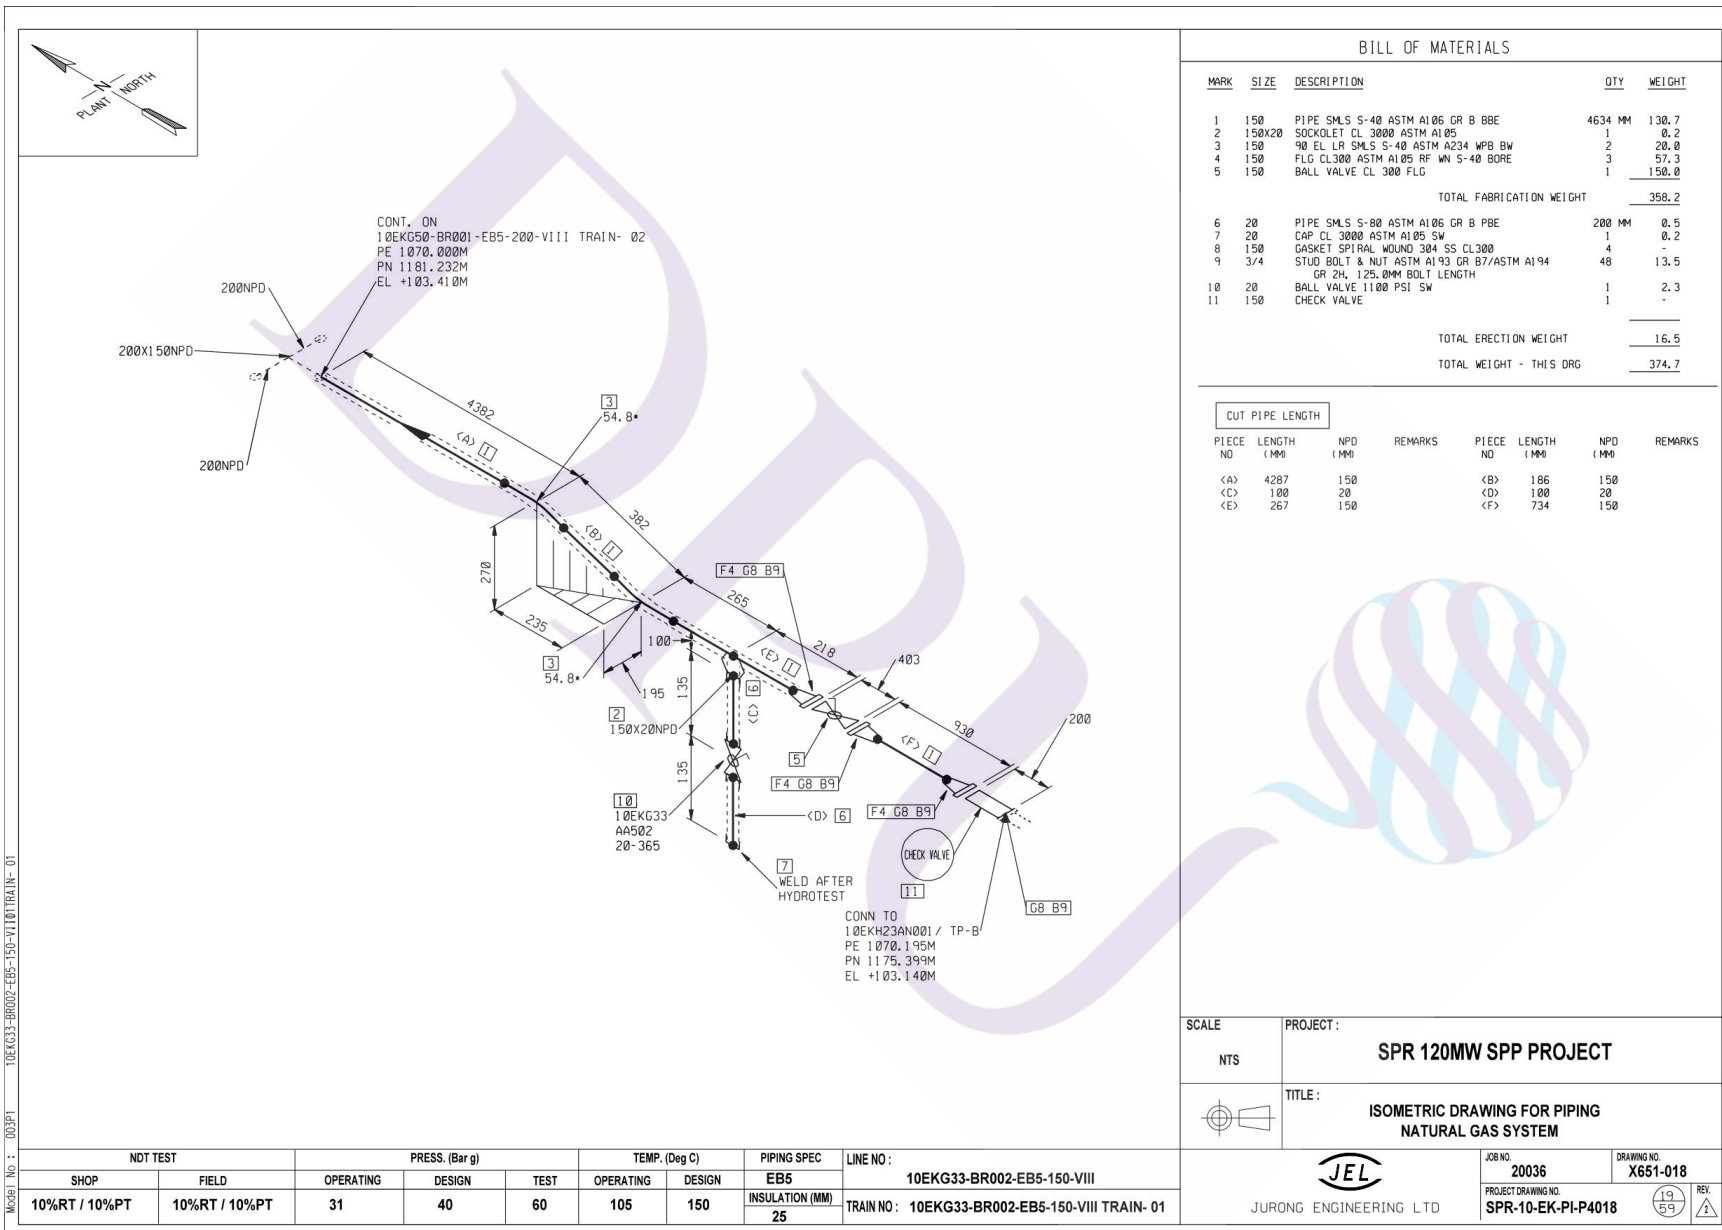

BILL OF MATERIALS

MARK	SIZE	DESCRIPTION	QTY	WEIGHT
1	150	PIPE SMLS S-40 ASTM A106 GR B BBE	4634 MM	130.7
2	150X20	SOCKET CL 3000 ASTM A105	1	0.2
3	150	90 EL L/R SMLS S-40 ASTM A234 WPB BW	2	20.0
4	150	FLG CL300 ASTM A105 RF WN S-40 BORE	3	57.3
5	150	BALL VALVE CL 300 FLG	1	150.0
TOTAL FABRICATION WEIGHT				358.2
6	20	PIPE SMLS S-80 ASTM A106 GR B PBE	200 MM	0.5
7	20	CAP CL 3000 ASTM A105 SW	1	0.2
8	150	GASKET SPIRAL WOUND 304 SS CL300	4	-
9	3/4	STUD BOLT & NUT ASTM A193 GR B7/ASTM A194 GR 2H, 125.0MM BOLT LENGTH	48	13.5
10	20	BALL VALVE 1100 PSI SW	1	2.3
11	150	CHECK VALVE	1	-
TOTAL ERECTION WEIGHT				16.5
TOTAL WEIGHT - THIS DRG				374.7

CUT PIPE LENGTH

PIECE NO	LENGTH (MM)	NPD (MM)	REMARKS	PIECE NO	LENGTH (MM)	NPD (MM)	REMARKS
<A>	4287	150			186	150	
<C>	100	20		<D>	100	20	
<E>	267	150		<F>	734	150	

SCALE: NTS PROJECT: SPR 120MW SPP PROJECT

TITLE: ISOMETRIC DRAWING FOR PIPING NATURAL GAS SYSTEM

JEL JURONG ENGINEERING LTD


JOB NO. 20036 DRAWING NO. X651-018

PROJECT DRAWING NO. SPR-10-EK-PI-P4018

REV. 19/59

Model No.: 10EKG33-BR002-EB5-150-VIII TRAIN-01

NDT TEST			PRESS. (Bar g)			TEMP. (Deg C)		PIPING SPEC	LINE NO :
SHOP	FIELD	OPERATING	DESIGN	TEST	OPERATING	DESIGN	EB5	10EKG33-BR002-EB5-150-VIII	
10%RT / 10%PT	10%RT / 10%PT	31	40	60	105	150	INSULATION (MM) 25	TRAIN NO: 10EKG33-BR002-EB5-150-VIII TRAIN-01	

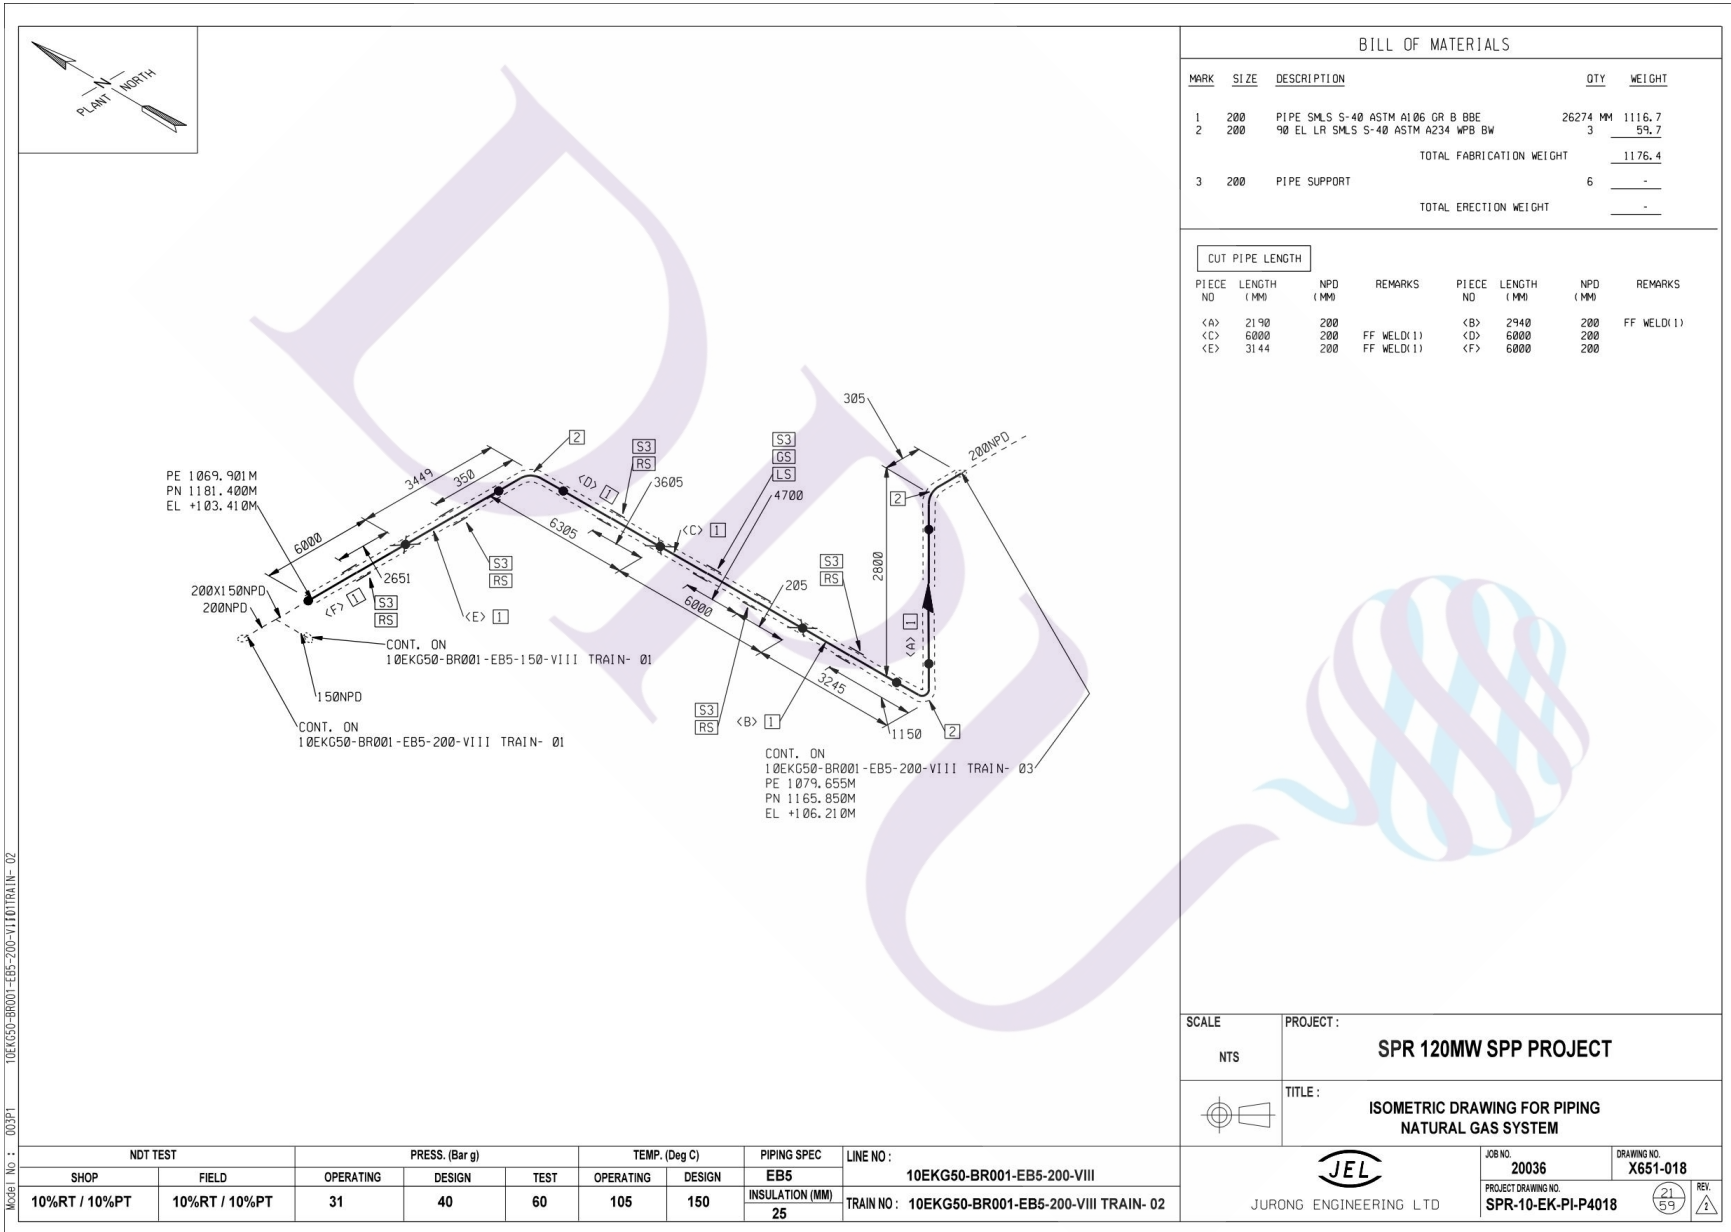

BILL OF MATERIALS

MARK	SIZE	DESCRIPTION	QTY	WEIGHT
1	200	PIPE SMLS S-40 ASTM A106 GR B BBE	26274 MM	1116.7
2	200	90 EL LR SMLS S-40 ASTM A234 WPB BW	3	59.7
TOTAL FABRICATION WEIGHT				1176.4
3	200	PIPE SUPPORT	6	-
TOTAL ERECTION WEIGHT				-

CUT PIPE LENGTH

PIECE NO	LENGTH (MM)	NPD (MM)	REMARKS	PIECE NO	LENGTH (MM)	NPD (MM)	REMARKS
<A>	2190	200			2940	200	FF WELDI 1)
<C>	6000	200	FF WELDI 1)	<D>	6000	200	
<E>	3144	200	FF WELDI 1)	<F>	6000	200	

SCALE: NTS

PROJECT: **SPR 120MW SPP PROJECT**

TITLE: **ISOMETRIC DRAWING FOR PIPING NATURAL GAS SYSTEM**


Model No.: 003P1 10EKG50-BR001-EB5-200-VIII TRAIN- 02

NDT TEST		PRESS. (Bar g)			TEMP. (Deg C)		PIPING SPEC	LINE NO :
SHOP	FIELD	OPERATING	DESIGN	TEST	OPERATING	DESIGN	EB5	10EKG50-BR001-EB5-200-VIII
10%RT / 10%PT	10%RT / 10%PT	31	40	60	105	150	INSULATION (MM) 25	TRAIN NO : 10EKG50-BR001-EB5-200-VIII TRAIN- 02

JEL

JURONG ENGINEERING LTD

JOB NO. 20036	DRAWING NO. X651-018
PROJECT DRAWING NO. SPR-10-EK-PI-P4018	REV. 21/59

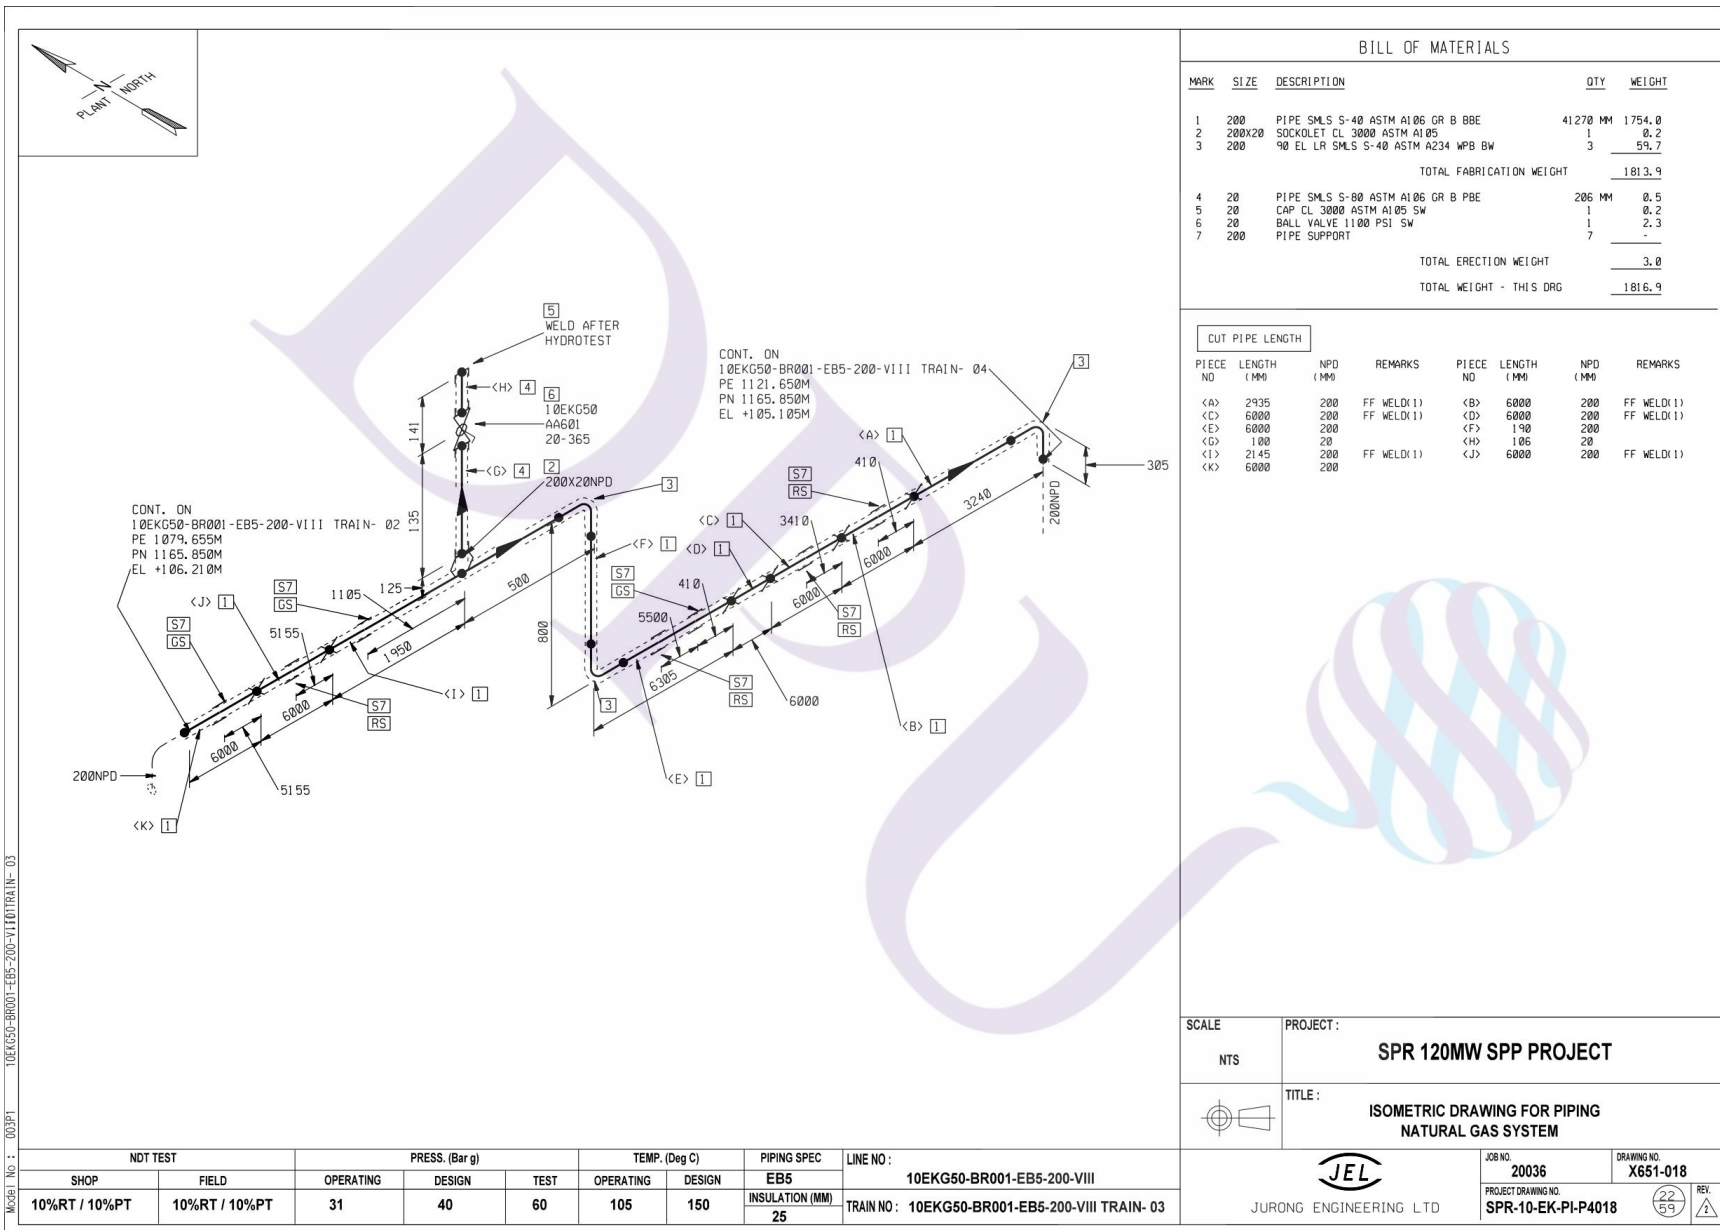

BILL OF MATERIALS

MARK	SIZE	DESCRIPTION	QTY	WEIGHT
1	200	PIPE SMLS S-40 ASTM A106 GR B BBE	41270 MM	1754.0
2	200X20	SOCKET CL 3000 ASTM A105	1	0.2
3	200	90 EL LR SMLS S-40 ASTM A234 WPB BW	3	59.7
TOTAL FABRICATION WEIGHT				1813.9
4	20	PIPE SMLS S-80 ASTM A106 GR B PBE	206 MM	0.5
5	20	CAP CL 3000 ASTM A105 SW	1	0.2
6	20	BALL VALVE 1100 PSI SW	1	2.3
7	200	PIPE SUPPORT	7	-
TOTAL ERECTION WEIGHT				3.0
TOTAL WEIGHT - THIS DRG				1816.9

CUT PIPE LENGTH

PIECE NO	LENGTH (MM)	NPD (MM)	REMARKS	PIECE NO	LENGTH (MM)	NPD (MM)	REMARKS
<A>	2935	200	FF WELD(1)		6000	200	FF WELD(1)
<C>	6000	200	FF WELD(1)	<D>	6000	200	FF WELD(1)
<E>	6000	200		<F>	190	200	
<G>	100	20		<H>	106	20	
<I>	2145	200	FF WELD(1)	<J>	6000	200	FF WELD(1)
<K>	6000	200					

SCALE: NTS PROJECT: **SPR 120MW SPP PROJECT**

TITLE: **ISOMETRIC DRAWING FOR PIPING NATURAL GAS SYSTEM**


Model No.: 00391 10EKG50-BR001-EB5-200-VIII TRAIN-03

NDT TEST		PRESS. (Bar g)			TEMP. (Deg C)		PIPING SPEC	LINE NO :
SHOP	FIELD	OPERATING	DESIGN	TEST	OPERATING	DESIGN	EB5	10EKG50-BR001-EB5-200-VIII
10%RT / 10%PT	10%RT / 10%PT	31	40	60	105	150	INSULATION (MM) 25	TRAIN NO: 10EKG50-BR001-EB5-200-VIII TRAIN-03



JURONG ENGINEERING LTD

JOB NO. 20036	DRAWING NO. X651-018
PROJECT DRAWING NO. SPR-10-EK-PI-P4018	REV. 22/59

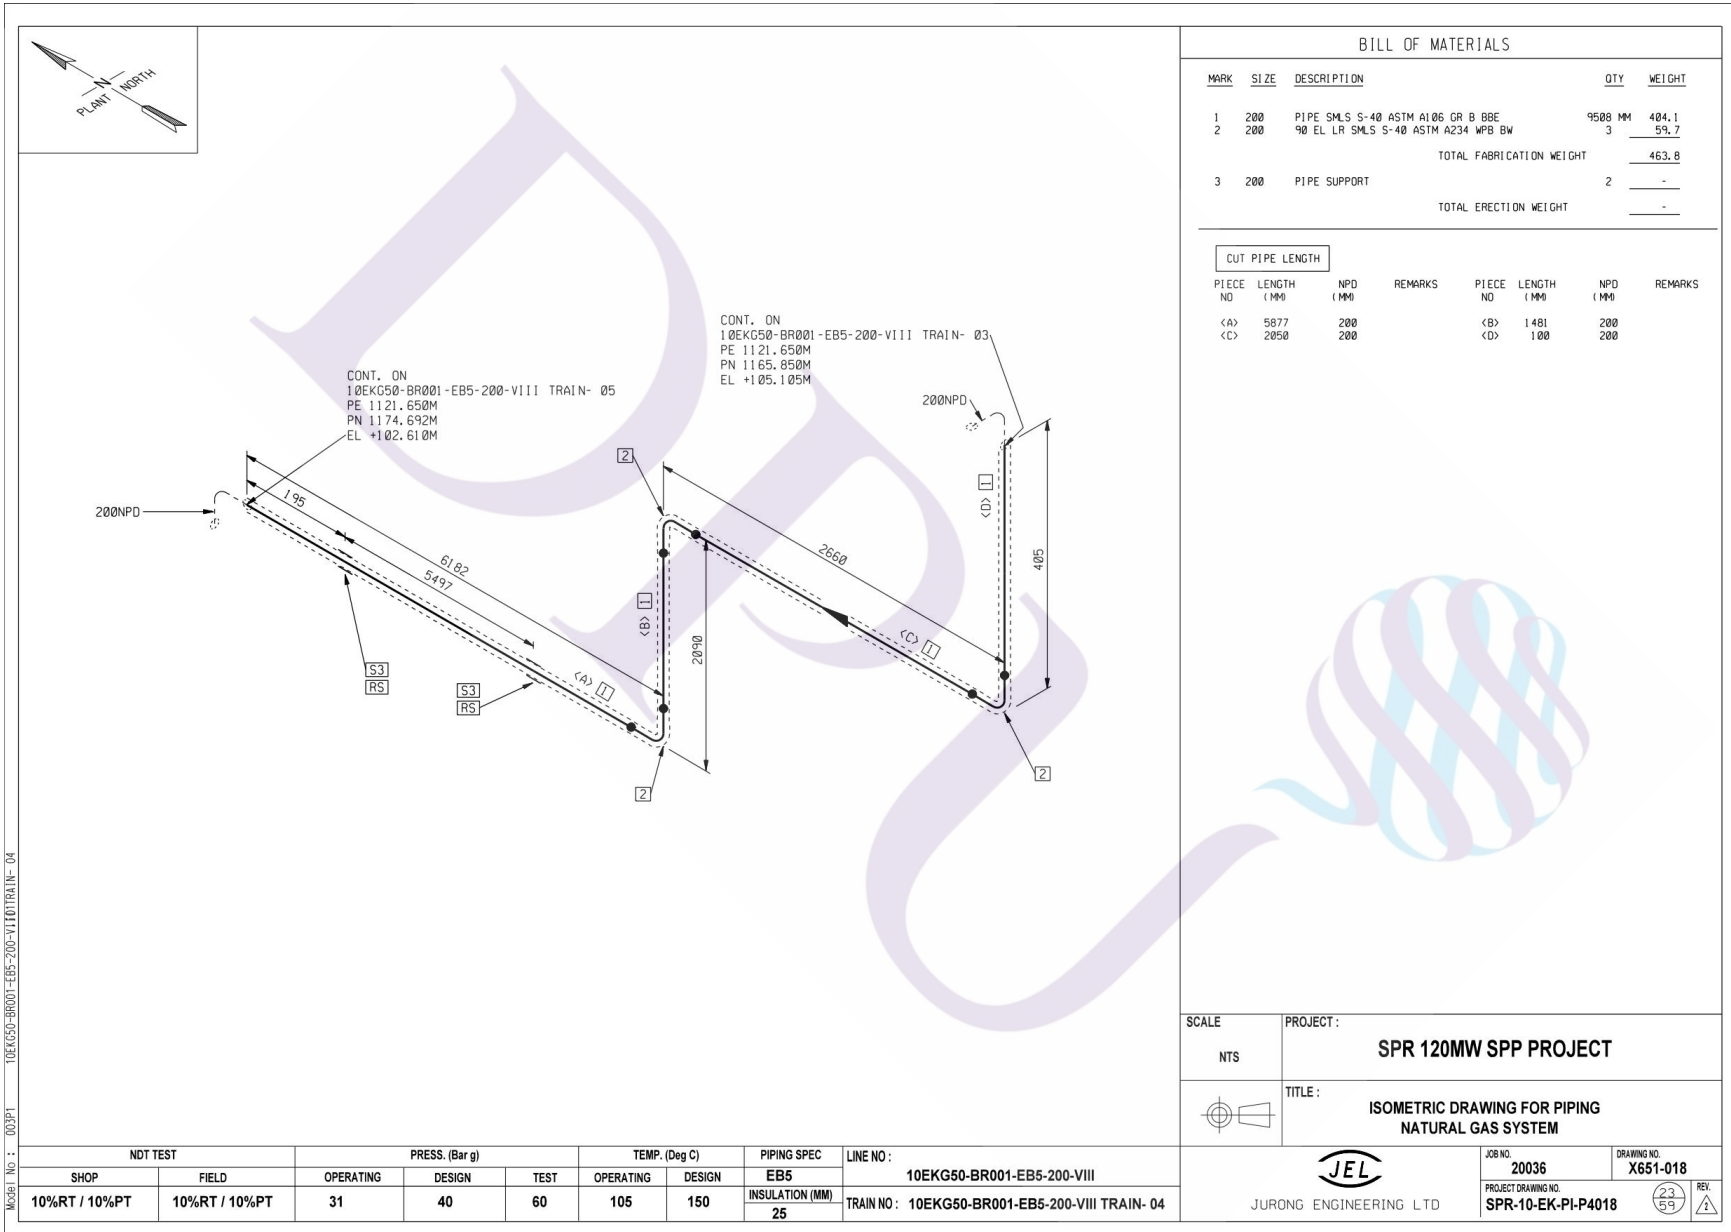

BILL OF MATERIALS

MARK	SIZE	DESCRIPTION	QTY	WEIGHT
1	200	PIPE SMLS S-40 ASTM A106 GR B BBE	9500 MM	404.1
2	200	90 EL. LR SMLS S-40 ASTM A234 WPB BW	3	59.7
TOTAL FABRICATION WEIGHT				463.8
3	200	PIPE SUPPORT	2	-
TOTAL ERECTION WEIGHT				-

CUT PIPE LENGTH

PIECE NO	LENGTH (MM)	NPD (MM)	REMARKS	PIECE NO	LENGTH (MM)	NPD (MM)	REMARKS
<A>	5877	200			1481	200	
<C>	2050	200		<D>	100	200	


SCALE NTS	PROJECT: SPR 120MW SPP PROJECT
	TITLE: ISOMETRIC DRAWING FOR PIPING NATURAL GAS SYSTEM

Model No.: 003P1 10EKG50-BR001-EB5-200-VIII TRAIN- 04

NDT TEST		PRESS. (Bar g)			TEMP. (Deg C)		PIPING SPEC	LINE NO :
SHOP	FIELD	OPERATING	DESIGN	TEST	OPERATING	DESIGN	EB5	10EKG50-BR001-EB5-200-VIII
10%RT / 10%PT	10%RT / 10%PT	31	40	60	105	150	INSULATION (MM) 25	TRAIN NO : 10EKG50-BR001-EB5-200-VIII TRAIN- 04

JURONG ENGINEERING LTD

JOB NO. 20036	DRAWING NO. X651-018
PROJECT DRAWING NO. SPR-10-EK-PI-P4018	REV.

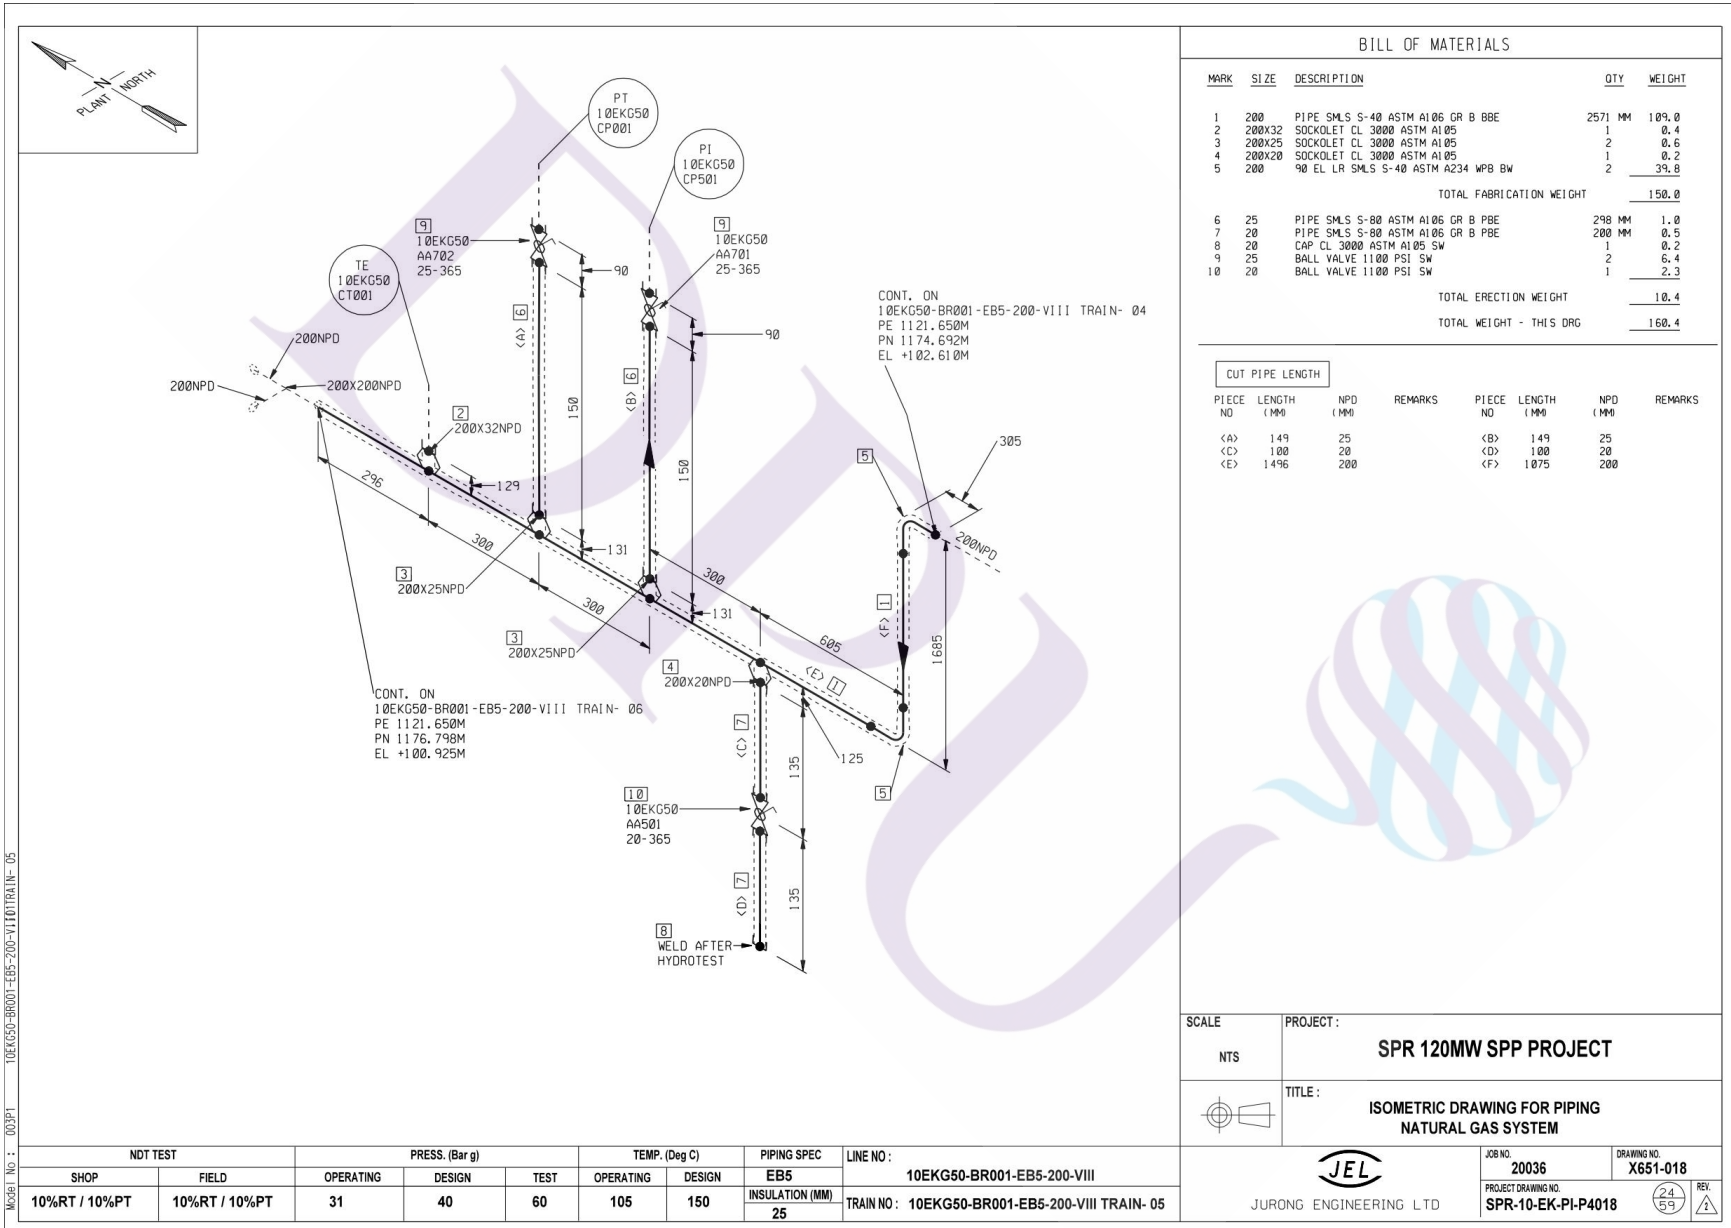

BILL OF MATERIALS

MARK	SIZE	DESCRIPTION	QTY	WEIGHT
1	200	PIPE SMLS S-40 ASTM A106 GR B BBE	2571	MM 109.0
2	200X32	SOCKET CL 3000 ASTM A105	1	0.4
3	200X25	SOCKET CL 3000 ASTM A105	2	0.6
4	200X20	SOCKET CL 3000 ASTM A105	1	0.2
5	200	90 EL LR SMLS S-40 ASTM A234 WPB BW	2	39.8
TOTAL FABRICATION WEIGHT				150.0
6	25	PIPE SMLS S-80 ASTM A106 GR B PBE	298	MM 1.0
7	20	PIPE SMLS S-80 ASTM A106 GR B PBE	200	MM 0.5
8	20	CAP CL 3000 ASTM A105 SW	1	0.2
9	25	BALL VALVE 1100 PSI SW	2	6.4
10	20	BALL VALVE 1100 PSI SW	1	2.3
TOTAL ERECTION WEIGHT				10.4
TOTAL WEIGHT - THIS DRG				160.4

CUT PIPE LENGTH

PIECE NO	LENGTH (MM)	NPD (MM)	REMARKS	PIECE NO	LENGTH (MM)	NPD (MM)	REMARKS
<A>	149	25			149	25	
<C>	100	20		<D>	100	20	
<E>	1496	200		<F>	1075	200	

SCALE: NTS PROJECT: **SPR 120MW SPP PROJECT**

TITLE: **ISOMETRIC DRAWING FOR PIPING NATURAL GAS SYSTEM**


Model No.: 003PT 10EKG50-BR001-EB5-200-VIII TRAIN- 05

NDT TEST			PRESS. (Bar g)			TEMP. (Deg C)		PIPING SPEC	LINE NO :
SHOP	FIELD		OPERATING	DESIGN	TEST	OPERATING	DESIGN	EB5	10EKG50-BR001-EB5-200-VIII
10%RT / 10%PT	10%RT / 10%PT		31	40	60	105	150	INSULATION (MM) 25	TRAIN NO: 10EKG50-BR001-EB5-200-VIII TRAIN- 05

JEL

JURONG ENGINEERING LTD

JOB NO. 20036	DRAWING NO. X651-018
PROJECT DRAWING NO. SPR-10-EK-PI-P4018	REV. 24/59

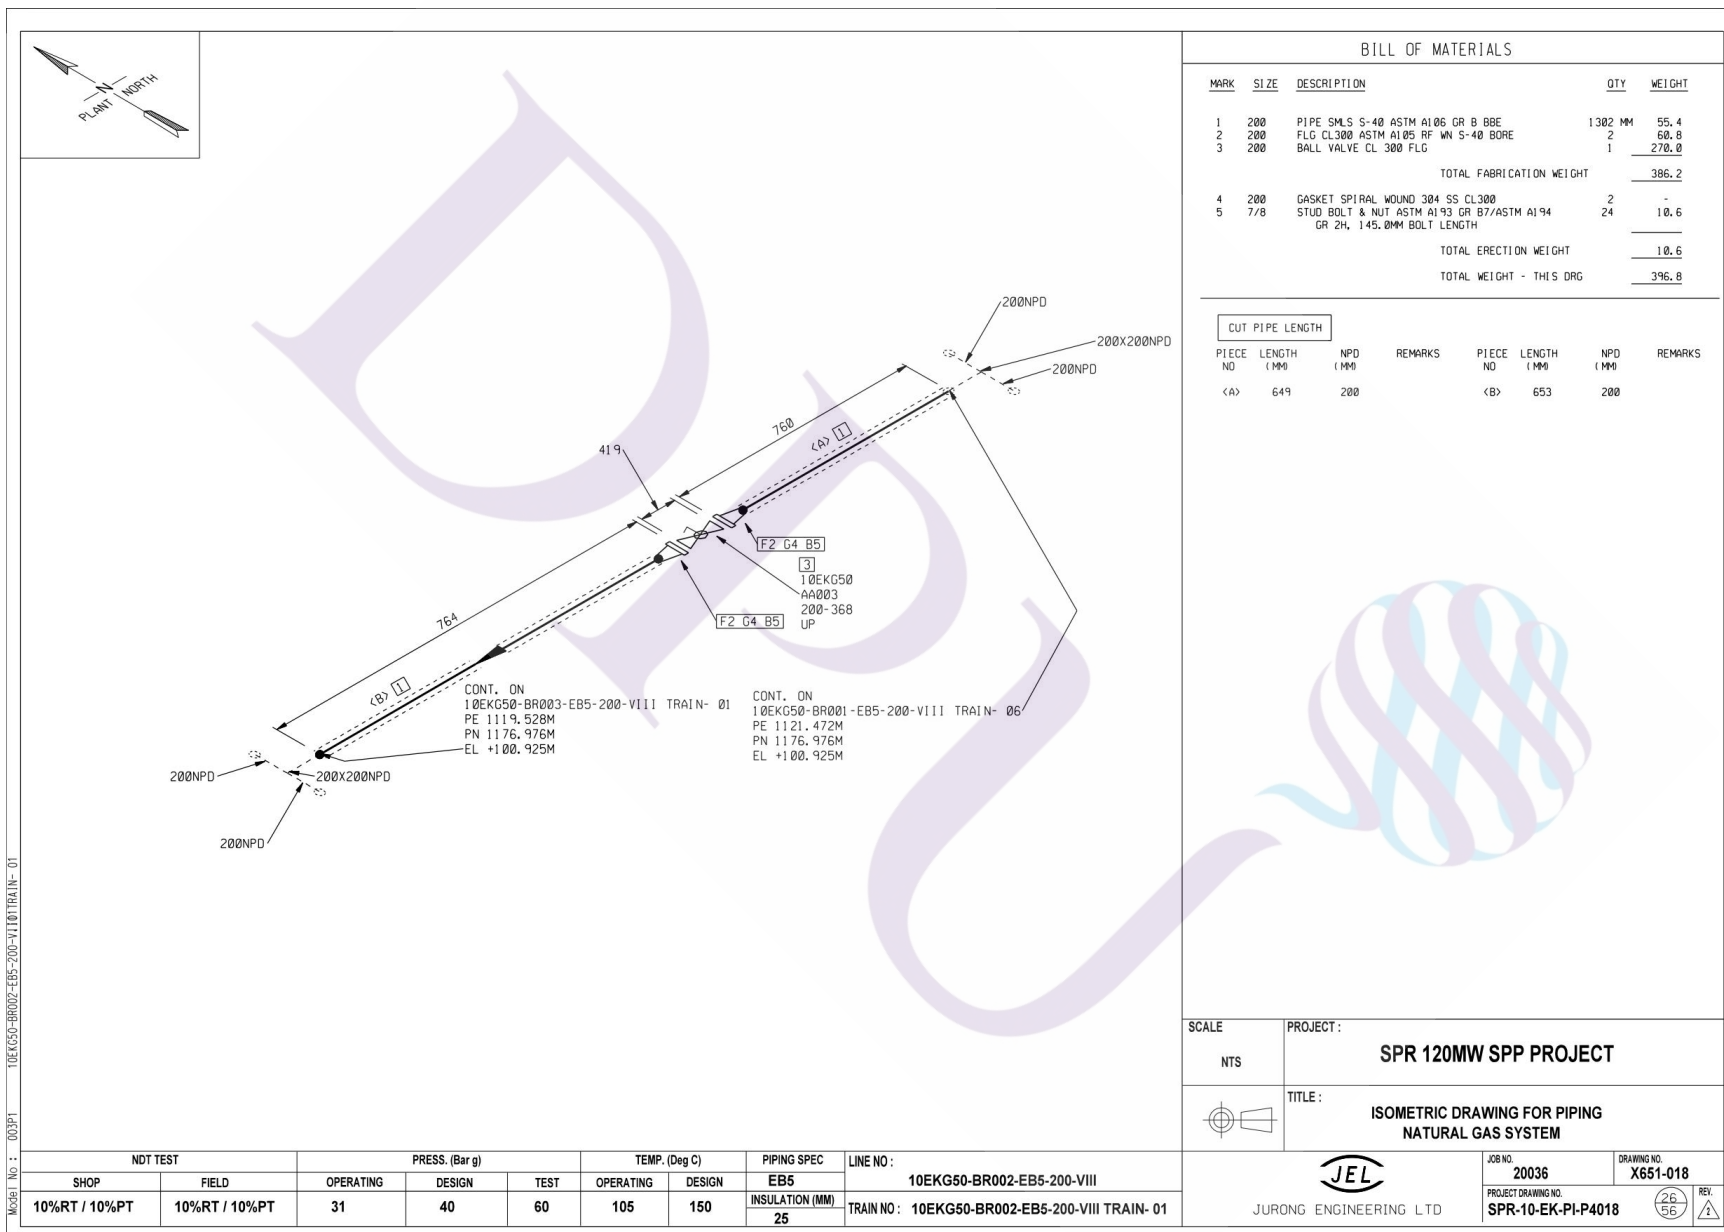

BILL OF MATERIALS

MARK	SIZE	DESCRIPTION	QTY	WEIGHT
1	200	PIPE SMLS S-40 ASTM A106 GR B BBE	1302 MM	55.4
2	200	FLG CL300 ASTM A105 RF WN S-40 BORE	2	60.8
3	200	BALL VALVE CL 300 FLG	1	270.0
TOTAL FABRICATION WEIGHT				386.2
4	200	GASKET SPIRAL WOUND 304 SS CL300	2	-
5	7/8	STUD BOLT & NUT ASTM A193 GR B7/ASTM A194 GR 2H, 145.0MM BOLT LENGTH	24	10.6
TOTAL ERECTION WEIGHT				10.6
TOTAL WEIGHT - THIS DRG				396.8

CUT PIPE LENGTH

PIECE NO	LENGTH (MM)	NPD (MM)	REMARKS	PIECE NO	LENGTH (MM)	NPD (MM)	REMARKS
<A>	649	200			653	200	

SCALE	PROJECT :
NTS	SPR 120MW SPP PROJECT
TITLE :	ISOMETRIC DRAWING FOR PIPING NATURAL GAS SYSTEM


Model No : 003P1 10EKG50-BR002-EB5-200-VIII TRAIN- 01

NDT TEST		PRESS. (Bar g)			TEMP. (Deg C)		PIPING SPEC	LINE NO :
SHOP	FIELD	OPERATING	DESIGN	TEST	OPERATING	DESIGN	EB5	10EKG50-BR002-EB5-200-VIII
10%RT / 10%PT	10%RT / 10%PT	31	40	60	105	150	INSULATION (MM)	TRAIN NO : 10EKG50-BR002-EB5-200-VIII TRAIN- 01
							25	

JEL

JURONG ENGINEERING LTD

JOB NO.	DRAWING NO.
20036	X651-018
PROJECT DRAWING NO.	REV.
SPR-10-EK-PI-P4018	2/5

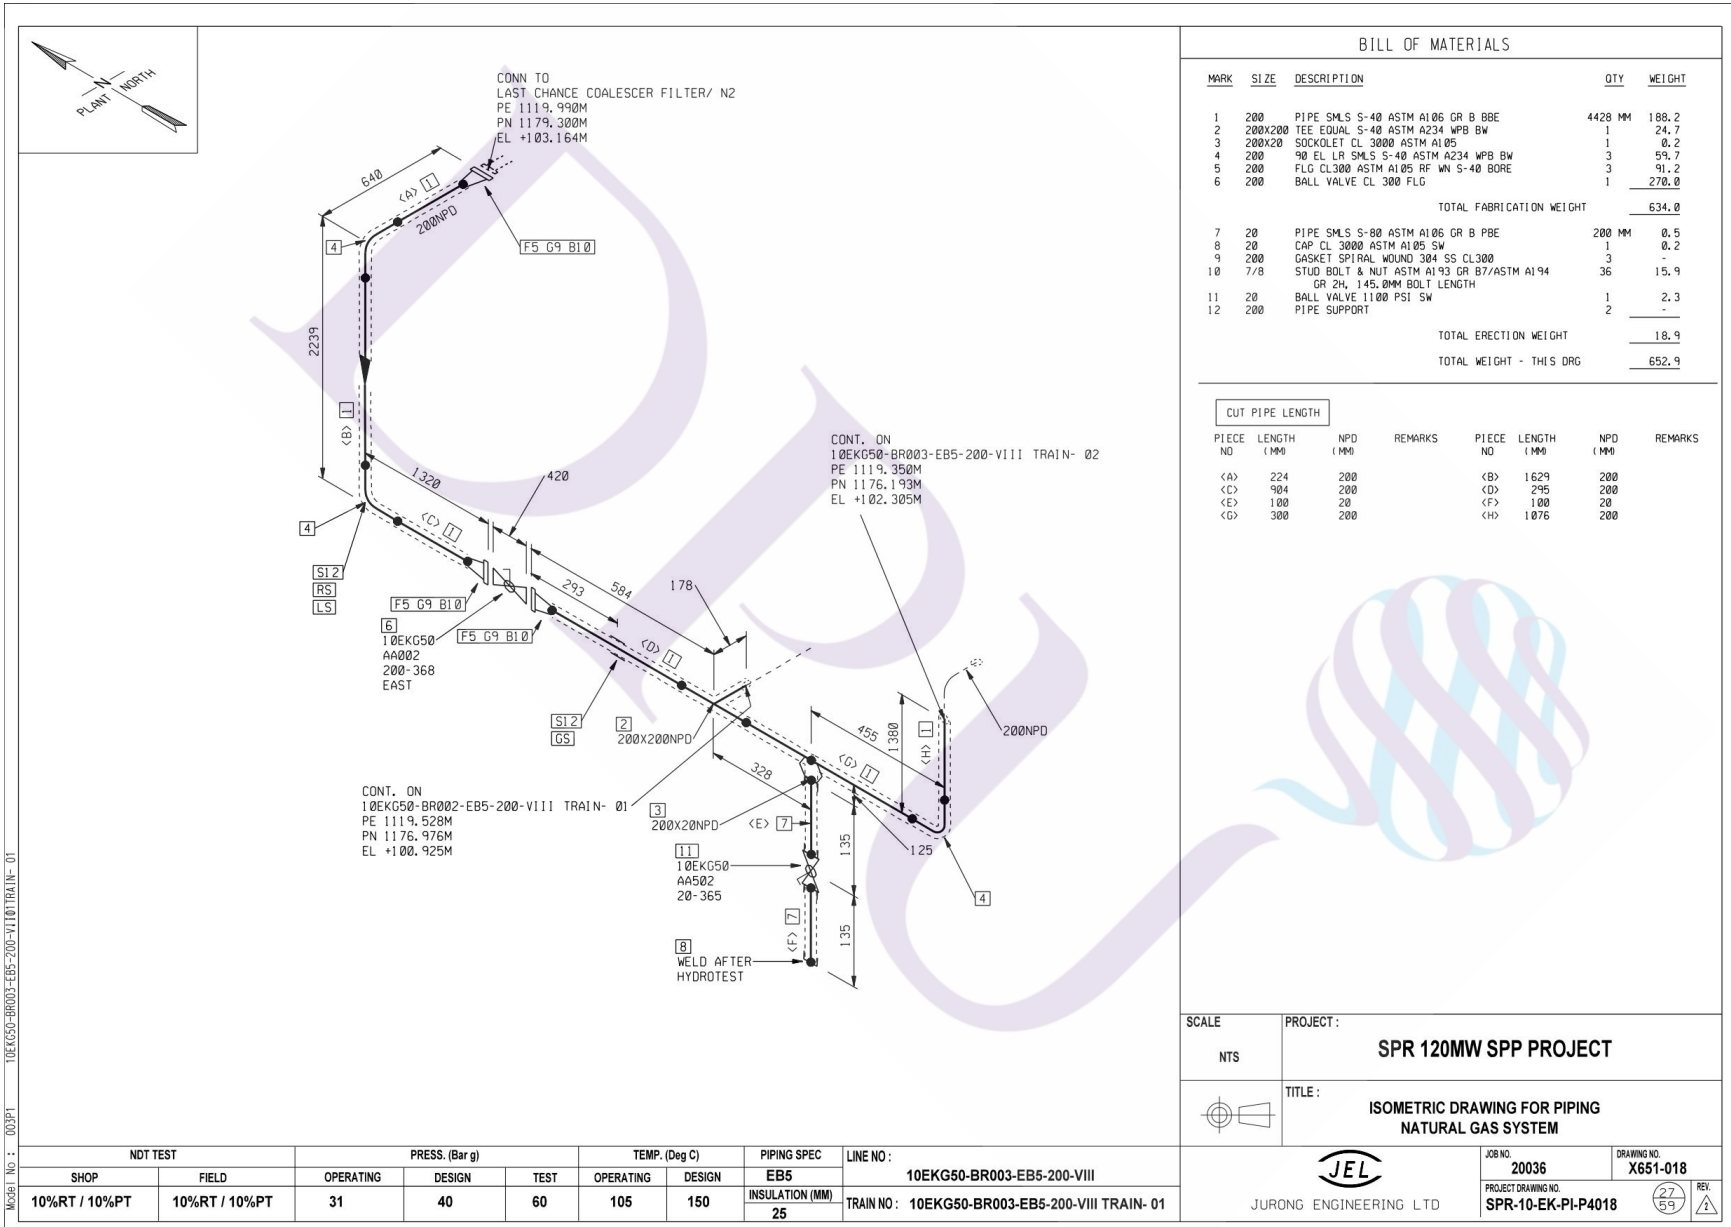

BILL OF MATERIALS

MARK	SIZE	DESCRIPTION	QTY	WEIGHT
1	200	PIPE SMLS S-40 ASTM A106 GR B BBE	4428 MM	188.2
2	200X200	TEE EQUAL S-40 ASTM A234 WPB BW	1	24.7
3	200X20	SOCKET CL 3000 ASTM A105	1	0.2
4	200	90 EL LR SMLS S-40 ASTM A234 WPB BW	3	59.7
5	200	FLG CL300 ASTM A105 RF WN S-40 BORE	3	91.2
6	200	BALL VALVE CL 300 FLG	1	270.0
TOTAL FABRICATION WEIGHT				634.0
7	20	PIPE SMLS S-80 ASTM A106 GR B PBE	200 MM	0.5
8	20	CAP CL 3000 ASTM A105 SW	1	0.2
9	200	GASKET SPIRAL WOUND 304 SS CL300	3	-
10	7/8	STUD BOLT & NUT ASTM A193 GR B7/ASTM A194 GR 2H, 145.0MM BOLT LENGTH	36	15.9
11	20	BALL VALVE 1100 PSI SW	1	2.3
12	200	PIPE SUPPORT	2	-
TOTAL ERECTION WEIGHT				18.9
TOTAL WEIGHT - THIS DRG				652.9

CUT PIPE LENGTH

PIECE NO	LENGTH (MM)	NPD (MM)	REMARKS	PIECE NO	LENGTH (MM)	NPD (MM)	REMARKS
<A>	224	200			1629	200	
<C>	904	200		<D>	295	200	
<E>	100	20		<F>	100	20	
<G>	300	200		<H>	1076	200	

SCALE: NTS

PROJECT: **SPR 120MW SPP PROJECT**

TITLE: **ISOMETRIC DRAWING FOR PIPING NATURAL GAS SYSTEM**

JEL
JURONG ENGINEERING LTD


JOB NO. 20036
DRAWING NO. X651-018

PROJECT DRAWING NO. SPR-10-EK-PI-P4018

REV. 27/59

Model No.: 003PI 10EKG50-BR003-EB5-200-VIII TRAIN- 01

NDT TEST			PRESS. (Bar g)			TEMP. (Deg C)		PIPING SPEC	LINE NO :
SHOP	FIELD	OPERATING	DESIGN	TEST	OPERATING	DESIGN	EB5	10EKG50-BR003-EB5-200-VIII	
10%RT / 10%PT	10%RT / 10%PT	31	40	60	105	150	INSULATION (MM) 25	TRAIN NO: 10EKG50-BR003-EB5-200-VIII TRAIN- 01	

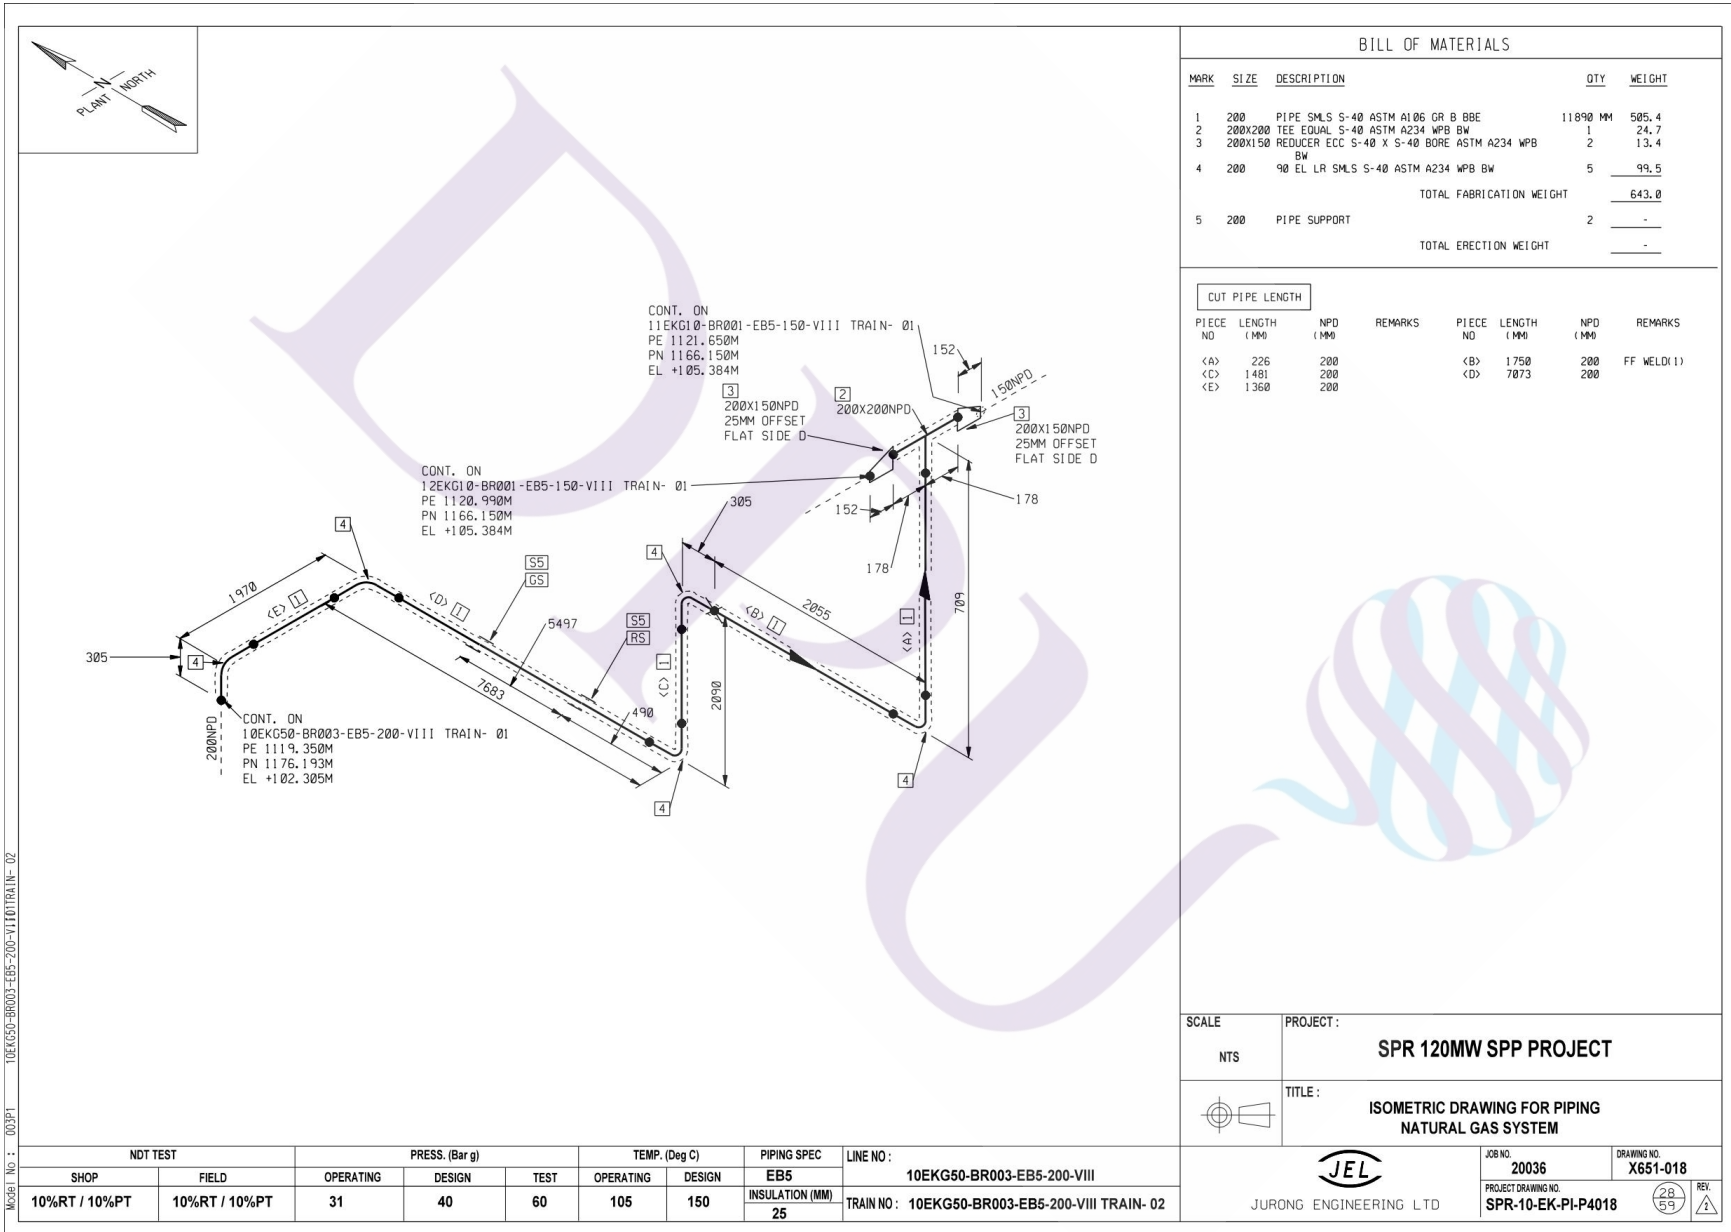

BILL OF MATERIALS

MARK	SIZE	DESCRIPTION	QTY	WEIGHT
1	200	PIPE SMLS S-40 ASTM A106 GR B BBE	11890 MM	505.4
2	200X200	TEE EDUAL S-40 ASTM A234 WPB BW	1	24.7
3	200X150	REDUCER ECC S-40 X S-40 BORE ASTM A234 WPB BW	2	13.4
4	200	90 EL LR SMLS S-40 ASTM A234 WPB BW	5	99.5
TOTAL FABRICATION WEIGHT				643.0
5	200	PIPE SUPPORT	2	-
TOTAL ERECTION WEIGHT				-

CUT PIPE LENGTH

PIECE NO	LENGTH (MM)	NPD (MM)	REMARKS	PIECE NO	LENGTH (MM)	NPD (MM)	REMARKS
<A>	226	200			1750	200	FF WELD(1)
<C>	1481	200		<D>	7073	200	
<E>	1360	200					

SCALE: NTS PROJECT: SPR 120MW SPP PROJECT

TITLE: ISOMETRIC DRAWING FOR PIPING NATURAL GAS SYSTEM

JEL JURONG ENGINEERING LTD


JOB NO. 20036 DRAWING NO. X651-018

PROJECT DRAWING NO. SPR-10-EK-PI-P4018

REV. 2/5

Model No.: 003PI 10EKG50-BR003-EB5-200-VIII TRAIN- 02

NDT TEST		PRESS. (Bar g)			TEMP. (Deg C)		PIPING SPEC	LINE NO :
SHOP	FIELD	OPERATING	DESIGN	TEST	OPERATING	DESIGN	EB5	10EKG50-BR003-EB5-200-VIII
10%RT / 10%PT	10%RT / 10%PT	31	40	60	105	150	INSULATION (MM) 25	TRAIN NO : 10EKG50-BR003-EB5-200-VIII TRAIN- 02

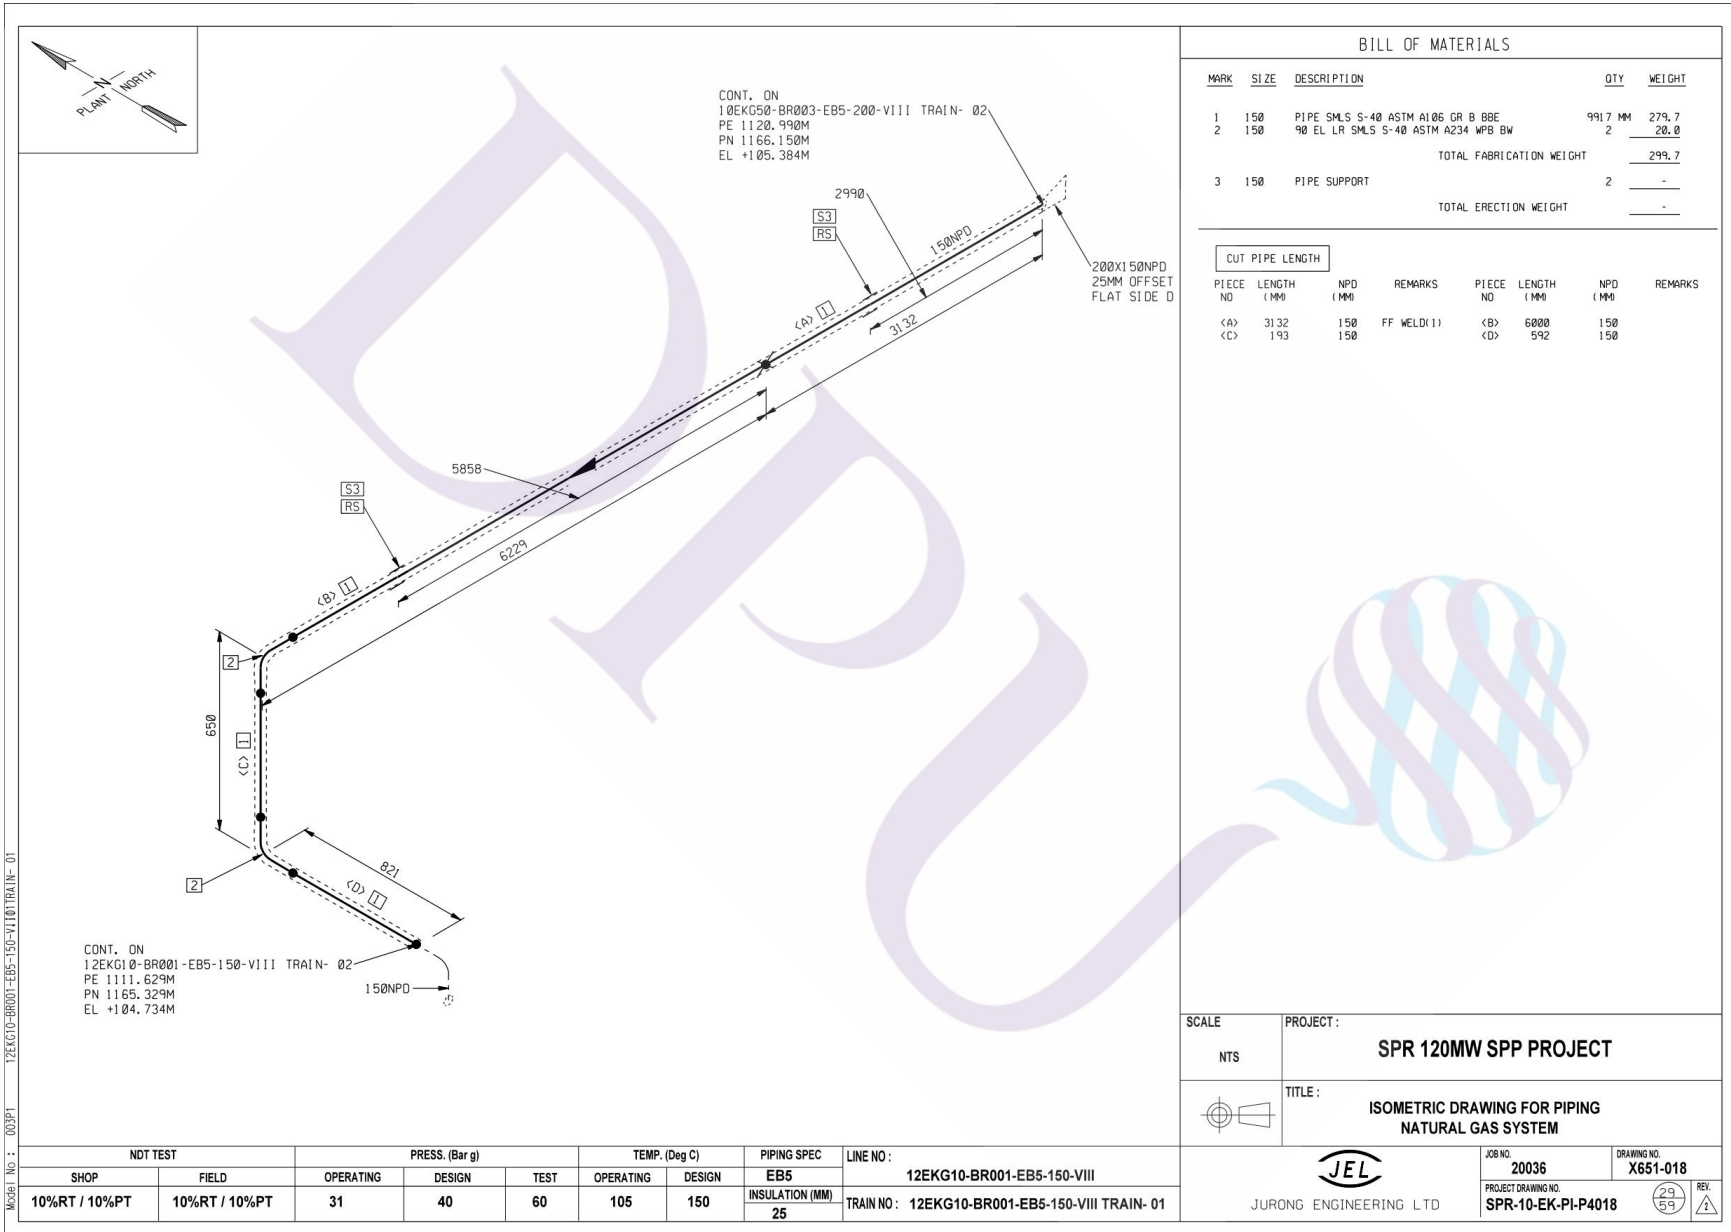

CONT. ON
 10EKG50-BR003-EB5-200-VIII TRAIN- 02
 PE 1120.990M
 PN 1166.150M
 EL +105.384M

CONT. ON
 12EKG10-BR001-EB5-150-VIII TRAIN- 02
 PE 1111.629M
 PN 1165.329M
 EL +104.734M

BILL OF MATERIALS

MARK	SIZE	DESCRIPTION	QTY	WEIGHT
1	150	PIPE SMLS S-40 ASTM A106 GR B BBE	991.7 MM	279.7
2	150	90 EL LR SMLS S-40 ASTM A234 WPB BW	2	20.0
TOTAL FABRICATION WEIGHT				299.7
3	150	PIPE SUPPORT	2	-
TOTAL ERECTION WEIGHT				-

CUT PIPE LENGTH

PIECE NO	LENGTH (MM)	NPD (MM)	REMARKS	PIECE NO	LENGTH (MM)	NPD (MM)	REMARKS
<A>	3132	150	FF WELD(1)		6000	150	
<C>	193	150		<D>	592	150	

SCALE NTS	PROJECT: SPR 120MW SPP PROJECT
	TITLE: ISOMETRIC DRAWING FOR PIPING NATURAL GAS SYSTEM


NDT TEST		PRESS. (Bar g)			TEMP. (Deg C)		PIPING SPEC	LINE NO :
SHOP	FIELD	OPERATING	DESIGN	TEST	OPERATING	DESIGN	EB5	12EKG10-BR001-EB5-150-VIII
10%RT / 10%PT	10%RT / 10%PT	31	40	60	105	150	INSULATION (MM) 25	TRAIN NO : 12EKG10-BR001-EB5-150-VIII TRAIN- 01

JEL
 JURONG ENGINEERING LTD

JOB NO. 20036
 PROJECT DRAWING NO. SPR-10-EK-PI-P4018

DRAWING NO. X651-018
 REV. 29/59

Model No. : 00391 12EKG10-BR001-EB5-150-VIII TRAIN- 01

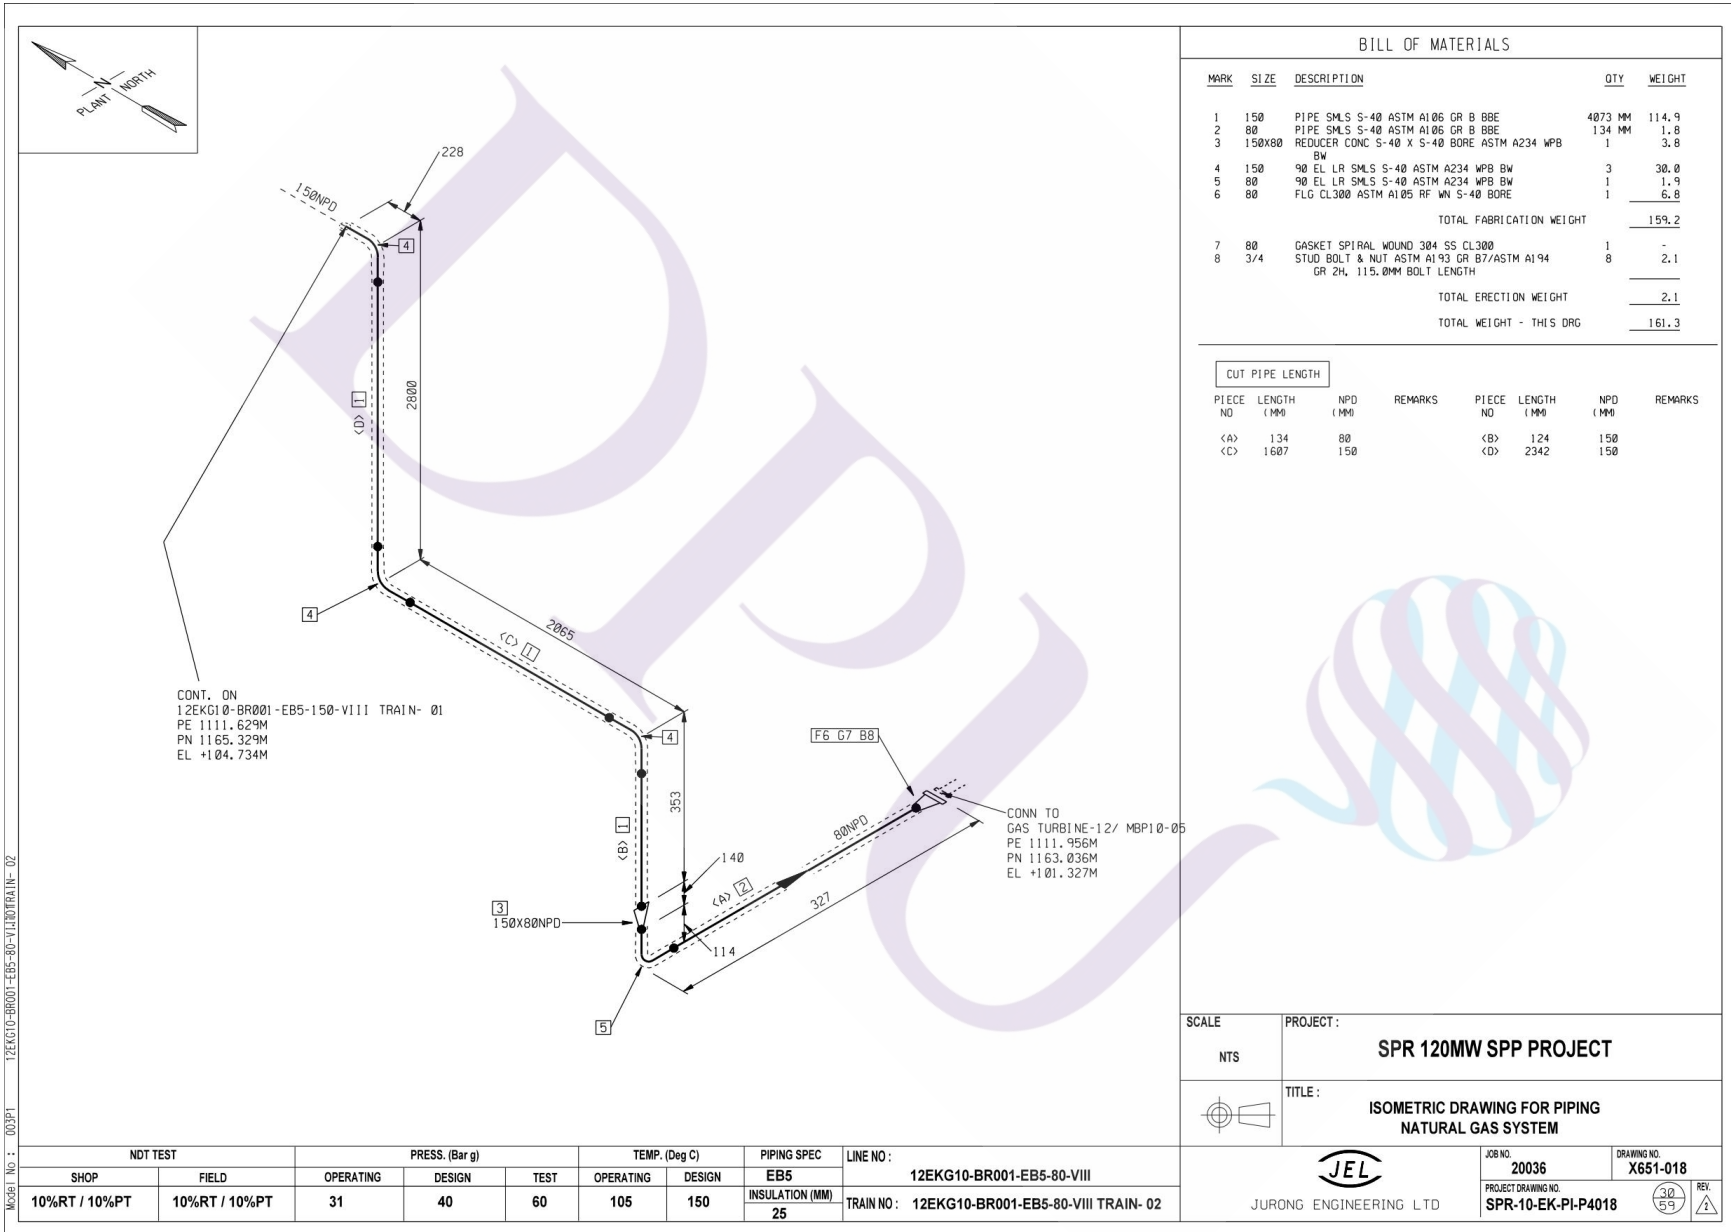

CONT. ON
 12EKG10-BR001-EB5-150-VIII TRAIN- 01
 PE 1111.629M
 PN 1165.329M
 EL +104.734M

CONN TO
 GAS TURBINE-12/ MBP10-05
 PE 1111.956M
 PN 1163.036M
 EL +101.327M

BILL OF MATERIALS

MARK	SIZE	DESCRIPTION	QTY	WEIGHT
1	150	PIPE SMLS S-40 ASTM A106 GR B BBE	4073 MM	114.9
2	80	PIPE SMLS S-40 ASTM A106 GR B BBE	134 MM	1.8
3	150X80	REDUCER CONC S-40 X S-40 BORE ASTM A234 WPB BW	1	3.8
4	150	90 EL LR SMLS S-40 ASTM A234 WPB BW	3	30.0
5	80	90 EL LR SMLS S-40 ASTM A234 WPB BW	1	1.9
6	80	FLG CL300 ASTM A105 RF WN S-40 BORE	1	6.8
TOTAL FABRICATION WEIGHT				159.2
7	80	GASKET SPIRAL WOUND 304 SS CL300	1	-
8	3/4	STUD BOLT & NUT ASTM A193 GR B7/ASTM A194 GR 2H, 115.0MM BOLT LENGTH	8	2.1
TOTAL ERECTION WEIGHT				2.1
TOTAL WEIGHT - THIS DRG				161.3


CUT PIPE LENGTH

PIECE NO	LENGTH (MM)	NPD (MM)	REMARKS	PIECE NO	LENGTH (MM)	NPD (MM)	REMARKS
<A>	134	80			124	150	
<C>	1607	150		<D>	2342	150	

SCALE NTS	PROJECT: SPR 120MW SPP PROJECT
TITLE: ISOMETRIC DRAWING FOR PIPING NATURAL GAS SYSTEM	
JURONG ENGINEERING LTD	JOB NO. 20036 DRAWING NO. X651-018
PROJECT DRAWING NO. SPR-10-EK-PI-P4018	REV. 3/0 5/9

Model No.: 00391 12EKG10-BR001-EB5-80-VIII TRAIN- 02

NDT TEST		PRESS. (Bar g)			TEMP. (Deg C)		PIPING SPEC	LINE NO :
SHOP	FIELD	OPERATING	DESIGN	TEST	OPERATING	DESIGN	EB5	12EKG10-BR001-EB5-80-VIII
10%RT / 10%PT	10%RT / 10%PT	31	40	60	105	150	INSULATION (MM) 25	TRAIN NO : 12EKG10-BR001-EB5-80-VIII TRAIN- 02

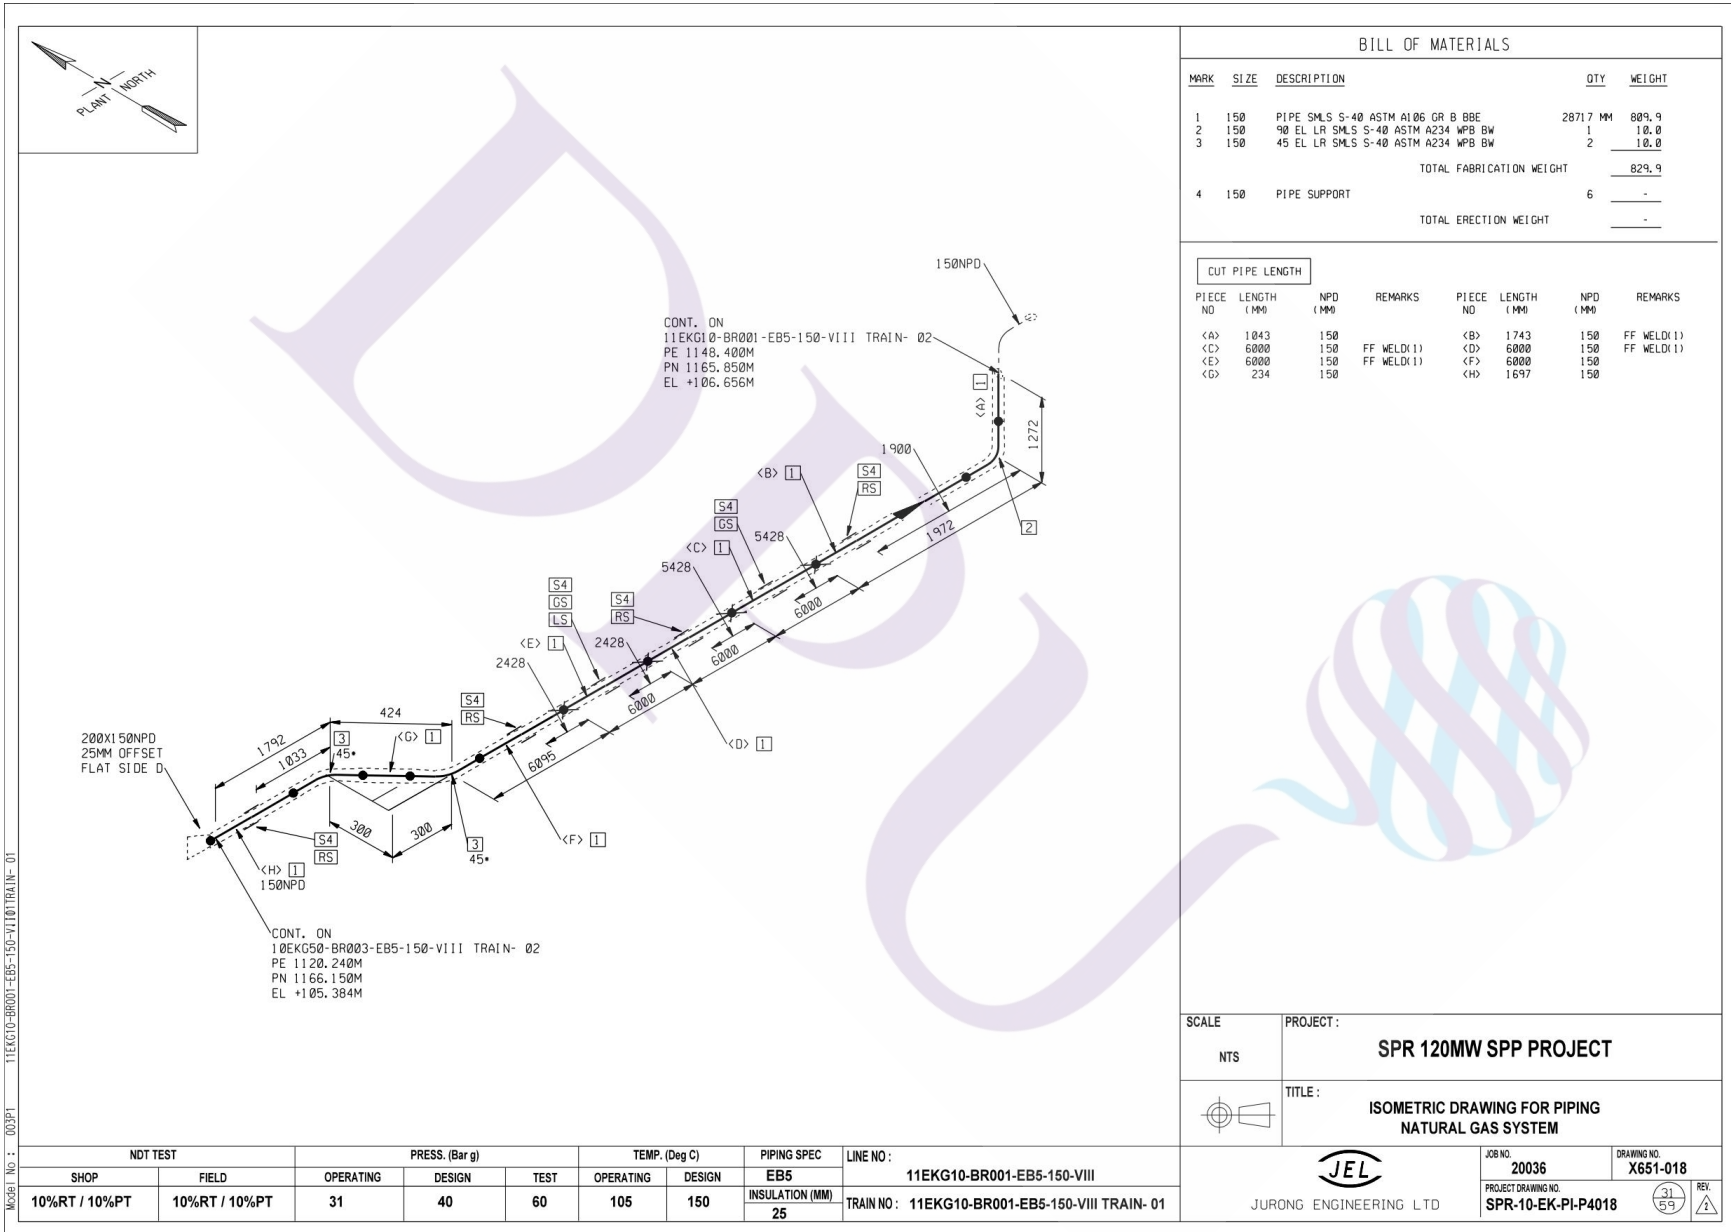

BILL OF MATERIALS

MARK	SIZE	DESCRIPTION	QTY	WEIGHT
1	150	PIPE SMLS S-40 ASTM A106 GR B BBE	2871.7 MM	809.9
2	150	90 EL LR SMLS S-40 ASTM A234 WPB BW	1	10.0
3	150	45 EL LR SMLS S-40 ASTM A234 WPB BW	2	10.0
TOTAL FABRICATION WEIGHT				829.9
4	150	PIPE SUPPORT	6	-
TOTAL ERECTION WEIGHT				-

CUT PIPE LENGTH

PIECE NO	LENGTH (MM)	NPD (MM)	REMARKS	PIECE NO	LENGTH (MM)	NPD (MM)	REMARKS
<A>	1043	150			1743	150	FF WELDI 1
<C>	6000	150	FF WELDI 1	<D>	6000	150	FF WELDI 1
<E>	6000	150	FF WELDI 1	<F>	6000	150	
<G>	234	150		<H>	1697	150	

SCALE: NTS

PROJECT: **SPR 120MW SPP PROJECT**

TITLE: **ISOMETRIC DRAWING FOR PIPING NATURAL GAS SYSTEM**


NDT TEST		PRESS. (Bar g)			TEMP. (Deg C)		PIPING SPEC	LINE NO :
SHOP	FIELD	OPERATING	DESIGN	TEST	OPERATING	DESIGN	EB5	11EKG10-BR001-EB5-150-VIII
10%RT / 10%PT	10%RT / 10%PT	31	40	60	105	150	INSULATION (MM)	TRAIN NO : 11EKG10-BR001-EB5-150-VIII TRAIN- 01
							25	

JEL

JURONG ENGINEERING LTD

JOB NO.	DRAWING NO.
20036	X651-018
PROJECT DRAWING NO.	REV.
SPR-10-EK-PI-P4018	31/59

Model No : 003PI 11EKG10-BR001-EB5-150-VIII TRAIN- 01

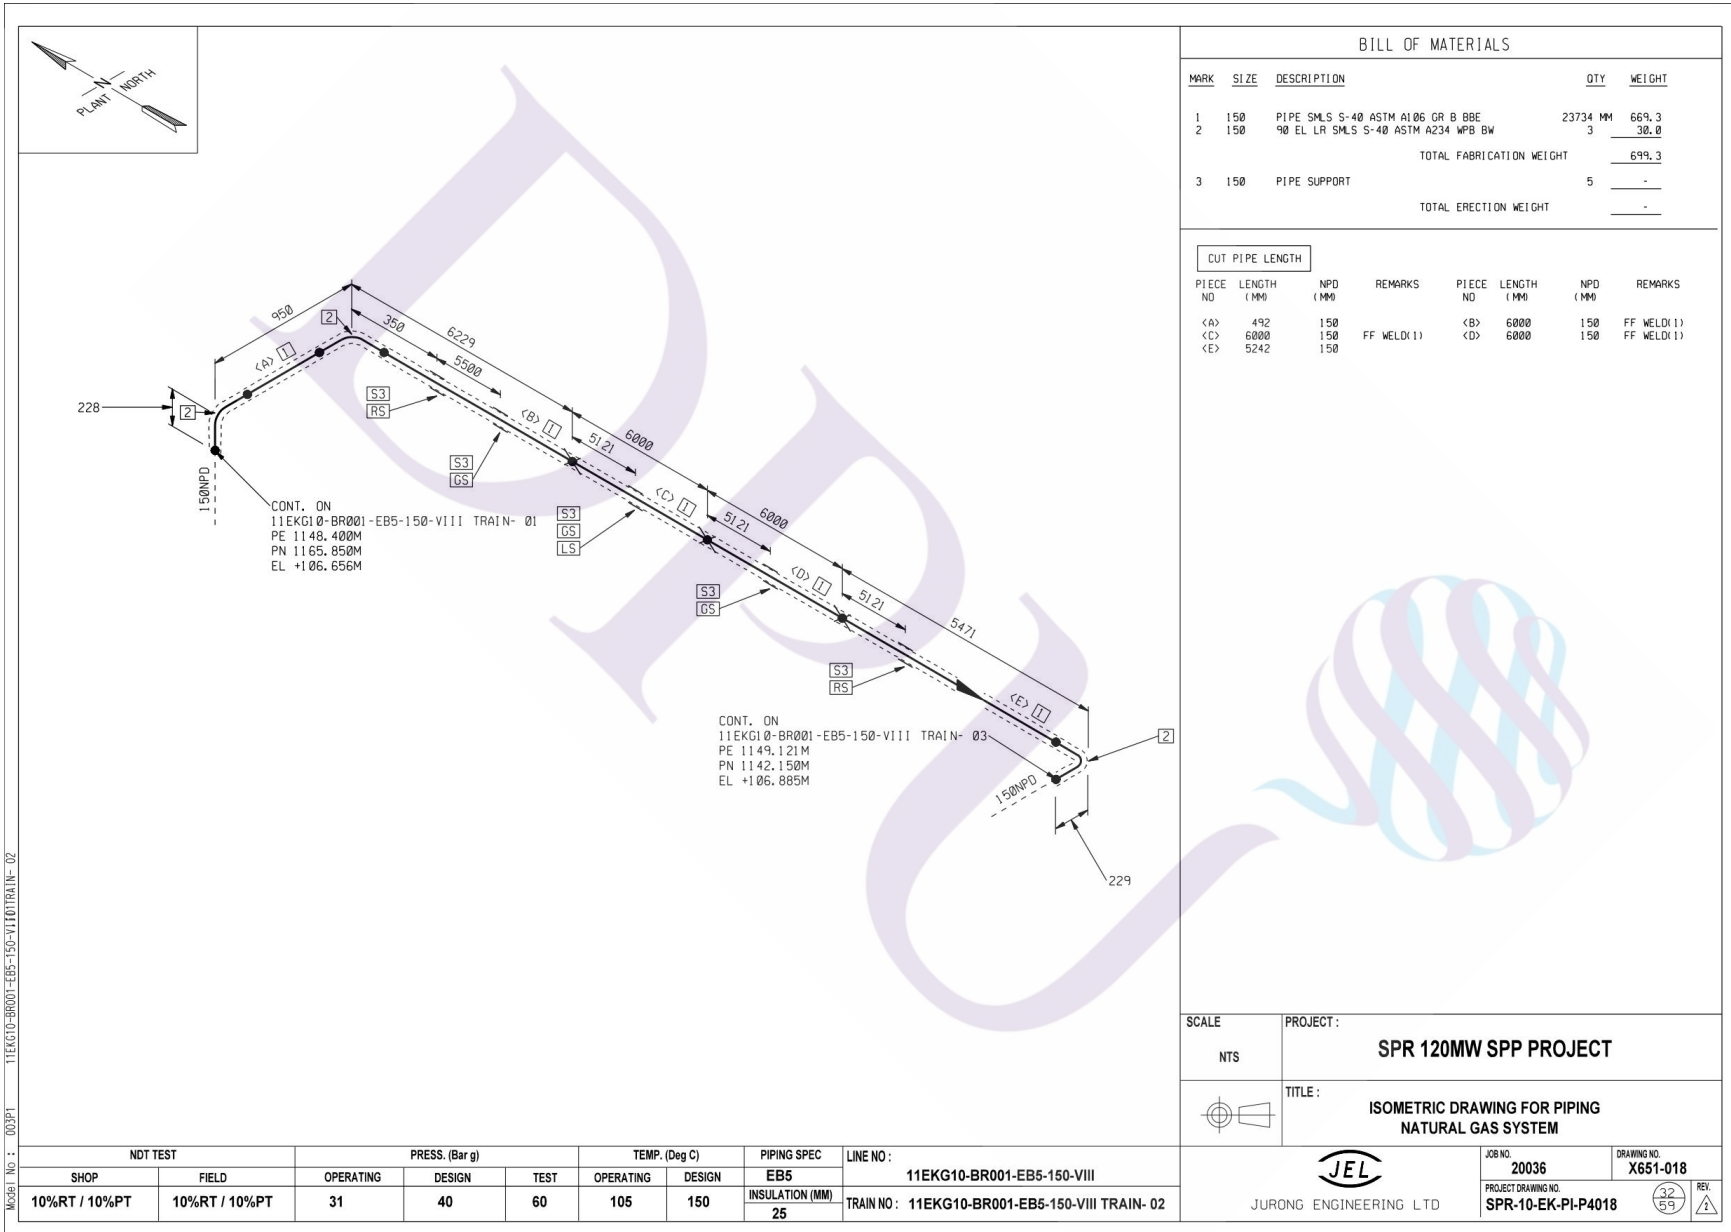

BILL OF MATERIALS

MARK	SIZE	DESCRIPTION	QTY	WEIGHT
1	150	PIPE SMLS S-40 ASTM A106 GR B BBE	23734 MM	669.3
2	150	90 EL LR SMLS S-40 ASTM A234 WPB BW	3	30.0
TOTAL FABRICATION WEIGHT				699.3
3	150	PIPE SUPPORT	5	-
TOTAL ERECTION WEIGHT				-

CUT PIPE LENGTH

PIECE NO	LENGTH (MM)	NPD (MM)	REMARKS	PIECE NO	LENGTH (MM)	NPD (MM)	REMARKS
<A>	492	150			6000	150	FF WELD(1)
<C>	6000	150		<D>	6000	150	FF WELD(1)
<E>	5242	150					

SCALE: NTS

PROJECT: **SPR 120MW SPP PROJECT**

TITLE: **ISOMETRIC DRAWING FOR PIPING NATURAL GAS SYSTEM**


NDT TEST		PRESS. (Bar g)			TEMP. (Deg C)		PIPING SPEC	LINE NO :
SHOP	FIELD	OPERATING	DESIGN	TEST	OPERATING	DESIGN	EB5	11EKGI0-BR001-EB5-150-VIII
10%RT / 10%PT	10%RT / 10%PT	31	40	60	105	150	INSULATION (MM) 25	TRAIN NO : 11EKGI0-BR001-EB5-150-VIII TRAIN- 02

JEL

JURONG ENGINEERING LTD

JOB NO. 20036	DRAWING NO. X651-018
PROJECT DRAWING NO. SPR-10-EK-PI-P4018	REV. 32/55

Model No : 003PI 11EKGI0-BR001-EB5-150-VIII TRAIN- 02

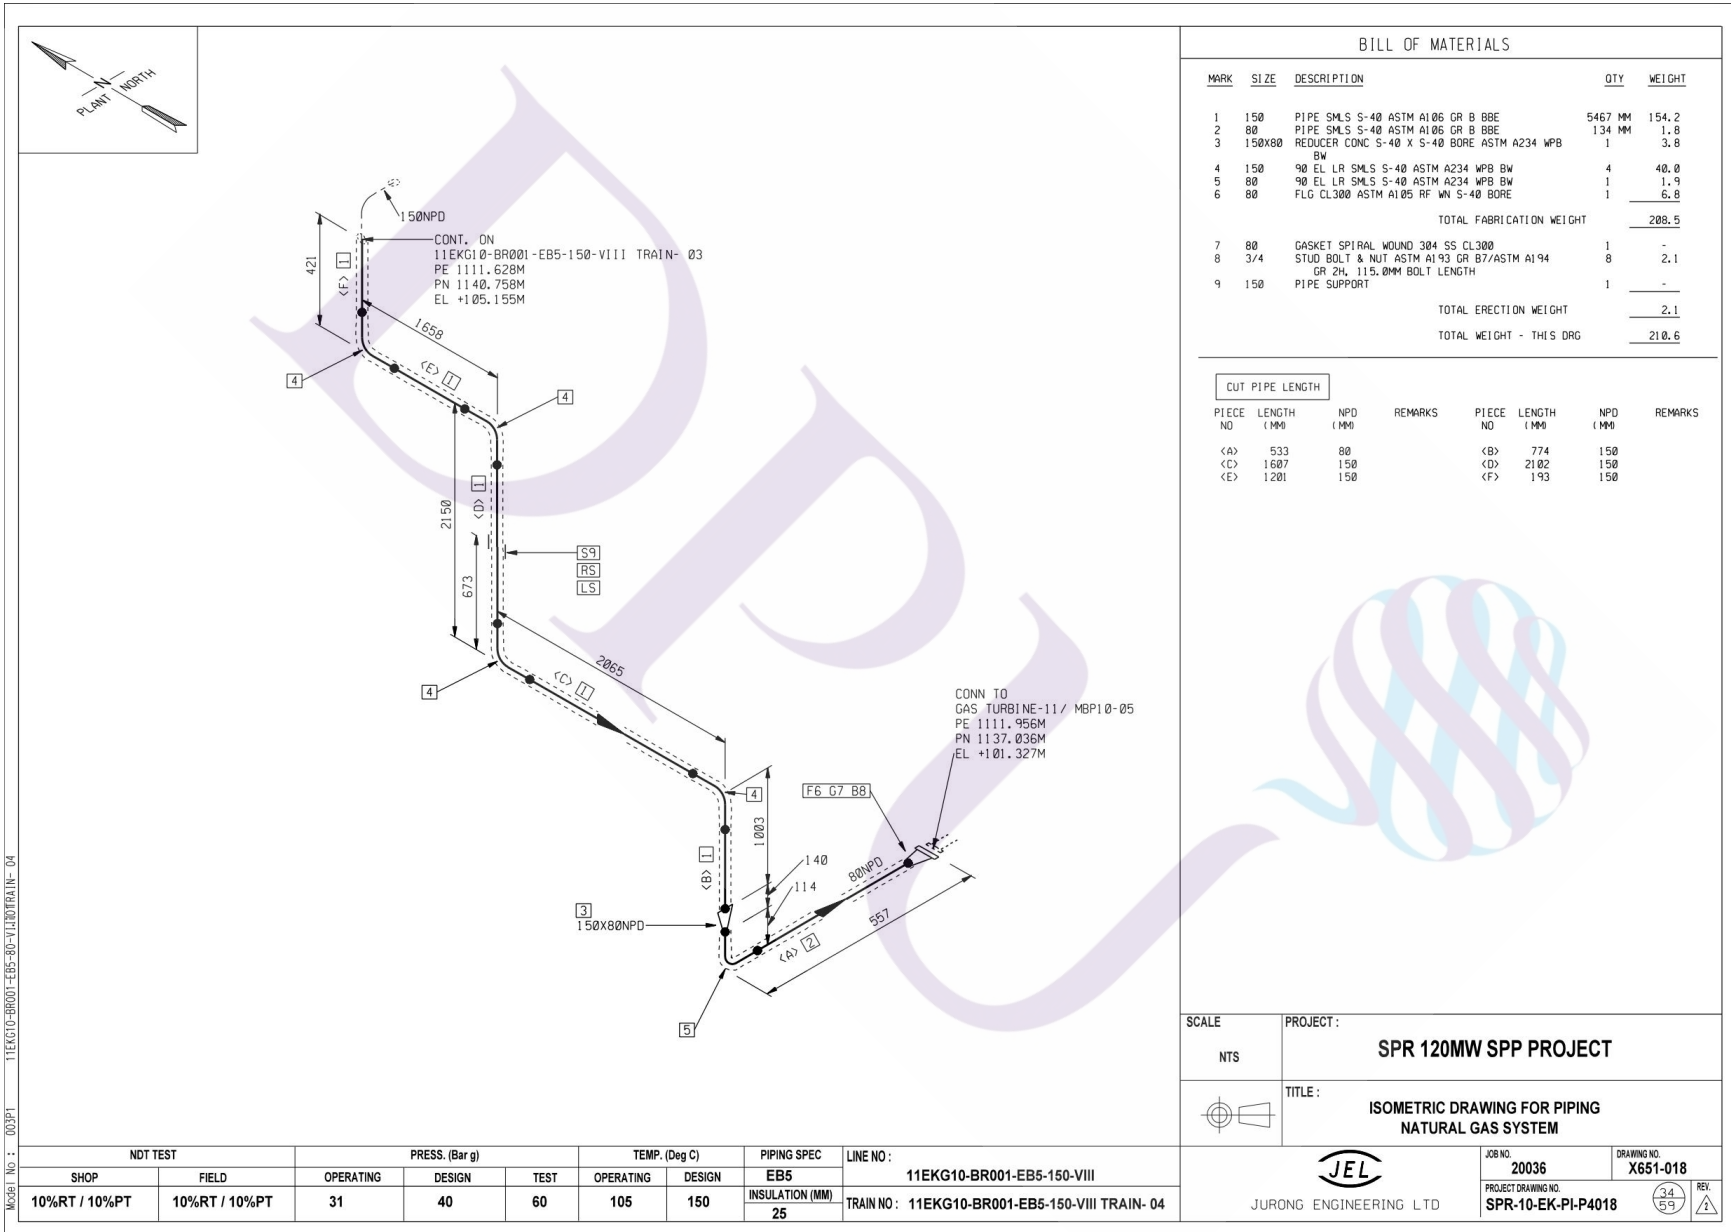

BILL OF MATERIALS

MARK	SIZE	DESCRIPTION	QTY	WEIGHT
1	150	PIPE SMLS S-40 ASTM A106 GR B BBE	5467 MM	154.2
2	80	PIPE SMLS S-40 ASTM A106 GR B BBE	134 MM	1.8
3	150X80	REDUCER CONC S-40 X S-40 BORE ASTM A234 WPB BW	1	3.8
4	150	90 EL LR SMLS S-40 ASTM A234 WPB BW	4	40.0
5	80	90 EL LR SMLS S-40 ASTM A234 WPB BW	1	1.9
6	80	FLG CL300 ASTM A105 RF WN S-40 BORE	1	6.8
TOTAL FABRICATION WEIGHT				208.5
7	80	GASKET SPIRAL WOUND 304 SS CL300	1	-
8	3/4	STUD BOLT & NUT ASTM A193 GR B7/ASTM A194 GR 2H, 115.0MM BOLT LENGTH	8	2.1
9	150	PIPE SUPPORT	1	-
TOTAL ERECTION WEIGHT				2.1
TOTAL WEIGHT - THIS DRG				210.6

CUT PIPE LENGTH

PIECE NO	LENGTH (MM)	NPD (MM)	REMARKS	PIECE NO	LENGTH (MM)	NPD (MM)	REMARKS
<A>	533	80			774	150	
<C>	1607	150		<D>	2102	150	
<E>	1201	150		<F>	193	150	


SCALE NTS	PROJECT: SPR 120MW SPP PROJECT
	TITLE: ISOMETRIC DRAWING FOR PIPING NATURAL GAS SYSTEM

Model No.: 00391 11EKG10-BR001-EB5-150-VIII TRAIN-04

NDT TEST		PRESS. (Bar g)			TEMP. (Deg C)		PIPING SPEC	LINE NO :
SHOP	FIELD	OPERATING	DESIGN	TEST	OPERATING	DESIGN	EB5	11EKG10-BR001-EB5-150-VIII
10%RT / 10%PT	10%RT / 10%PT	31	40	60	105	150	INSULATION (MM) 25	TRAIN NO : 11EKG10-BR001-EB5-150-VIII TRAIN-04

JURONG ENGINEERING LTD

JOB NO. 20036	DRAWING NO. X651-018
PROJECT DRAWING NO. SPR-10-EK-PI-P4018	REV. 34 59

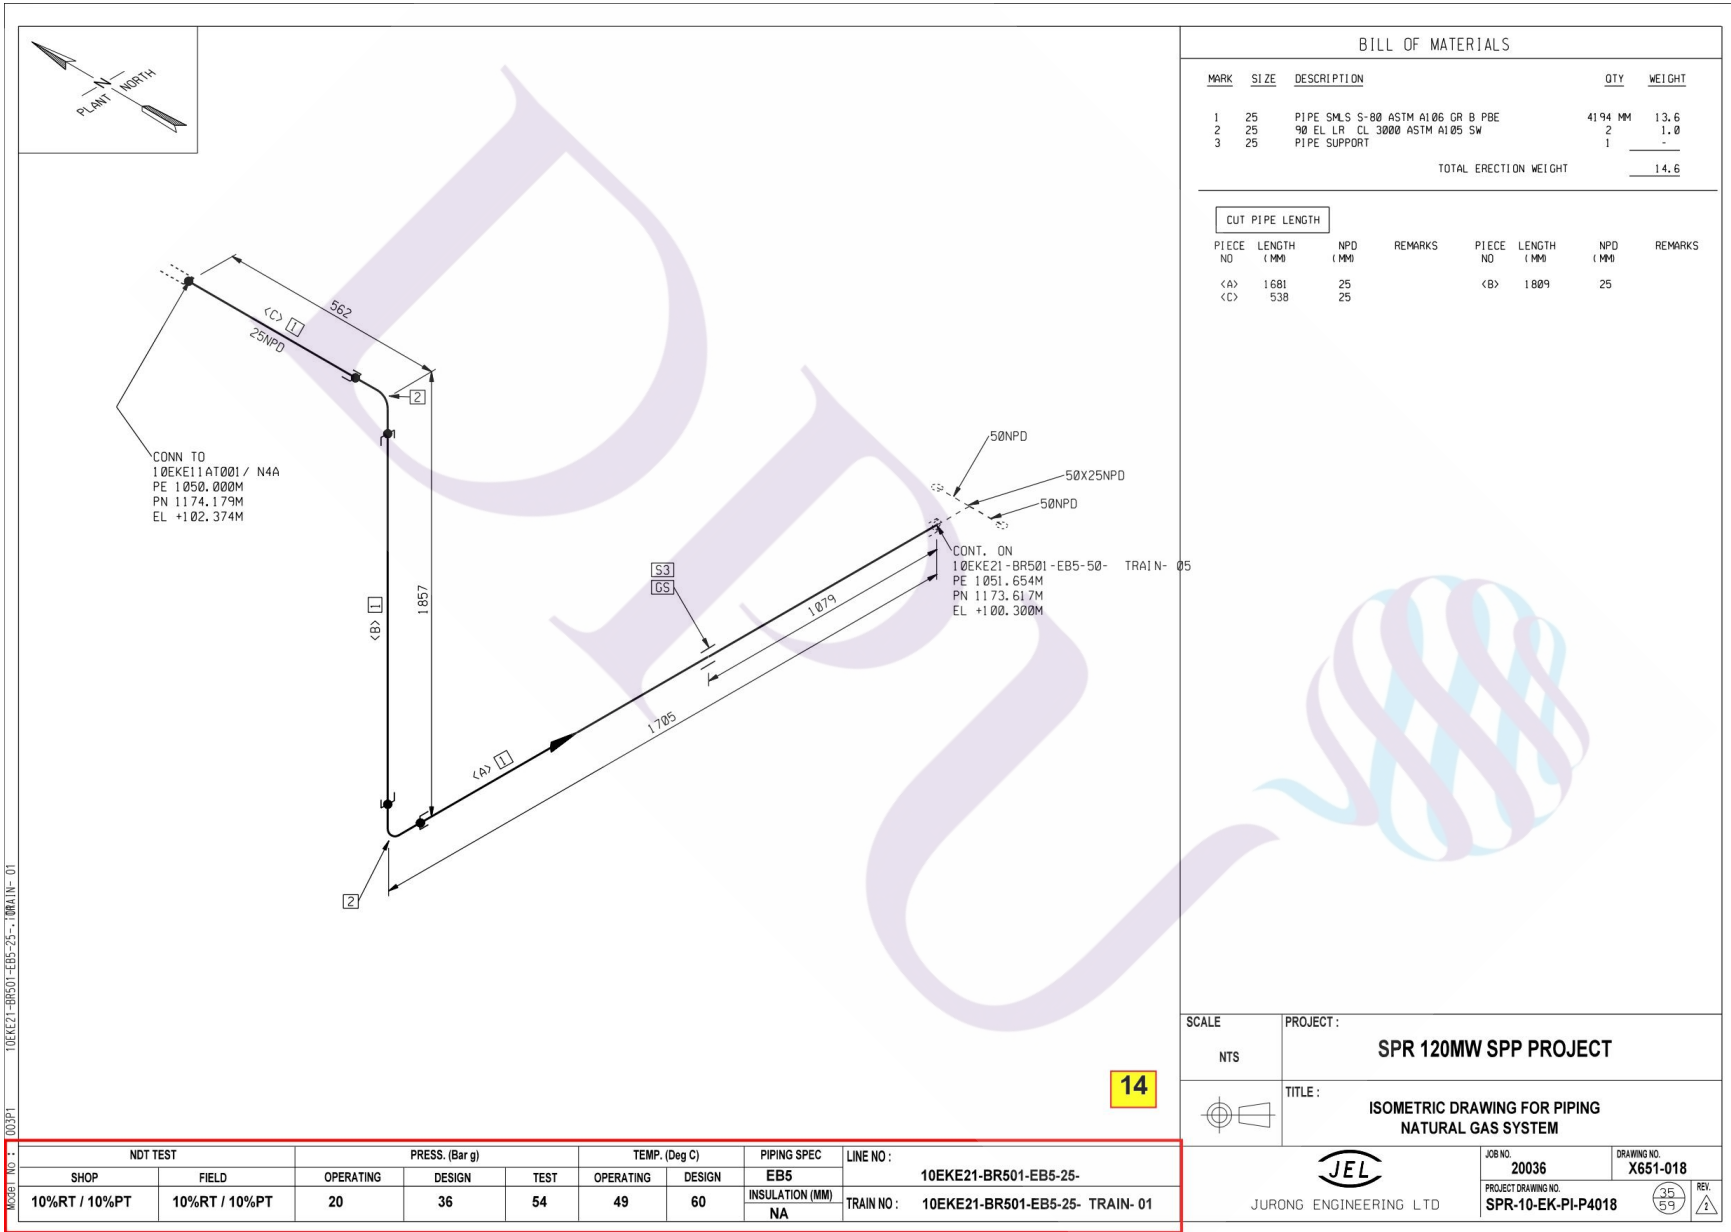

BILL OF MATERIALS

MARK	SIZE	DESCRIPTION	QTY	WEIGHT
1	25	PIPE SMLS S-B0 ASTM A105 GR B PBE	4194	MM 13.6
2	25	90 EL LR CL 3000 ASTM A105 SW	2	1.0
3	25	PIPE SUPPORT	1	-
TOTAL ERECTION WEIGHT				14.6

CUT PIPE LENGTH

PIECE NO	LENGTH (MM)	NPD (MM)	REMARKS	PIECE NO	LENGTH (MM)	NPD (MM)	REMARKS
<A>	1681	25			1809	25	
<C>	538	25					

SCALE: NTS PROJECT: **SPR 120MW SPP PROJECT**

TITLE: **ISOMETRIC DRAWING FOR PIPING NATURAL GAS SYSTEM**

NDT TEST		PRESS. (Bar g)			TEMP. (Deg C)		PIPING SPEC	LINE NO :
SHOP	FIELD	OPERATING	DESIGN	TEST	OPERATING	DESIGN	EB5	10EKE21-BR501-EB5-25-
10%RT / 10%PT	10%RT / 10%PT	20	36	54	49	60	INSULATION (MM) NA	TRAIN NO : 10EKE21-BR501-EB5-25- TRAIN-01



 JURONG ENGINEERING LTD

JOB NO. **20036** DRAWING NO. **X651-018**
 PROJECT DRAWING NO. **SPR-10-EK-PI-P4018**

REV. 

14

MODEL NO : 003PT 10EKE21-BR501-EB5-25-TRAIN-01

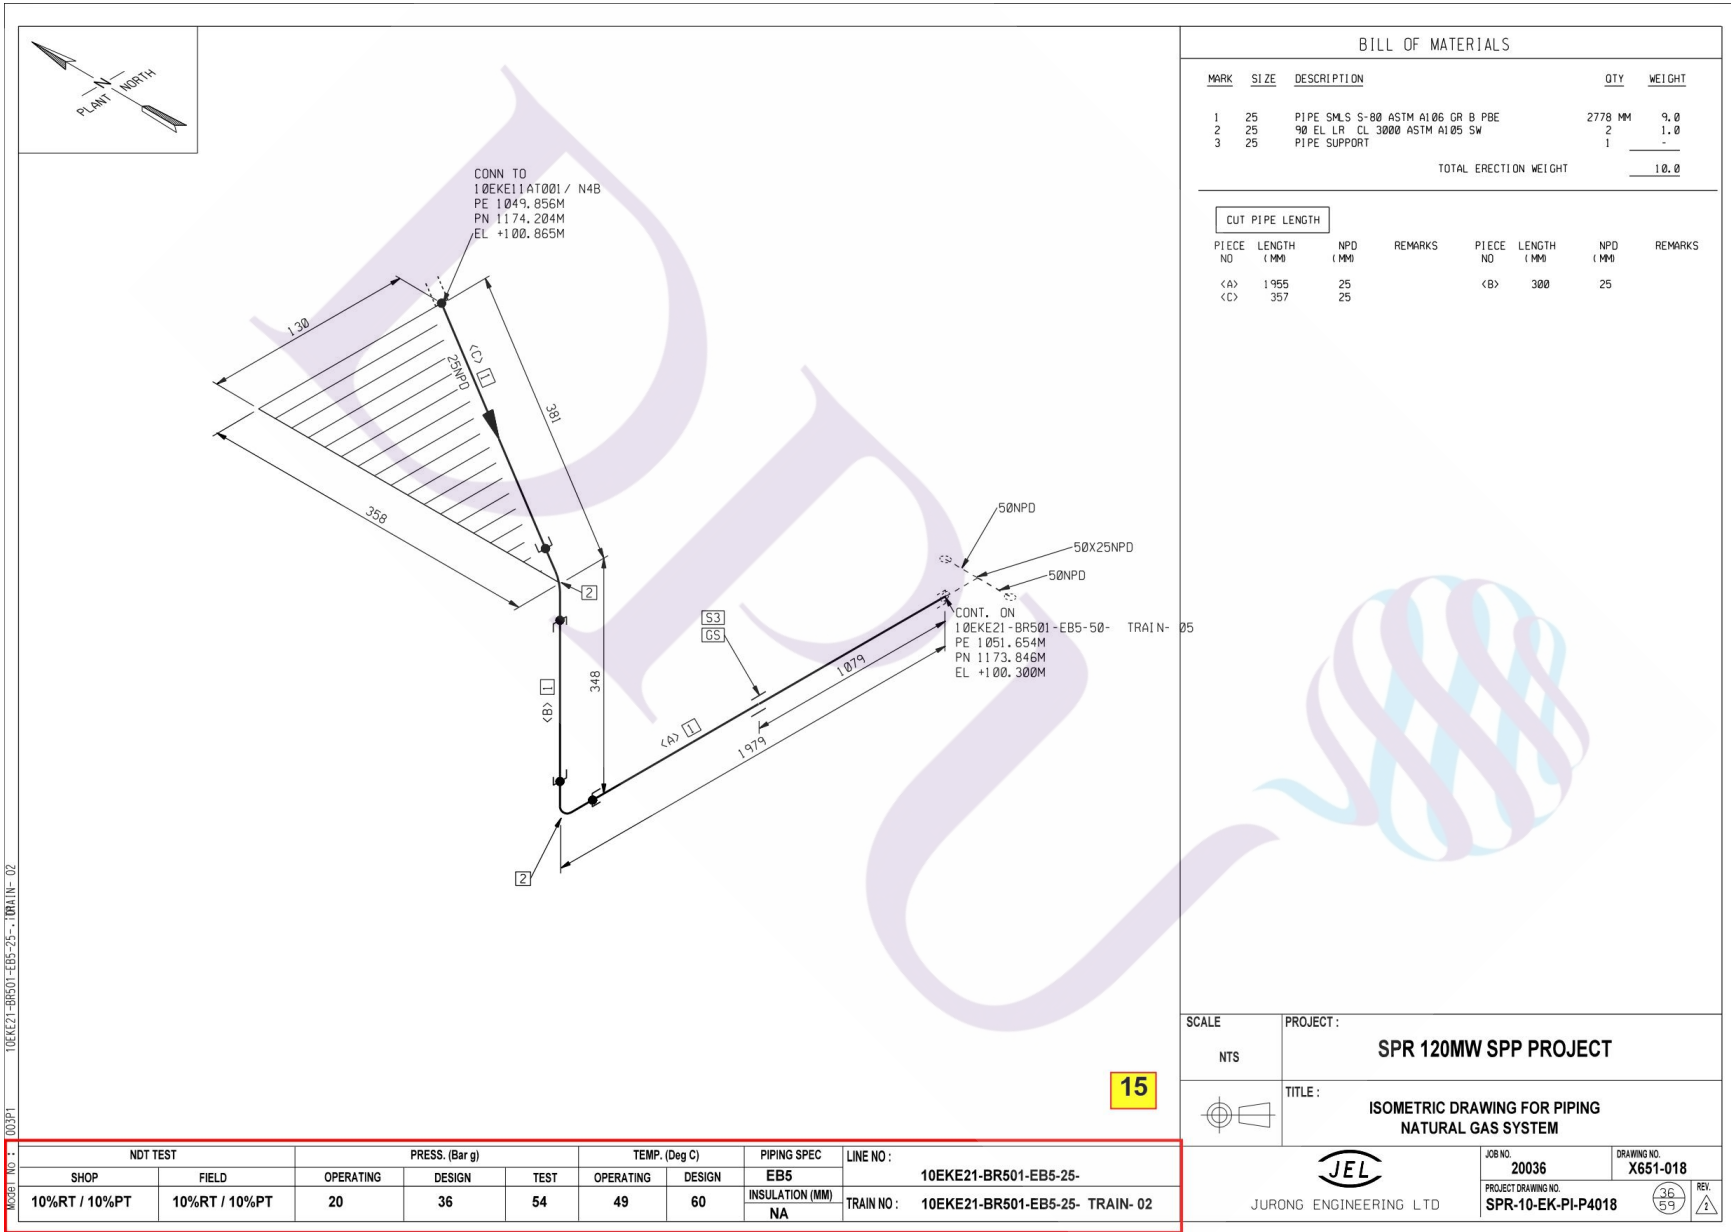

BILL OF MATERIALS

MARK	SIZE	DESCRIPTION	QTY	WEIGHT
1	25	PIPE SMLS S-80 ASTM A105 GR B PBE	2778 MM	9.0
2	25	90 EL LR CL 3000 ASTM A105 SW	2	1.0
3	25	PIPE SUPPORT	1	-
TOTAL ERECTION WEIGHT				10.0

CUT PIPE LENGTH

PIECE NO	LENGTH (MM)	NPD (MM)	REMARKS	PIECE NO	LENGTH (MM)	NPD (MM)	REMARKS
<A>	1955	25			300	25	
<C>	357	25					


SCALE NTS	PROJECT: SPR 120MW SPP PROJECT
TITLE: ISOMETRIC DRAWING FOR PIPING NATURAL GAS SYSTEM	

MODEL NO : 10EKE21-BR501-EB5-25-TRAIN-02

NDT TEST		PRESS. (Bar g)			TEMP. (Deg C)		PIPING SPEC	LINE NO :
SHOP	FIELD	OPERATING	DESIGN	TEST	OPERATING	DESIGN	EB5	10EKE21-BR501-EB5-25-
10%RT / 10%PT	10%RT / 10%PT	20	36	54	49	60	INSULATION (MM) NA	TRAIN NO : 10EKE21-BR501-EB5-25- TRAIN- 02

JEL
JURONG ENGINEERING LTD

JOB NO. 20036	DRAWING NO. X651-018
PROJECT DRAWING NO. SPR-10-EK-PI-P4018	REV. 3/6

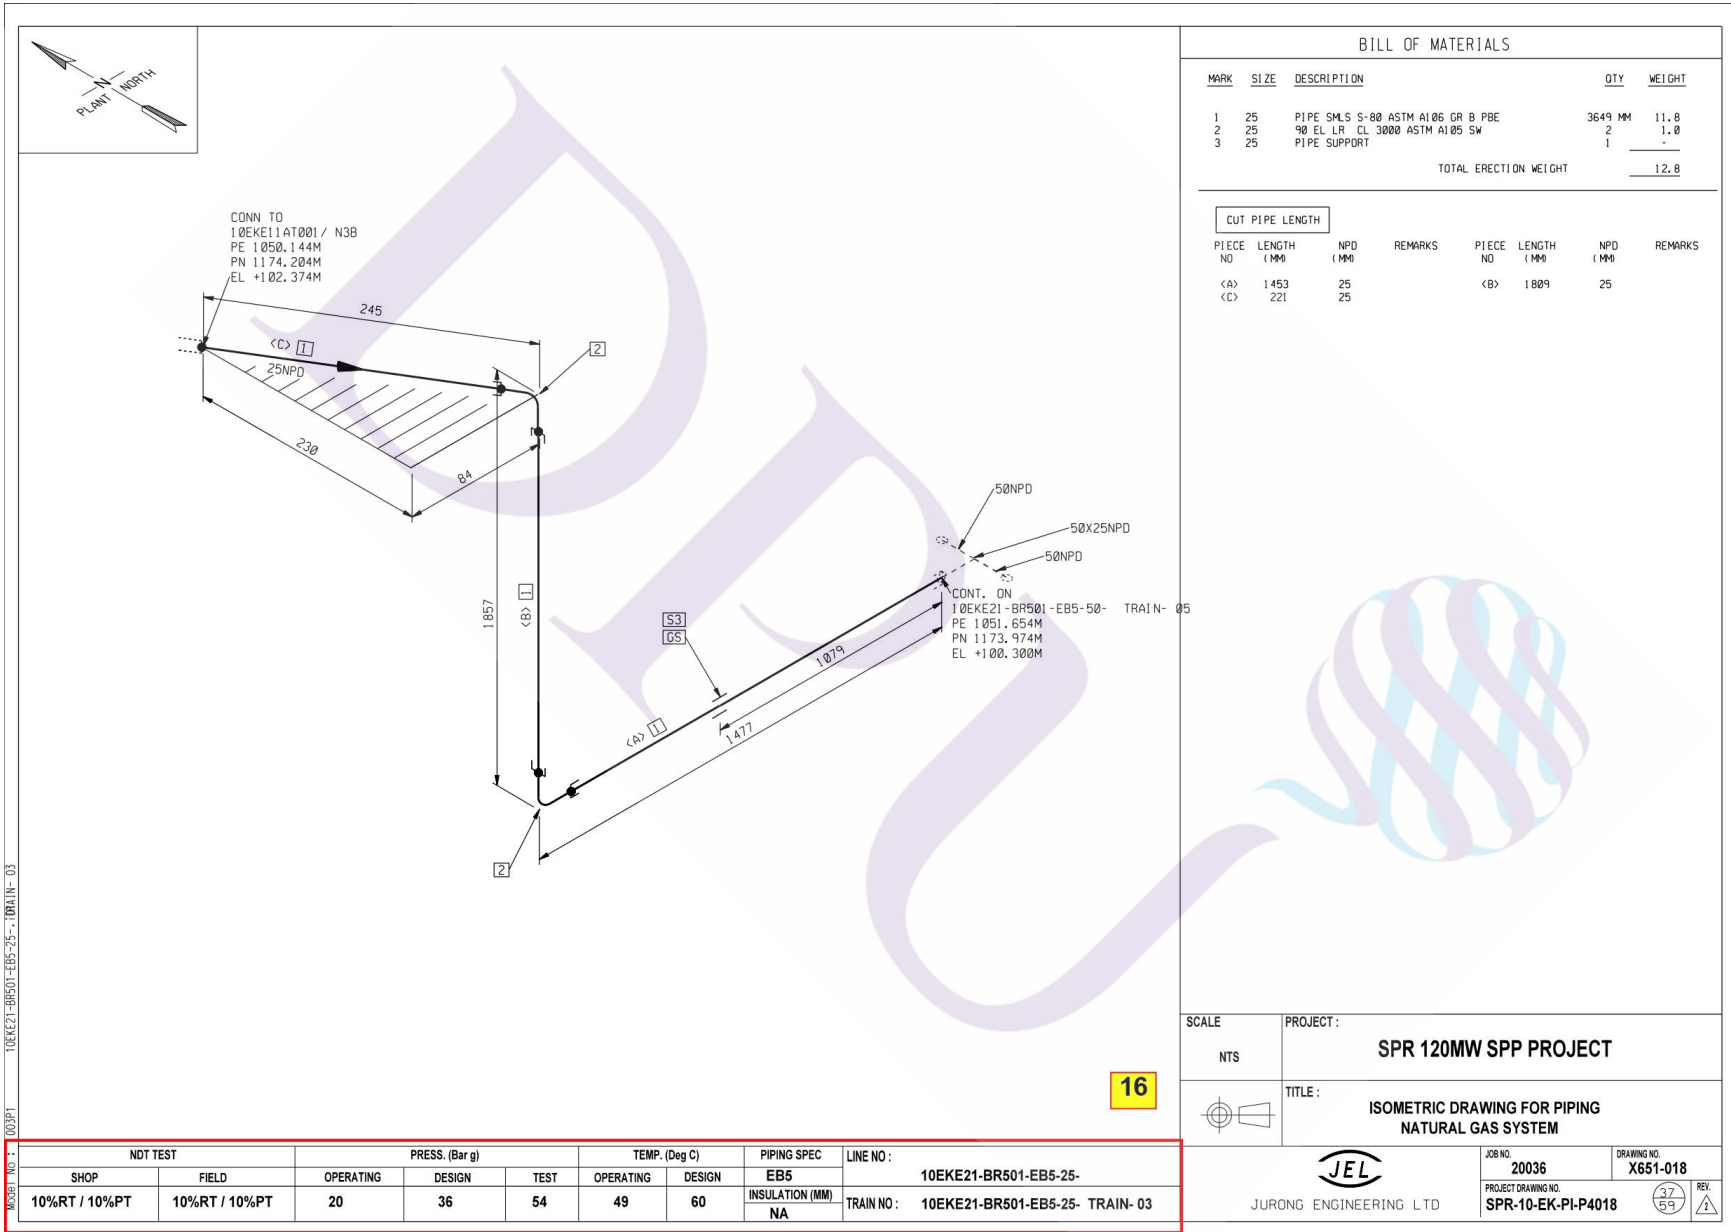

BILL OF MATERIALS

MARK	SIZE	DESCRIPTION	QTY	WEIGHT
1	25	PIPE SMLS S-B0 ASTM A105 GR B PBE	3649 MM	11.8
2	25	90 EL. LR. CL. 3000 ASTM A105 SW	2	1.0
3	25	PIPE SUPPORT	1	-
TOTAL ERECTION WEIGHT				12.8

CUT PIPE LENGTH

PIECE NO	LENGTH (MM)	NPD (MM)	REMARKS	PIECE NO	LENGTH (MM)	NPD (MM)	REMARKS
<A>	1453	25			1809	25	
<C>	221	25					

SCALE: NTS

PROJECT: **SPR 120MW SPP PROJECT**

TITLE: **ISOMETRIC DRAWING FOR PIPING NATURAL GAS SYSTEM**


NDT TEST		PRESS. (Bar g)			TEMP. (Deg C)		PIPING SPEC	LINE NO :
SHOP	FIELD	OPERATING	DESIGN	TEST	OPERATING	DESIGN	EB5	10EKE21-BR501-EB5-25-
10%RT / 10%PT	10%RT / 10%PT	20	36	54	49	60	INSULATION (MM) NA	TRAIN NO : 10EKE21-BR501-EB5-25- TRAIN- 03

JEL

JURONG ENGINEERING LTD

JOB NO. 20036	DRAWING NO. X651-018
PROJECT DRAWING NO. SPR-10-EK-PI-P4018	REV. 37/59

MODEL NO : 003PI 10EKE21-BR501-EB5-25- TRAIN- 03

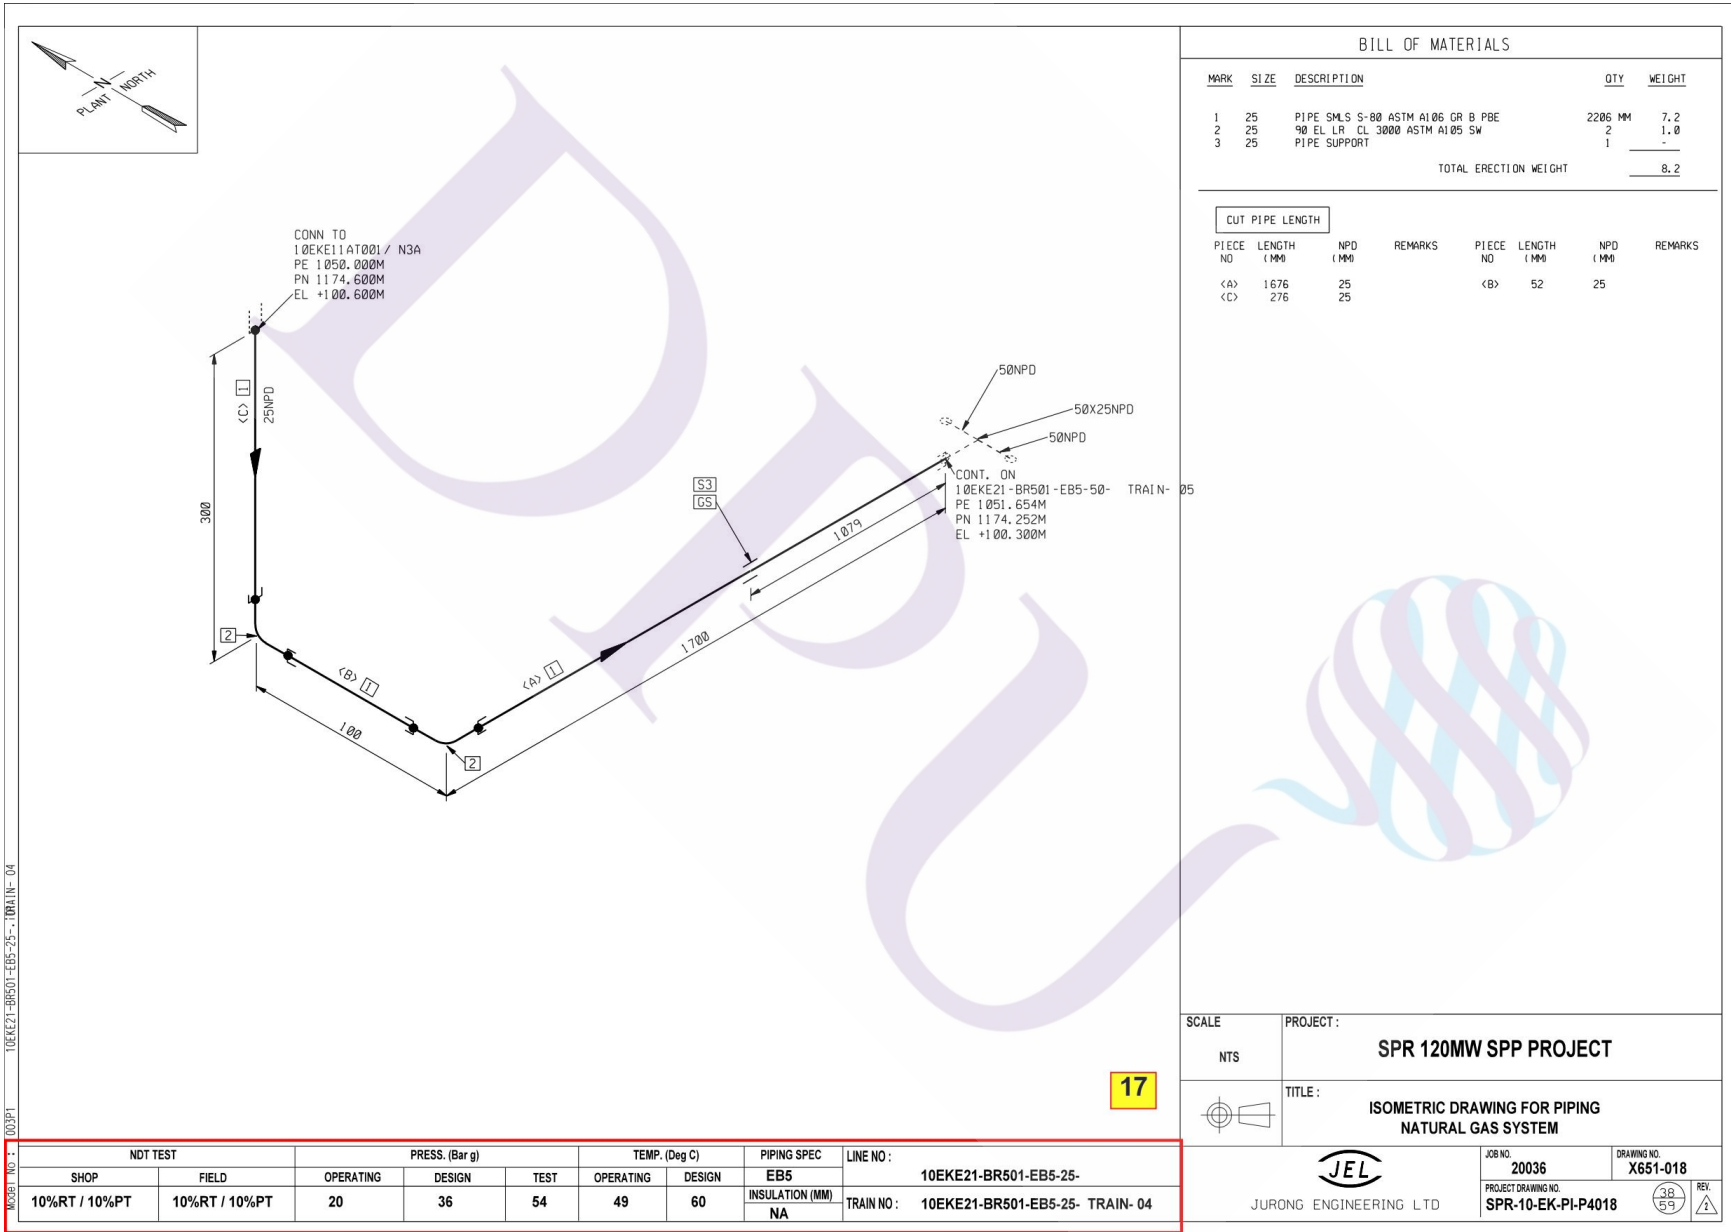

BILL OF MATERIALS

MARK	SIZE	DESCRIPTION	QTY	WEIGHT
1	25	PIPE SMLS S-B0 ASTM A105 GR B PBE	2205 MM	7.2
2	25	90 EL LR CL 3000 ASTM A105 SW	2	1.0
3	25	PIPE SUPPORT	1	-
TOTAL ERECTION WEIGHT				8.2

CUT PIPE LENGTH

PIECE NO	LENGTH (MM)	NPD (MM)	REMARKS	PIECE NO	LENGTH (MM)	NPD (MM)	REMARKS
<A>	1676	25			52	25	
<C>	276	25					

SCALE NTS	PROJECT: SPR 120MW SPP PROJECT
	TITLE: ISOMETRIC DRAWING FOR PIPING NATURAL GAS SYSTEM


17

MODEL NO : 10EKE21-BR501-EB5-25-TRAIN-04

NDT TEST		PRESS. (Bar g)			TEMP. (Deg C)		PIPING SPEC	LINE NO :
SHOP	FIELD	OPERATING	DESIGN	TEST	OPERATING	DESIGN	EB5	10EKE21-BR501-EB5-25-
10%RT / 10%PT	10%RT / 10%PT	20	36	54	49	60	INSULATION (MM) NA	TRAIN NO : 10EKE21-BR501-EB5-25- TRAIN- 04

JURONG ENGINEERING LTD

JOB NO. 20036	DRAWING NO. X651-018
PROJECT DRAWING NO. SPR-10-EK-PI-P4018	REV.

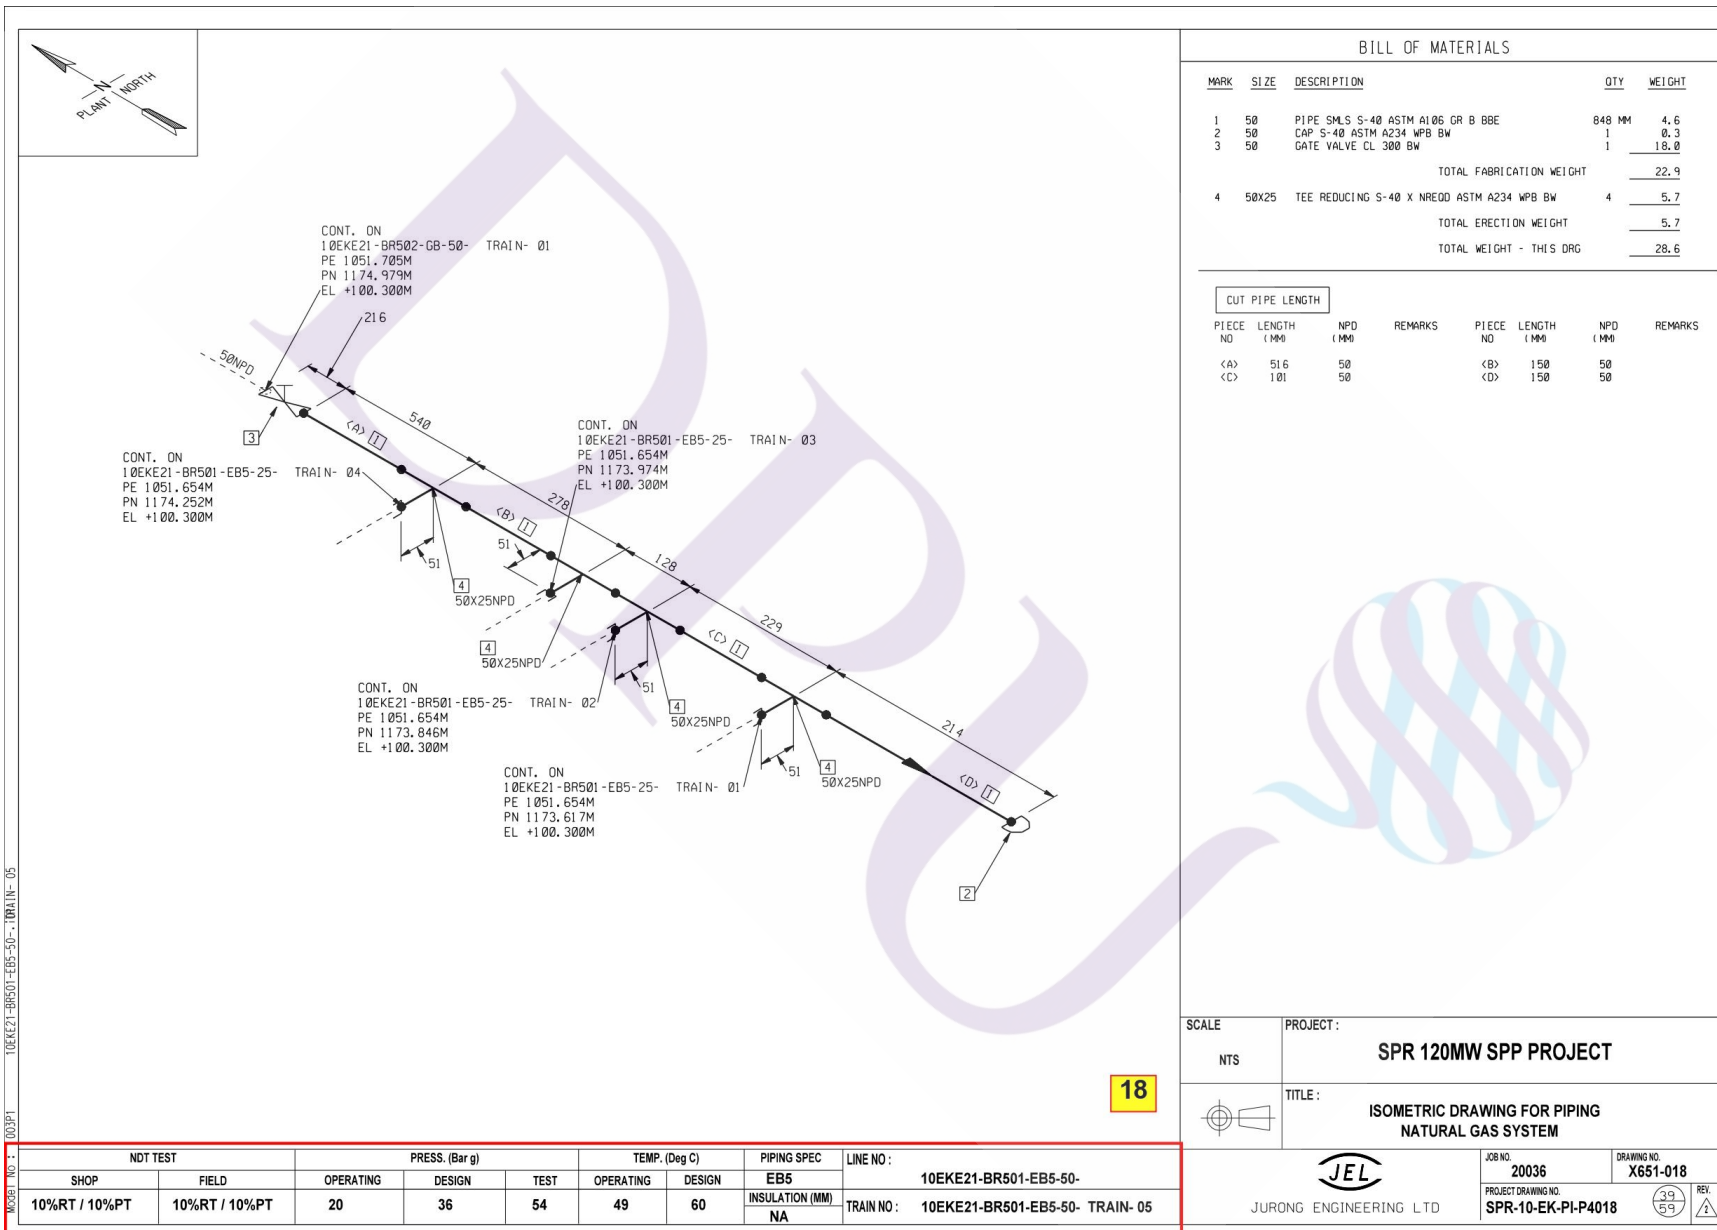

BILL OF MATERIALS

MARK	SIZE	DESCRIPTION	QTY	WEIGHT
1	50	PIPE SMLS S-40 ASTM A105 GR B BBE	848 MM	4.6
2	50	CAP S-40 ASTM A234 WPB BW	1	0.3
3	50	GATE VALVE CL 300 BW	1	18.0
TOTAL FABRICATION WEIGHT				22.9
4	50X25	TEE REDUCING S-40 X NREOD ASTM A234 WPB BW	4	5.7
TOTAL ERECTION WEIGHT				5.7
TOTAL WEIGHT - THIS DRG				28.6

CUT PIPE LENGTH

PIECE NO	LENGTH (MM)	NPD (MM)	REMARKS	PIECE NO	LENGTH (MM)	NPD (MM)	REMARKS
<A>	51.6	50			150	50	
<C>	101	50		<D>	150	50	

SCALE: NTS
 PROJECT: SPR 120MW SPP PROJECT
 TITLE: ISOMETRIC DRAWING FOR PIPING NATURAL GAS SYSTEM



JURONG ENGINEERING LTD


JOB NO. 20036
 DRAWING NO. X651-018
 PROJECT DRAWING NO. SPR-10-EK-PI-P4018

REV. 39/59



MODEL NO.: 10EKE21-BR501-EB5-50--TRAIN-05

NDT TEST		PRESS. (Bar g)			TEMP. (Deg C)		PIPING SPEC	LINE NO :
SHOP	FIELD	OPERATING	DESIGN	TEST	OPERATING	DESIGN	EB5	10EKE21-BR501-EB5-50-
10%RT / 10%PT	10%RT / 10%PT	20	36	54	49	60	INSULATION (MM) NA	TRAIN NO: 10EKE21-BR501-EB5-50- TRAIN- 05

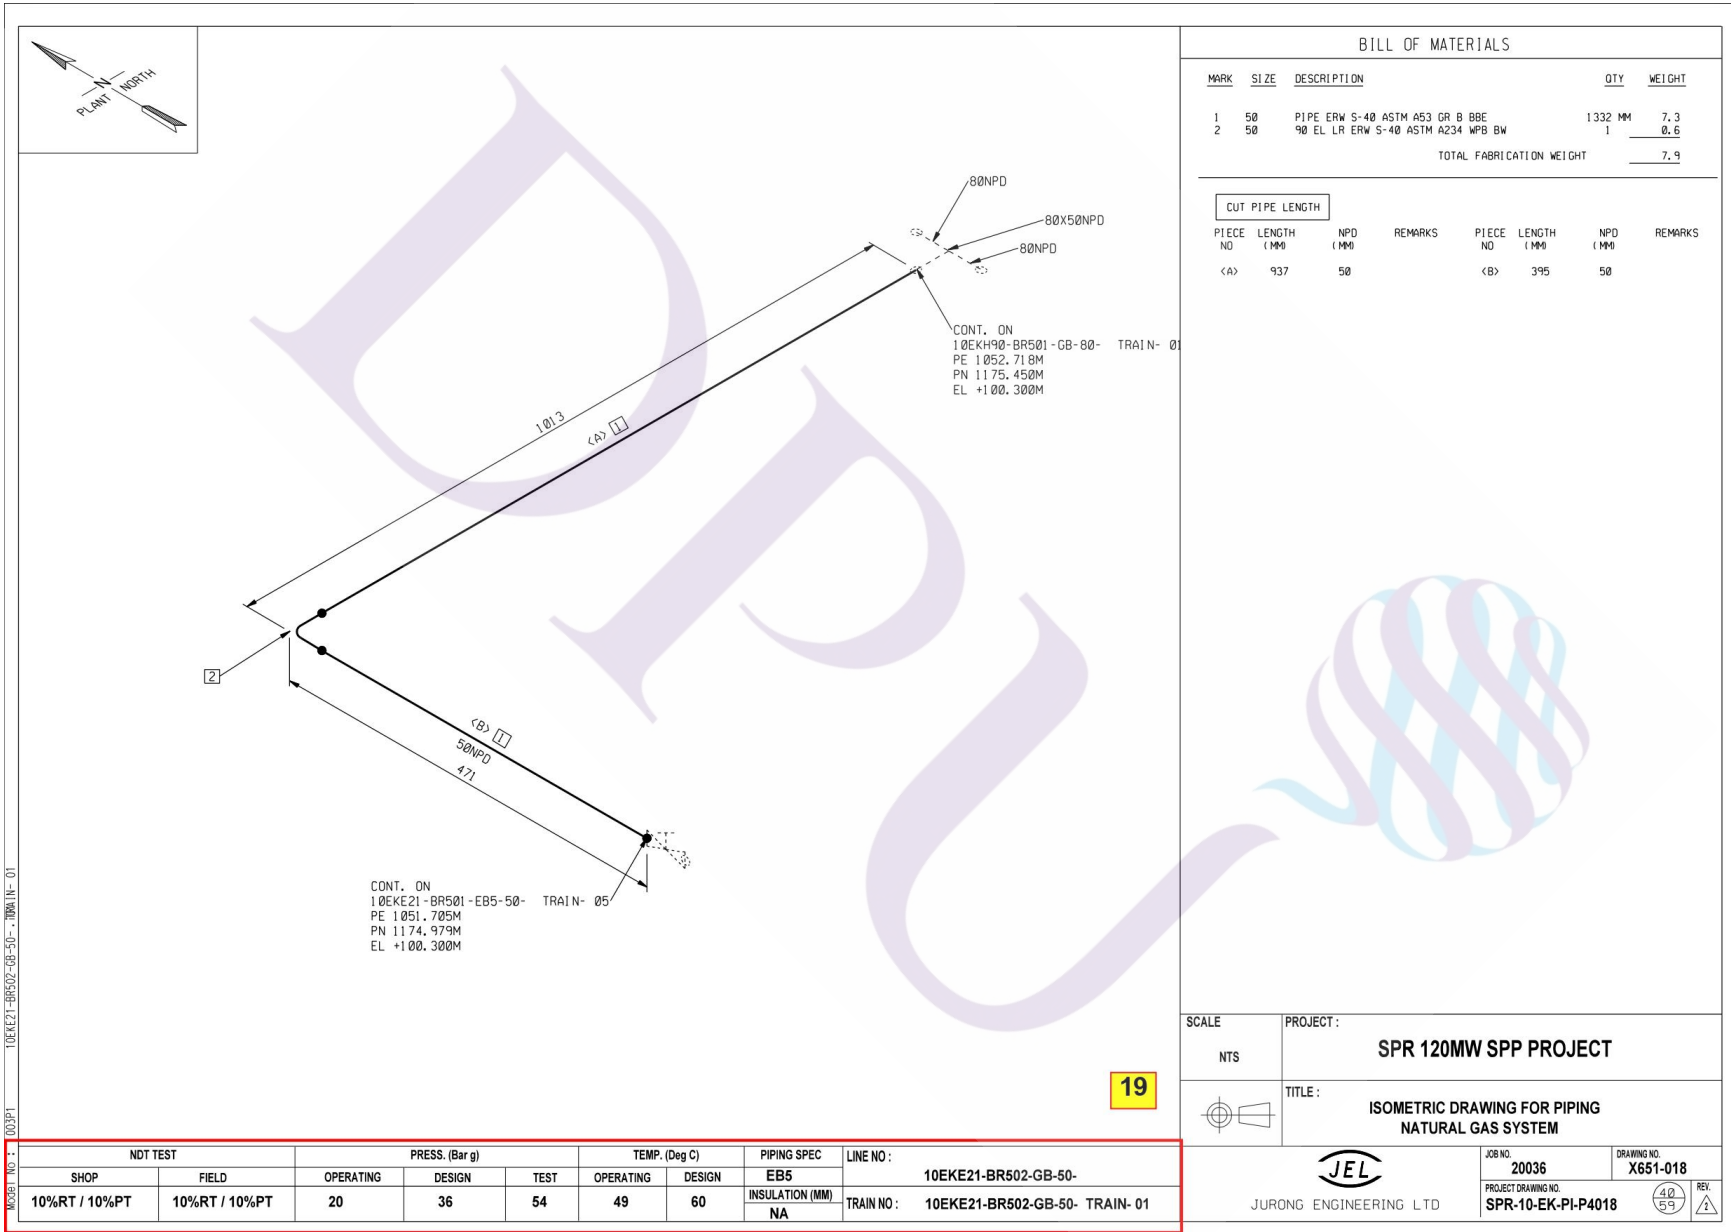

BILL OF MATERIALS

MARK	SIZE	DESCRIPTION	QTY	WEIGHT
1	50	PIPE ERW S-40 ASTM A53 GR B BBE	1332 MM	7.3
2	50	90 EL. LR ERW S-40 ASTM A234 WP8 BW	1	0.6
TOTAL FABRICATION WEIGHT				7.9

CUT PIPE LENGTH

PIECE NO	LENGTH (MM)	NPD (MM)	REMARKS	PIECE NO	LENGTH (MM)	NPD (MM)	REMARKS
<A>	937	50			395	50	

SCALE: NTS PROJECT: **SPR 120MW SPP PROJECT**

TITLE: **ISOMETRIC DRAWING FOR PIPING NATURAL GAS SYSTEM**


NDT TEST		PRESS. (Bar g)			TEMP. (Deg C)		PIPING SPEC	LINE NO :
SHOP	FIELD	OPERATING	DESIGN	TEST	OPERATING	DESIGN	EB5	10EKE21-BR502-GB-50-
10%RT / 10%PT	10%RT / 10%PT	20	36	54	49	60	INSULATION (MM) NA	TRAIN NO : 10EKE21-BR502-GB-50- TRAIN- 01

JEL
JURONG ENGINEERING LTD

JOB NO. **20036** DRAWING NO. **X651-018**

PROJECT DRAWING NO. **SPR-10-EK-PI-P4018**


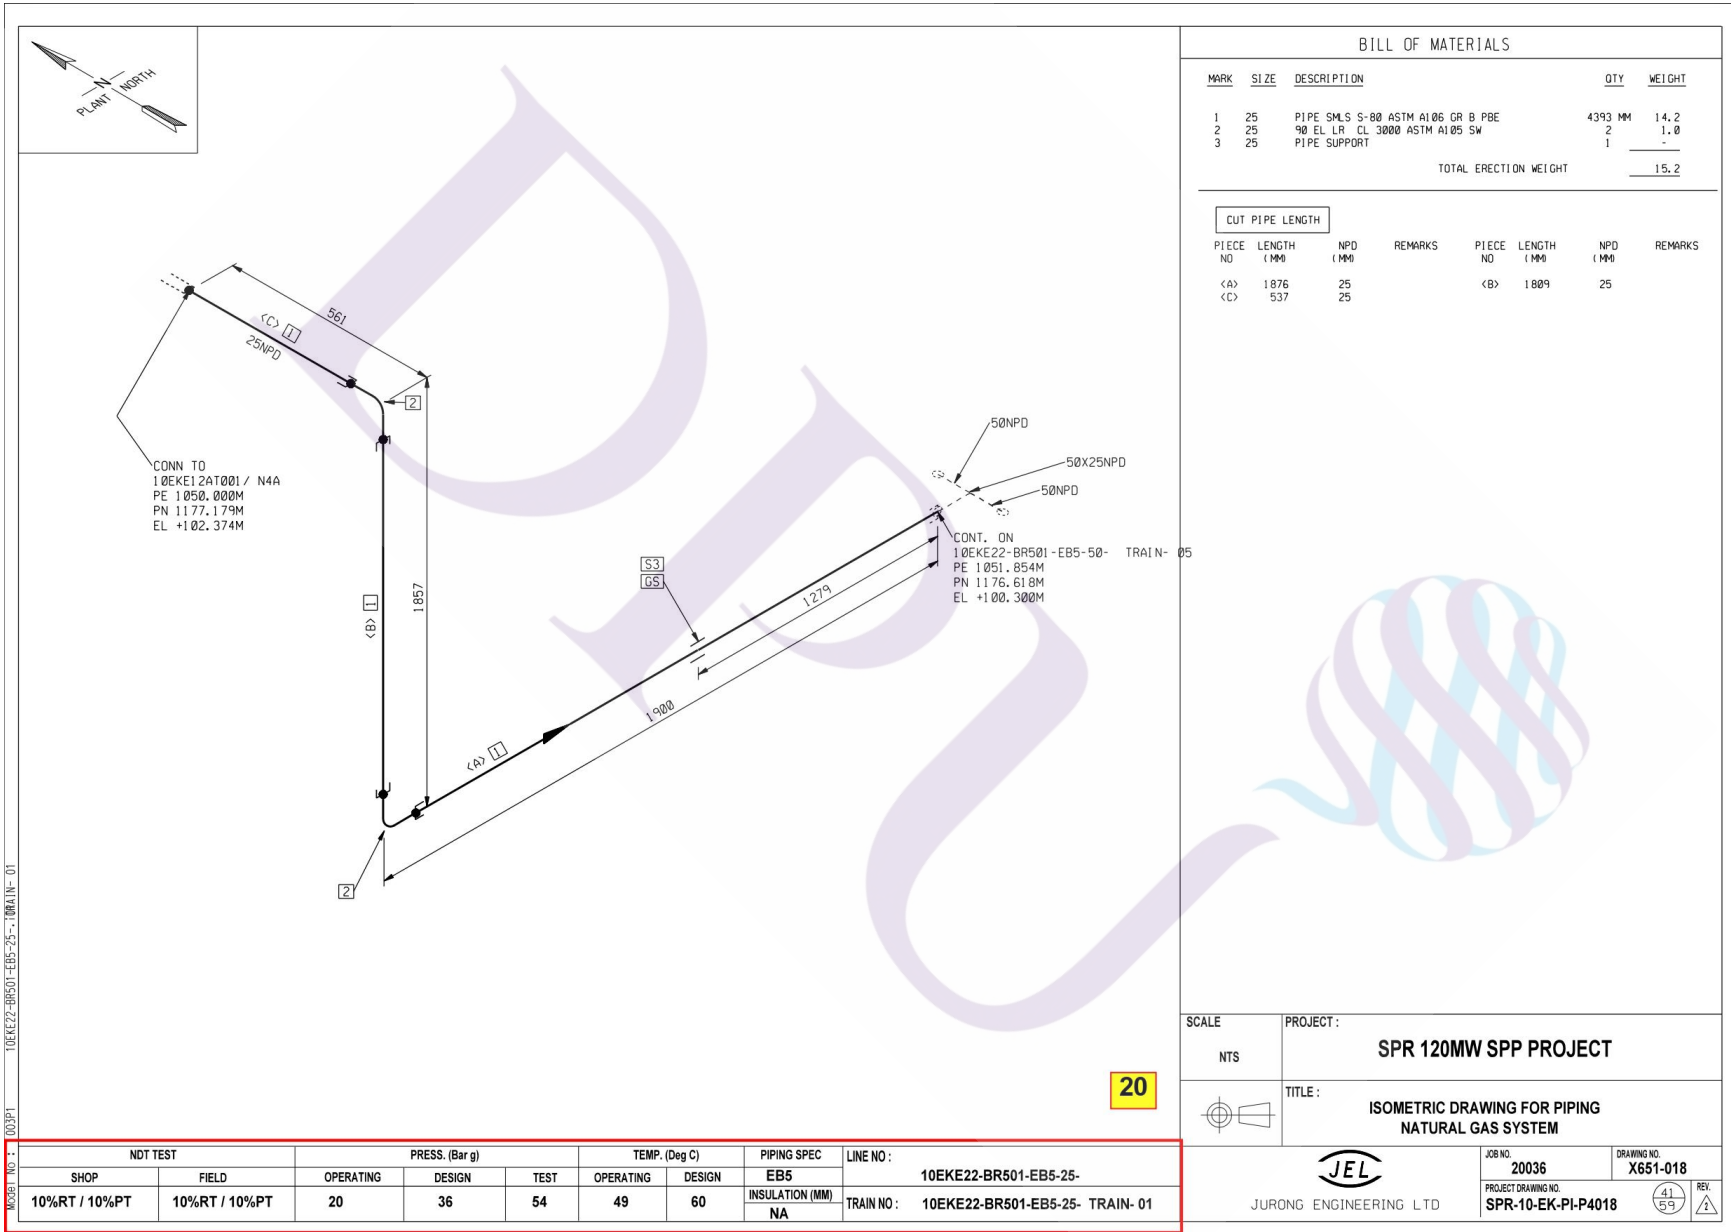

BILL OF MATERIALS

MARK	SIZE	DESCRIPTION	QTY	WEIGHT
1	25	PIPE SMLS S-B0 ASTM A105 GR B PBE	4393 MM	14.2
2	25	90 EL. LR. CL. 3000 ASTM A105 SW	2	1.0
3	25	PIPE SUPPORT	1	-
TOTAL ERECTION WEIGHT				15.2

CUT PIPE LENGTH

PIECE NO	LENGTH (MM)	NPD (MM)	REMARKS	PIECE NO	LENGTH (MM)	NPD (MM)	REMARKS
<A>	1876	25			1809	25	
<C>	537	25					

SCALE: NTS PROJECT: **SPR 120MW SPP PROJECT**

TITLE: **ISOMETRIC DRAWING FOR PIPING NATURAL GAS SYSTEM**




 JOB NO. **20036** DRAWING NO. **X651-018**
 PROJECT DRAWING NO. **SPR-10-EK-PI-P4018**

JURONG ENGINEERING LTD

MODEL NO.: 00391 10EKE22-BR501-EB5-25-TRAIN-01

20

NDT TEST		PRESS. (Bar g)			TEMP. (Deg C)		PIPING SPEC	LINE NO :
SHOP	FIELD	OPERATING	DESIGN	TEST	OPERATING	DESIGN	EB5	10EKE22-BR501-EB5-25-
10%RT / 10%PT	10%RT / 10%PT	20	36	54	49	60	INSULATION (MM) NA	TRAIN NO : 10EKE22-BR501-EB5-25- TRAIN-01

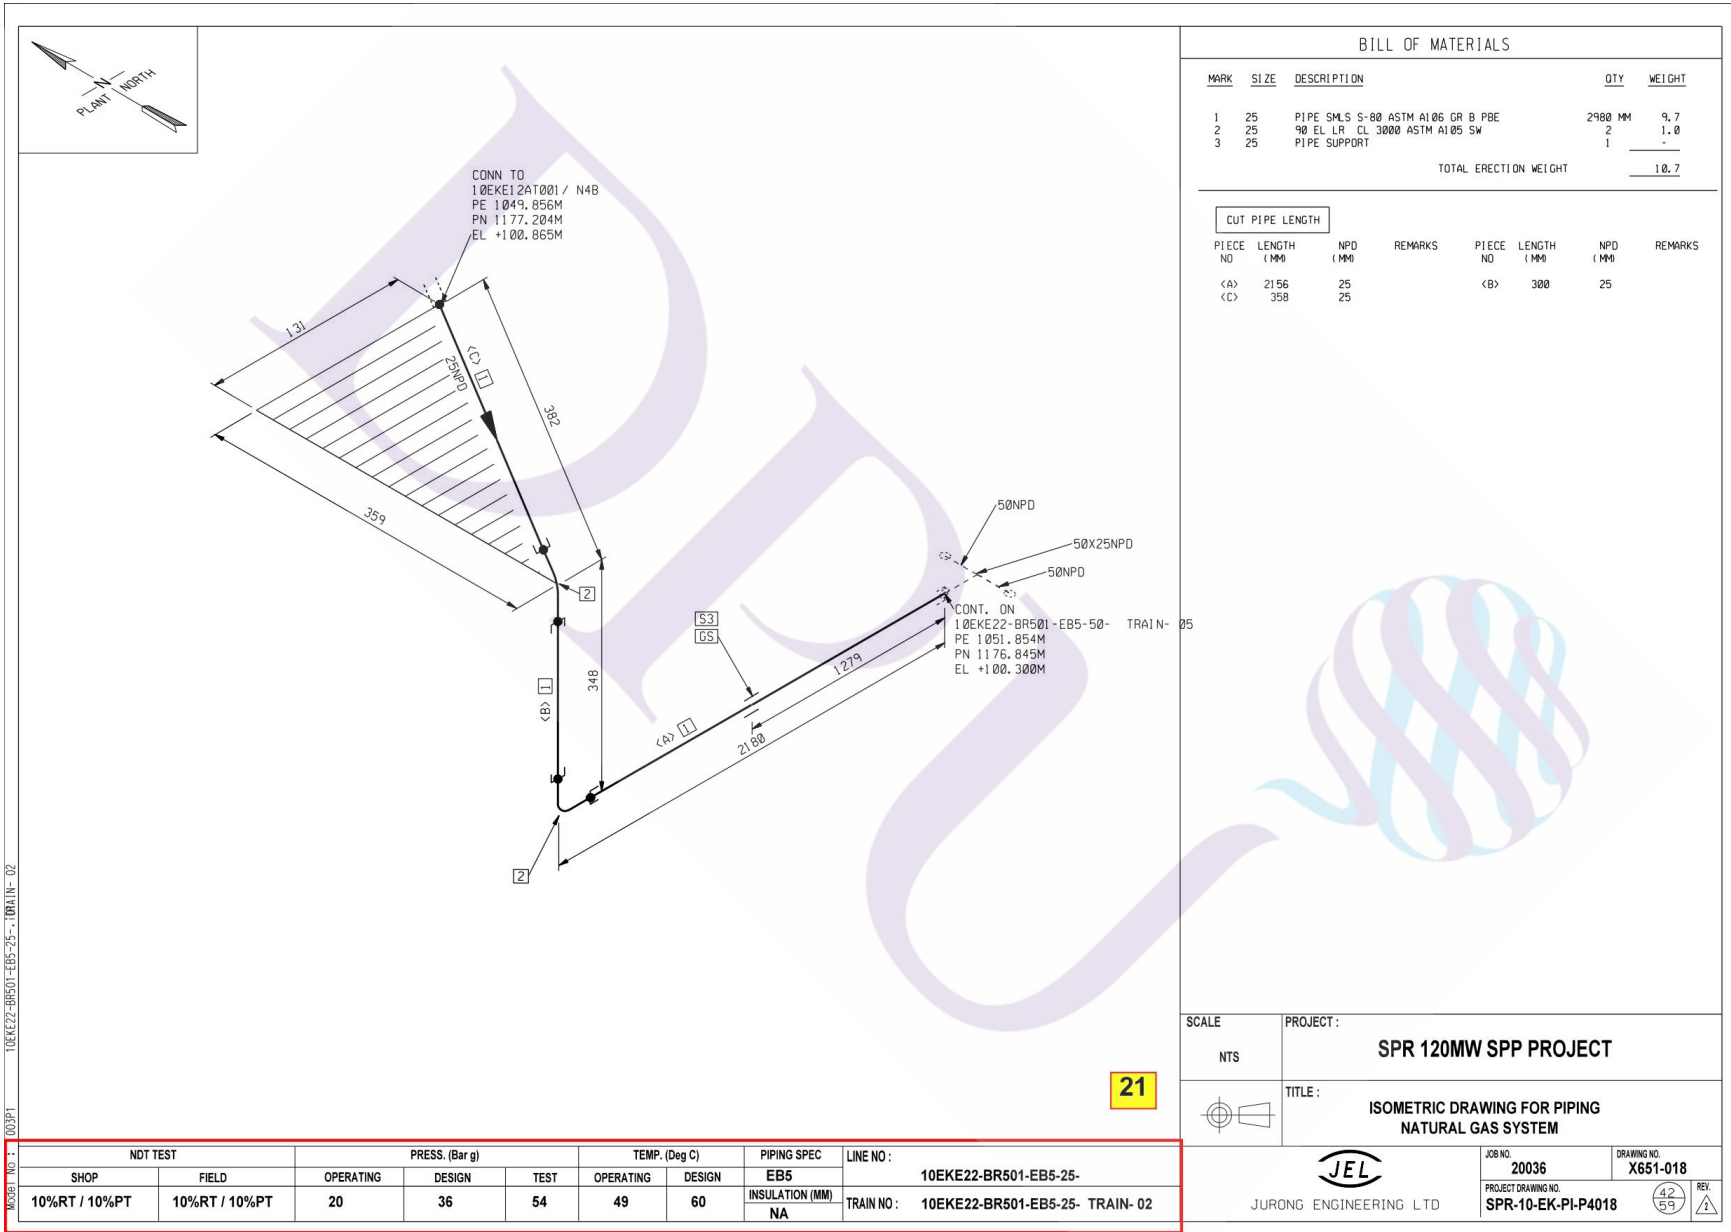

BILL OF MATERIALS

MARK	SIZE	DESCRIPTION	QTY	WEIGHT
1	25	PIPE SMLS S-B0 ASTM A105 GR B PBE	2980 MM	9.7
2	25	90 EL LR CL 3000 ASTM A105 SW	2	1.0
3	25	PIPE SUPPORT	1	-
TOTAL ERECTION WEIGHT				10.7

CUT PIPE LENGTH

PIECE NO	LENGTH (MM)	NPD (MM)	REMARKS	PIECE NO	LENGTH (MM)	NPD (MM)	REMARKS
<A>	2156	25			300	25	
<C>	358	25					

SCALE NTS	PROJECT: SPR 120MW SPP PROJECT
TITLE: ISOMETRIC DRAWING FOR PIPING NATURAL GAS SYSTEM	


10EKE22-BR501-EB5-25-TRAIN-02

NDT TEST		PRESS. (Bar g)			TEMP. (Deg C)		PIPING SPEC	LINE NO :
SHOP	FIELD	OPERATING	DESIGN	TEST	OPERATING	DESIGN	EB5	10EKE22-BR501-EB5-25-
10%RT / 10%PT	10%RT / 10%PT	20	36	54	49	60	INSULATION (MM) NA	TRAIN NO : 10EKE22-BR501-EB5-25- TRAIN- 02

JEL

JURONG ENGINEERING LTD

JOB NO. 20036	DRAWING NO. X651-018
PROJECT DRAWING NO. SPR-10-EK-PI-P4018	REV. 42/55

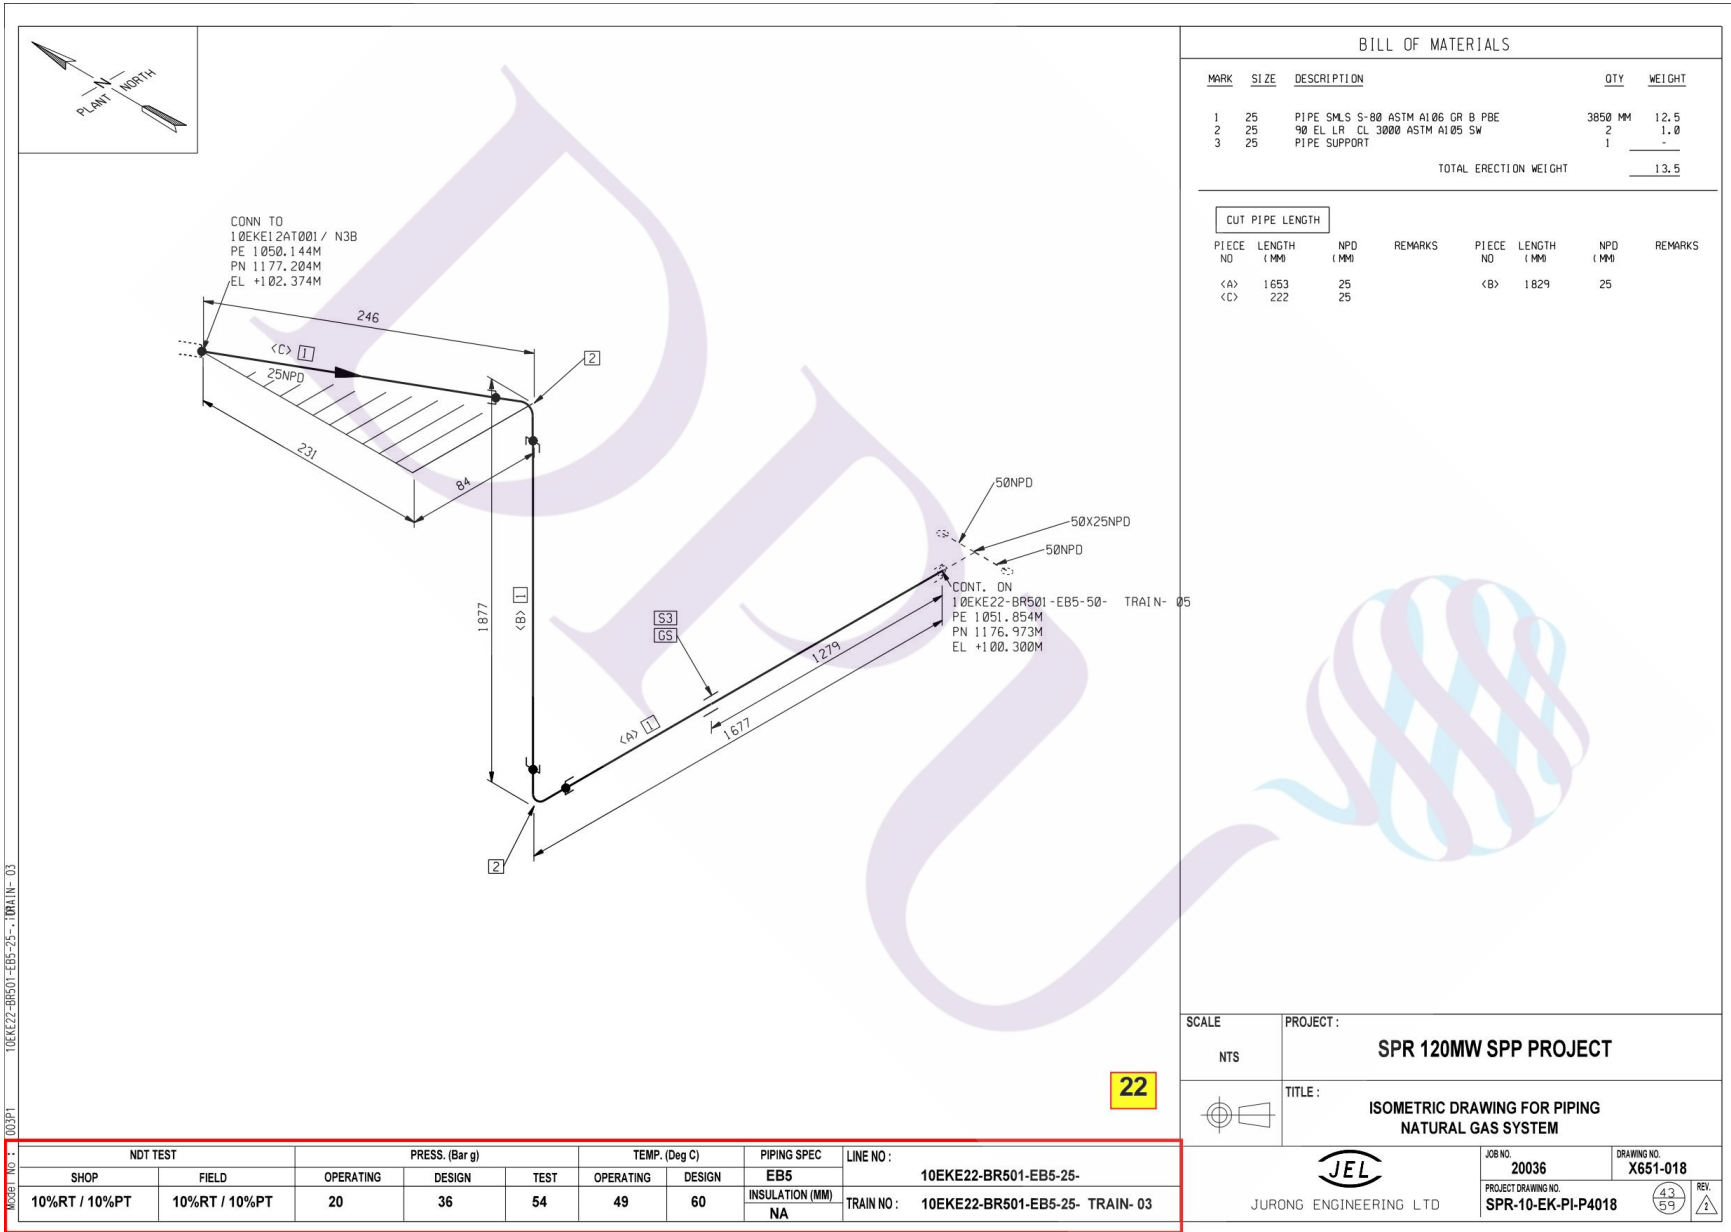

BILL OF MATERIALS

MARK	SIZE	DESCRIPTION	QTY	WEIGHT
1	25	PIPE SMLS S-B0 ASTM A105 GR B PBE	3850 MM	12.5
2	25	90 EL LR CL 3000 ASTM A105 SW	2	1.0
3	25	PIPE SUPPORT	1	-
TOTAL ERECTION WEIGHT				13.5

CUT PIPE LENGTH

PIECE NO	LENGTH (MM)	NPD (MM)	REMARKS	PIECE NO	LENGTH (MM)	NPD (MM)	REMARKS
<A>	1653	25			1829	25	
<C>	222	25					


SCALE NTS	PROJECT: SPR 120MW SPP PROJECT
TITLE: ISOMETRIC DRAWING FOR PIPING NATURAL GAS SYSTEM	

NDT TEST		PRESS. (Bar g)			TEMP. (Deg C)		PIPING SPEC	LINE NO :
SHOP	FIELD	OPERATING	DESIGN	TEST	OPERATING	DESIGN	EB5	10EKE22-BR501-EB5-25-
10%RT / 10%PT	10%RT / 10%PT	20	36	54	49	60	INSULATION (MM) NA	TRAIN NO : 10EKE22-BR501-EB5-25- TRAIN- 03

JEL
JURONG ENGINEERING LTD

JOB NO. 20036	DRAWING NO. X651-018
PROJECT DRAWING NO. SPR-10-EK-PI-P4018	REV. 43 59

MODEL NO : 10EKE22-BR501-EB5-25- TRAIN-03

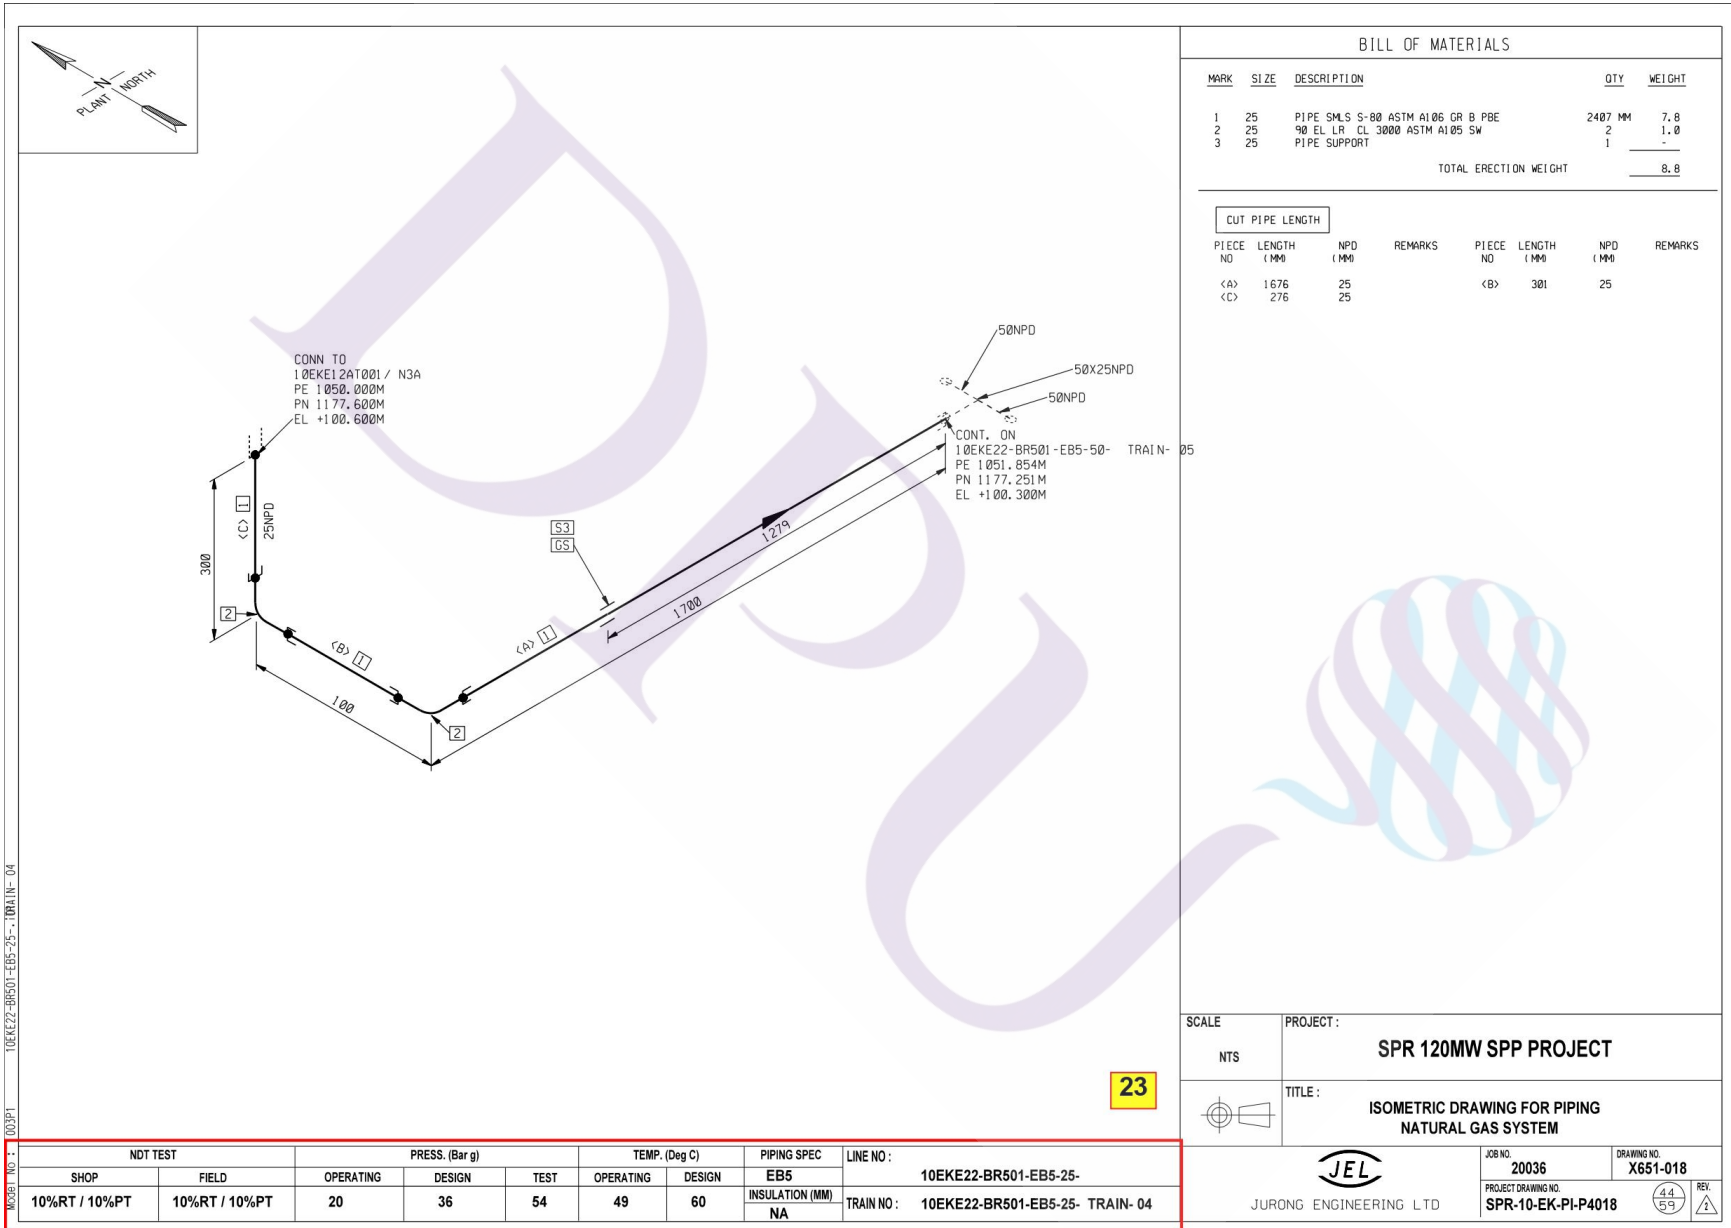

BILL OF MATERIALS

MARK	SIZE	DESCRIPTION	QTY	WEIGHT
1	25	PIPE SMLS S-B0 ASTM A105 GR B PBE	2407 MM	7.8
2	25	90 EL LR CL 3000 ASTM A105 SW	2	1.0
3	25	PIPE SUPPORT	1	-
TOTAL ERECTION WEIGHT				8.8

CUT PIPE LENGTH

PIECE NO	LENGTH (MM)	NPD (MM)	REMARKS	PIECE NO	LENGTH (MM)	NPD (MM)	REMARKS
<A>	1676	25			301	25	
<C>	276	25					

SCALE: NTS PROJECT: **SPR 120MW SPP PROJECT**

TITLE: **ISOMETRIC DRAWING FOR PIPING NATURAL GAS SYSTEM**

MODEL NO.: 10EKE22-BR501-EB5-25-TRAIN-04


23

NDT TEST		PRESS. (Bar g)			TEMP. (Deg C)		PIPING SPEC	LINE NO :
SHOP	FIELD	OPERATING	DESIGN	TEST	OPERATING	DESIGN	EB5	10EKE22-BR501-EB5-25-
10%RT / 10%PT	10%RT / 10%PT	20	36	54	49	60	INSULATION (MM) NA	TRAIN NO : 10EKE22-BR501-EB5-25- TRAIN-04

JEL

JURONG ENGINEERING LTD

JOB NO. 20036	DRAWING NO. X651-018
PROJECT DRAWING NO. SPR-10-EK-PI-P4018	REV. 4.4

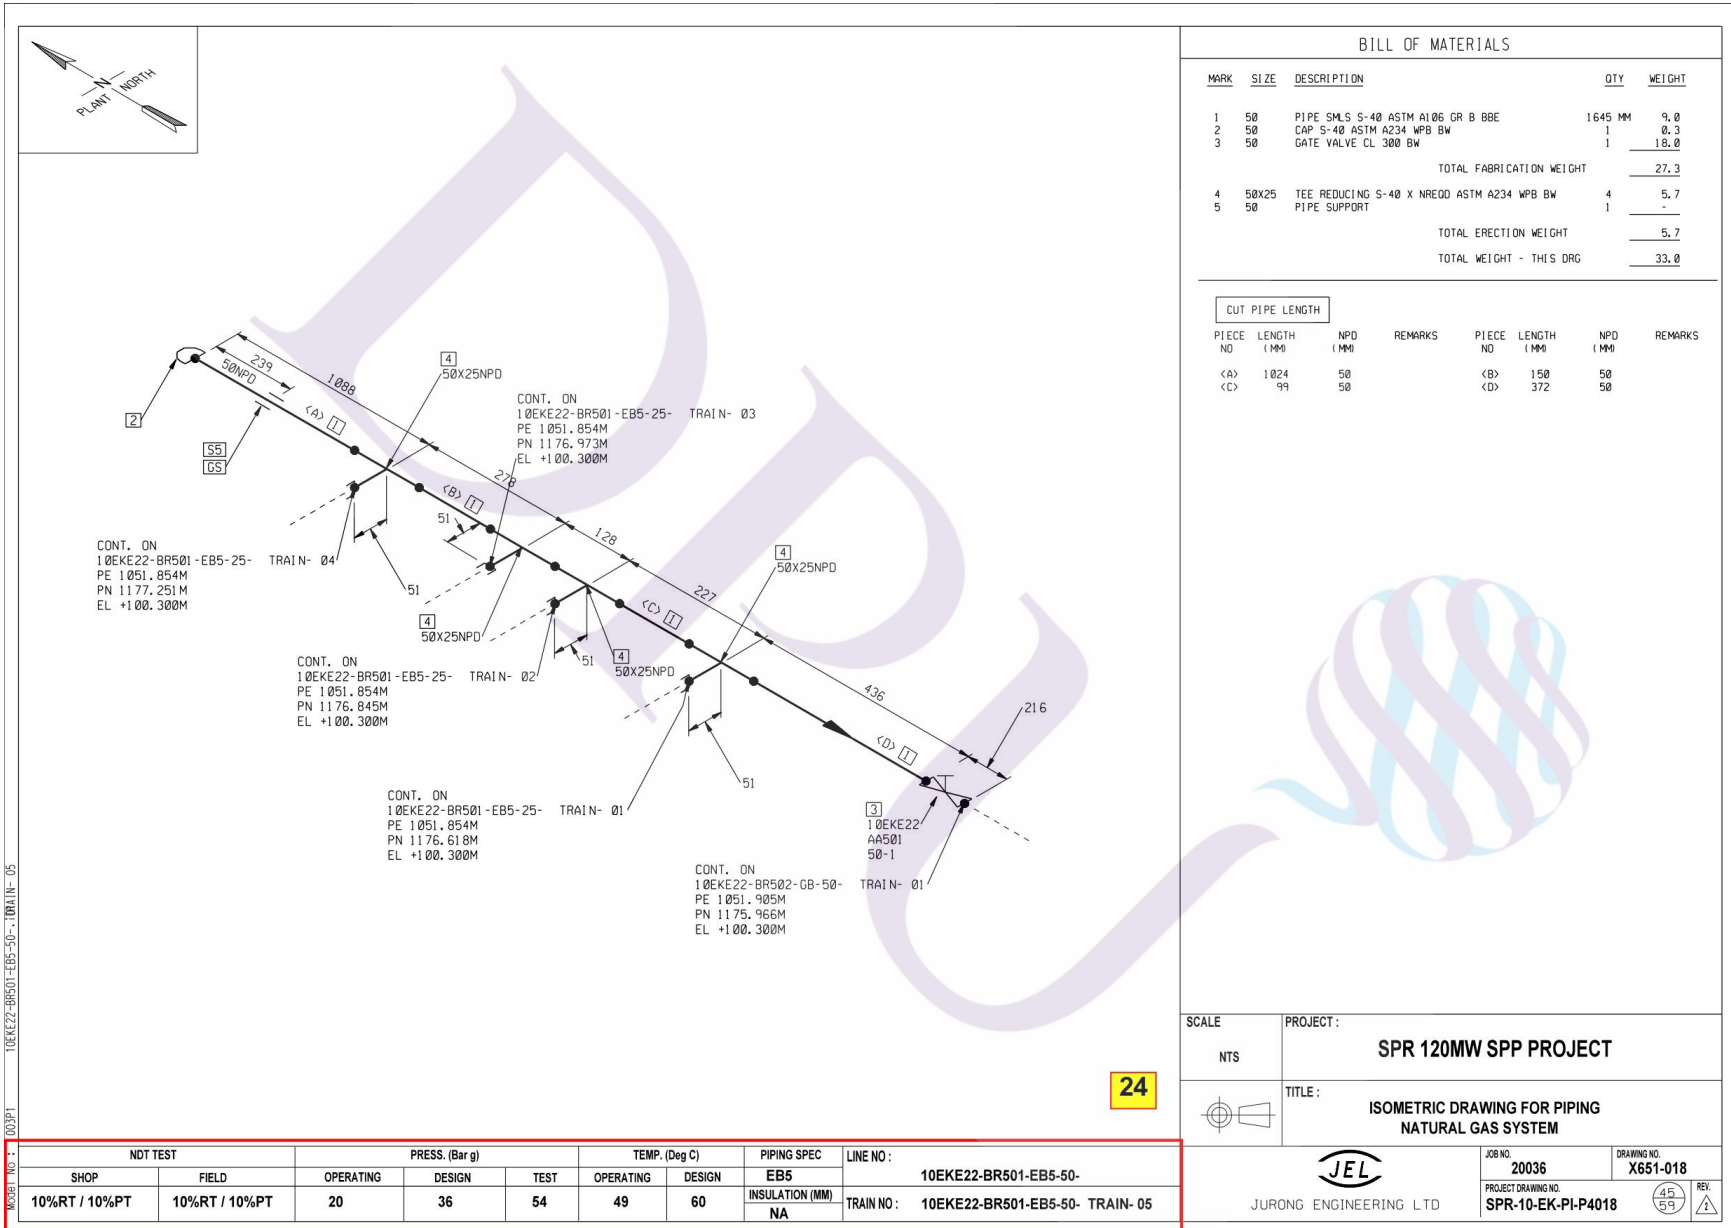

BILL OF MATERIALS

MARK	SIZE	DESCRIPTION	QTY	WEIGHT
1	50	PIPE SMLS S-40 ASTM A105 GR B BBE	1645 MM	9.0
2	50	CAP S-40 ASTM A234 WPB BW	1	0.3
3	50	GATE VALVE CL 300 BW	1	18.0
TOTAL FABRICATION WEIGHT				27.3
4	50X25	TEE REDUCING S-40 X NREOD ASTM A234 WPB BW	4	5.7
5	50	PIPE SUPPORT	1	-
TOTAL ERECTION WEIGHT				5.7
TOTAL WEIGHT - THIS DRG				33.0

CUT PIPE LENGTH

PIECE NO	LENGTH (MM)	NPD (MM)	REMARKS	PIECE NO	LENGTH (MM)	NPD (MM)	REMARKS
<A>	1024	50			150	50	
<C>	99	50		<D>	372	50	

SCALE: NTS
 PROJECT: SPR 120MW SPP PROJECT
 TITLE: ISOMETRIC DRAWING FOR PIPING NATURAL GAS SYSTEM

24

MODEL NO.: 10EKE22-BR501-EB5-50-TRAIN-05

NDT TEST			PRESS. (Bar g)			TEMP. (Deg C)		PIPING SPEC	LINE NO :
SHOP	FIELD	OPERATING	DESIGN	TEST	OPERATING	DESIGN	EB5	10EKE22-BR501-EB5-50-	
10%RT / 10%PT	10%RT / 10%PT	20	36	54	49	60	INSULATION (MM) NA	TRAIN NO: 10EKE22-BR501-EB5-50- TRAIN-05	




JURONG ENGINEERING LTD

JOB NO. 20036
 DRAWING NO. X651-018
 PROJECT DRAWING NO. SPR-10-EK-PI-P4018



REV.

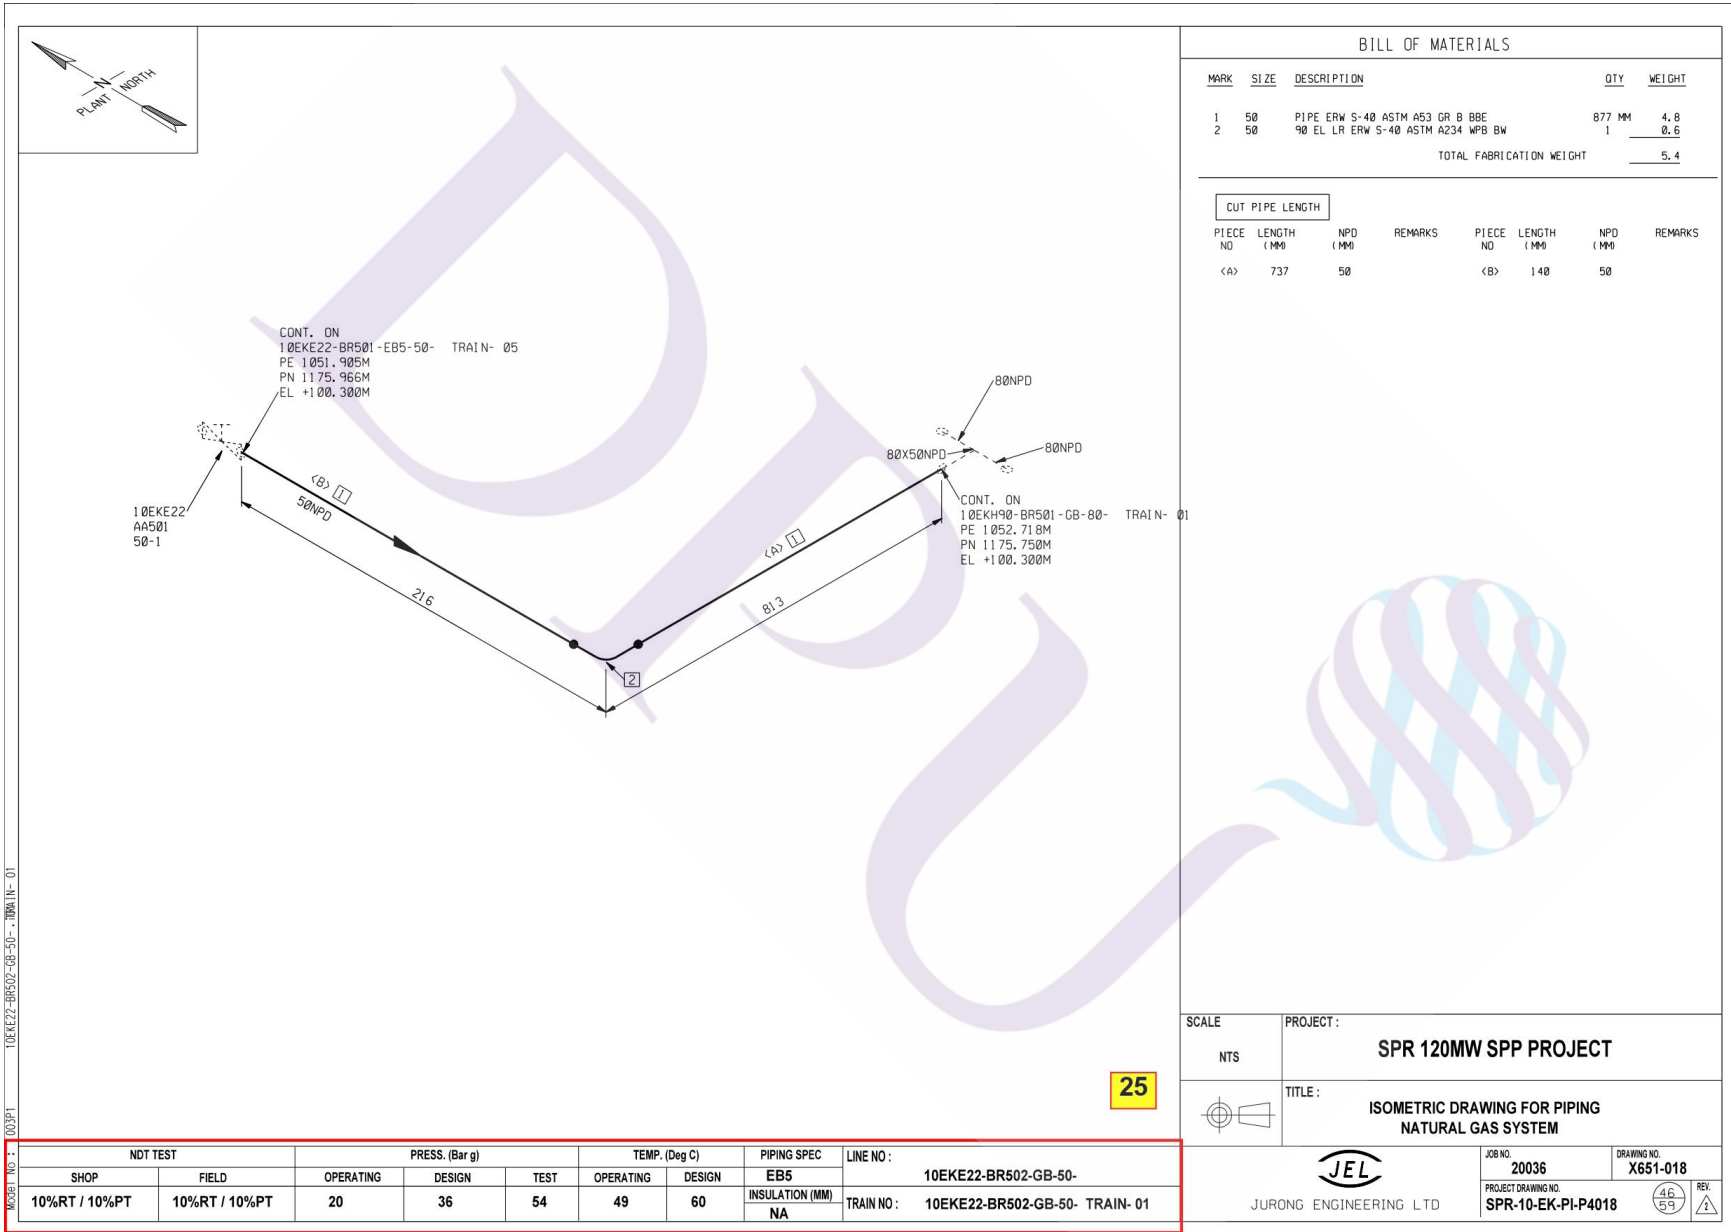

BILL OF MATERIALS

MARK	SIZE	DESCRIPTION	QTY	WEIGHT
1	50	PIPE ERW S-40 ASTM A53 GR B BBE	877 MM	4.8
2	50	90 EL LR ERW S-40 ASTM A234 WP8 BW	1	0.6
TOTAL FABRICATION WEIGHT				5.4

CUT PIPE LENGTH

PIECE NO	LENGTH (MM)	NPD (MM)	REMARKS	PIECE NO	LENGTH (MM)	NPD (MM)	REMARKS
<A>	737	50			140	50	


SCALE NTS	PROJECT: SPR 120MW SPP PROJECT
--------------	--

TITLE: ISOMETRIC DRAWING FOR PIPING NATURAL GAS SYSTEM
--

 JURONG ENGINEERING LTD	JOB NO. 20036	DRAWING NO. X651-018
	PROJECT DRAWING NO. SPR-10-EK-PI-P4018	REV. 4/6 5/9

MODEL NO : 10EKE22-BR502-GB-50- -NBR-IN- 01

NDT TEST		PRESS. (Bar g)			TEMP. (Deg C)		PIPING SPEC	LINE NO :
SHOP	FIELD	OPERATING	DESIGN	TEST	OPERATING	DESIGN	EB5	10EKE22-BR502-GB-50-
10%RT / 10%PT	10%RT / 10%PT	20	36	54	49	60	INSULATION (MM) NA	TRAIN NO : 10EKE22-BR502-GB-50- TRAIN- 01

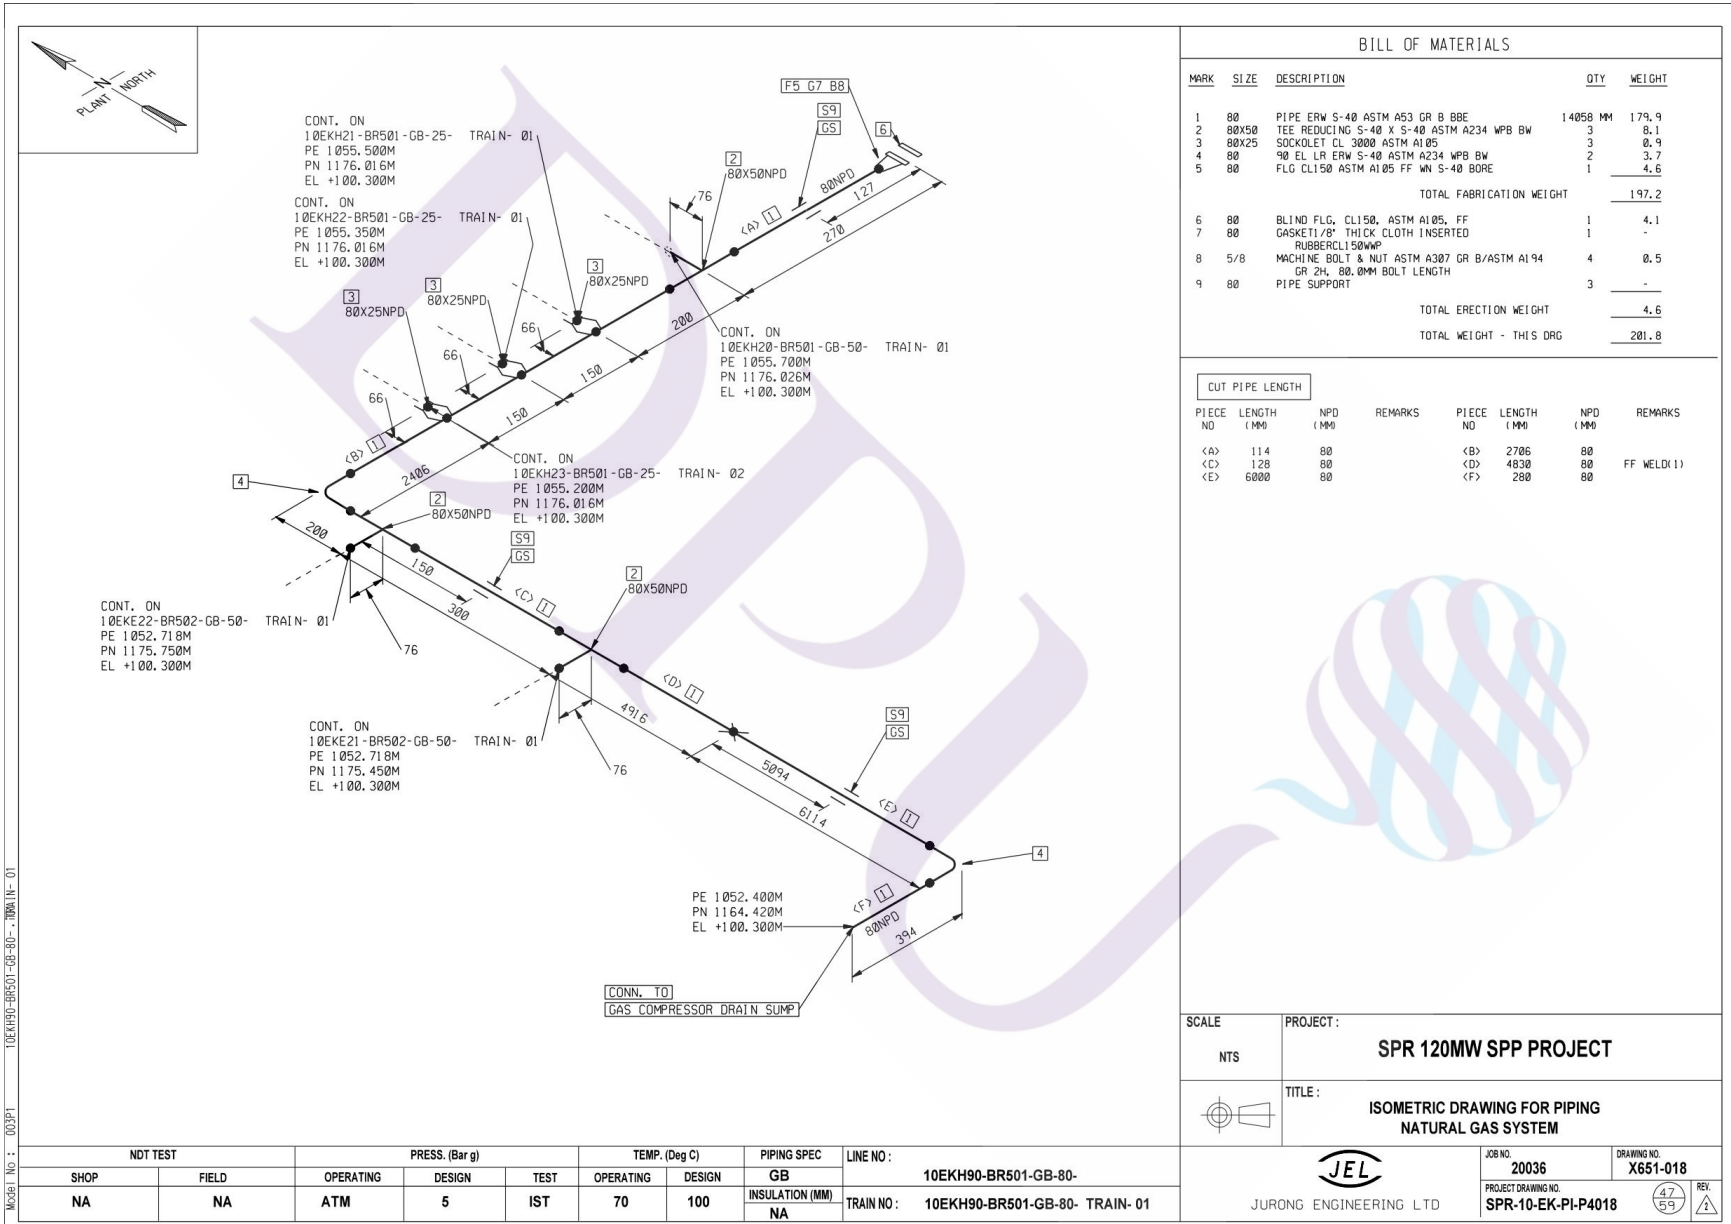

Model No.: 00391 10EKH90-BR501-GB-80-TRAIN-01

NDT TEST		PRESS. (Bar g)			TEMP. (Deg C)		PIPING SPEC	LINE NO :
SHOP	FIELD	OPERATING	DESIGN	TEST	OPERATING	DESIGN	GB	10EKH90-BR501-GB-80-
NA	NA	ATM	5	IST	70	100	INSULATION (MM) NA	TRAIN NO : 10EKH90-BR501-GB-80- TRAIN- 01

SCALE: NTS PROJECT: **SPR 120MW SPP PROJECT**


TITLE: **ISOMETRIC DRAWING FOR PIPING NATURAL GAS SYSTEM**

JEL JURONG ENGINEERING LTD

JOB NO. 20036 DRAWING NO. X651-018

PROJECT DRAWING NO. SPR-10-EK-PI-P4018

REV. 47/59

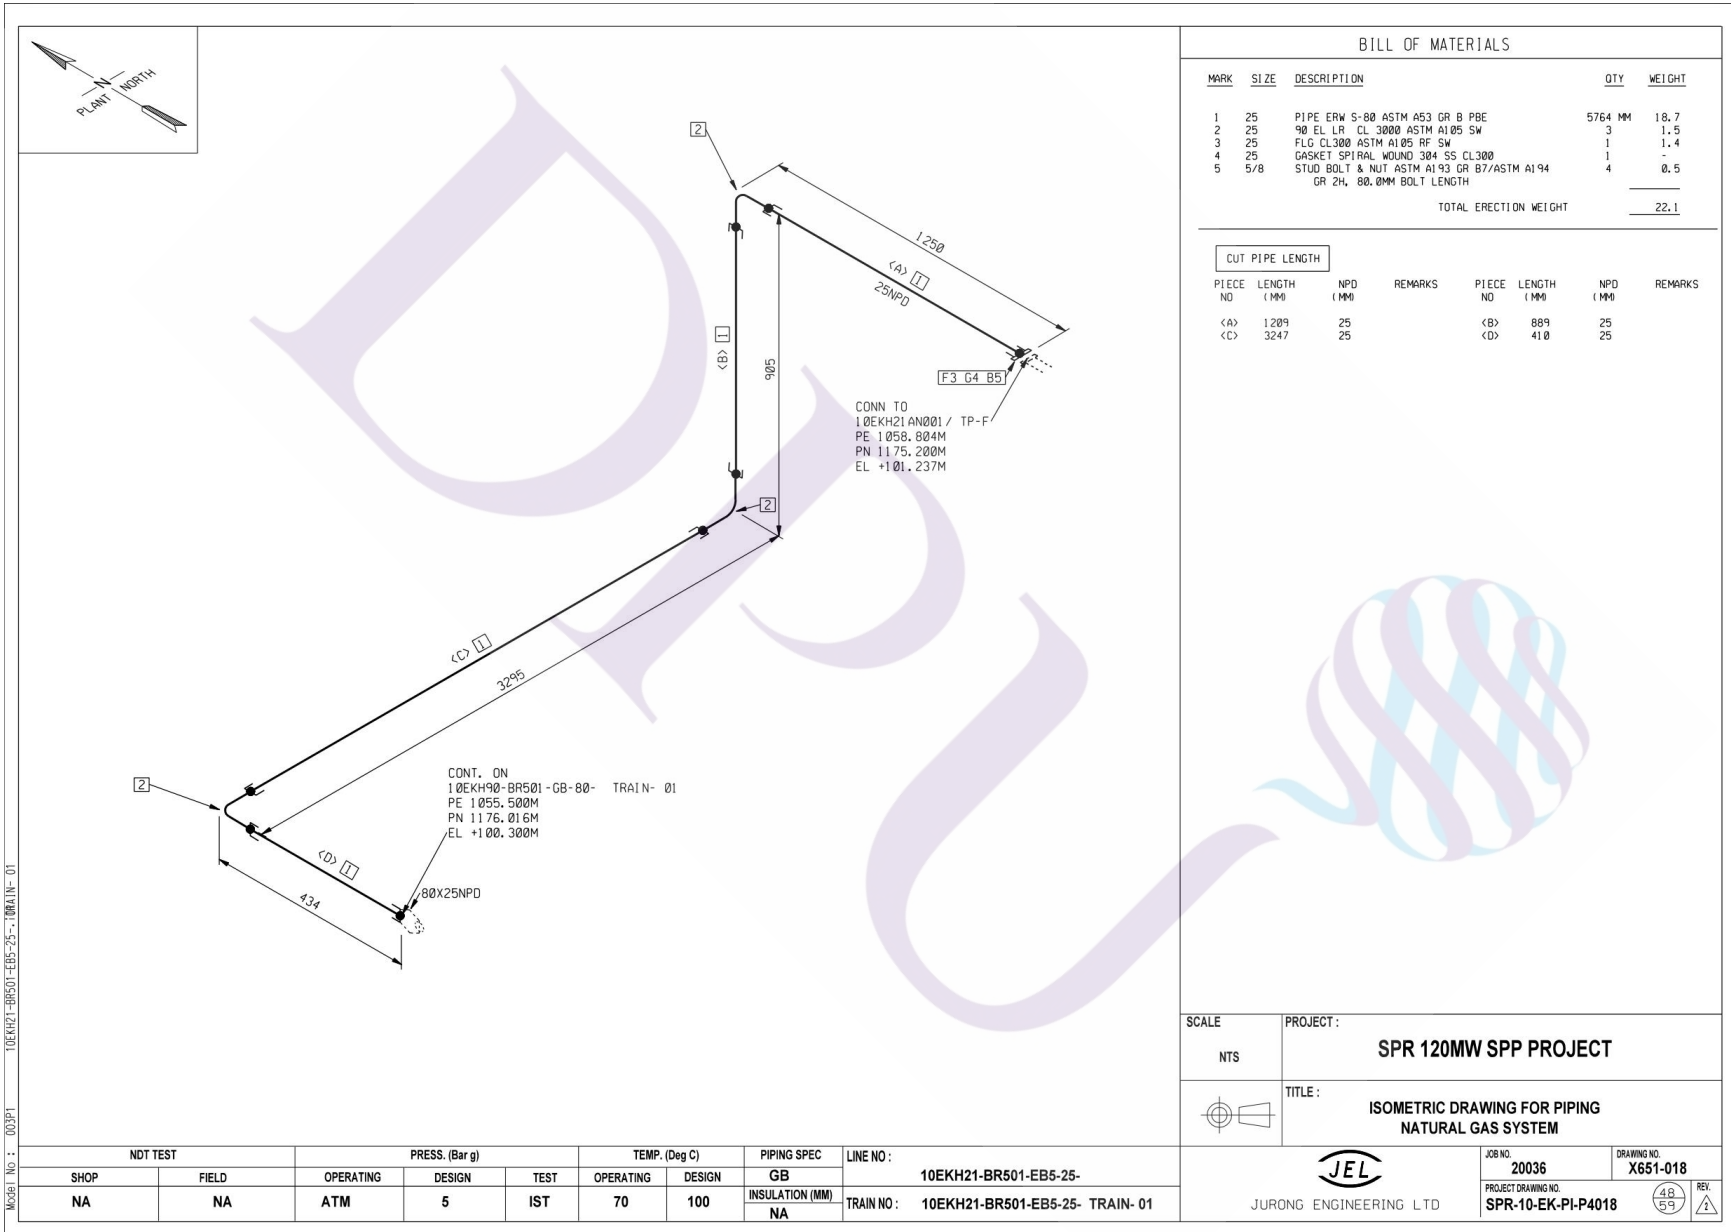

BILL OF MATERIALS

MARK	SIZE	DESCRIPTION	QTY	WEIGHT
1	25	PIPE ERW S-80 ASTM A53 GR B PBE	5764 MM	18.7
2	25	90 EL LR CL 3000 ASTM A105 SW	3	1.5
3	25	FLG CL300 ASTM A105 RF SW	1	1.4
4	25	GASKET SPIRAL WOUND 304 SS CL300	1	-
5	5/8	STUD BOLT & NUT ASTM A193 GR B7/ASTM A194 GR 2H, 80.0MM BOLT LENGTH	4	0.5
TOTAL ERECTION WEIGHT				22.1

CUT PIPE LENGTH

PIECE NO	LENGTH (MM)	NPD (MM)	REMARKS	PIECE NO	LENGTH (MM)	NPD (MM)	REMARKS
<A>	1209	25			889	25	
<C>	3247	25		<D>	410	25	

SCALE: NTS

PROJECT: **SPR 120MW SPP PROJECT**

TITLE: **ISOMETRIC DRAWING FOR PIPING NATURAL GAS SYSTEM**

JEL JURONG ENGINEERING LTD


JOB NO: 20036 DRAWING NO: X651-018

PROJECT DRAWING NO: SPR-10-EK-PI-P4018


Model No.: 00391 10EKH21-BR501-EB5-25-TRAIN-01

NDT TEST		PRESS. (Bar g)			TEMP. (Deg C)		PIPING SPEC	LINE NO :
SHOP	FIELD	OPERATING	DESIGN	TEST	OPERATING	DESIGN	GB	10EKH21-BR501-EB5-25-
NA	NA	ATM	5	IST	70	100	INSULATION (MM) NA	TRAIN NO: 10EKH21-BR501-EB5-25- TRAIN-01

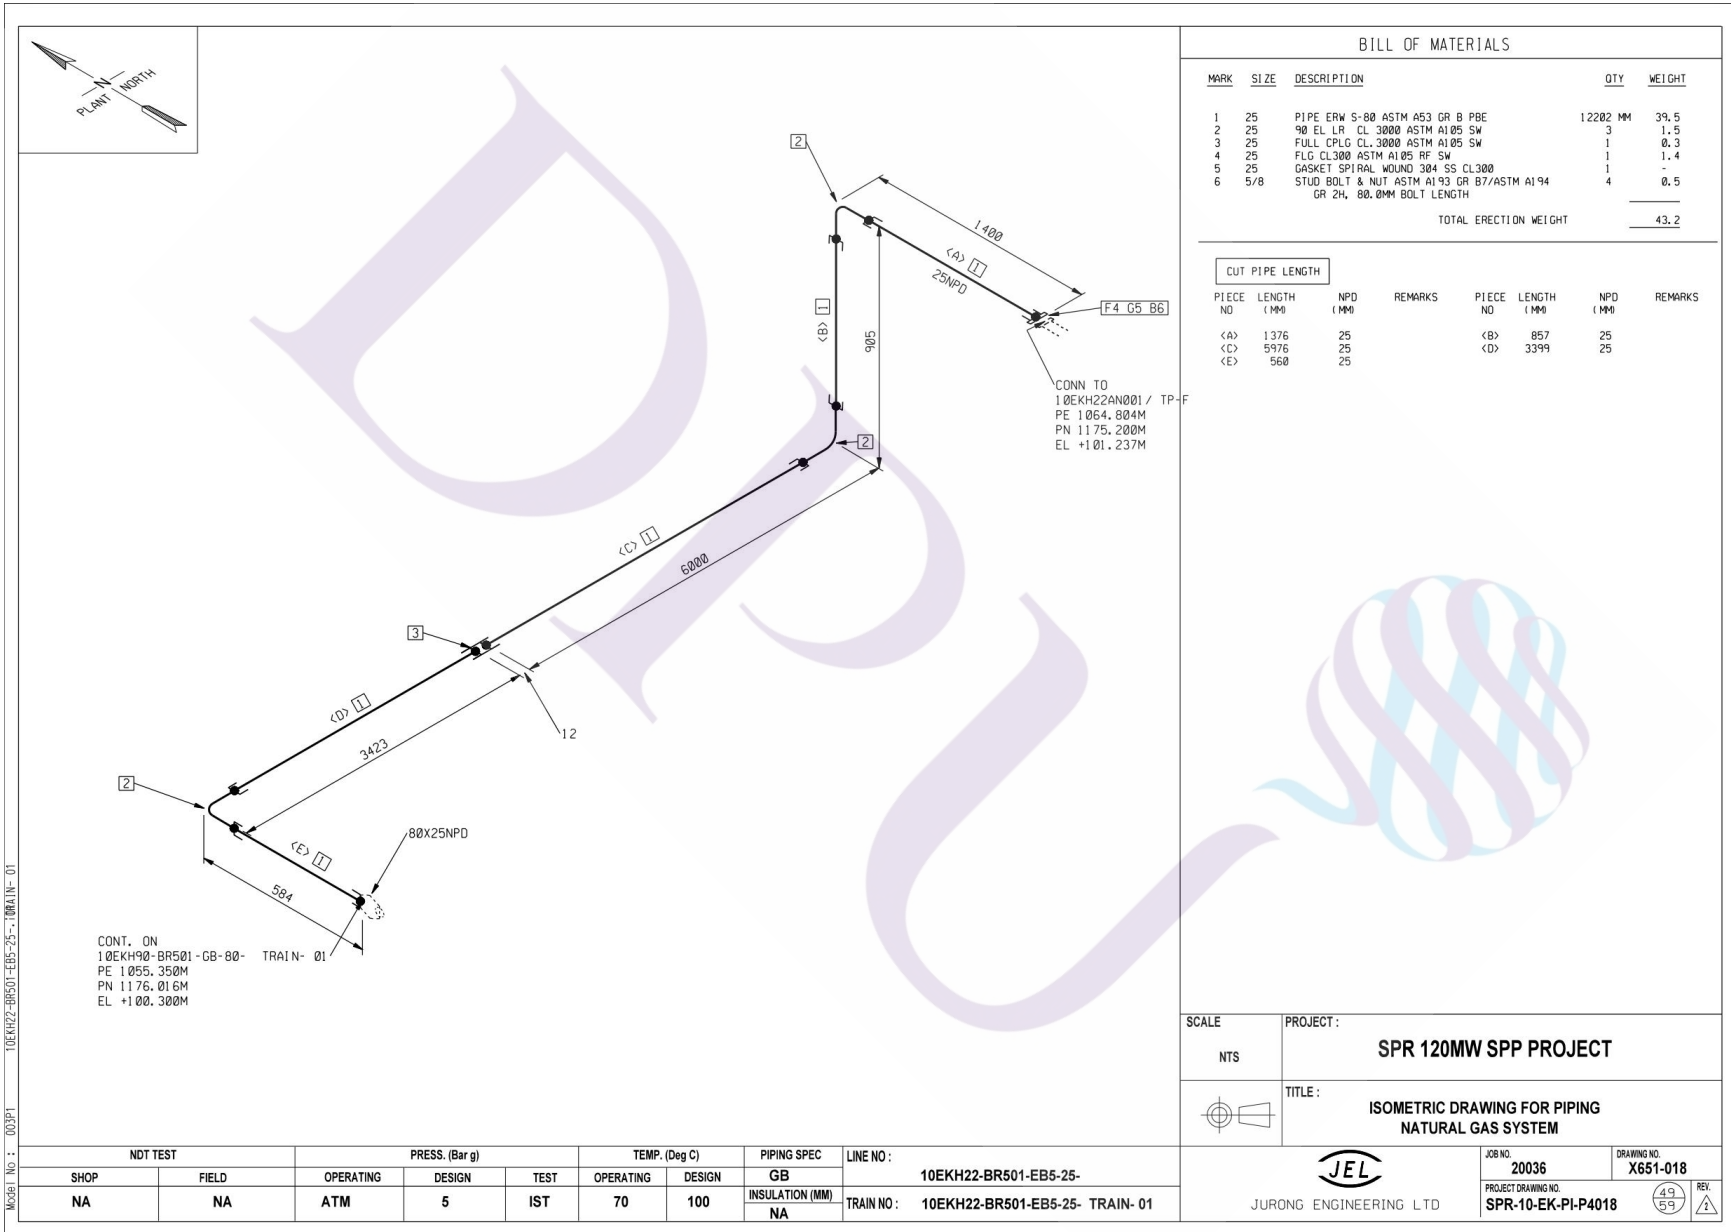

BILL OF MATERIALS

MARK	SIZE	DESCRIPTION	QTY	WEIGHT
1	25	PIPE ERW S-80 ASTM A53 GR B PBE	12202 MM	39.5
2	25	90 EL LR CL 3000 ASTM A105 SW	3	1.5
3	25	FULL CPLG CL 3000 ASTM A105 SW	1	0.3
4	25	FLG CL300 ASTM A105 RF SW	1	1.4
5	25	GASKET SPIRAL WOUND 304 SS CL300	1	-
6	5/8	STUD BOLT & NUT ASTM A193 GR B7/ASTM A194 GR 2H, 80.0MM BOLT LENGTH	4	0.5
TOTAL ERECTION WEIGHT				43.2

CUT PIPE LENGTH

PIECE NO	LENGTH (MM)	NPD (MM)	REMARKS	PIECE NO	LENGTH (MM)	NPD (MM)	REMARKS
<A>	1376	25			857	25	
<C>	5976	25		<D>	3399	25	
<E>	560	25					

CONN TO
10EKH22AN001 / TP-F
PE 1064.804M
PN 1175.200M
EL +101.237M

CONT. ON
10EKH90-BR501-GB-80- TRAI N- 01
PE 1055.350M
PN 1176.016M
EL +100.300M


SCALE NTS	PROJECT: SPR 120MW SPP PROJECT
	TITLE: ISOMETRIC DRAWING FOR PIPING NATURAL GAS SYSTEM

Model No : 003P1 10EKH22-BR501-EB5-25-TRAIN-01

NDT TEST		PRESS. (Bar g)			TEMP. (Deg C)		PIPING SPEC	LINE NO :
SHOP	FIELD	OPERATING	DESIGN	TEST	OPERATING	DESIGN	GB	10EKH22-BR501-EB5-25-
NA	NA	ATM	5	IST	70	100	INSULATION (MM) NA	TRAIN NO : 10EKH22-BR501-EB5-25- TRAIN-01

JURONG ENGINEERING LTD

JOB NO. 20036	DRAWING NO. X651-018		
PROJECT DRAWING NO. SPR-10-EK-PI-P4018	REV. <table border="1"> <tr> <td>49</td> <td>59</td> </tr> </table>	49	59
49	59		

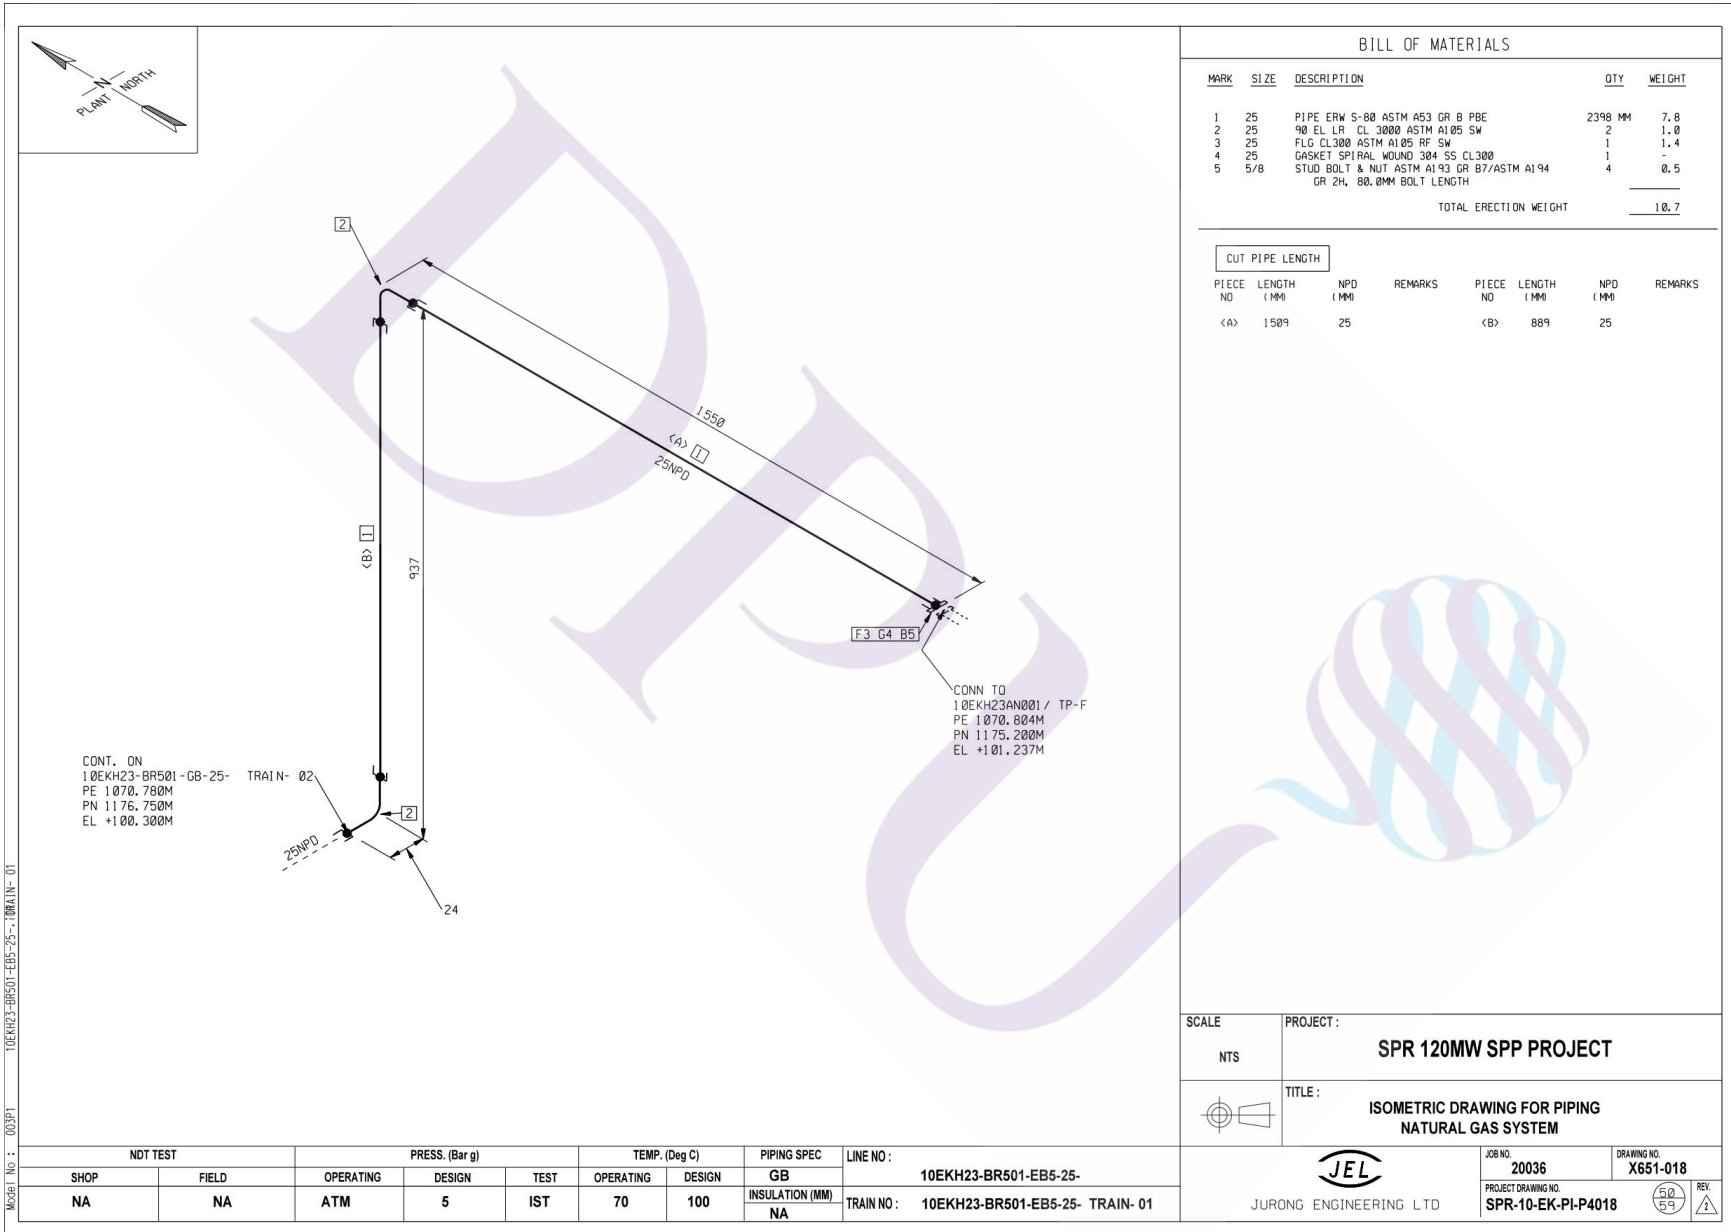

BILL OF MATERIALS

MARK	SIZE	DESCRIPTION	QTY	WEIGHT
1	25	PIPE ERW S-80 ASTM A53 GR B PBE	2398 MM	7.8
2	25	90 EL LR CL 3000 ASTM A105 SW	2	1.0
3	25	FLG CL300 ASTM A105 RF SW	1	1.4
4	25	GASKET SPIRAL WOUND 304 SS CL300	1	-
5	5/8	STUD BOLT & NUT ASTM A193 GR B7/ASTM A194 GR 2H, 80.0MM BOLT LENGTH	4	0.5
TOTAL ERECTION WEIGHT				10.7

CUT PIPE LENGTH

PIECE NO	LENGTH (MM)	NPD (MM)	REMARKS	PIECE NO	LENGTH (MM)	NPD (MM)	REMARKS
<A>	1509	25			889	25	


SCALE NTS	PROJECT: SPR 120MW SPP PROJECT
	TITLE: ISOMETRIC DRAWING FOR PIPING NATURAL GAS SYSTEM

Model No.: 00391 10EKH23-BR501-EB5-25- TRAIN-01

NDT TEST		PRESS. (Bar g)			TEMP. (Deg C)		PIPING SPEC	LINE NO :
SHOP	FIELD	OPERATING	DESIGN	TEST	OPERATING	DESIGN	GB	10EKH23-BR501-EB5-25-
NA	NA	ATM	5	IST	70	100	INSULATION (MM) NA	TRAIN NO : 10EKH23-BR501-EB5-25- TRAIN-01

JURONG ENGINEERING LTD

JOB NO. 20036	DRAWING NO. X651-018
PROJECT DRAWING NO. SPR-10-EK-PI-P4018	REV.

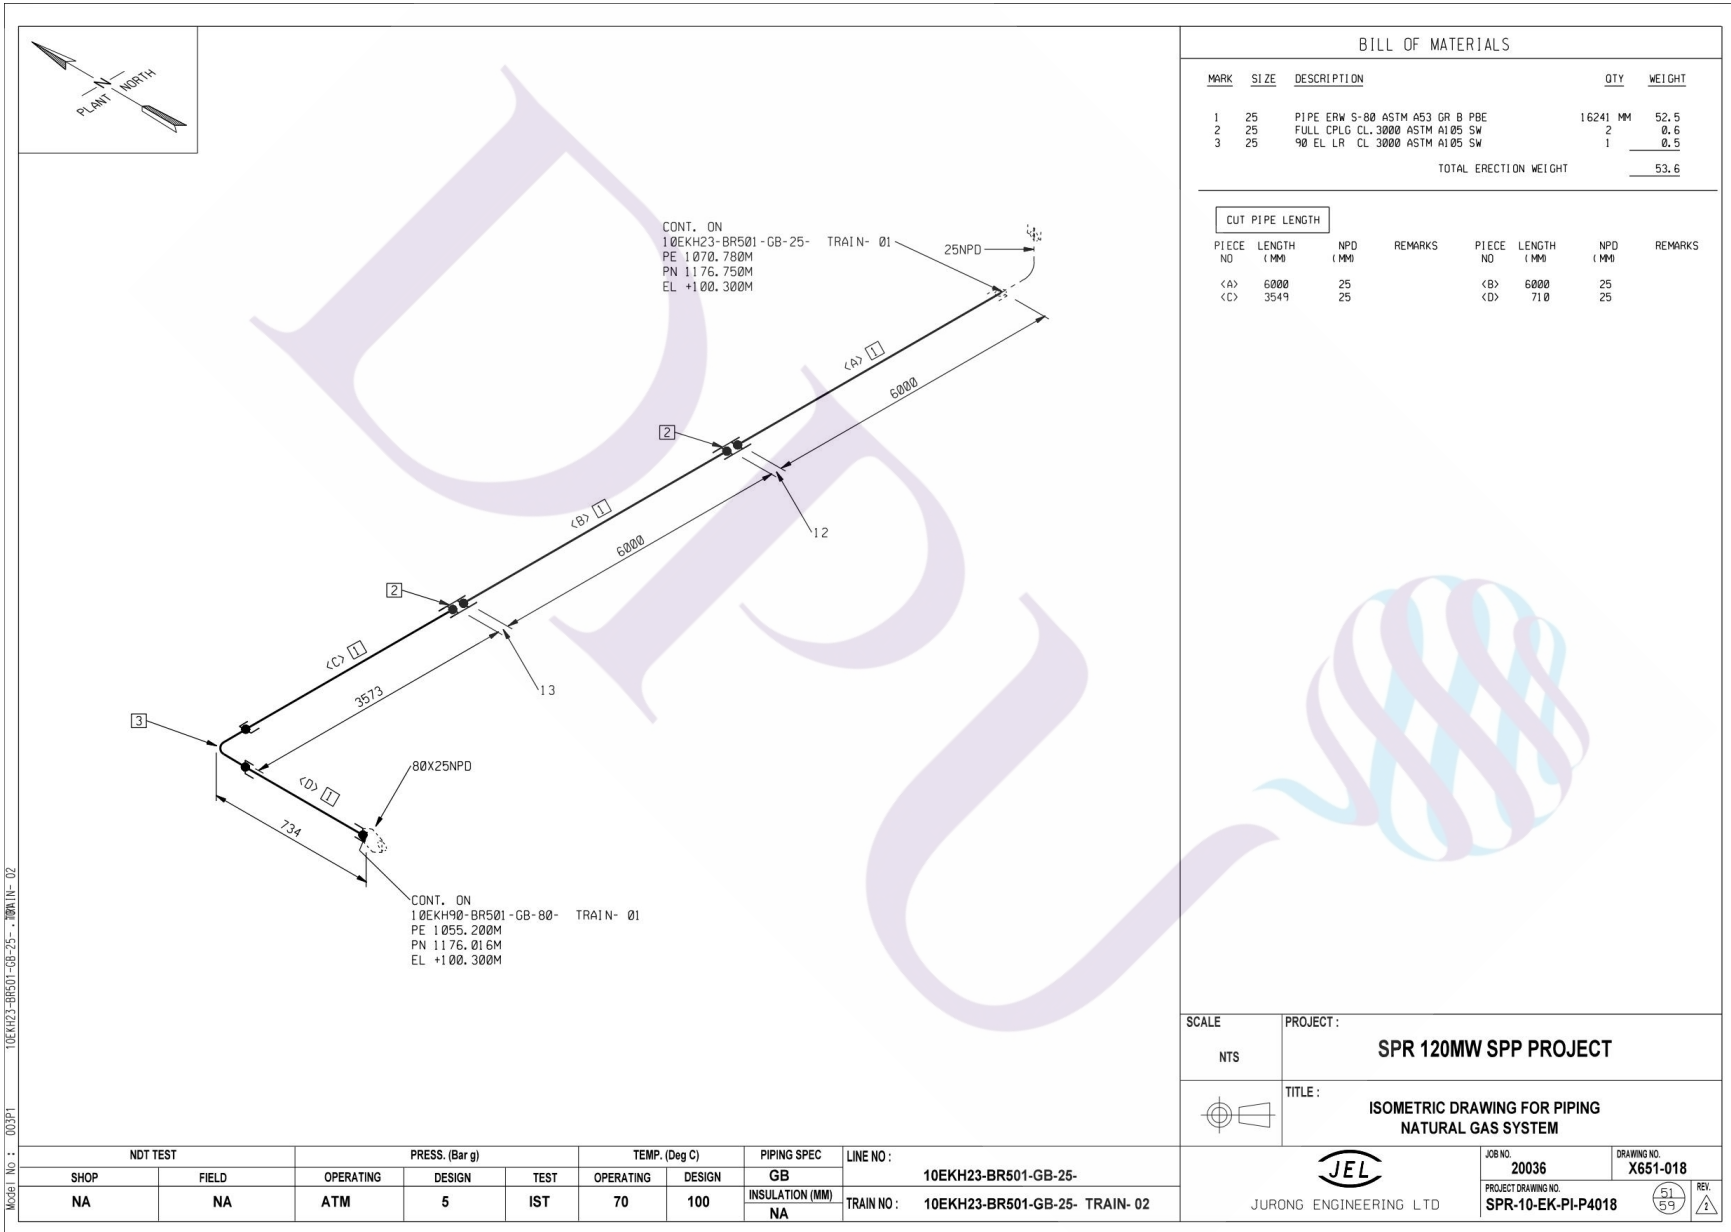

BILL OF MATERIALS

MARK	SIZE	DESCRIPTION	QTY	WEIGHT
1	25	PIPE ERW S-80 ASTM A53 GR B PBE	16241 MM	52.5
2	25	FULL CPLG CL. 3000 ASTM A105 SW	2	0.6
3	25	90 EL LR CL. 3000 ASTM A105 SW	1	0.5
TOTAL ERECTION WEIGHT				53.6

CUT PIPE LENGTH

PIECE NO	LENGTH (MM)	NPD (MM)	REMARKS	PIECE NO	LENGTH (MM)	NPD (MM)	REMARKS
<A>	6000	25			6000	25	
<C>	3549	25		<D>	710	25	

SCALE NTS	PROJECT: SPR 120MW SPP PROJECT
	TITLE: ISOMETRIC DRAWING FOR PIPING NATURAL GAS SYSTEM


Model No.: 00391 10EKH23-BR501-GB-25- TRAIN-01

NDT TEST		PRESS. (Bar g)			TEMP. (Deg C)		PIPING SPEC	LINE NO :
SHOP	FIELD	OPERATING	DESIGN	TEST	OPERATING	DESIGN	GB	10EKH23-BR501-GB-25-
NA	NA	ATM	5	IST	70	100	INSULATION (MM) NA	TRAIN NO : 10EKH23-BR501-GB-25- TRAIN- 02

JURONG ENGINEERING LTD

JOB NO. 20036	DRAWING NO. X651-018
PROJECT DRAWING NO. SPR-10-EK-PI-P4018	

REV.

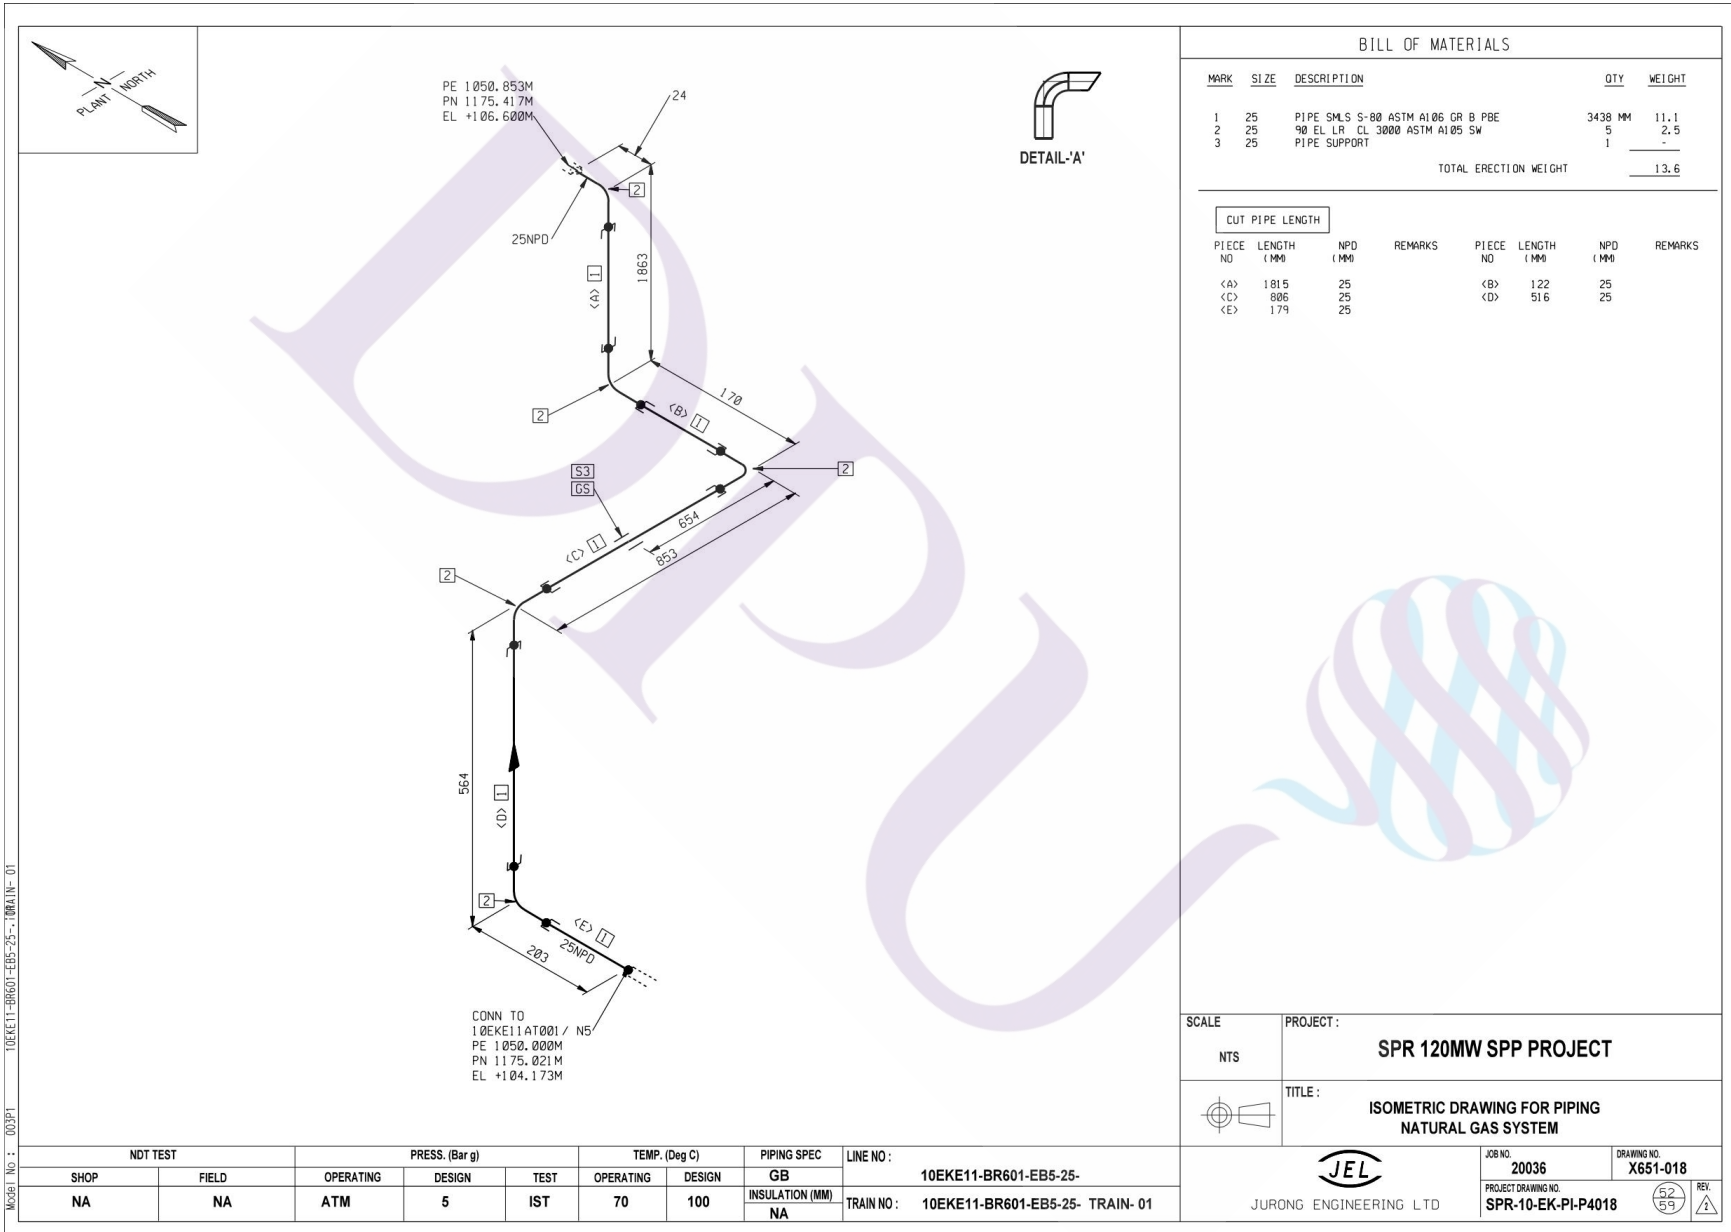

BILL OF MATERIALS

MARK	SIZE	DESCRIPTION	QTY	WEIGHT
1	25	PIPE SMLS S-B0 ASTM A105 GR B PBE	3438 MM	11.1
2	25	90 EL LR CL 3000 ASTM A105 SW	5	2.5
3	25	PIPE SUPPORT	1	-
TOTAL ERECTION WEIGHT				13.6

CUT PIPE LENGTH

PIECE NO	LENGTH (MM)	NPD (MM)	REMARKS	PIECE NO	LENGTH (MM)	NPD (MM)	REMARKS
<A>	1815	25			122	25	
<C>	806	25		<D>	516	25	
<E>	179	25					


SCALE NTS	PROJECT: SPR 120MW SPP PROJECT
	TITLE: ISOMETRIC DRAWING FOR PIPING NATURAL GAS SYSTEM

Model No.: 003P1
PROJECT: 10EKE11-BR601-EB5-25-TRAIN-01

NDT TEST		PRESS. (Bar g)			TEMP. (Deg C)		PIPING SPEC	LINE NO :
SHOP	FIELD	OPERATING	DESIGN	TEST	OPERATING	DESIGN	GB	10EKE11-BR601-EB5-25-
NA	NA	ATM	5	IST	70	100	INSULATION (MM) NA	TRAIN NO : 10EKE11-BR601-EB5-25- TRAIN- 01

JURONG ENGINEERING LTD

JOB NO. 20036	DRAWING NO. X651-018
PROJECT DRAWING NO. SPR-10-EK-PI-P4018	REV.

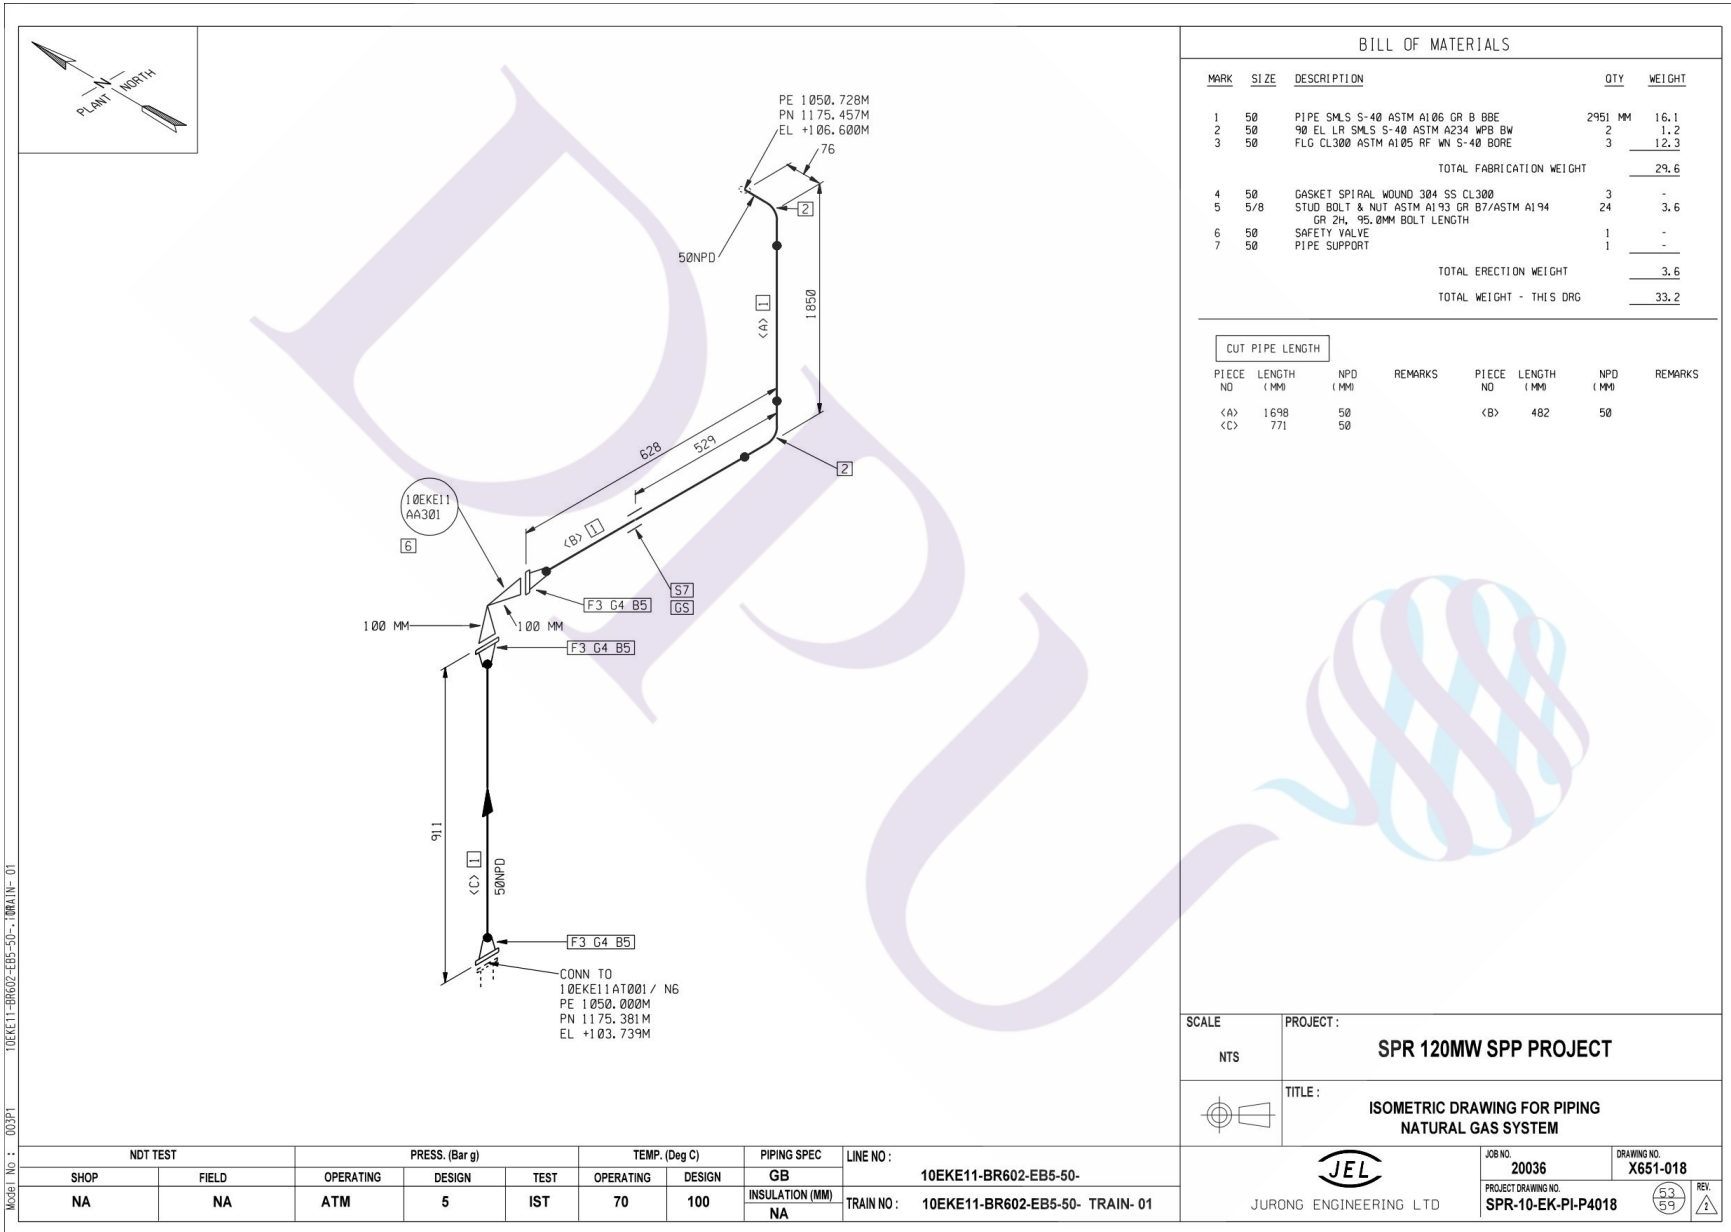

BILL OF MATERIALS

MARK	SIZE	DESCRIPTION	QTY	WEIGHT
1	50	PIPE SMLS S-40 ASTM A106 GR B BBE	2951 MM	16.1
2	50	90 EL LR SMLS S-40 ASTM A234 WPB BW	2	1.2
3	50	FLG CL300 ASTM A105 RF WN S-40 BORE	3	12.3
TOTAL FABRICATION WEIGHT				29.6
4	50	GASKET SPIRAL WOUND 304 SS CL300	3	-
5	5/8	STUD BOLT & NUT ASTM A193 GR B7/ASTM A194 GR 2H, 95.0MM BOLT LENGTH	24	3.6
6	50	SAFETY VALVE	1	-
7	50	PIPE SUPPORT	1	-
TOTAL ERECTION WEIGHT				3.6
TOTAL WEIGHT - THIS DRG				33.2

CUT PIPE LENGTH

PIECE NO	LENGTH (MM)	NPD (MM)	REMARKS	PIECE NO	LENGTH (MM)	NPD (MM)	REMARKS
<A>	1698	50			482	50	
<C>	771	50					

SCALE: NTS PROJECT: SPR 120MW SPP PROJECT

TITLE: ISOMETRIC DRAWING FOR PIPING NATURAL GAS SYSTEM

JEL JURONG ENGINEERING LTD


JOB NO. 20036 DRAWING NO. X651-018

PROJECT DRAWING NO. SPR-10-EK-PI-P4018

REV. 53


NDT TEST		PRESS. (Bar g)			TEMP. (Deg C)		PIPING SPEC	LINE NO :
SHOP	FIELD	OPERATING	DESIGN	TEST	OPERATING	DESIGN	GB	10EKE11-BR602-EB5-50-
NA	NA	ATM	5	IST	70	100	INSULATION (MM) NA	TRAIN NO: 10EKE11-BR602-EB5-50- TRAIN-01

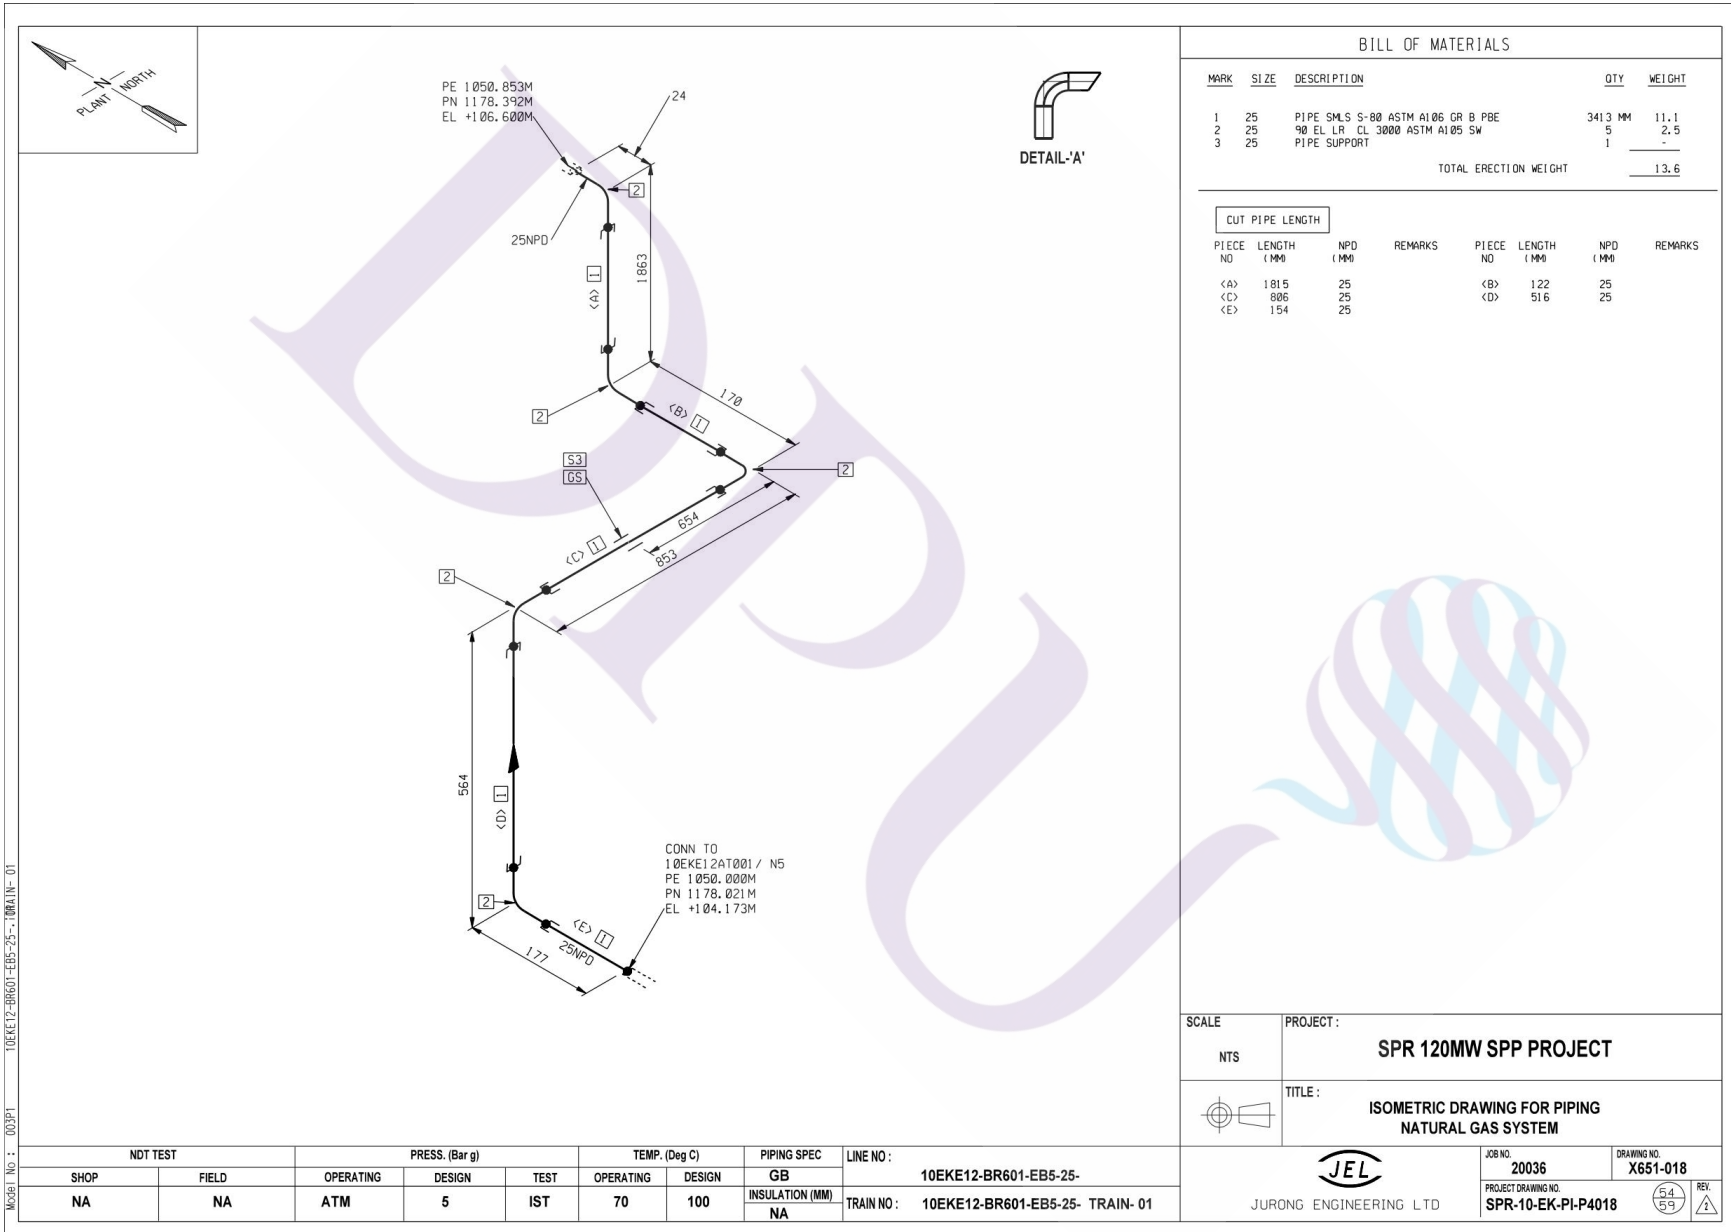

BILL OF MATERIALS

MARK	SIZE	DESCRIPTION	QTY	WEIGHT
2	25	90 EL. LR. CL. 3000 ASTM A105 SW	5	2.5
3	25	PIPE SUPPORT	1	-
TOTAL ERECTION WEIGHT				13.6

CUT PIPE LENGTH

PIECE NO	LENGTH (MM)	NPD (MM)	REMARKS	PIECE NO	LENGTH (MM)	NPD (MM)	REMARKS
<E>	154	25					


SCALE NTS	PROJECT: SPR 120MW SPP PROJECT
	TITLE: ISOMETRIC DRAWING FOR PIPING NATURAL GAS SYSTEM

Model No.: 00391
10EKE12-BR601-EB5-25-TRAIN-01

NDT TEST		PRESS. (Bar g)			TEMP. (Deg C)		PIPING SPEC	LINE NO :
SHOP	FIELD	OPERATING	DESIGN	TEST	OPERATING	DESIGN	GB	10EKE12-BR601-EB5-25-
NA	NA	ATM	5	IST	70	100	INSULATION (MM) NA	TRAIN NO : 10EKE12-BR601-EB5-25- TRAIN- 01

JURONG ENGINEERING LTD

JOB NO. 20036	DRAWING NO. X651-018
PROJECT DRAWING NO. SPR-10-EK-PI-P4018	REV.

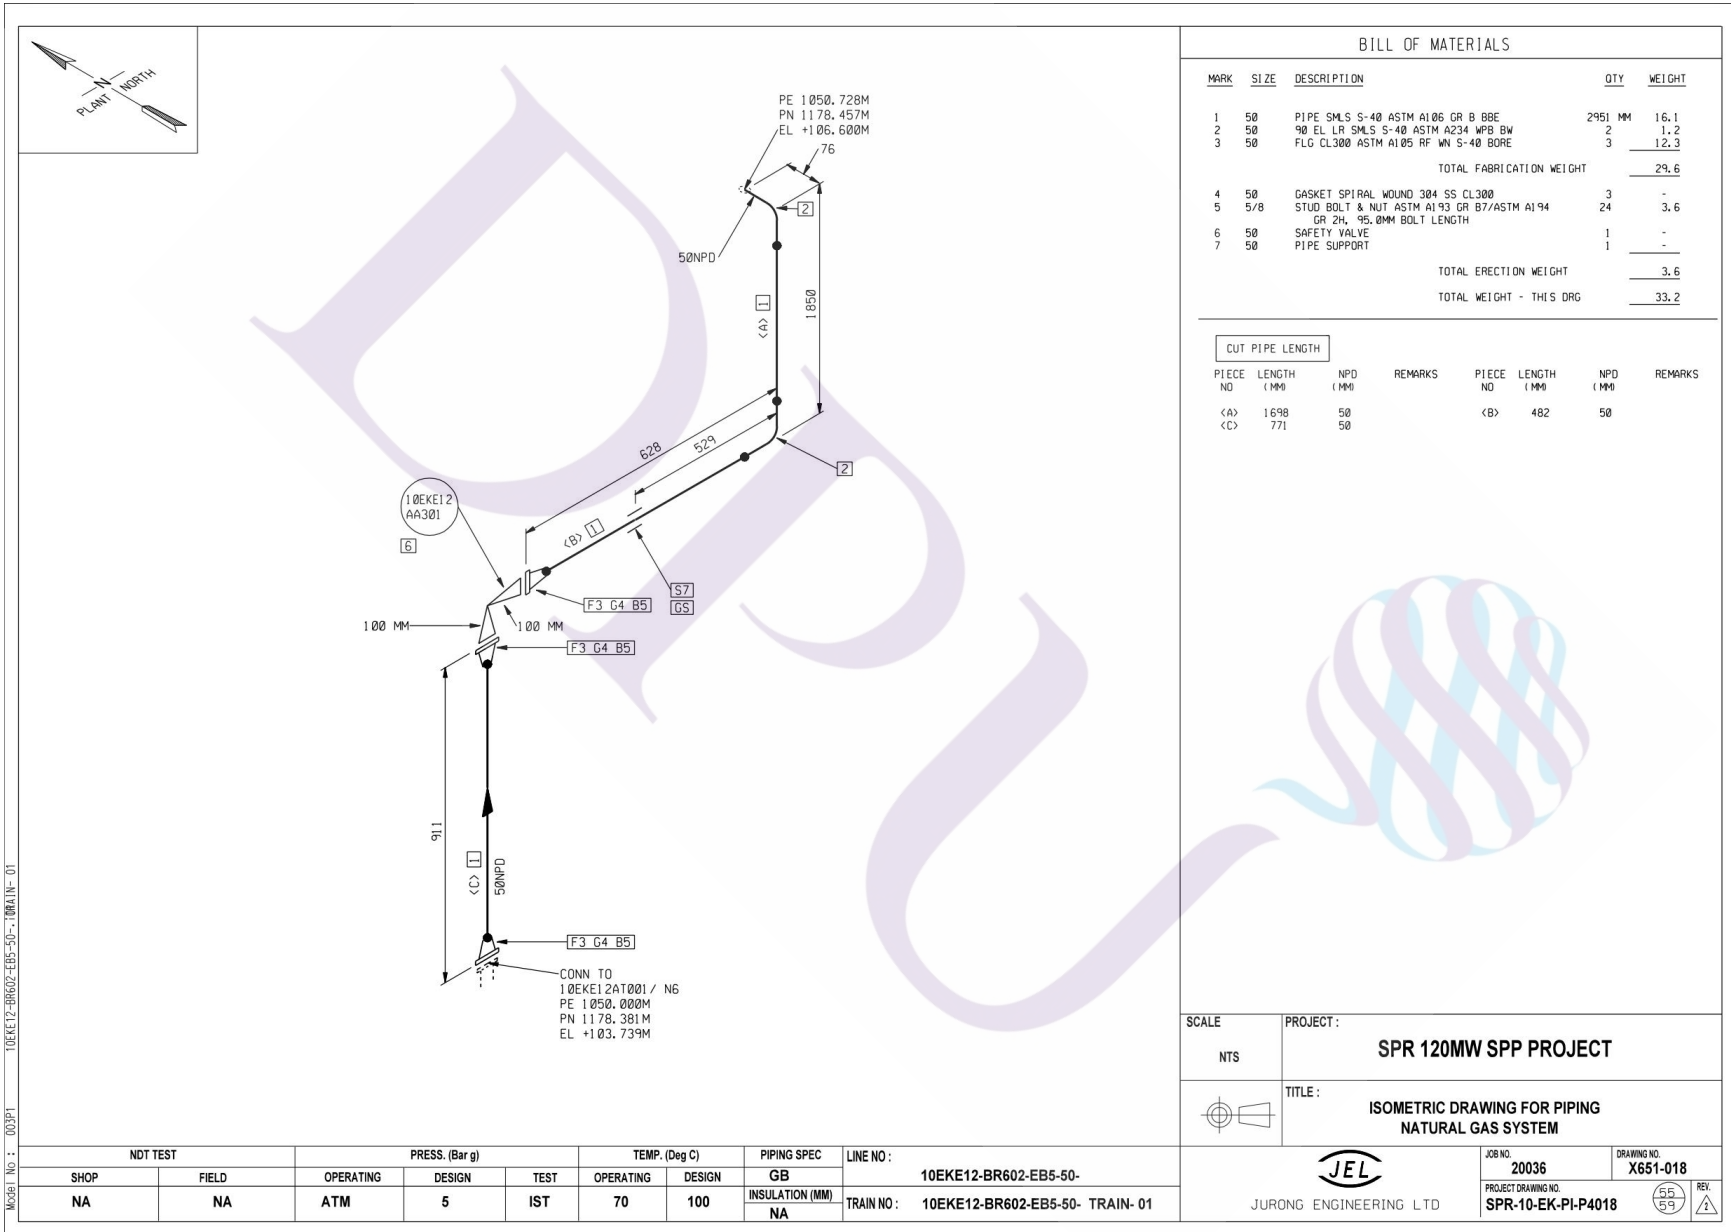

BILL OF MATERIALS

MARK	SIZE	DESCRIPTION	QTY	WEIGHT
1	50	PIPE SMLS S-40 ASTM A106 GR B BBE	2951 MM	16.1
2	50	90 EL LR SMLS S-40 ASTM A234 WPB BW	2	1.2
3	50	FLG CL300 ASTM A105 RF WN S-40 BORE	3	12.3
TOTAL FABRICATION WEIGHT				29.6
4	50	GASKET SPIRAL WOUND 304 SS CL300	3	-
5	5/8	STUD BOLT & NUT ASTM A193 GR B7/ASTM A194 GR 2H, 95.0MM BOLT LENGTH	24	3.6
6	50	SAFETY VALVE	1	-
7	50	PIPE SUPPORT	1	-
TOTAL ERECTION WEIGHT				3.6
TOTAL WEIGHT - THIS DRG				33.2

CUT PIPE LENGTH

PIECE NO	LENGTH (MM)	NPD (MM)	REMARKS	PIECE NO	LENGTH (MM)	NPD (MM)	REMARKS
<A>	1698	50			482	50	
<C>	771	50					

SCALE	PROJECT:
NTS	SPR 120MW SPP PROJECT

TITLE:	ISOMETRIC DRAWING FOR PIPING NATURAL GAS SYSTEM
--------	--

JEL JURONG ENGINEERING LTD


JOB NO. 20036 DRAWING NO. X651-018

PROJECT DRAWING NO. SPR-10-EK-PI-P4018

REV. 55/59

Model No.: 00391 10EKE12-BR602-EB5-50--TUMAIN-01

NDT TEST		PRESS. (Bar g)			TEMP. (Deg C)		PIPING SPEC	LINE NO :
SHOP	FIELD	OPERATING	DESIGN	TEST	OPERATING	DESIGN	GB	10EKE12-BR602-EB5-50-
NA	NA	ATM	5	IST	70	100	INSULATION (MM) NA	TRAIN NO: 10EKE12-BR602-EB5-50- TRAIN-01

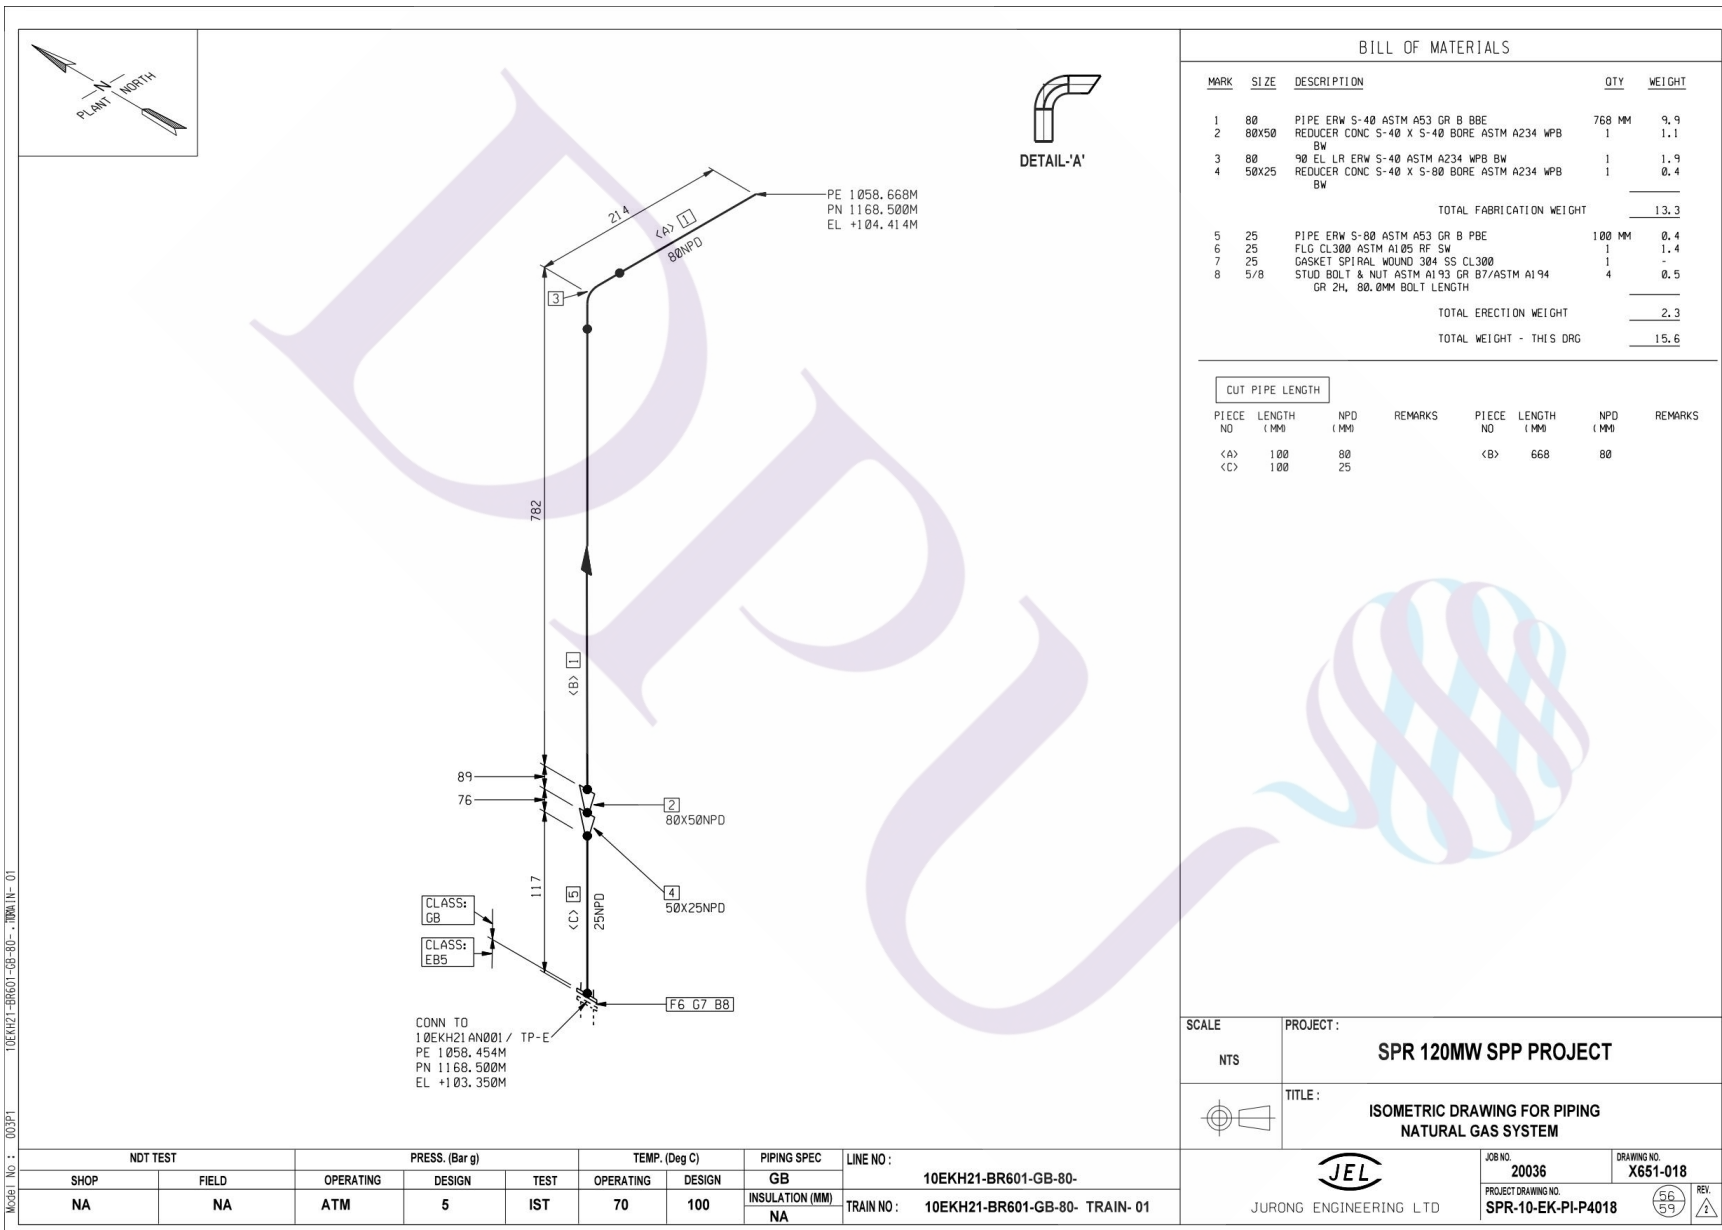

BILL OF MATERIALS

MARK	SIZE	DESCRIPTION	QTY	WEIGHT
1	80	PIPE ERW S-40 ASTM A53 GR B BBE	768	9.9
2	80X50	REDUCER CONC S-40 X S-40 BORE ASTM A234 WPB BW	1	1.1
3	80	90 EL LR ERW S-40 ASTM A234 WPB BW	1	1.9
4	50X25	REDUCER CONC S-40 X S-80 BORE ASTM A234 WPB BW	1	0.4
TOTAL FABRICATION WEIGHT				13.3
5	25	PIPE ERW S-80 ASTM A53 GR B PBE	100	0.4
6	25	FLG CL300 ASTM A105 RF SW	1	1.4
7	25	GASKET SPIRAL WOUND 304 SS CL300	1	-
8	5/8	STUD BOLT & NUT ASTM A193 GR B7/ASTM A194 GR 2H, 80.0MM BOLT LENGTH	4	0.5
TOTAL ERECTION WEIGHT				2.3
TOTAL WEIGHT - THIS DRG				15.6

CUT PIPE LENGTH

PIECE NO	LENGTH (MM)	NPD (MM)	REMARKS	PIECE NO	LENGTH (MM)	NPD (MM)	REMARKS
<A>	100	80			668	80	
<C>	100	25					

SCALE: NTS

PROJECT: **SPR 120MW SPP PROJECT**

TITLE: **ISOMETRIC DRAWING FOR PIPING NATURAL GAS SYSTEM**

JEL JURONG ENGINEERING LTD


JOB NO: 20036 DRAWING NO: X651-018

PROJECT DRAWING NO: SPR-10-EK-PI-P4018

REV. 5/9

Model No.: 00391 10EKH21-BR601-GB-80- TRAIN-01

NDT TEST		PRESS. (Bar g)			TEMP. (Deg C)		PIPING SPEC	LINE NO :
SHOP	FIELD	OPERATING	DESIGN	TEST	OPERATING	DESIGN	GB	10EKH21-BR601-GB-80-
NA	NA	ATM	5	IST	70	100	INSULATION (MM) NA	TRAIN NO : 10EKH21-BR601-GB-80- TRAIN- 01

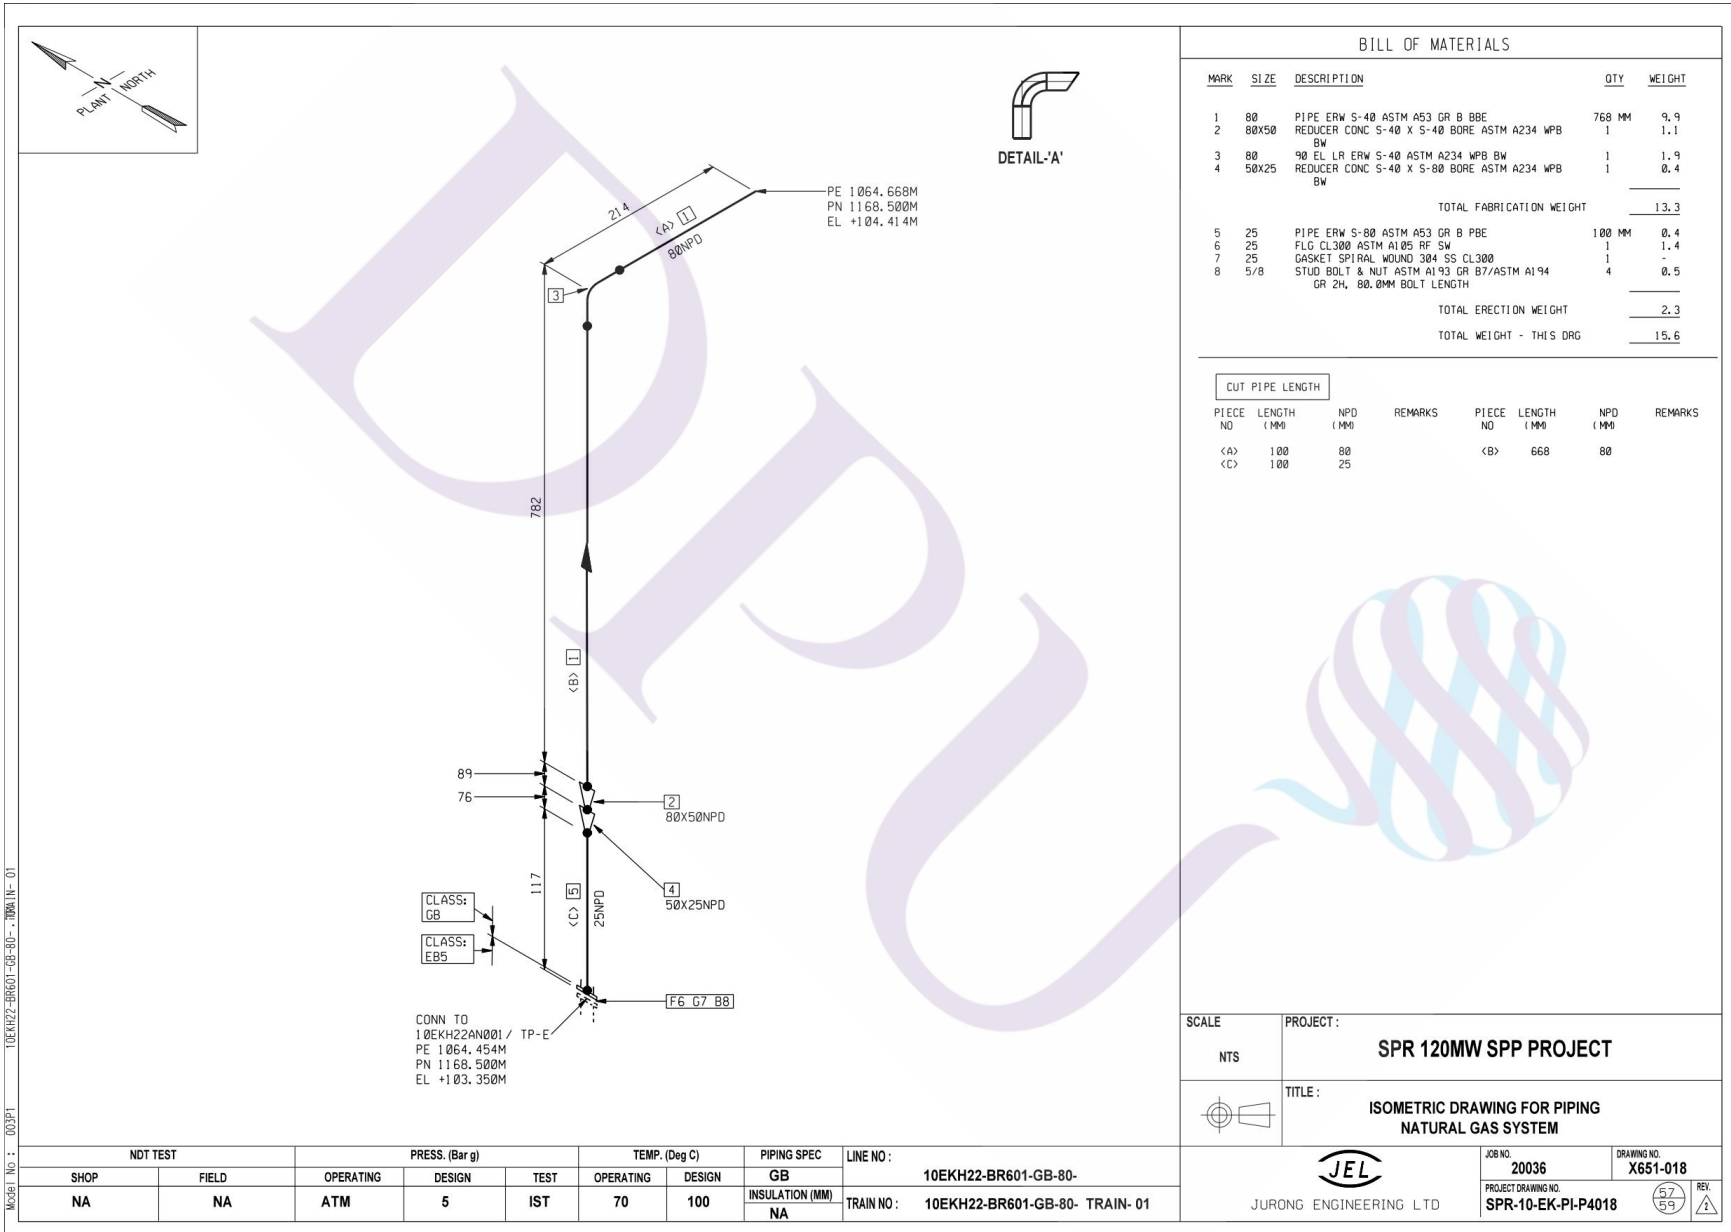

BILL OF MATERIALS

MARK	SIZE	DESCRIPTION	QTY	WEIGHT
1	80	PIPE ERW S-40 ASTM A53 GR B BBE	768	9.9
2	80X50	REDUCER CONC S-40 X S-40 BORE ASTM A234 WPB BW	1	1.1
3	80	90 EL LR ERW S-40 ASTM A234 WPB BW	1	1.9
4	50X25	REDUCER CONC S-40 X S-80 BORE ASTM A234 WPB BW	1	0.4
TOTAL FABRICATION WEIGHT				13.3
5	25	PIPE ERW S-80 ASTM A53 GR B PBE	100	0.4
6	25	FLG CL300 ASTM A105 RF SW	1	1.4
7	25	GASKET SPIRAL WOUND 304 SS CL300	1	-
8	5/8	STUD BOLT & NUT ASTM A193 GR B7/ASTM A194 GR 2H, 80.0MM BOLT LENGTH	4	0.5
TOTAL ERECTION WEIGHT				2.3
TOTAL WEIGHT - THIS DRG				15.6

CUT PIPE LENGTH

PIECE NO	LENGTH (MM)	NPD (MM)	REMARKS	PIECE NO	LENGTH (MM)	NPD (MM)	REMARKS
<A>	100	80			668	80	
<C>	100	25					

SCALE: NTS

PROJECT: **SPR 120MW SPP PROJECT**

TITLE: **ISOMETRIC DRAWING FOR PIPING NATURAL GAS SYSTEM**

JEL

JURONG ENGINEERING LTD


JOB NO: 20036 DRAWING NO: X651-018

PROJECT DRAWING NO: SPR-10-EK-PI-P4018


Model No.: 00391 10EKH22-BR601-GB-80-TRAIN-01

NDT TEST		PRESS. (Bar g)			TEMP. (Deg C)		PIPING SPEC	LINE NO :
SHOP	FIELD	OPERATING	DESIGN	TEST	OPERATING	DESIGN	GB	10EKH22-BR601-GB-80-
NA	NA	ATM	5	IST	70	100	INSULATION (MM) NA	TRAIN NO : 10EKH22-BR601-GB-80- TRAIN- 01

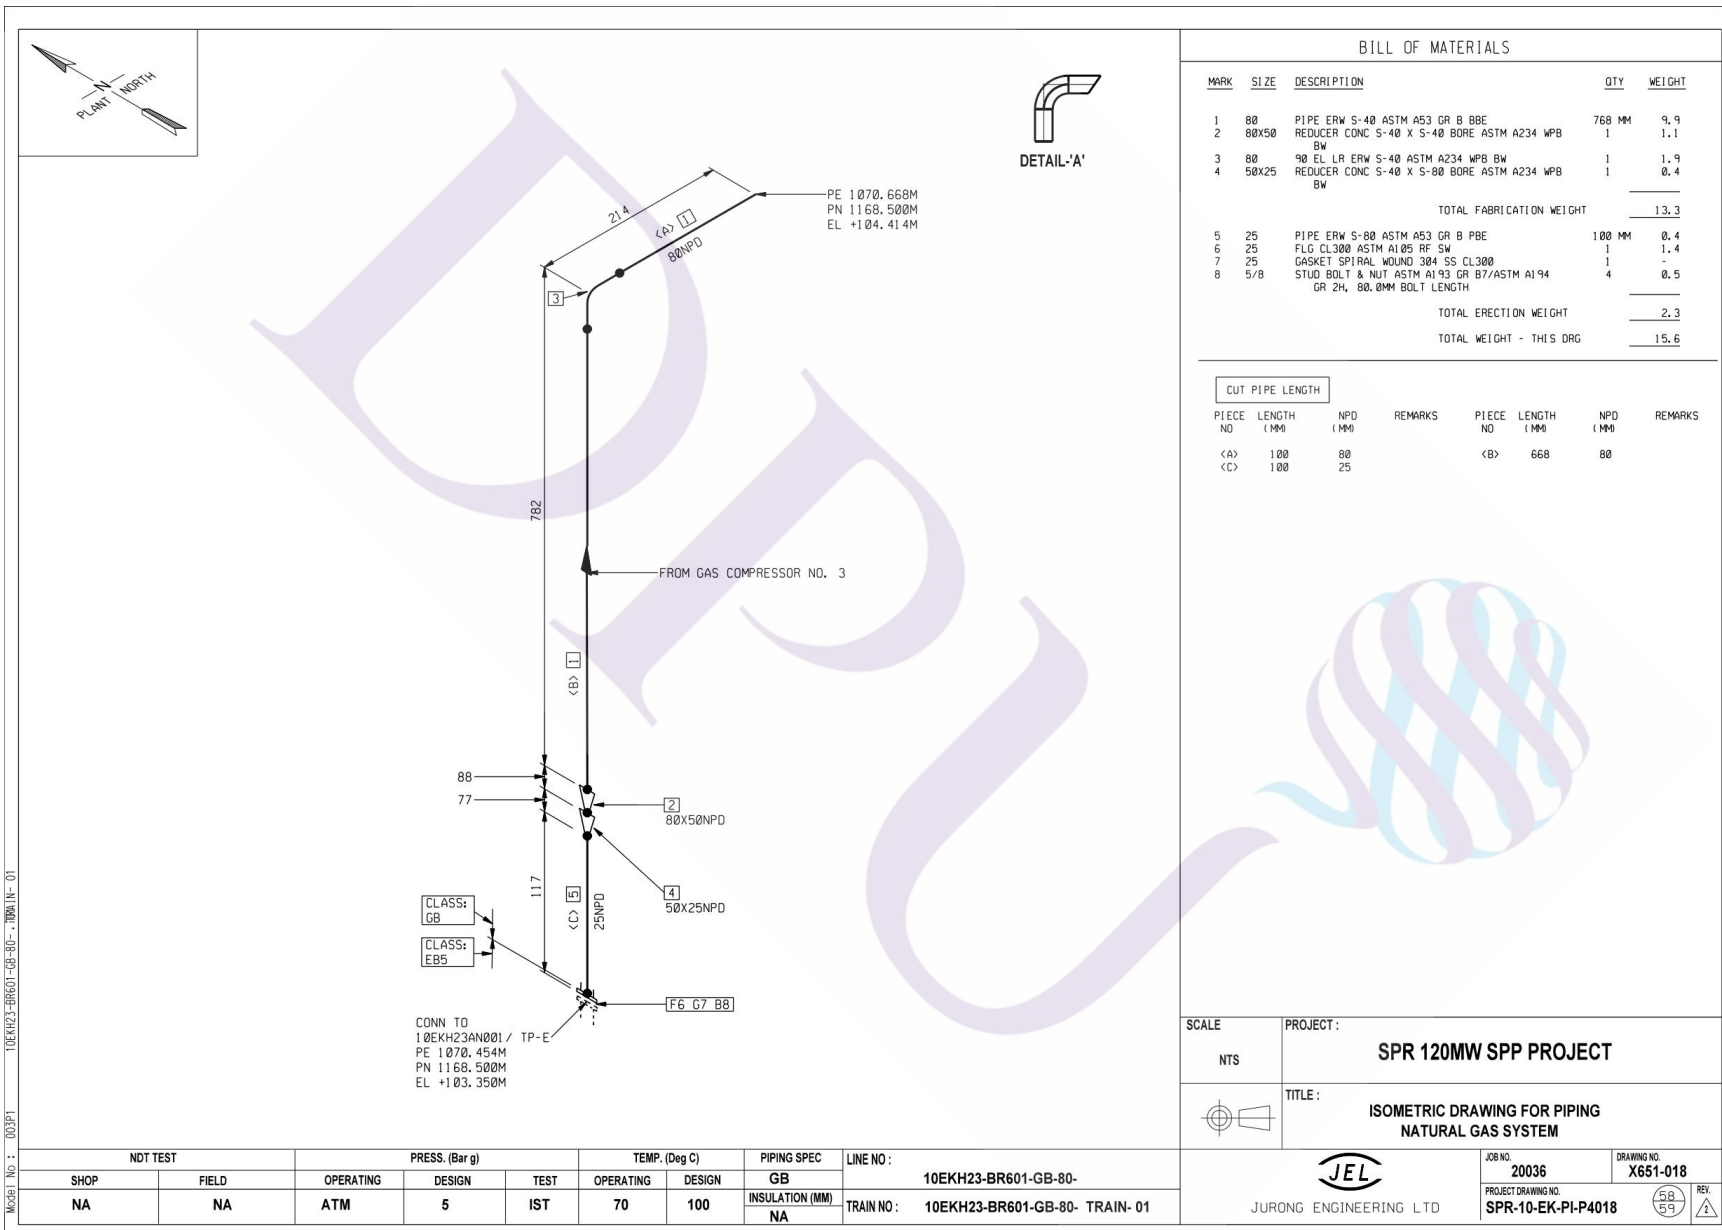

BILL OF MATERIALS

MARK	SIZE	DESCRIPTION	QTY	WEIGHT
1	80	PIPE ERW S-40 ASTM A53 GR B BBE	768	9.9
2	80X50	REDUCER CONC S-40 X S-40 BORE ASTM A234 WPB BW	1	1.1
3	80	90 EL LR ERW S-40 ASTM A234 WPB BW	1	1.9
4	50X25	REDUCER CONC S-40 X S-80 BORE ASTM A234 WPB BW	1	0.4
TOTAL FABRICATION WEIGHT				13.3
5	25	PIPE ERW S-80 ASTM A53 GR B PBE	100	0.4
6	25	FLG CL300 ASTM A105 RF SW	1	1.4
7	25	GASKET SPIRAL WOUND 304 SS CL300	1	-
8	5/8	STUD BOLT & NUT ASTM A193 GR B7/ASTM A194 GR 2H, 80.0MM BOLT LENGTH	4	0.5
TOTAL ERECTION WEIGHT				2.3
TOTAL WEIGHT - THIS DRG				15.6

CUT PIPE LENGTH

PIECE NO	LENGTH (MM)	NPD (MM)	REMARKS	PIECE NO	LENGTH (MM)	NPD (MM)	REMARKS
<A>	100	80			668	80	
<C>	100	25					

SCALE: NTS

PROJECT: **SPR 120MW SPP PROJECT**

TITLE: **ISOMETRIC DRAWING FOR PIPING NATURAL GAS SYSTEM**

JEL JURONG ENGINEERING LTD


JOB NO: 20036 DRAWING NO: X651-018

PROJECT DRAWING NO: SPR-10-EK-PI-P4018

REV. 5/3

Model No.: 00391 10EKH23-BR601-GB-80-TRAIN-01

NDT TEST		PRESS. (Bar g)			TEMP. (Deg C)		PIPING SPEC	LINE NO :
SHOP	FIELD	OPERATING	DESIGN	TEST	OPERATING	DESIGN	GB	10EKH23-BR601-GB-80-
NA	NA	ATM	5	IST	70	100	INSULATION (MM) NA	TRAIN NO : 10EKH23-BR601-GB-80- TRAIN- 01

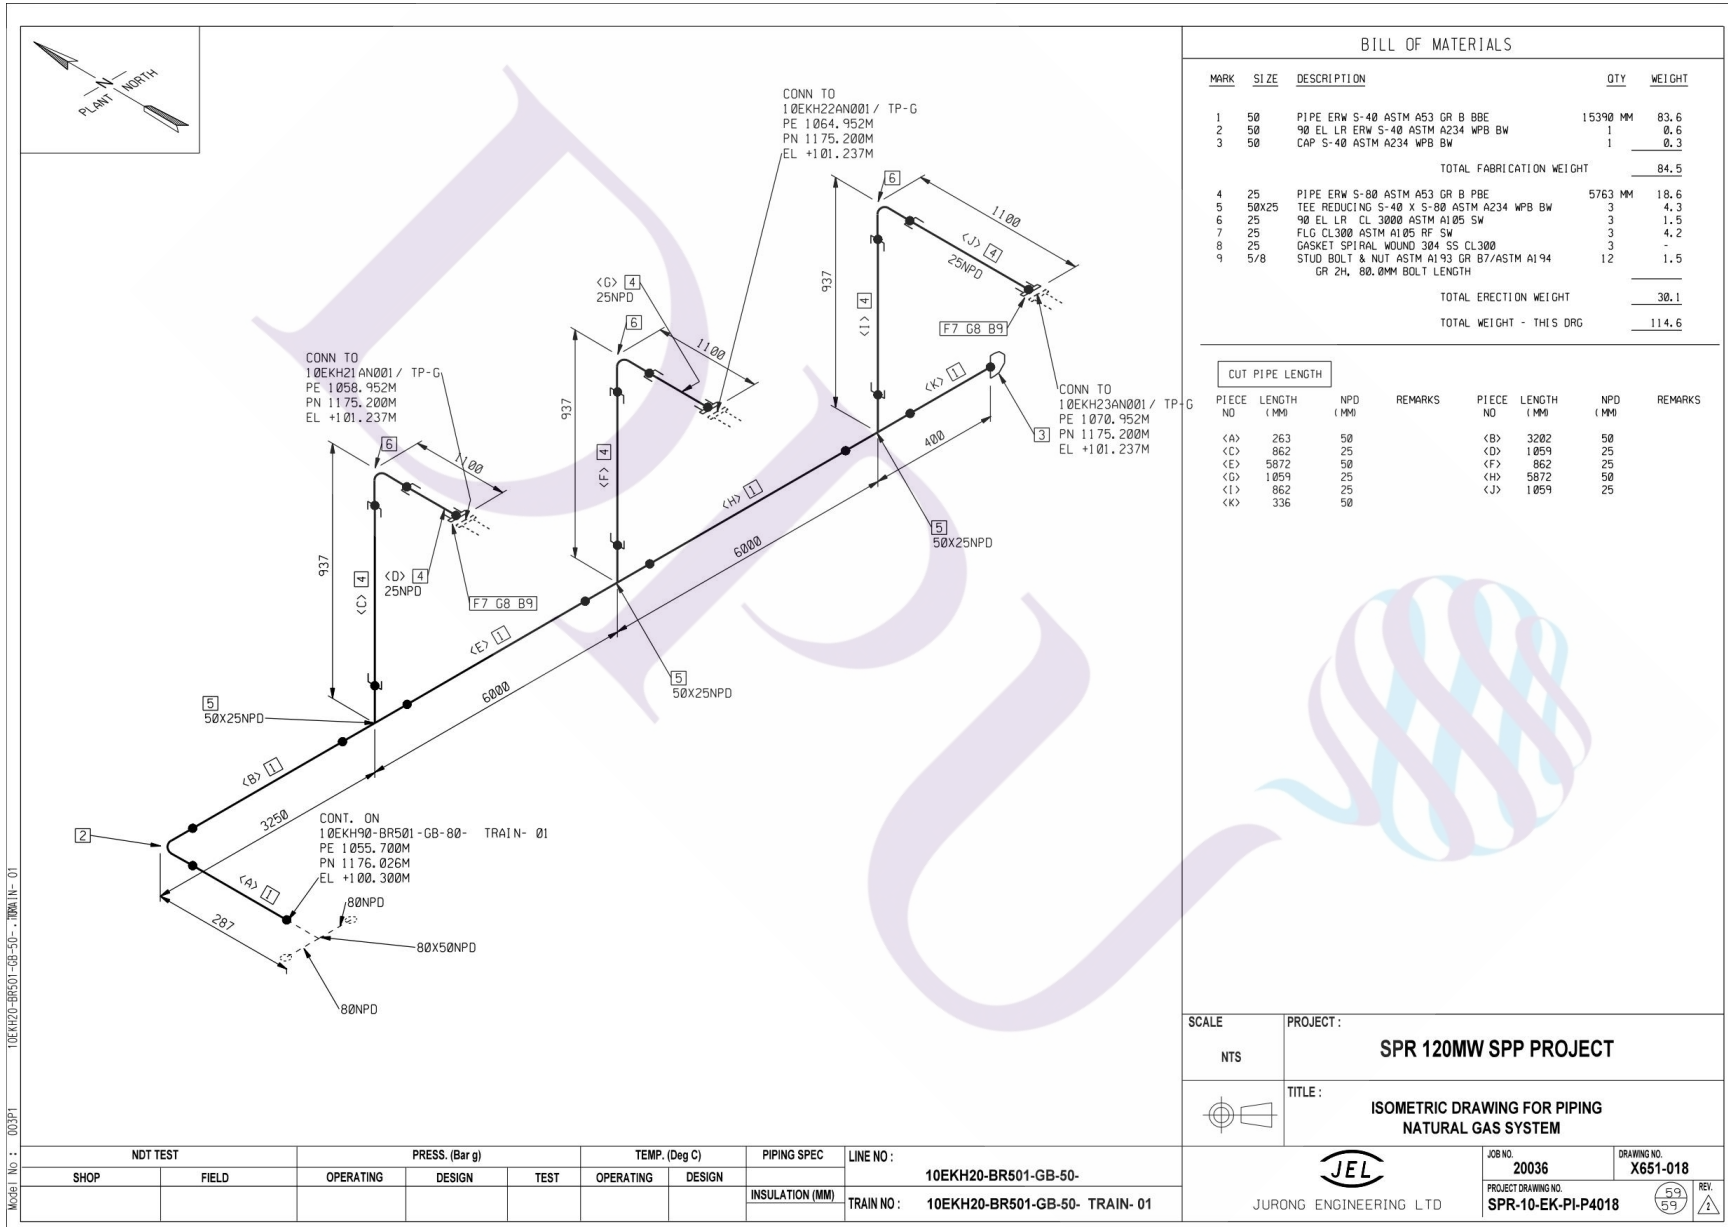

BILL OF MATERIALS

MARK	SIZE	DESCRIPTION	QTY	WEIGHT
1	50	PIPE ERW S-40 ASTM A53 GR B BBE	15390	MM 83.6
2	50	90 EL LR ERW S-40 ASTM A234 WPB BW	1	0.6
3	50	CAP S-40 ASTM A234 WPB BW	1	0.3
TOTAL FABRICATION WEIGHT				84.5
4	25	PIPE ERW S-80 ASTM A53 GR B PBE	5763	MM 18.6
5	50X25	TEE REDUCING S-40 X S-80 ASTM A234 WPB BW	3	4.3
6	25	90 EL LR CL 3000 ASTM A105 SW	3	1.5
7	25	FLG CL300 ASTM A105 RF SW	3	4.2
8	25	GASKET SPIRAL WOUND 304 SS CL300	3	-
9	5/8	STUD BOLT & NUT ASTM A193 GR B7/ASTM A194 GR 2H, 80.0MM BOLT LENGTH	12	1.5
TOTAL ERECTION WEIGHT				30.1
TOTAL WEIGHT - THIS DRG				114.6

CUT PIPE LENGTH

PIECE NO	LENGTH (MM)	NPD (MM)	REMARKS	PIECE NO	LENGTH (MM)	NPD (MM)	REMARKS
<A>	263	50			3202	50	
<C>	862	25		<D>	1059	25	
<E>	5872	50		<F>	862	25	
<I>	862	25		<J>	1059	25	
<K>	336	50					

SCALE: NTS PROJECT: **SPR 120MW SPP PROJECT**

TITLE: **ISOMETRIC DRAWING FOR PIPING NATURAL GAS SYSTEM**







Model No.: 00391 10EKH20-BR501-GB-50-TRAIN-01

NDT TEST		PRESS. (Bar g)			TEMP. (Deg C)		PIPING SPEC	LINE NO :
SHOP	FIELD	OPERATING	DESIGN	TEST	OPERATING	DESIGN	INSULATION (MM)	10EKH20-BR501-GB-50-
								TRAIN NO : 10EKH20-BR501-GB-50- TRAIN- 01

JEL
JURONG ENGINEERING LTD

JOB NO. 20036 DRAWING NO. X651-018
PROJECT DRAWING NO. SPR-10-EK-PI-P4018

REV. 59 59

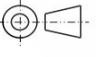REV.	DATE	DESCRIPTION	DRAWN	DESIGNED	CHECKED	APPROVED	STATUS
2	29-Mar-16	As-Built	-	DBM	BALU	WEI	AB
1	11-Apr-15	Revised as per OE comments & design progress and Issued for Construction	-	DBM	BALU	WEI	C
0	14-Jul-14	Revised as per design progress and Issued for Construction	-	DBM	BALU	WEI	C
B	18-Jun-14	Revised as per OE comment SPR-DATE-P0011. Issued for Reference	-	DBM	BALU	WEI	R
A	21-Apr-14	Issued for Reference	-	DBM	BALU	WEI	R
JEL STAMP			OWNER'S APPROVAL STAMP				
<p>OWNER</p>  <p>SIAM PURE RICE COMPANY LIMITED 71 AGR Building, Charoen Rat Road, Bang Khlo, Bang Kho Laem, Bangkok 10120.</p>							
<p>OWNER'S ENGINEER</p>  <p>TRACTEBEL ENGINEERING LTD. Unit 1903-1905, 19th Fl., Two Pacific Place Building, 142 Sukhumvit Road, Kwaeng Klontoe, Khet Klontoe, Bangkok 10110.</p>							
SPR	OWNER'S ENGINEER						
TE	TRACTEBEL ENGINEERING LTD.						
TJEL	Unit 1903-1905, 19th Fl., Two Pacific Place Building, 142 Sukhumvit Road, Kwaeng Klontoe, Khet Klontoe, Bangkok 10110.						
PROJ	THE CONSORTIUM OF						
P&E	OFFSHORE CONSORTIUM MEMBER			ONSHORE CONSORTIUM MEMBER			
PIPING	 <p>JURONG ENGINEERING LIMITED 25 Tanjong Kling Road, Singapore 628050.</p>			 <p>THAI JURONG ENGINEERING LIMITED 75/43 Ocean Tower2, 22nd Floor, Sukhumvit 19, North Klontoe, Wattana, Bangkok 10110.</p>			
C&S							
T&V							
ELEC	OWNER CONTRACT NO.	PROJECT					
INST	-	SPR 120MW SPP PROJECT					
PROC	SCALE	PROJECTION	TITLE:				
	NTS		PIPING MATERIAL SPECIFICATION				
	 <p>Jurong Engineering Limited</p>			JOB NO.	JEL DRAWING NO.		
TOTAL				20036	K602-001		
DISTRIBUTION				PROJECT DRAWING NO.	REV. NO.		
				SPR-10-AAA-SP-P9001	2		

JURONG ENGINEERING LIMITED

CONTENTS

1.0	<u>SCOPE</u>	<u>3</u>
2.0	<u>APPLICABLE CODES AND STANDARDS</u>	<u>3</u>
3.0	<u>TECHNICAL REQUIREMENTS</u>	<u>4</u>
4.0	<u>PIPING CLASS IDENTIFICATION</u>	<u>5</u>
5.0	<u>SERVICE DESIGNATORS</u>	<u>6</u>
6.0	<u>ABBREVIATIONS</u>	<u>7</u>

ATTACHMENTS

Piping Material Specification Revision record
Piping Material Specifications used for SPR 120MW SPP Project
Piping Material Specification Sheets

TITLE: PIPING MATERIAL SPECIFICATION	JOB No.	DRAWING No.	PROJECT DWG No.	REV. No.
	20036	K602-001	SPR-10-AAA-SP-P9001	2

JURONG ENGINEERING LIMITED

1.0 SCOPE

1.1 WORK INCLUDED

The purpose of this specification is to provide information necessary for selection of materials for power and auxiliary service piping systems for power plants designed by JEL, in compliance with ASME B31.1, POWER PIPING CODE.

Included in the specification are pipe, fittings, flanges, gaskets, bolting material, valves (excluding control valves), and piping specialties, for both field and shop-fabricated piping. Root valves for instrumentation connections to piping systems are included but not instrument piping beyond the valve.

1.2 WORK NOT INCLUDED

This specification does not apply to piping that is part of a proprietary piece of equipment or skid unless the purchase specifications for the equipment incorporate these specifications by reference. This specification is not intended as a design guide for processes, layout, fabrication, installation, or operation of piping systems.

1.3 RELATED SPECIFICATIONS

SPR-10-AAA-PB-M8604 KKS coding - Plant Identification system
 SPR-10-AAA-SP-P9002 Valves and Piping Specialties Specification
 SPR-10-AAA-SP-P9004 Insulation Specification for Piping and Piping Specialties

2.0 APPLICABLE CODES AND STANDARDS

Materials shall fully comply with the requirements of the latest editions of the following codes and standards, as applicable. In case of conflicts between these references, specific project requirements and /or local codes, JEL shall be notified.


American National Standards Institute	ANSI
American Petroleum Institute	API
American Society of Mechanical Engineers	ASME
American Society for Testing and Materials	ASTM
American Welding Society	AWS
American Water Works Association	AWWA
Cast Iron Soil Pipe Institute	CISPI
Manufacturers Standardization Society	MSS

TITLE: PIPING MATERIAL SPECIFICATION	JOB No.	DRAWING No.	PROJECT DWG No.	REV. No.
	20036	K602-001	SPR-10-AAA-SP-P9001	2

National Fire Protection Association	NFPA		
Underwriters Laboratories/Factory Mutual	ULFM		
Deutsches Institut für Normung	DIN		
Japanese Industrial Standards	JIS		
3.0 TECHNICAL REQUIREMENTS			
3.1 Materials			
3.1.1	All materials furnished under this specification shall comply with the attached piping, valve and piping specialties specifications. All materials and products shall be new, undamaged, and unused. Products that have been discontinued are not acceptable. Use of alternative products or materials must be approved by JEL.		
3.1.2	Material to be installed within the jurisdiction of section 1 of the ASME Boiler and Pressure Vessel code, i.e. Boiler Proper Piping (BPP) or Boiler External Piping (BEP), shall be specified as conforming to an ASME specification. When so specified, material shall be marked as required by ASME, section 2 for the applicable specification. Such marking shall be considered as the manufacturer's certification that the product complies with the material specifications and standard indicated. Material which is not fully identified in accordance with ASME, section 2, shall be certified in accordance with ASME BPVC, section 1, PG-10 (Mill test Reports).		
3.2 Welding			
3.2.1	Post weld heat treatment (PWHT) is specified in accordance with ASME B31.1, paragraph 132		
3.2.2	Non destructive examination of welds is specified in accordance with ASME B31.1, paragraph 136.4. Methods specified include visual (VT), magnetic particle (MT), liquid penetrant (PT), and radiographic (RT).		
3.3 Other Requirements			
3.3.1	Bending of pipe is not permitted unless specifically requested, or approved by JEL. When Pipe bends are approved, they shall be made using only seamless pipe, and the minimum bend radius shall be as specified, but no less than five pipe diameters. Bending of galvanized or lined pipe is not permitted.		
3.3.2	Butt weld elbows shall be long radius unless otherwise noted.		
3.3.3	Orifice flanges shall be provided in accordance with ASME/ANSI B16.36.They shall be provided in pairs without bolting or gaskets but with jackscrews. For sizes 1 1/2 NPS and smaller, provide socket weld ends.		
3.3.4	Butt weld ends shall be bevelled in accordance with ASME/ANSI B 16.25.		
3.3.5	Pipe thread on fittings shall be coated with a Teflon based sealant except for high temperature steam lines, which will be coated with an antisieze compound. Drying type pipe dope or Teflon tape shall not be used.		
TITLE: PIPING MATERIAL SPECIFICATION			
JOB No.	DRAWING No.	PROJECT DWG No.	REV. No.
20036	K602-001	SPR-10-AAA-SP-P9001	2

4.0 PIPING CLASS IDENTIFICATION

The design pressure and temperature established for each line, together with the service inline, determine the applicable piping material. Individual piping material specification have been developed to cover each pressure and temperature of material group. The piping specification, as illustrated below:

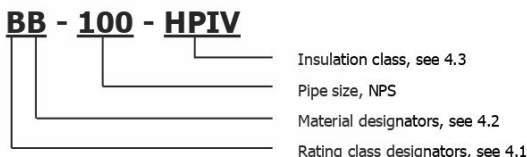

4.1 Rating Class Designators

The following is a list of designators used to identify ANSI pressure-temperature rating classes:

Designator	ANSI Rating
A	Class 2500
B	Class 1500
C	Class 900
D	Class 600
E	Class 300
F	Class 150
G	Class 125

Designator G is also used to identify systems having working pressures of 200 psi or less

4.2 Material Designators

The following is a list of material designators used:

Designator	Material Description
A	Alloy (e.g. CrMo, Alloy 20)
B	Carbon Steel (CS)
C	Stainless Steel (SS)
E	Cast Iron or Ductile Iron (CI or DI)
F	Galvanized Carbon Steel
H	Polyvinyl Chloride (PVC) or Chlorinated Polyvinyl Chloride (CPVC)
K	Plastic Lined Carbon Steel
L	Polyethylene (PE)
P	Polyvinylidene Fluoride (PVDF)
R	Fiberglass Reinforced Plastic (FRP)
T	Polyvinyl Chloride AWWA pipe for Firewater Service Underground

TITLE: PIPING MATERIAL SPECIFICATION	JOB No.	DRAWING No.	PROJECT DWG No.	REV. No.
	20036	K602-001	SPR-10-AAA-SP-P9001	2

4.3 Insulation Class

Insulation classes have two parts: Roman numerals I through VIII which indicate temperature range and letter prefixes which indicate purpose. The purposes are designated as follows:

<u>Letter</u>	<u>Prefix</u>	<u>Purpose</u>
(None)		Thermal conservation
P		Personnel protection
H		Heat Conservation
HP		Personnel protection with heat trace
VAS		Anti-sweat insulation with vapor barrier

The required thickness depends on pipe size and temperature range for each of the purposes listed. Specification SPR-10-AAA-SP-P9004 - Insulation Specification for Piping and Piping Specialties tabulates those thickness requirements.

5.0 **SERVICE DESIGNATORS**

The following is a list of commonly used service designations. Refer to P&ID's for project specific services not listed here. Piping material specifications are listed as appropriate for each service.

Service	Piping Material Specifications
Compressed Air	GF
Service Air	GF
Acid	FA
Blow down, Blow off	DB2, EB3, FB3
Boiler Feed water	CB2, DB2, EB3, FB3
Condensate	EB3, FB3
Chemical Feed	BC2, CC2, FC2, EC2, GH2,
Chilled Water Return	GB
Chilled Water Supply	GB
Chlorine	GH3
Circulating Water Blowdown	GB
Cooling Water Makeup	GB
Circulating Water Return	GB, GB1
Circulating Water Supply	GB, GB1
Drain	GB, GE, GE3, GL1, GL2, GR
Demineralized Water	FC
Firewater	GB2, GF1
Natural Gas	DB4, EB5, EC
High Pressure Steam	BA, CA, DA, FA1
Instrument Air	FC
Low Pressure Steam	FB3, EB3
Medium Pressure Steam	EB3
Raw Water	GB, GL2
Vent	FB3, GB
Waste Water	GB, GL1, GR

TITLE: PIPING MATERIAL SPECIFICATION	JOB No.	DRAWING No.	PROJECT DWG No.	REV. No.
	20036	K602-001	SPR-10-AAA-SP-P9001	2

6.0 ABBREVIATIONS

BE	: Bevel End
PE	: Plain End
SW	: Socket Weld
BW	: Butt Weld
Sch	: Schedule
Conc	: Concentric
Ecc	: Eccentric
SO	: Slip-On
WN	: Welding Neck
RF	: Raised Face
FF	: Flat Face
SOL	: Sockolet
WOL	: Weldolet
TOL	: Threadolet
Smls	: Seamless
CL	: Class
PWHT	: Post Weld Heat Treatment
NDE	: Non Destructive Examination
Rdeg	: Reducing

TITLE: PIPING MATERIAL SPECIFICATION	JOB No.	DRAWING No.	PROJECT DWG No.	REV. No.
	20036	K602-001	SPR-10-AAA-SP-P9001	2

JURONG ENGINEERING LIMITED

SERVICE: High Pressure Steam										CLASS 1500					MATERIAL: ALLOY STEEL						
TEMP, F		302	392	482	572	662	707	752	797	842											
PRESS, PSIG		See Sheet 2																			
TEMP, C		300	350	375	400	425	450	475	500	538											
PRESS, kPag		See Sheet 2																			
SIZE	NPS	1/2	3/4	1	1.5	2	2.5	3	4	6	8	10	12	14	16	18	20	24			
	DN	15	20	25	40	50	65	80	100	150	200	250	300	350	400	450	500	600			
PIPE (1)		Sch 160 (PE)					Sch 160 (BE)					Sch 140 (BE)					ASTM A335 P22 Smls				
FITTINGS		ASTM A182F22 CL 6000 SW					ASTM A234 WP22, Smls Butt weld, bore to match pipe														
FLANGES		ASTM A182F22 CL 1500 RF																			
		SW(RF)					WNRF, bore to match pipe														
UNIONS		Not allowed, use flanges as specified above																			
BRANCH CONNECTIONS		SW Tee, Rdcg Tee, ASTM A182F22					Full size Tee and Rdcg Tee through three size reduction, ASTM A234 WP22; Weldolet down to 2" (DN 50), ASTM A182F22; Sockolet for 1-1/2" (DN 40) and smaller, ASTM A182F22														
BOLTING		Alloy Steel Studs, ASTM A193 Gr B16 with Hvy Hex Nuts, ASTM A194 Gr 3																			
GASKETS		CL 1500 Spiral wound 304 SS with Flexicarb Filler, Flexitallic Style CG or equal																			
V	BALL																				
A	B'FLY																				
L	CHECK																212				
V	GATE	90					91														
E	GLOBE	434																			
S																					
M																					
I	STEAM TRAP						893														
S																					
C																					
PWHT		NO										YES									
SIZE	NPS	1/2	3/4	1	1.5	2	2.5	3	4	6	8	10	12	14	16	18	20	24			
	DN	15	20	25	40	50	65	80	100	150	200	250	300	350	400	450	500	600			
NOTES:																					
1. 1/16" (1.58 mm) allowance for corrosion																					
2. All pressure connections shall be 1" (DN 25) SOL and all temperature connections shall be 3/4" (DN20) SOL. Except HPS - 11/2"(DN40) SOL and LPS & Feed Water - 11/4"(DN32) SOL.																					
4. PWHT is not required if nominal material thickness is less than 1/2" (13mm) and the specified carbon content of the material to be welded is 0.15% or less.																					
										DATE	REV	PIPING MATERIAL SPECIFICATION: BA									
										29-Mar-16	2	Sheet 1 of 2									

SERVICE: High Pressure Steam					CLASS 1500	MATERIAL: ALLOY STEEL				
------------------------------	--	--	--	--	------------	-----------------------	--	--	--	--

CL 1500	TEMP, F	572	662	707	752	797	842	887	932	1000
FLG RTG PRESS, PSIG		3110	2917	2815	2656	2540	2451	2294	2044	1337

PIPE PRESSURE RATING, PSIG (1)											
P I P E S I Z E	SCH 160	1/2									
		3/4									
		1									
		1.5	For pipe pressure ratings in the blank area above the line, use flange ratings as limiting values.								
		2									
		2.5									
	SCH 140	3									
		4									
		6	3042								
		8	2650	2650	2650	2650			1904		
		10	2668	2668	2668	2668			1917		
		12	2546	2546	2546	2546			2205	1283	
		14	2597	2597	2597	2597			2250	1866	1310

CL 1500	TEMP, C	300	350	375	400	425	450	475	500	538
FLG RTG PRESS, kPa		21440	20110	19410	18310	17510	16900	15820	14090	9220

PIPE PRESSURE RATING, kPag (1)											
P I P E S I Z E	SCH 160	15									
		20									
		25									
		40	For pipe pressure ratings in the blank area above the line, use flange ratings as limiting values.								
		50									
		65									
	SCH 140	80									
		100									
		150	20977								
		200	18272	18272	18272	18272			13131		
		250	18394	18394	18394	18394			13220		
		300	17551	17551	17551	17551			15204	12608	8846
		350	17907	17907	17907	17907			15512	12866	9034

										DATE	REV	PIPING MATERIAL SPECIFICATION: BA
										29-Mar-16	2	Sheet 2 of 2

SERVICE: Steam, Feedwater, Blowdown, Blowoff											CLASS 900				MATERIAL: CARBON STEEL						
TEMP, F		100	200	300	400	500	600	650	700	750											
PRESS, PSIG		See Sheet 2																			
TEMP, C		38	93	149	204	260	316	343	371	399											
PRESS, kPag		See Sheet 2																			
SIZE	NPS	1/2	3/4	1	1.5	2	2.5	3	4	6	8	10	12	14	16	18	20	24			
	DN	15	20	25	40	50	65	80	100	150	200	250	300	350	400	450	500	600			
PIPE (1)		Sch 80										Sch 120									
		ASTM A106 Gr B (2)																			
FITTINGS		ASME B16.11, ASTM A105, CL 6000 SW					ASME/ANSI B16.9, ASTM A234 WPB, Smls Butt weld, bore to match pipe														
FLANGES		ASME/ANSI B16.5, ASTM A105																			
		CL 1500 RF					CL 900 RF														
		SW					WN, bore to match pipe														
UNIONS		Not allowed, use flanges as specified above																			
BRANCH CONNECTIONS (3)		SW Tee and Rdcg Tee, ASTM A105					Full size Tee and Rdcg Tee through three size reduction, ASTM A234 WPB; Weldolet down to 2" (DN 50), ASTM A105; Sockolet for 1-1/2" (DN 40) and smaller, ASTM A105														
BOLTING		Alloy Steel Studs, ASTM A193 Gr B7 with Hvy Hex Nuts, ASTM A194 Gr 2H																			
GASKETS		Spiral wound 304 SS with Flexicarb Filler, Flexitallic Style CG or equal																			
		CL 1500					CL 900														
V	BALL																				
A	B'FLY																				
L	CHECK																				
(4)V	GATE	83					40														
E	GLOBE (5)	408																			
S	TANDEM																				
M	STRAINER	702																			
I																					
S																					
C																					
PWHT		NO (7)										YES									
SIZE	NPS	1/2	3/4	1	1.5	2	2.5	3	4	6	8	10	12	14	16	18	20	24			
	DN	15	20	25	40	50	65	80	100	150	200	250	300	350	400	450	500	600			
NOTES:		<p>1. 1/16" (1.58 mm) allowance for corrosion</p> <p>2. For Boiler Proper and Boiler External Piping (BEP) use materials per ASME BPVC Section I, PG-9.</p> <p>3. All pressure connections shall be 1" (DN 25) SOL and all temperature connections shall be 3/4" (DN20) SOL. Except HPS - 11/2"(DN40) SOL and LPS & Feed Water - 11/4"(DN32) SOL.</p> <p>4. BEP valves are identified by a 9000 series valve specification number (ie: valve 202 would be designated 9202).</p> <p>5. Conventional globe valves are not allowed in blowoff piping. Angle or Y pattern globe valves must be used.</p> <p>6. Subcontractors shall submit welding procedures meeting ASME BPVC Section IX for P-No. 1 materials.</p> <p>7. For weldolets 3" NPS (DN 80) and larger, postweld heat treatment is required.</p>																			
		DATE		REV		PIPING MATERIAL SPECIFICATION: CB2															
		29-Mar-16		2		Sheet 1 of 2															

SERVICE: Steam, Feedwater, Blowdown, Blowoff						CLASS 900	MATERIAL: CARBON STEEL			
--	--	--	--	--	--	-----------	------------------------	--	--	--

CL 1500	TEMP, F	100	200	300	400	500	600	650	700	750
FLG RTG PRESS, PSIG		3705	3395	3270	3170	3015	2840	2745	2655	2535

CL 900	TEMP, F	100	200	300	400	500	600	650	700	750
FLG RTG PRESS, PSIG		2220	2035	1966	1900	1810	1705	1650	1590	1520

PIPE PRESSURE RATING, PSIG (1)										
P I P E S C H 80 I Z E	1/2	2520	2520	2520	2520	2520	2520	2520	2420	2184
	3/4	2185	2185	2185	2185	2185	2185	2185	2097	1893
	1	2278	2278	2278	2278	2278	2278	2278	2187	1974
	1.5	1865	1865	1865	1865	1865	1865	1865	1790	1616
	2	1693	1693	1693	1693	1693	1693	1693	1625	1467
	2.5	1966	1966	1966	1966	1966	1966	1966	1887	1704
	3	1796	1796	1796	1796	1796	1640	1610	1590	1510
	4	1616	1616	1616	1616	1616	1616	1610	1551	1400
	6	1485	1485	1485	1485	1485	1485	1485	1426	1287
	8	1351	1351	1351	1351	1351	1351	1351	1297	1171
	10	1318	1318	1318	1318	1318	1318	1318	1266	1143
	12	1312	1312	1312	1312	1312	1312	1312	1259	1137
	14	1317	1317	1317	1317	1317	1317	1317	1264	1141
	16	1310	1310	1310	1310	1310	1310	1310	1258	1135

CL 1500	TEMP, C	38	93	149	204	260	316	343	371	399
FLG RTG PRESS, kPag		25546	23408	22546	21857	20788	19581	18926	18306	17478

CL 900	TEMP, C	38	93	149	204	260	316	343	371	399
FLG RTG PRESS, kPag		15307	14031	13548	13101	12480	11756	11376	10963	10521

PIPE PRESSURE RATING, kPag (1)										
P I P E S C H 80 I Z E	15	17375	17375	17375	17375	17375	17375	17375	16686	15059
	20	15066	15066	15066	15066	15066	15066	15066	14459	13052
	25	15707	15707	15707	15707	15707	15707	15707	15079	13611
	40	12859	12859	12859	12859	12859	12859	12859	12342	11142
	50	11673	11673	11673	11673	11673	11673	11673	11204	10115
	65	13556	13556	13556	13556	13556	13556	13556	13011	11749
	80	12383	12383	12383	12383	12383	11308	11101	10963	10411
	100	11142	11142	11142	11142	11142	11142	11101	10694	9653
	150	10239	10239	10239	10239	10239	10239	10239	9832	8874
	200	9315	9315	9315	9315	9315	9315	9315	8943	8074
	250	9088	9088	9088	9088	9088	9088	9088	8729	7881
	300	9046	9046	9046	9046	9046	9046	9046	8681	7840
	350	9081	9081	9081	9081	9081	9081	9081	8715	7867
	400	9032	9032	9032	9032	9032	9032	9032	8674	7826

					DATE	REV	PIPING MATERIAL SPECIFICATION: CB2			
					29-Mar-16	2	Sheet 2 of 2			

SERVICE: Sodium Tri Phosphate, Steam Sampling					CLASS 900					MATERIAL: STAINLESS STEEL												
TEMP, F		100	200	300	400	500	600	650	700	750												
PRESS, PSIG		See Sheet 2																				
TEMP, C		38	93	149	204	260	316	343	371	399												
PRESS, Barg		See Sheet 2																				
SIZE	NPS	1/2	3/4	1	1.5	2	2.5	3	4	6	8	10	12	14	16	18	20	24				
	DN	15	20	25	40	50	65	80	100	150	200	250	300	350	400	450	500	600				
PIPE (2)		Sch 80S ASTM A312 Type 316, Smls (3)																				
FITTINGS		ASME B16.11, ASTM A182 F316, CL 3000 SW					ASME/ANSI B16.9, ASTM A403 WP316, Smls (3) Butt weld, bore to match pipe															
FLANGES		ASME/ANSI B16.5, ASTM A182 F316																				
		CL 1500 RF SW					CL 900 RF WN, bore to match pipe															
UNIONS		Not allowed, use flanges as specified above																				
BRANCH CONNECTIONS (4)		SW Tee and Rdcg Tee ASTM A182 F316					Full size Tee and Rdcg Tee through three size reduction, ASTM A403 WP316; Weldolet down to 2 1/2" (DN 65), ASTM A182 F316; Socketlet for 2" (DN 50) and smaller, ASTM A182 F316															
BOLTING		Studs, ASTM A193 Gr B8 Cl 2 with Hvy Hex Nuts, ASTM A194 Gr E																				
GASKETS		Spiral Wound 304 SS with Flexicarb Filler, Flexitallic Style CG or equal																				
		CL 1500					CL 900															
V	BALL (1)																					
A	B'FLY																					
L	CHECK																					
(5)V	GATE																					
E	GLOBE	411																				
S																						
M	STRAINER																					
I																						
S																						
C																						
PWHT		NO																				
SIZE	NPS	1/2	3/4	1	1.5	2	2.5	3	4	6	8	10	12	14	16	18	20	24				
	DN	15	20	25	40	50	65	80	100	150	200	250	300	350	400	450	500	600				
NOTES:																						
1. Pressure ratings are for piping and components other than ball valves. Ball valves have lower pressure-temperature ratings based on seat and seal materials. Verify actual service conditions before purchasing ball valves.																						
2. No allowance for corrosion																						
3. For Boiler Proper and Boiler External Piping (BEP) use materials per ASME BPVC Section I, PG-9. Types 304L and WP304 materials are not acceptable within Boiler Code boundaries. Use types 304 and WP316 materials.																						
4. All pressure connections shall be 3/4" (DN 20) SOL and all temperature connections shall be 1" (DN 25) SOL.																						
5. BEP valves are identified by a 9000 series valve specification number (ie: valve 202 would be designated 9202).																						
6. Refer JEL welding procedure specification																						
					DATE		REV		PIPING MATERIAL SPECIFICATION: CC2													
					29-Mar-16		2		Sheet 1 of 2													

SERVICE: Sodium Tri Phosphate, Steam Sampling	CLASS 900	MATERIAL: STAINLESS STEEL
---	-----------	---------------------------

CL 1500	TEMP, F	100	200	300	400	500	600	650	700	750
FLG RTG PRESS, PSIG		3600	3000	2700	2485	2330	2185	2150	2125	2075

CL 900	TEMP, F	100	200	300	400	500	600	650	700	750
FLG RTG PRESS, PSIG		2160	1800	1620	1490	1395	1310	1290	1275	1245

PIPE PRESSURE RATING, PSIG (2)											
P I P E S I Z E	SCH 80S	1/2	3329	2884	2598	2383	2215	2098	2049	2015	1982
		3/4	2884	2498	2250	2065	1919	1817	1775	1746	1717
		1	3022	2618	2358	2164	2011	1904	1860	1830	1799
		1 1/2	2471	2141	1928	1769	1644	1557	1521	1496	1471
		2	2250	1949	1755	1610	1497	1417	1385	1362	1339
		2 1/2	2612	2263	2038	1870	1738	1646	1608	1581	1555
		3	2387	2068	1863	1709	1589	1504	1470	1445	1421
		4	2155	1867	1682	1543	1434	1358	1327	1305	1283
		6	1975	1711	1541	1414	1314	1244	1216	1196	1176
		8	1798	1558	1403	1287	1196	1133	1107	1089	1070
		10	1432	1241	1118	1025	953	903	882	867	853
		12	1202	1042	938	861	800	758	740	728	716

CL 1500	TEMP, C	38	93	149	204	260	316	343	371	399
FLG RTG PRESS, kPag		24821	20684	18615	15754	16064	15065	14823	14651	14306

CL 900	TEMP, C	38	93	149	204	260	316	343	371	399
FLG RTG PRESS, kPag		14892	12410	11170	10274	9618	9032	8894	8790	8584

PIPE PRESSURE RATING, kPag (2)											
P I P E S I Z E	SCH 80S	15	22954	19885	17911	16433	15273	14463	14129	13896	13665
		20	19884	17225	15515	14235	13230	12529	12239	12037	11837
		25	20838	18051	16260	14918	13865	13130	12826	12615	12405
		40	17039	14760	13295	12198	11337	10736	10488	10315	10143
		50	15511	13437	12103	11104	10320	9773	9547	9390	9233
		65	18011	15602	14054	12894	11984	11349	11086	10903	10722
		80	16461	14260	12845	11785	10953	10372	10132	9965	9799
		100	14859	12872	11595	10638	9887	9363	9146	8995	8846
		150	13617	11796	10625	9748	9060	8580	8381	8243	8106
		200	12397	10739	9673	8875	8249	7811	7631	7505	7380
		250	9873	8555	7706	7070	6571	6223	6079	5978	5879
		300	8287	7181	6468	5934	5516	5223	5102	5018	4935

DATE		REV	PIPING MATERIAL SPECIFICATION: CC2							
29-Mar-16		2	Sheet 2 of 2							

SERVICE: Sampling					CLASS 600					MATERIAL: STAINLESS STEEL													
TEMP, F	100	200	300	400	500	600	650	700	750														
PRESS, PSIG (1)	1440	1200	1075	995	930	885	865	845	825														
TEMP, C	38	93	149	204	260	316	343	371	399														
PRESS, kPag (1)	9928	8274	7412	6860	6412	6102	5964	5826	5688														
SIZE	NPS	1/2	3/4	1	1.5	2	2.5	3	4	6	8	10	12	14	16	18	20	24					
	DN	15	20	25	40	50	65	80	100	150	200	250	300	350	400	450	500	600					
PIPE (2)		Sch 80S					Sch 40S																
		ASTM A312 Type 316, Smls (3)																					
FITTINGS		ASME B16.11, ASTM A182, F316, CL 3000 SW					ASME/ANSI B16.9, ASTM A403 WP316, Smls (3) Butt weld, bore to match pipe																
FLANGES		ASME/ANSI B16.5, ASTM A182 F316																					
		CL 600 RF SW					CL 600 RF WN, bore to match pipe																
UNIONS		Not allowed, use flanges as specified above																					
BRANCH CONNECTIONS (4)		SW Tee and Rdcg Tee, ASTM A182 F316					Full size Tee and Rdcg Tee through three size reduction, ASTM A403 WP316 ; Weldolet down to 2" (DN 50), ASTM A182 F316 ; Socket for 1-1/2" (DN 40) and smaller, ASTM A182 F316																
BOLTING		Studs, ASTM A193 Gr B8M Cl 2 with Hvy Hex Nuts, ASTM A194 Gr 8M																					
GASKETS		CL 600 Spiral Wound 304 SS with Flexicarb Filler, Flexitallic Style CG or equal																					
V	BALL (1)																						
A	B'FLY																						
L	CHECK																						
(5)V	GATE																						
E	GLOBE																						
S																							
M	STRAINER																						
I																							
S																							
C																							
	PWHT	NO																					
SIZE	NPS	1/2	3/4	1	1.5	2	2.5	3	4	6	8	10	12	14	16	18	20	24					
	DN	15	20	25	40	50	65	80	100	150	200	250	300	350	400	450	500	600					
NOTES:																							
1. Pressure ratings are for piping and components other than ball valves. Ball valves have lower pressure-temperature ratings based on seat and seal materials. Verify actual service conditions before purchasing ball valves.																							
2. No allowance for corrosion																							
3. For Boiler Proper and Boiler External Piping (BEP) use materials per ASME BPVC Section I, PG-9. Types 304L and WP304 materials are not acceptable within Boiler Code boundaries. Use types 304 and WP316 materials.																							
4. All pressure connections shall be 1" (DN 25) SOL and all temperature connections shall be 3/4" (DN20) TOL.																							
5. BEP valves are identified by a 9000 series valve specification number (ie: valve 226 would be designated 9226).																							
6. Subcontractor shall submit welding procedures meeting ASME BPVC Section IX for P-No. 8 materials.																							
	DATE	29-Mar-16	REV	2	PIPING MATERIAL SPECIFICATION:																	DC2	
					Sheet 1 of 1																		

SERVICE: Steam, Feedwater, Blowdown, Condensate										CLASS 300					MATERIAL: CARBON STEEL						
TEMP, F		100	200	300	400	500	600	650	700	750											
PRESS, PSIG		See Sheet 2																			
TEMP, C		38	93	149	204	260	316	343	371	399											
PRESS, kPag		See Sheet 2																			
SIZE	NPS	1/2	3/4	1	1.5	2	2.5	3	4	6	8	10	12	14	16	18	20	24			
	DN	15	20	25	40	50	65	80	100	150	200	250	300	350	400	450	500	600			
PIPE (1)		Sch 80			Sch 40						Sch STD				Sch XS						
		ASTM A106 Gr B (2)																			
FITTINGS		ASME B16.11, ASTM A105, CL 3000 SW				ASME/ANSI B16.9, ASTM A234 WPB, Smls Butt weld, bore to match pipe															
FLANGES		ASME/ANSI B16.5, ASTM A105																			
		CL 300 RF SW						CL 300 RF WN or SO, bore to match pipe (3)													
UNIONS		MSS SP-83, ASTM A105, CL 3000 SW				Not allowed, use flanges as specified above															
BRANCH CONNECTIONS (4)		SW Tee and Rdcg Tee, ASTM A105				Full size Tee and Rdcg Tee through three size reduction, ASTM A234 WPB; Weldolet down to 2" (DN 50), ASTM A105; Sockolet for 1-1/2"(DN 40) and smaller, ASTM A105															
BOLTING		Alloy Steel Studs, ASTM A193 Gr B7 with Hvy Hex Nuts, ASTM A194 Gr 2H																			
GASKETS		CL 300 Spiral Wound 304 SS with Flexicarb Filler, Flexitallic Style CG or equal																			
V	BALL																				
A	B'FLY																				
L	CHECK	220						260													
(5)V	GATE	42						1, 1A													
E	GLOBE	420																			
S																					
M	STRAINER	720						740, 760													
I	STEAM TRAP	892																			
S																					
C																					
PWHT		NO (7)																			
SIZE	NPS	1/2	3/4	1	1.5	2	2.5	3	4	6	8	10	12	14	16	18	20	24			
	DN	15	20	25	40	50	65	80	100	150	200	250	300	350	400	450	500	600			
NOTES:																					
1. 1/16" (1.58 mm) allowance for corrosion																					
2. For Boiler Proper and Boiler External Piping (BEP) use materials per ASME BPVC Section I, PG-9.																					
3. Slip-on flanges are not allowed in BEP piping larger than 4" NPS (DN 100).																					
3. All pressure connections shall be 3/4" (DN 20) SOL and all temperature connections shall be 3/4" (DN 20) TOL. Except HPS - 1 1/2"(DN40) SOL and LPS & Feed Water - 1 1/4"(DN32) SOL.																					
5. BEP valves are identified by a 9000 series valve specification number (ie: valve 260 would be designated 9260).																					
6. Subcontractors shall submit welding procedures meeting ASME BPVC Section IX for P-No. 1 materials.																					
7. For weldolets 3" NPS (DN 80) and larger only, postweld heat treatment is required.																					
										DATE	REV	PIPING MATERIAL SPECIFICATION:							EB3		
										29-Mar-16	2	Sheet 1 of 2									

SERVICE: Steam, Feedwater, Blowdown, Condensate					CLASS 300	MATERIAL: CARBON STEEL				
---	--	--	--	--	-----------	------------------------	--	--	--	--

FLANGE	TEMP, F	100	200	300	400	500	600	650	700	750
RATING	PRESS, PSIG	740	680	655	635	605	570	550	530	505

PIPE PRESSURE RATING, PSIG (1)											
P I P E S I Z E	SCH 80	1/2									
		3/4									
		1									
			1 1/2								
			2								
			2 1/2								
	SCH 40	3									
		4									
		6									
			8								
			10	731							
	STD	12	636	636	636						
14		578	578	578	578	578				501	
16		505	505	505	505	505	505	505	485	437	
18		448	448	448	448	448	448	448	430	388	
20		403	403	403	403	403	403	403	387	349	
24		335	335	335	335	335	335	335	322	290	

For pipe pressure ratings in the blank area above the line, use flange ratings as limiting values.

FLANGE	TEMP, C	38	93	149	204	260	316	343	371	399
RATING	PRESS, kPag	5102	4688	4516	4378	4171	3930	3792	3654	3482

PIPE PRESSURE RATING, kPag (1)											
P I P E S I Z E	SCH 80	15									
		20									
		25									
			40								
			50								
			65								
	SCH 40	80									
		100									
		150									
			200								
			250	5040							
	STD	300	4385	4385	4385						
350		3985	3985	3985	3985	3985				3454	
400		3482	3482	3482	3482	3482	3482	3482	3344	3013	
450		3089	3089	3089	3089	3089	3089	3089	2965	2675	
500		2779	2779	2779	2779	2779	2779	2779	2668	2406	
600		2310	2310	2310	2310	2310	2310	2310	2220	2000	

For pipe pressure ratings in the blank area above the line, use flange ratings as limiting values.

DATE	REV	PIPING MATERIAL SPECIFICATION:	EB3
29-Mar-16	2	Sheet 2 of 2	

SERVICE: Natural Gas, Propane, Fuel Oil										CLASS 300					MATERIAL: CARBON STEEL										
TEMP, F		100	200	300	400	500	600	650	700	750															
PRESS, PSIG (1)		See Sheet 2																							
TEMP, C		38	93	149	204	260	316	343	371	399															
PRESS, kPag (1)		See Sheet 2																							
SIZE	NPS	1/2	3/4	1	1.5	2	2.5	3	4	6	8	10	12	14	16	18	20	24							
	DN	15	20	25	40	50	65	80	100	150	200	250	300	350	400	450	500	600							
PIPE (2)		Sch 80			Sch 40						Sch STD				Sch XS				ASTM A53 Gr B Smls or A106 Gr B						
FITTINGS		ASME B16.11, ASTM A105, CL 3000 SW					ASME/ANSI B16.9, ASTM A234 WPB, Smls Butt weld, bore to match pipe																		
FLANGES		ASME/ANSI B16.5, ASTM A105																							
		CL 300 RF SW					CL 300 RF WN, bore to match pipe																		
UNIONS		ASME B16.11, ASTM A105, CL 3000 SW					Not allowed, use flanges as specified above																		
BRANCH CONNECTIONS (3)		SW Tee and Rdcg Tee, ASTM A105					Full size Tee and Rdcg Tee through three size reduction, ASTM A234 WPB; Weldolet down to 2" (DN 50), ASTM A105; Sockolet for 1-1/2" (DN 40) and smaller, ASTM A105																		
BOLTING		Alloy Steel Studs, ASTM A193 Gr B7 with Hvy Hex Nuts, ASTM A194 Gr 2H																							
GASKETS		CL 300 Spiral Wound 304 SS with Flexicarb Filler, Flexitallic Style CG or equal																							
V	BALL (1)	365					368																		
A	B'FLY																								
L	CHECK	220					260																		
V	GATE	42					1																		
E	GLOBE	420																							
S	PLUG																								
M	STRAINER	720					740, 760																		
I	FLEX HOSE																								
S																									
C																									
PWHT		NO (5)																							
SIZE	NPS	1/2	3/4	1	1.5	2	2.5	3	4	6	8	10	12	14	16	18	20	24							
	DN	15	20	25	40	50	65	80	100	150	200	250	300	350	400	450	500	600							
NOTES:																									
1. Pressure ratings are for piping and components other than ball valves. Ball valves have lower pressure-temperature ratings based on seat and seal materials. Verify actual service conditions before purchasing ball valves.																									
2. 1/16" (1.58 mm) allowance for corrosion																									
3. All pressure connections shall be 3/4" (DN 20) SOL and all temperature connections shall be 3/4" (DN 20) TOL.																									
4. Subcontractors shall submit welding procedures meeting ASME BPVC Section IX for P-No. 1 materials.																									
5. For weldolets 3" NPS (DN 80) and larger only, postweld heat treatment is required.																									
6. Coat and wrap underground gas piping in accordance with ANSI/AWWA C213 and C216 for field joints, or with ANSI/AWWA C215 and C209 for field joints. Coat and wrap underground fuel oil piping with ANSI/AWWA C214 and C209 for field joints. Consult coating manufacturer for service temperature conditions and limitations.																									
															DATE	REV	PIPING MATERIAL SPECIFICATION:	EB5							
															29-Mar-16	2	Sheet 1 of 2								

SERVICE: Natural Gas, Propane, Fuel Oil				CLASS 300			MATERIAL: CARBON STEEL			
---	--	--	--	-----------	--	--	------------------------	--	--	--

FLANGE	TEMP, F	100	200	300	400	500	600	650	700	750
RATING	PRESS, PSIG	740	680	655	635	605	570	550	530	505

PIPE PRESSURE RATING, PSIG (2)											
P I P E S I Z E	SCH 80	1/2									
		3/4									
		1									
			1 1/2								
			2								
			2 1/2								
			3								
			4								
			6								
			8								
			10	731							
			12	636	636	636					
			14	578	578	578	578	578			501
			16	505	505	505	505	505	505	485	437
			18	448	448	448	448	448	448	430	388
			20	403	403	403	403	403	403	387	349
			24	335	335	335	335	335	335	322	290

FLANGE	TEMP, C	38	93	149	204	260	316	343	371	399
RATING	PRESS, kPag	5102	4688	4516	4378	4171	3930	3792	3654	3482

PIPE PRESSURE RATING, kPag (2)											
P I P E S I Z E	SCH 80	15									
		20									
		25									
		40									
		50									
			65								
			80								
			100								
			150								
			200								
			250	5040							
			300	4385	4385	4385					
			350	3985	3985	3985	3985	3985			3454
			400	3482	3482	3482	3482	3482	3482	3344	3013
			450	3089	3089	3089	3089	3089	3089	2965	2675
			500	2779	2779	2779	2779	2779	2779	2668	2406
			600	2310	2310	2310	2310	2310	2310	2220	2000

										<table border="1"> <tr> <td>DATE</td> <td>REV</td> <td>PIPING MATERIAL SPECIFICATION:</td> <td>EB5</td> </tr> <tr> <td>29-Mar-16</td> <td>2</td> <td>Sheet 2 of 2</td> <td></td> </tr> </table>	DATE	REV	PIPING MATERIAL SPECIFICATION:	EB5	29-Mar-16	2	Sheet 2 of 2	
DATE	REV	PIPING MATERIAL SPECIFICATION:	EB5															
29-Mar-16	2	Sheet 2 of 2																

SERVICE: Sampling, Chemical Feed											CLASS 300				MATERIAL: STAINLESS STEEL						
TEMP, F		100	200	300	400	500	600	650	700	750											
PRESS, PSIG (1)		720	600	540	495	465	440	430	420	415											
TEMP, C		38	93	149	204	260	316	343	371	399											
PRESS, kPag (1)		4964	4137	3723	3413	3206	3034	2965	2896	2861											
SIZE	NPS	1/2	3/4	1	1.5	2	2.5	3	4	6	8	10	12	14	16	18	20	24			
	DN	15	20	25	40	50	65	80	100	150	200	250	300	350	400	450	500	600			
PIPE (2)		Sch 40S										Sch 10S									
		ASTM A312 Type 316, Smls (3)																			
FITTINGS		ASME B16.11, ASTM A182, F316, CL 3000 SW										ASME/ANSI B16.9, ASTM A403 WP316, Smls (3) Butt weld, bore to match pipe									
FLANGES		ASME/ANSI B16.5, ASTM A182 F316																			
		CL 300 RF SW										CL 300 RF WN, bore to match pipe									
UNIONS		Not allowed, use flanges as specified above																			
BRANCH CONNECTIONS (4)		SW Tee and Rdcg Tee, ASTM A182 F316										Full size Tee, Rdcg Tee, or Tee and Reducer, ASTM A403 WP316 (Socketlets are only allowed for instrumentation connections)									
BOLTING		Studs, ASTM A193 Gr B8M Cl 2 with Hvy Hex Nuts, ASTM A194 Gr 8M																			
GASKETS		CL 300 Spiral Wound 304 SS with Flexicarb Filler, Flexitallic Style CG or equal																			
V	BALL (1)																				
A	B'FLY																				
L	CHECK																				
(5)V	GATE																				
E	GLOBE																				
S																					
M	STRAINER																				
I	FLEX HOSE																				
S																					
C																					
PWHT		NO																			
SIZE	NPS	1/2	3/4	1	1.5	2	2.5	3	4	6	8	10	12	14	16	18	20	24			
	DN	15	20	25	40	50	65	80	100	150	200	250	300	350	400	450	500	600			
NOTES:																					
1. Pressure ratings are for piping and components other than ball valves. Ball valves have lower pressure-temperature ratings based on seat and seal materials. Verify actual service conditions before purchasing ball valves.																					
2. No allowance for corrosion																					
3. For Boiler Proper and Boiler External Piping (BEP) use materials per ASME BPVC Section I, PG-9. Types 304L and WP304 materials are not acceptable within Boiler Code boundaries. Use types 304 and WP316 materials.																					
4. All pressure connections shall be 3/4" (DN 20) SOL and all temperature connections shall be 3/4" (DN 20) TOL.																					
5. BEP valves are identified by a 9000 series valve specification number (ie: valve 227 would be designated 9227).																					
6. Subcontractor shall submit welding procedures meeting ASME BPVC Section IX for P-No. 8 materials.																					
(Continued on sheet 2)																					
											DATE	REV	PIPING MATERIAL SPECIFICATION:				EC2				
											29-Mar-16	2	Sheet 1 of 1								

SERVICE: Sulfuric Acid (2-98%)										CLASS 150					MATERIAL: ALLOY 20 (N08020)				
TEMP, F		100	200	300															
PRESS, PSIG		290	260	230															
TEMP, C		38	93	149															
PRESS, kPag		2000	1769	1585															
SIZE	NPS	1/2	3/4	1	1.5	2	2.5	3	4	6	8	10	12	14	16	18	20	24	
	DN	15	20	25	40	50	65	80	100	150	200	250	300	350	400	450	500	600	
PIPE (1, 2)		Sch 80S Sch 40S ASTM B729 Smls or ASTM B464 Welded																	
FITTINGS		ASME B16.11, ASTM B462, CL 3000 SW									ASTM B366, Smls or Welded Butt weld, bore to match pipe								
FLANGES		ASME/ANSI B16.5 ASTM B462 CL 150 FF SW ASTM A105 CL 150 Lap Joint with MSS-SP-43 Type A Stub End, ASTM B366																	
UNIONS		Not allowed, use flanges as specified above																	
BRANCH CONNECTIONS (3)		SW Tee and Rdog Tee, ASTM B462						Full size Tee, ASTM B366; Weldolet down to 2 1/2" (DN 65), ASTM B462; Socketlet for 2" (DN 50) and smaller, ASTM B462											
BOLTING		Alloy Steel Studs, ASTM A193 Gr B7 with Hvy Hex Nuts, ASTM A194 Gr 2H; or in areas where piping may be exposed to weather or potentially submerged, studs and nuts shall be Alloy 20 mat'l conforming to ASME B16.5																	
GASKETS		1/8" thick PTFE/Filler blend, Garlock Gylon Style 3510 or equal																	
V	BALL																		
A	B'FLY																		
L	CHECK	276A																	
V	GATE																		
E	GLOBE																		
S	DIAPHRAG	601																	
M	STRAINER																		
I	HOSE																		
S																			
C																			
PWHT		NO																	
SIZE	NPS	1/2	3/4	1	1.5	2	2.5	3	4	6	8	10	12	14	16	18	20	24	
	DN	15	20	25	40	50	65	80	100	150	200	250	300	350	400	450	500	600	
NOTES:																			
1. No allowance for corrosion																			
2. Meets toxic fluid requirements of ASME B31.1, Para. 122.8.2																			
3. All pressure connections shall be 3/4" (DN 20) SOL and all temperature connections shall be 3/4" (DN 20) TOL.																			
4. Subcontractor shall submit welding procedures meeting ASME BPVC Section IX for P-No. 45 materials.																			
										DATE	REV	PIPING MATERIAL SPECIFICATION:							FA
										29-Mar-16	2								

SERVICE: Steam					CLASS 150					MATERIAL: ALLOY STEEL					
TEMP, F	100	200	300	400	500	600	650	700	750						
PRESS, PSIG	290	260	230	200	170	140	125	110	95						
TEMP, C	38	93	149	204	260	316	343	371	399						
PRESS, kPag	2000	1793	1586	1379	1172	965	862	758	655						
SIZE	NPS	1/2	3/4	1	1.5	2	2.5	3	4	6	8	10	12 thru 24	26 thru 36	
	DN	15	20	25	40	50	65	80	100	150	200	250	300 thru 600	650 thru 900	
PIPE (1)	Sch 80		Sch 40								Std				
	ASTM A335 P5 Smls														
FITTINGS	ASME B16.11, A182 Gr F5, CL 3000 SW				ASME/ANSI B16.9, ASTM A234 WP5, Smls										
	Butt weld, bore to match pipe														
FLANGES	ASME/ANSI B16.5, ASTM A182 Gr F5														
	CL 150 RF SW				CL 150 RF WN or SO, bore to match pipe (3)										
UNIONS	Not allowed, use flanges as specified above														
BRANCH CONNECTIONS (4)	SW Tee and Rdcg Tee, ASTM A182 Gr F5				Full size Tee and Rdcg Tee through three size reduction, ASTM A234 WP5; Weldolet down to 2" (DN 50), ASTM A182 Gr F5										
	Socketlet for 1-1/2" (DN 40) and smaller, ASTM AA182 Gr F5														
BOLTING	Alloy Steel Studs, ASTM A193 Gr B16 with Hvy Hex Nuts, ASTM A194 Gr 7														
GASKETS	CL 150 Spiral Wound 304 SS with Flexicarb Filler, Flexitallic Style LS or equal														
VALVES (5)	BALL														
	B'FLY														
	CHECK														
	GATE														
	GLOBE														
MISCELLANEOUS	STRAINER														
	EXP JOINT														
PWHT	NO														
SIZE	NPS	1/2	3/4	1	1.5	2	2.5	3	4	6	8	10	12 thru 24	26 thru 36	
	DN	15	20	25	40	50	65	80	100	150	200	250	300 thru 600	650 thru 900	
NOTES:															
2. All pressure connections shall be 1" (DN 25) SOL and all temperature connections shall be 3/4" (DN20) TOL. Except HPS - 1 1/2"(DN40) SOL and LPS & Feed Water - 1 1/4"(DN32) SOL.															
3. PWHT is not required if nominal material thickness is less than 1/2" (13mm) and the specified carbon content of the material to be welded is 0.15% or less.															
					DATE	REV	PIPING MATERIAL SPECIFICATION:							FA1	
					29-Mar-16	2	Sheet 1 of 1								

SERVICE: Steam, Feedwater, Condensate, Noncondensable											CLASS 150				MATERIAL: CARBON STEEL			
TEMP, F		100	200	300	400	500	600	650	700	750								
PRESS, PSIG		See Sheet 2																
TEMP, C		38	93	149	204	260	316	343	371	399								
PRESS, kPag		See Sheet 2																
SIZE	NPS	1/2	3/4	1	1.5	2	2.5	3	4	6	8	10	12 thru 24	26 thru 36				
	DN	15	20	25	40	50	65	80	100	150	200	250	300 thru 600	650 thru 900				
PIPE (1)	Sch 80		Sch 40									Std						
ASTM A106 Gr B (2)																		
FITTINGS	ASME B16.11, ASTM A105, CL 3000 SW					ASME/ANSI B16.9, ASTM A234 WPB, Smls												
Butt weld, bore to match pipe																		
FLANGES	ASME/ANSI B16.5, ASTM A105										ASME B16.47, A105							
		CL 150 RF SW					CL 150 RF WN or SO, bore to match pipe (3)											
UNIONS	MSS SP-83, ASTM A105, CL 3000 SW					Not allowed, use flanges as specified above												
BRANCH CONNECTIONS (4)	SW Tee and Rdcg Tee, ASTM A105					Full size Tee and Rdcg Tee through three size reduction, ASTM A234 WPB; Weldolet down to 2" (DN 50), ASTM A105; Sockolet for 1-1/2" (DN 50) and smaller, ASTM A105												
BOLTING	Alloy Steel Studs, ASTM A193 Gr B7 with Hvy Hex Nuts, ASTM A194 Gr 2H																	
GASKETS	CL 150 Spiral Wound 304 SS with Flexicarb Filler, Flexitallic Style LS or equal																	
V	BALL																	
A	B'FLY																	
L	CHECK	220					262											
(5)V	GATE	42					8											
E	GLOBE	420																
S																		
M	STRAINER	720					740											
I	EXP JOINT						870, 873 (6)											
S	STEAM TRAP	892																
C																		
PWHT NO (8)																		
SIZE	NPS	1/2	3/4	1	1.5	2	2.5	3	4	6	8	10	12 thru 24	26 thru 36				
	DN	15	20	25	40	50	65	80	100	150	200	250	300 thru 600	650 thru 900				
NOTES:																		
1. 1/16" (1.58 mm) allowance for corrosion																		
2. For Boiler Proper and Boiler External Piping (BEP) use materials per ASME BPVC Section I, PG-9.																		
3. Slip-on flanges are not allowed in BEP piping larger than 4" NPS (DN 100).																		
4. All pressure connections shall be 3/4" (DN 20) SOL and all temperature connections shall be 3/4" (DN 20) TOL. Except HPS - 11/2"(DN40) SOL and LPS & Feed Water - 11/4"(DN32) SOL.																		
5. BEP valves are identified by a 9000 series valve specification number (ie: valve 262 would be designated 9262).																		
6. These expansion joints are intended for low temperature condensate service only. They have lower temperature and pressure limitations than the piping. Verify actual service conditions before purchase.																		
7. Subcontractor shall submit welding procedures meeting ASME BPVC Section IX for P-No. 1 materials.																		
8. For weldolets 3" NPS (DN 80) and larger only, postweld heat treatment is required.																		
										DATE	REV	PIPING MATERIAL SPECIFICATION: FB3						
										29-Mar-16	2	Sheet 1 of 2						

SERVICE: Steam, Feedwater, Condensate, Noncondensable	CLASS 150	MATERIAL: CARBON STEEL
---	-----------	------------------------

FLANGE	TEMP, F	100	200	300	400	500	600	650	700	750
RATING	PRESS, PSIG	285	260	230	200	170	140	125	110	95

PIPE PRESSURE RATING, PSIG (1)											
P I P E S I Z E	SCH 80	1/2									
		3/4									
		1									
		1 1/2									
		2									
	SCH 40	2 1/2									
		3									
		4									
		6									
		8									
		10									
	STD	12									
		14									
		16									
		18									
		20									
		24									
		30	268								
	36	223	223	223							

For pipe pressure ratings in the blank area above the line, use flange ratings as limiting values.

FLANGE	TEMP, C	38	93	149	204	260	316	343	371	399
RATING	PRESS, kPa	1965	1793	1586	1379	1172	965	862	758	655

PIPE PRESSURE RATING, kPag (1)											
P I P E S I Z E	SCH 80	15									
		20									
		25									
		40									
		50									
	SCH 40	65									
		80									
		100									
		150									
		200									
		250									
	STD	300									
		350									
		400									
		450									
		500									
		600									
		750	1848								
	900	1538	1538	1538							

For pipe pressure ratings in the blank area above the line, use flange ratings as limiting values.

DATE	REV	PIPING MATERIAL SPECIFICATION:	FB3
29-Mar-16	2	Sheet 2 of 2	

SERVICE: Demin Water, Condensate , Instrument Air, Sampling											CLASS 150					MATERIAL: STAINLESS STEEL					
TEMP, F	100	200	300	400	500	600	650	700	750												
PRESS, PSIG	275	230	205	190	170	140	125	110	95												
TEMP, C	38	93	149	204	260	316	343	371	399												
PRESS, kPag	1896	1586	1413	1310	1172	965	862	758	655												
SIZE	NPS	1/2	3/4	1	1.5	2	2.5	3	4	6	8	10	12	14	16	18	20	24			
	DN	15	20	25	40	50	65	80	100	150	200	250	300	350	400	450	500	600			
PIPE (1)		Sch 40S					Sch 10S														
		ASTM A312 Type 304L, Smls (2)																			
FITTINGS		ASME B16.11, ASTM A182 F304L, CL 3000 SW					ASME/ANSI B16.9, ASTM A403 WP304L , Smls (2) Butt weld, bore to match pipe														
FLANGES		ASME/ANSI B16.5, ASTM A182 F304L																			
		CL 150 RF SW					CL 150 RF SO or WN, bore to match pipe														
UNIONS		Not allowed, use flanges as specified above																			
BRANCH CONNECTIONS (3)		SW Tee and Rdcg Tee, ASTM A182 F304L					Full size Tee, Rdcg Tee, or Tee and Reducer, ASTM A403 WP304L (Socketlets are only allowed for instrumentation connections)														
BOLTING		Studs, ASTM A193 Gr B8M Cl 2 with Hvy Hex Nuts, ASTM A194 Gr 8M																			
GASKETS		CL 150 Spiral Wound 304 SS with Flexicarb Filler, Flexitallic Style LS or equal																			
V	BALL	353					354														
A	B'FLY																				
L	CHECK	225					264														
(4)V	GATE	46					9(5)														
E	GLOBE	427					467(5)														
S																					
M	STRAINER						740, 763														
I	FLEX HOSE						876														
S	EXP JOINT																				
C																					
PWHT		NO																			
SIZE	NPS	1/2	3/4	1	1.5	2	2.5	3	4	6	8	10	12	14	16	18	20	24			
	DN	15	20	25	40	50	65	80	100	150	200	250	300	350	400	450	500	600			
NOTES:																					
1. No allowance for corrosion																					
2. For Boiler Proper and Boiler External Piping (BEP) use materials per ASME BPVC Section I, PG-9. Types 304L and WP304 materials are not acceptable within Boiler Code boundaries. Use types 304 and WP316 materials.																					
3. All pressure connections shall be 3/4" (DN 20) SOL and all temperature connections shall be 3/4" (DN 20) TOL.																					
4. BEP valves are identified by a 9000 series valve specification number (ie: valve 264 would be designated 9264).																					
5. Butt weld end valves are preferred for piping sizes 8" NPS (DN 200) and larger.																					
6. These expansion joints are intended for low temperature water service only. They have lower temperature and pressure limitations than the piping. Verify actual service conditions before purchase.																					
7. Subcontractor shall submit welding procedures meeting ASME BPVC Section IX for P-No. 8 materials.																					
8. Coat and wrap underground gas piping per AWWA C213 and C216 for field joints, or per AWWA C215 and C209 for field joints. Coat and wrap underground water piping per AWWA C214 and C209 for field joints Consult coating manufacturer for service temperature																					
											DATE	REV	PIPING MATERIAL SPECIFICATION:					FC			
											29-Mar-16	2									

SERVICE: Chemical Feed					CLASS 150					MATERIAL: STAINLESS STEEL									
TEMP, F	100	200	300	400															
PRESS, PSIG	275	235	215	195															
TEMP, C	38	93	149	204															
PRESS, kPag	1896	1620	1482	1345															
SIZE	NPS	1/2	3/4	1	1.5	2	2.5	3	4	6	8	10	12	14	16	18	20	24	
	DN	15	20	25	40	50	65	80	100	150	200	250	300	350	400	450	500	600	
PIPE (1, 2)	Sch 80S					Sch 40S					ASTM A312 Type 316L, Smls								
FITTINGS	ASME B16.11, ASTM A182 F316L, CL 3000 SW					ASME/ANSI B16.9, ASTM A403 WP316L, Smls					Butt weld, bore to match pipe								
FLANGES	ASME/ANSI B16.5, ASTM A182 F316L										CL 150 FF WN, bore to match pipe								
UNIONS	Not allowed, use flanges as specified above																		
BRANCH CONNECTIONS (3)	SW Tee and Rdcg Tee, ASTM A403 F316L					Full size Tee and Rdcg Tee through three size reduction, ASTM A403 WP316L ; Weldolet down to 2" (DN 50), ASTM A182 F316L ; Sockolet for 1-1/2" (DN 40) and smaller, ASTM A182 F316L													
BOLTING	Studs, ASTM A193 Gr B8M Cl 2 with Hvy Hex Nuts, ASTM A194 G1																		
GASKETS	1/8" (3 mm) thick PTFE/Filler blend, Garlock Gylon Style 3510 or eq																		
V	BALL																		
A	B'FLY																		
L	CHECK																		
V	GATE																		
E	GLOBE																		
S																			
M	STRAINER																		
I																			
S																			
C																			
PWHT										NO									
SIZE	NPS	1/2	3/4	1	1.5	2	2.5	3	4	6	8	10	12	14	16	18	20	24	
	DN	15	20	25	40	50	65	80	100	150	200	250	300	350	400	450	500	600	
NOTES:																			
1. No allowance for corrosion																			
2. Meets toxic fluid requirements of ASME B31.1, Para. 122.8.2																			
3. Threaded connections should be avoided but are allowed for sizes 3/4" NPS (DN 20) and smaller.																			
4. Subcontractor shall submit welding procedures meeting ASME BPVC Section IX for P-No. 8 materials.																			
5. For Boiler Proper and Boiler External Piping (BEP) use materials per ASME BPVC Section I, PG-9. Types 304L and WP304 materials are not acceptable within Boiler Code boundaries. Use types 304 and WP316 materials.																			
										DATE	REV	PIPING MATERIAL SPECIFICATION:							FC2
										29-Mar-16	2								

SERVICE: Chilled,Raw, Waste Water, Cooling Water, Service Water										CLASS 125		MATERIAL: CARBON STEEL						
TEMP, F		-20 to 150			200			-20 to 150		200		-20 to 150		200				
PRESS, PSIG		200			190			150		135		150		115				
TEMP, C		66			93			66		93		66		93				
PRESS, kPag		1379			1310			1034		931		1034		793				
SIZE	NPS	1/2	3/4	1	1.5	2	2 1/2 thru 10	12	14 thru 24	26 thru 48	50 thru 60							
	DN	15	20	25	40	50	65 thru 250	300	350 thru 600	650 thru 1200	1250 thru 1500							
PIPE (1)	Sch 80 ASTM A53 Gr B ERW or API 5L Gr B ERW										Sch 40 Std		3/8" wall, ANSI/AWWA C200 EFW, from ASTM A283 Gr C plate					
FITTINGS	ASME B16.11, ASTM A105, CL 3000 SW			ASME/ANSI B16.9, ASTM A234 WPB, Butt weld, bore to match pipe or Welded fittings (2)														
FLANGES	ASME/ANSI B16.5, ASTM A105										ASME B16.47, ASTM A105							
UNIONS	MSS SP-83, ASTM A105 CL 3000 SW			CL 150 FF WN or SO, bore to match pipe, or ANSI/AWWA C207 SO Hub Class D														
BRANCH CONNECTIONS (3)	SW Tee and Rdcg Tee, ASTM A105			Full size Tee and Rdcg Tee thru three sizes, A234 WPB; Stub-in down to 2 1/2" (DN 65); Weldolet for 2", TOL or SOL for 1-1/2" (DN 40) and less, A105										Stub-in				
BOLTING	Machine Bolts, ASTM A307 Gr B with Hvy Hex Nuts, ASTM A563 Gr A UNC or A194 Gr 2H UNC																	
GASKETS	1/8" (3 mm) thick Cloth Inserted Rubber																	
V	BALL	362			366													
A	B'FLY											161						
L	CHECK	220			262, 262A			270										
V	GATE	42			15													
E	GLOBE	420			462													
S																		
M	STRAINER	720			730, 740, 741, 765													
I	EXP JOINT											870						
S	FLOW INDP																	
C																		
PWHT															NO			
SIZE	NPS	1/2	3/4	1	1.5	2	2 1/2 thru 10	12 thru 24	26 thru 48	50 thru 60								
	DN	15	20	25	40	50	65 thru 250	300 thru 600	650 thru 1200	1250 thru 1500								
NOTES:																		
1. 1/16" (1.58 mm) allowance for corrosion																		
2. Welded fittings are to be of the same material and wall thickness as the pipe. Mitered fittings are acceptable for 600mm and larger.																		
4. All pressure connections shall be 3/4" (DN 20) SOL and all temperature connections shall be 3/4" (DN 20) TOL.																		
4. Subcontractor shall submit welding procedures meeting ASME BPVC Section IX for P-No. 1 materials.																		
5. Coat and wrap underground piping in accordance with ANSI/AWWA C214 and C209 for field joints.																		
Consult coating manufacturer for service temperature conditions and limitations.																		
										DATE	REV	PIPING MATERIAL SPECIFICATION:		GB				
										29-Mar-16	2							

SERVICE: Cooling Water					CLASS 125	MATERIAL: CARBON STEEL		
TEMP, F					-20 to 150	200		
PRESS, PSIG					150	115		
TEMP, C					66	93		
PRESS, kPag					1034	793		
SIZE	NPS					26 thru 48	50 thru 60	
	DN					650 thru 1200	1250 thru 1500	
PIPE (1)(6)					3/8" wall, ANSI/AWWA C200 EFW, from ASTM A283 Gr C plate			
FITTINGS					ASME/ANSI B16.9, ASTM A234 WPB, Butt weld, bore to match pipe or Welded fittings (2)			
FLANGES					ASME B16.47, ASTM A105 CL 150 FF WN or SO, bore to match pipe, or ANSI/AWWA C207 SO Hub Class D			
UNIONS BRANCH CONNECTIONS (3)					Not allowed, use flanges as specified above TOL or SOL for 1 1/2" (DN 40) and less, A105 Stub-in for 2" & Larger			
BOLTING					Machine Bolts, ASTM A307 Gr B with Hvy Hex Nuts, ASTM A563 Gr A UNC or A194 Gr 2H UNC			
GASKETS					1/8" (3 mm) thick Cloth Inserted Rubber			
VALVES	BALL							
	B'FLY							161
	CHECK							
VESSELS	GATE							
	GLOBE							
MISCELLANEOUS	STRAINER							741
	EXP JOINT							870
	FLOW INDIC							
PWHT					NO			
SIZE	NPS					26 thru 48	50 thru 60	
	DN					650 thru 1200	1250 thru 1500	
<p>NOTES:</p> <ol style="list-style-type: none"> 1/16" (1.58 mm) allowance for corrosion Welded fittings are to be of the same material and wall thickness as the pipe. Mitered fittings are acceptable for 600mm and larger. All pressure connections shall be 3/4" (DN 20) SOL and all temperature connections shall be 3/4" (DN 20) TOL. Subcontractor shall submit welding procedures meeting ASME BPVC Section IX for P-No. 1 materials. Coat and wrap underground piping in accordance with ANSI/AWWA C214 and C209 for field joints. Consult coating manufacturer for service temperature conditions and limitations. Internally coat with one coat of Valspar Hi-build Epoxy Series 78 (or equal) to a min. of DFT of 4.0 mils for size 450mm and larger. 								
					DATE	REV	PIPING MATERIAL SPECIFICATION: GB1	
					29-Mar-16	2		

SERVICE: Underground Fire Water										150 WWP					MATERIAL: CARBON STEEL				
TEMP, F		-20 to 150					200					-20 to 150		200		-20 to 150		200	
PRESS, PSIG		200					190					150		135		150		115	
TEMP, C		66					93					66		93		66		93	
PRESS, kPag		1379					1310					1034		931		1034		793	
SIZE	NPS	1/2	3/4	1	1.5	2	2.5	3	4	6	8	10	12	14					
	DN	15	20	25	40	50	65	80	100	150	200	250	300	350					
PIPE (1)		Sch 80					Sch 40					Sch STD							
		ASTM A53 Gr B ERW or API 5L Gr B ERW																	
FITTINGS		ASME B16.11, ASTM A105, CL 3000 SW					ASME/ANSI B16.9, ASTM A234 WPB, Butt weld, bore to match pipe												
FLANGES		CL 150 FF SW					ASME/ANSI B16.5, ASTM A105												
							CL 150 FF WN or SO, bore to match pipe, or ANSI/AWWA C207 SO Hub Class D												
UNIONS		MSS SP-83, ASTM A105 CL 3000 SW					Not allowed, use flanges as specified above												
BRANCH CONNECTIONS (3)		SW Tee and Rdcg Tee, ASTM A105					Full size Tee and Rdcg Tee thru three sizes, A234 WPB; Stub-in down to 2 1/2" (DN 65); Weldolet for 2", TOL or SOL for 1-1/2" (DN 40) and less, A105												
BOLTING		Machine Bolts, ASTM A307 Gr B with Hvy Hex Nuts, ASTM A563 Gr A UNC or A194 Gr 2H UNC																	
GASKETS		1/8" (3 mm) thick Cloth Inserted Rubber																	
V	BALL																		
A	B'FLY																		
L	CHECK																		
V	GATE	13																	
E	GLOBE																		
S																			
M																			
I																			
S																			
C																			
PWHT		NO																	
SIZE	NPS	1/2	3/4	1	1.5	2	2.5	3	4	6	8	10	12	14					
	DN	15	20	25	40	50	65	80	100	150	200	250	300	350					
<p>NOTES:</p> <ol style="list-style-type: none"> 1/16" (1.58 mm) allowance for corrosion All Bolts & Nuts shall be Galvanized and applied anti-seizing solvent(Molybdenum Disulfide). All pressure connections shall be 3/4" (DN 20) SOL and all temperature connections shall be 3/4" (DN 20) TOL. Subcontractor shall submit welding procedures meeting ASME BPVC Section IX for P-No. 1 materials. Coat and wrap underground piping in accordance with ANSI/AWWA C214 and C209 for field joints. Consult coating manufacturer for service temperature conditions and limitations. 																			
										DATE	REV	PIPING MATERIAL SPECIFICATION:							GB2
										29-Mar-16	2								

SERVICE: Underground BlowDown					150 WWP					MATERIAL: CARBON STEEL					
TEMP, F		-20 to 150			200			-20 to 150		200		-20 to 150		200	
PRESS, PSIG		200			190			150		135		150		115	
TEMP, C		66			93			66		93		66		93	
PRESS, kPag		1379			1310			1034		931		1034		793	
SIZE	NPS	1/2	3/4	1	1.5	2	2.5	3	4	6					
	DN	15	20	25	40	50	65	80	100	150					
PIPE (1)		Sch 80 ASTM A53 Gr B ERW or API 5L Gr B ERW													
FITTINGS		ASME/ANSI B16.9, ASTM A234 WPB, Butt weld, bore to match pipe													
FLANGES															
UNIONS															
BRANCH CONNECTIONS (3)		Full size Tee and Rdcg Tee thru three sizes, A234 WPB; Stub-in down to 2 1/2" (DN 65); Weldolet for 2", TOL or SOL for 1-1/2" (DN 40) and less, A105													
BOLTING															
GASKETS															
V	BALL														
A	B'FLY														
L	CHECK														
V	GATE														
E	GLOBE														
S															
M															
I															
S															
C															
PWHT		NO													
SIZE	NPS	1/2	3/4	1	1.5	2	2.5	3	4	6					
	DN	15	20	25	40	50	65	80	100	150					
<p>NOTES:</p> <p>1. 1/16" (1.58 mm) allowance for corrosion</p> <p>2. Coat and wrap underground piping in accordance with ANSI/AWWA C214 and C209 for field joints. Consult coating manufacturer for service temperature conditions and limitations.</p>															
					DATE					REV					
					29-Mar-16					2					
										PIPING MATERIAL SPECIFICATION: GB4					







SERVICE: Service Air											CLASS 125					MATERIAL: GALVANIZED CARBON STEEL									
TEMP, F		-20	150	200																					
PRESS, PSIG		200	200	190																					
TEMP, C		-29	66	93																					
PRESS, kPag		1378	1378	1310																					
SIZE	NPS	1/2	3/4	1	1.5	2	2.5	3	4	6	8	10	12	14	16	18	20	24							
	DN	15	20	25	40	50	65	80	100	150	200	250	300	350	400	450	500	600							
PIPE	Sch 80 Threaded End						Sch 40 Grooved End																		
	ASTM A53 Gr B ERW, Galvanized																								
FITTINGS	ASME B16.11, ASTM A105 Galvanized CL 3000 Threaded						Ductile Iron ASTM A536, Gr. 65-45-12 or ASTM A395 Gr. 65-45-15 Galv.with grooved end According to AWWA C606																		
FLANGES	A105 Galvanized CL 150 FF Threaded						Ductile Iron ASTM A536, Gr. 65-45-12 or ASTM A395 Gr. 65-45-15 Galv.Flange adapter with grooved end According to AWWA C606																		
JOINTS	MSS SP-83, ASTM A105, Galvanized CL 3000 Threaded						Mechanical Coupling With Grooved End According to AWWA C606																		
BRANCH CONNECTIONS -2	Ductile Iron ASTM A536, Gr. 65-45-12 or ASTM A395 Gr. 65-45-15 Galv. Galvanized Threaded Mechanical Tee																								
BOLTING	Machine Bolts, ASTM A307 Gr B with Hvy Hex Nuts, ASTM A563 Gr A UNC or A194 Gr 2H UNC																								
GASKETS	1/8" (3 mm) thick Cloth Inserted Rubber																								
VALVES	BALL	362						366																	
	B'FLY																								
	CHECK									262A															
	GLOBE	463						462																	
MISC	STRAINER																								
PWHT																									
SIZE	NPS	1/2	3/4	1	1.5	2	2.5	3	4	6	8	10	12	14	16	18	20	24							
	DN	15	20	25	40	50	65	80	100	150	200	250	300	350	400	450	500	600							
<p>NOTES:</p> <ol style="list-style-type: none"> 1/16" (1.58 mm) allowance for corrosion All pressure connections shall be 3/4" (DN 20) SOL and all temperature connections shall be 3/4" (DN 20) TOL. Components of potable water systems shall be marked or tagged denoting potable water service. Coat and wrap underground piping in accordance with ANSI/AWWA C203, or C213, C214 and C209 for field joints Consult coating manufacturer for service temperature conditions and limitations. 																									
											DATE	REV	PIPING MATERIAL SPECIFICATION: GF												
											29-Mar-16	2													

SERVICE: Aboveground Firewater										150 WWP					MATERIAL: CARBON STEEL(GALV)				
TEMP, F		100	150	200															
PRESS, PSIG		150	150	135															
TEMP, C		38	66	93															
PRESS, kPag		1034	1034	931															
SIZE	NPS	1/2	3/4	1	1.5	2	2.5	3	4	6	8	10	12	14	16	18	20	24	
	DN	15	20	25	40	50	65	80	100	150	200	250	300	350	400	450	500	600	
PIPE		Sch 80 Threaded End					Sch 40 Grooved End												
		ASTM A53 Gr B ERW(GALV)																	
FITTINGS		ASME B16.11, ASTM A105 Galvanized CL 3000 Threaded					Ductile Iron ASTM A536, Gr. 65-45-12 or ASTM A395 Gr. 65-45-15 Galv.with grooved end According to AWWA C606												
FLANGES		ASME/ANSI B16.5, ASTM A105 Galvanized CL 150 FF Threaded					Ductile Iron ASTM A536, Gr. 65-45-12 or ASTM A395 Gr. 65-45-15 Galv.Flange adapter with grooved end According to AWWA C606												
JOINTS		MSS SP-83, ASTM A105, Galvanized CL 3000 Threaded					Mechanical Coupling With Grooved End According to AWWA C606												
BRANCH CONNECTIONS	-2	Ductile Iron ASTM A536, Gr. 65-45-12 or ASTM A395 Gr. 65-45-15 Galv.Galvanized Threaded Mechanical Tee																	
	(4)																		
GASKETS		1/8" (3 mm) thick Cloth Inserted Rubber																	
V	BALL	362																	
A	BFLY																		
L	CHECK																		
V	GATE	17																	
E	GLOBE																		
S																			
M																			
I																			
S																			
C																			
PWHT		NO																	
SIZE	NPS	1/2	3/4	1	1.5	2	2.5	3	4	6	8	10	12	14	16	18	20	24	
	DN	15	20	25	40	50	65	80	100	150	200	250	300	350	400	450	500	600	
NOTES:																			
1. 1/16" (1.58 mm) allowance for corrosion																			
2. All pressure connections shall be 3/4" (DN 20) SOL and all temperature connections shall be 3/4" (DN 20) TOL.																			
3. Not Used.																			
4. All Bolts & Nuts shall be Galvanized and applied anti-seizing solvent(Molybdenum Disulfide)																			
5. Coat and wrap underground piping in accordance with ANSI/AWWA C203 and C209 for field joints.																			
Consult coating manufacturer for service temperature conditions and limitations.																			
										DATE	REV	PIPING MATERIAL SPECIFICATION: GF1							
										29-Mar-16	2								

SERVICE: Sodium Hypochlorite					150 WWP					MATERIAL: CPVC PLASTIC									
TEMP, F	73	80	100	120	140	160	180	200											
PRESS, PSIG	150	135	105	80	60	45	35	20											
TEMP, C	23	27	38	49	60	71	82	93											
PRESS, kPag	1034	931	724	552	414	310	241	138											
SIZE	NPS	1/2	3/4	1	1.5	2	2.5	3	4	6	8	10	12	14	16	18	20	24	
	DN	15	20	25	40	50	65	80	100	150	200	250	300	350	400	450	500	600	
Sch 80																			
PIPE	ASTM F441 Chlorinated Polyvinyl Chloride (CPVC) Plastic, CL 23447-B																		
FITTINGS	ASTM F439, Socket type CPVC, Sch 80, ASTM F493 solvent cement																		
FLANGES	ASTM F439, FF Socket type CPVC, dimensions to ASME/ANSI B16.5 CL 150																		
JOINTS	Socket type Coupling, CPVC, Sch 80																		
BRANCH CONNECTIONS	Socket type Tee and Reducing Bushing																		
BOLTING	Machine Bolts, ASTM A307 Gr B with Hvy Hex Nuts, ASTM A194 Gr 2H UNC or A563 Gr A UNC																		
GASKETS	1/8" (3 mm) thick full Viton																		
VALVES	BALL																		
	B'FLY																		
	CHECK																		
	GATE																		
	GLOBE																		
MISCELLANEOUS	STRAINER																		
PWHT																			
SIZE	NPS	1/2	3/4	1	1.5	2	2.5	3	4	6	8	10	12	14	16	18	20	24	
	DN	15	20	25	40	50	65	80	100	150	200	250	300	350	400	450	500	600	
NOTES:																			
1. For outdoor, sunlight exposed installations, painting with two coats of heavily pigmented, light colored, exterior water base latex paint is required.																			
															DATE	REV	PIPING MATERIAL SPECIFICATION:		GH2
															29-Mar-16	2			

SERVICE: Underground Waste Water					120 WWP					MATERIAL: POLYETHYLENE										
TEMP, F	73	80	90	100	110	120	130	140												
PRESS, PSIG	120	113	105	94	85	75	68	60												
TEMP, C	23	27	32	38	43	49	54	60												
PRESS, kPag	827	779	724	648	586	517	469	414												
SIZE (IPS)	NPS DN	1/2 15	3/4 20	1 25	1.5 40	2 50	3 80	4 100	6 150	8 200	10 250	12 300	14 350	16 400	18 450	20 500	22 550	24 600	26 650	28 700
PIPE	SDR 13.6					SDR 13.6														
	ASTM D3035					ASTM F714														
PN 10, PE 80 Polyethylene, ASTM D3350 Cell Classification 345434C																				
FITTINGS (1)	SDR 13.6 Molded Butt-type, ASTM D3261					SDR 13.6 Molded Butt-type, ASTM D3261, or SDR 13.6 Fabricated Butt-type, ASTM F714														
FLANGES (2)											PE 3408 Polyethylene Flange Adapter with Ductile Iron Back-Up Flange to match ASME/ANSI B16.5, CL 150									
UNIONS	Not allowed, use flanges as specified above																			
BRANCH CONNECTIONS	Tee or Branch Saddle Reducing Tee																			
BOLTING	Machine Bolts, ASTM A307 Gr B with Hvy Hex Nuts, ASTM A563 Gr A UNC or A194 Gr 2H UNC																			
GASKETS	1/8" (3 mm) thick Cloth Inserted Rubber or, if required for chemical resistance, 1/8" (3 mm) thick PTFE, Garlock CHEMREX or equal																			
VALVES (2)	BALL																			
	BFLY																			
	CHECK																			
	GLOBE																			
MISCELLANEOUS	STRAINER																			
PWHT																				
SIZE (IPS)	NPS DN	1/2 15	3/4 20	1 25	1.5 40	2 50	3 80	4 100	6 150	8 200	10 250	12 300	14 350	16 400	18 450	20 500	22 550	24 600	26 650	28 700
NOTES:																				
1. Piping 3" IPS (DN 80) and smaller can be cold bent with a minimum radius of curvature equal to 30 pipe diameters.																				
2. Flanges and valves shall be coated according to ANSI/AWWA C110/A21.10.																				
3. Piping shall be installed in accordance with ASTM D2321 and manufacturer's recommendations.																				
					DATE	REV	PIPING MATERIAL SPECIFICATION:													GL1
					29-Mar-16	2														

SERVICE: Waste Water				150 WWP				MATERIAL: FRP												
TEMP, F	73	80	100	120	140	160	180	200												
PRESS, PSIG	150	135	105	80	60	45	35	20												
TEMP, C	23	27	38	49	60	71	82	93												
PRESS, kPag	1034	931	724	552	414	310	241	138												
SIZE	NPS	1/2	3/4	1	1.5	2	2.5	3	4	6	8	10	12	14	16					
	DN	15	20	25	40	50	65	80	100	150	200	250	300	350	400					
PIPE (2)		Filament-wound fiberglass reinforced epoxy pipe with Taper/ Taper male and female adhesive joint. ASTM D-2310 & D-2996 Classification: RTRP-11 FE																		
FITTINGS (2)		Filament-wound fiberglass reinforced epoxy with integral taper socket ends ASTM D-2310 & D-2996 Classification: RTRP-11 FE																		
FLANGES (2)		Heavy-Duty filament-wound flanges with Taper-Taper adhesive bonded socket ends drillings : ANSI B16.5 Class 150 Filament-wound Stub-end flanges with Taper-Taper adhesive bonded socket ends and steel backing rings drillings : ANSI B16.5 Class 150																		
JOINTS (4)		Filament-wound couplings with integral Taper-Taper adhesive bonded socket ends ASTM D-2310 & D-2996 Classification: RTRP-11 FE																		
BRANCH CONNECTIONS	Filament-wound pipe saddles with stainless steel, ½ inch or ¾ inch Fabricated flanged reducing saddles	Filament-wound Tees, 45° Lateral, Cross, Reducing Tee, with integral Taper-Taper adhesive bonded socket ends																		
BOLTING (5)	Machine Bolts, ASTM A307 Gr B with Hvy Hex Nuts, ASTM A194 Gr 2H UNC or A563 Gr A UNC and plain washer ANSI/ASTM F436																			
GASKETS	3 mm (¼ inch) thick Full-face or raised face gasket of a reinforced elastomer or compressed fiber																			
V	BALL		362																	
A	B'FLY										161									
L	CHECK										262A									
V	GATE										15									
E	GLOBE		420																	
S																				
M	STRAINER																			
I	EXP JOINT																			
S	FLOW INDIC																			
C																				
PWHT		NO																		
SIZE	NPS	1/2	3/4	1	1.5	2	2 thru 10			12 thru 24		26 thru 48		50 thru 60						
	DN	15	20	25	40	50	thru 250			300 thru 600		650 thru 1200		1250 thru 1500						
NOTES:																				
1. Other configurations are available on request. Consult manufacturer.																				
2. Pipes, fittings and flanges shall be coated with UV protection.																				
3. Piping shall be installed in accordance with manufacturer's recommendations.																				
4. Moulded flange should not be connected to wafer valves or raised face steel flange.																				
5. All bolt to be tightened as per manufacturer's recommended torque. Do not exceed the torque increments given in RECOMMENDED BOLT TORQUE.																				
	DATE	REV	PIPING MATERIAL SPECIFICATION:															GR		
	29-Mar-16	2																		

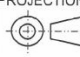
REV.	DATE	DESCRIPTION	DRAWN	DESIGNED	CHECKED	APPROVED	STATUS
1	15-Apr-15	Issued for Construction	-	RD	LAX/SKM	GPJ	C
0	26-Sept-14	Issued for Construction	-	RD	LAX/SKM	GPJ	C
A	21-July-14	Issued for Reference	-	RD	LAX/SKM	GPJ	R
JEL STAMP			OWNER'S APPROVAL STAMP				
<div style="border: 1px solid red; padding: 5px; display: inline-block; color: red; font-weight: bold;">FOR CONSTRUCTION</div>							
OWNER  SIAM PURE RICE COMPANY LIMITED 71 AGR Building, Charoen Rat Road, Bang Khlo, Bang Kho Laem, Bangkok 10120.							
SPR	OWNER'S ENGINEER						
TE	TRACTEBEL ENGINEERING LTD. TRACTEBEL Engineering 12 th Fl., Park Ventures Ecoplex, 57 Wireless Road, Lumpini, Pathumwan, Bangkok 10330.						
TJEL							
PROJ	THE CONSORTIUM OF						
P&E	OFFSHORE CONSORTIUM MEMBER			ONSHORE CONSORTIUM MEMBER			
PIPING	 JURONG ENGINEERING LIMITED 25 Tanjong Kling Road, Singapore 628050.			 THAI JURONG ENGINEERING LIMITED 75/43 Ocean Tower2, 22nd Floor, Sukhumvit 19, North Klongtoey, Wattana, Bangkok 10110.			
C&S							
T&V							
ELEC	OWNER CONTRACT NO.	PROJECT					
INST	-	SPR 120MW SPP PROJECT					
PROC	SCALE	PROJECTION	TITLE:				
			GA DRAWINGS FOR GAS COMPRESSOR & MOTOR				
	NTS						
TOTAL	 Jurong Engineering Limited			JOB NO. 20036	JEL DRAWING NO. C515-003		
DISTRIBUTION	PROJECT DRAWING NO. SPR-10-EKG-GA-M4004				REV. NO. 1		

JURONG ENGINEERING LIMITED

INDEX

Sl.No	Vendor Dwg/Doc. No	Rev	Vendor Drawing Title	Project Dwg No. / Rev	Remarks
1	TAG-1405-200-141	3	GA DRAWINGS FOR GAS COMPRESSOR & MOTOR	SPR-10-EKG-GA-M4004_Rev_0	2 sheets(superseeded)
2	TAG-1405-200-141	5	GA DRAWINGS FOR GAS COMPRESSOR & MOTOR	SPR-10-EKG-GA-M4004_Rev_1	2 sheets



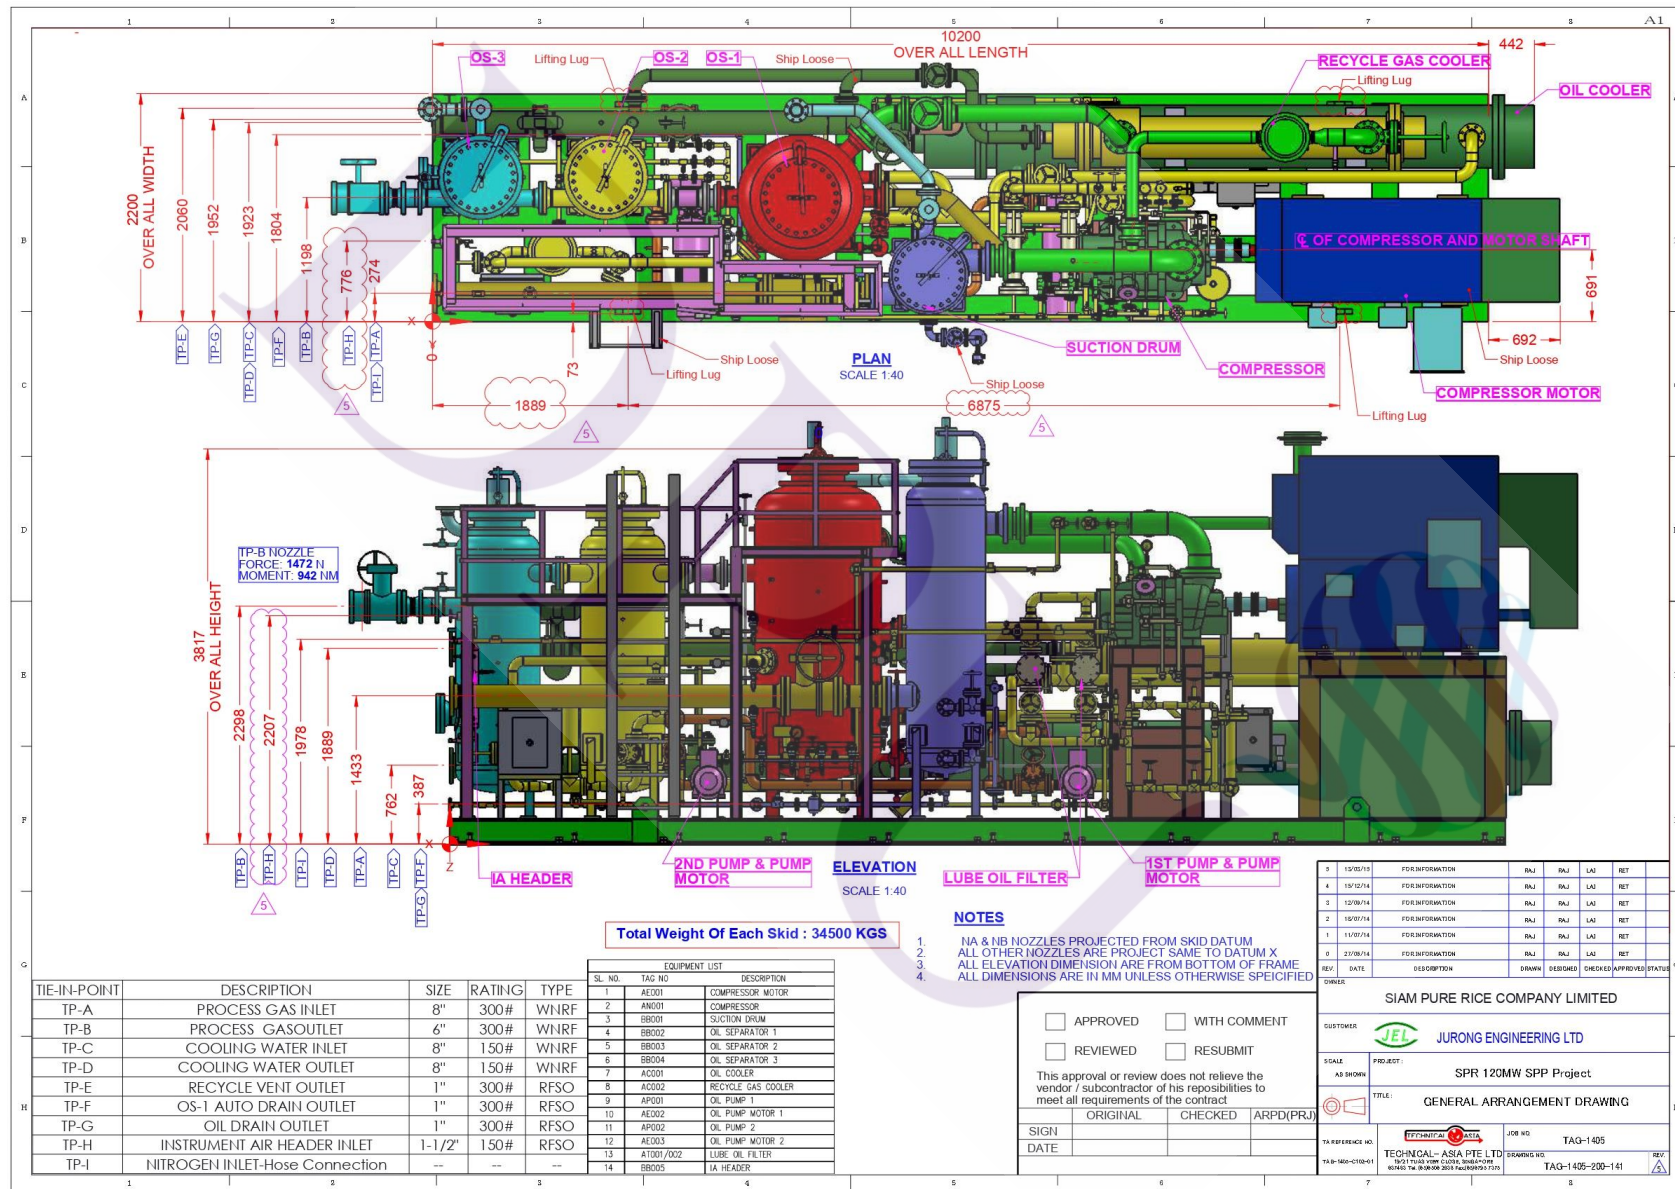

TIE-IN-POINT	DESCRIPTION	SIZE	RATING	TYPE
TP-A	PROCESS GAS INLET	8"	300#	WNRF
TP-B	PROCESS GAS OUTLET	6"	300#	WNRF
TP-C	COOLING WATER INLET	8"	150#	WNRF
TP-D	COOLING WATER OUTLET	8"	150#	WNRF
TP-E	RECYCLE VENT OUTLET	1"	300#	RFSO
TP-F	OS-1 AUTO DRAIN OUTLET	1"	300#	RFSO
TP-G	OIL DRAIN OUTLET	1"	300#	RFSO
TP-H	INSTRUMENT AIR HEADER INLET	1-1/2"	150#	RFSO
TP-I	NITROGEN INLET-Hose Connection	--	--	--


SL. NO.	TAG NO.	DESCRIPTION
1	AED01	COMPRESSOR MOTOR
2	AN001	COMPRESSOR
3	BB001	SUCTION DRUM
4	BB002	OIL SEPARATOR 1
5	BB003	OIL SEPARATOR 2
6	BB004	OIL SEPARATOR 3
7	AC001	OIL COOLER
8	AC002	RECYCLE GAS COOLER
9	AP001	OIL PUMP 1
10	AED02	OIL PUMP MOTOR 1
11	AP002	OIL PUMP 2
12	AED03	OIL PUMP MOTOR 2
13	AT001/002	LUBE OIL FILTER
14	BB005	IA HEADER

APPROVED WITH COMMENT

REVIEWED RESUBMIT

This approval or review does not relieve the vendor / subcontractor of his responsibilities to meet all requirements of the contract

SIGN	ORIGINAL	CHECKED	ARPD(PRJ)

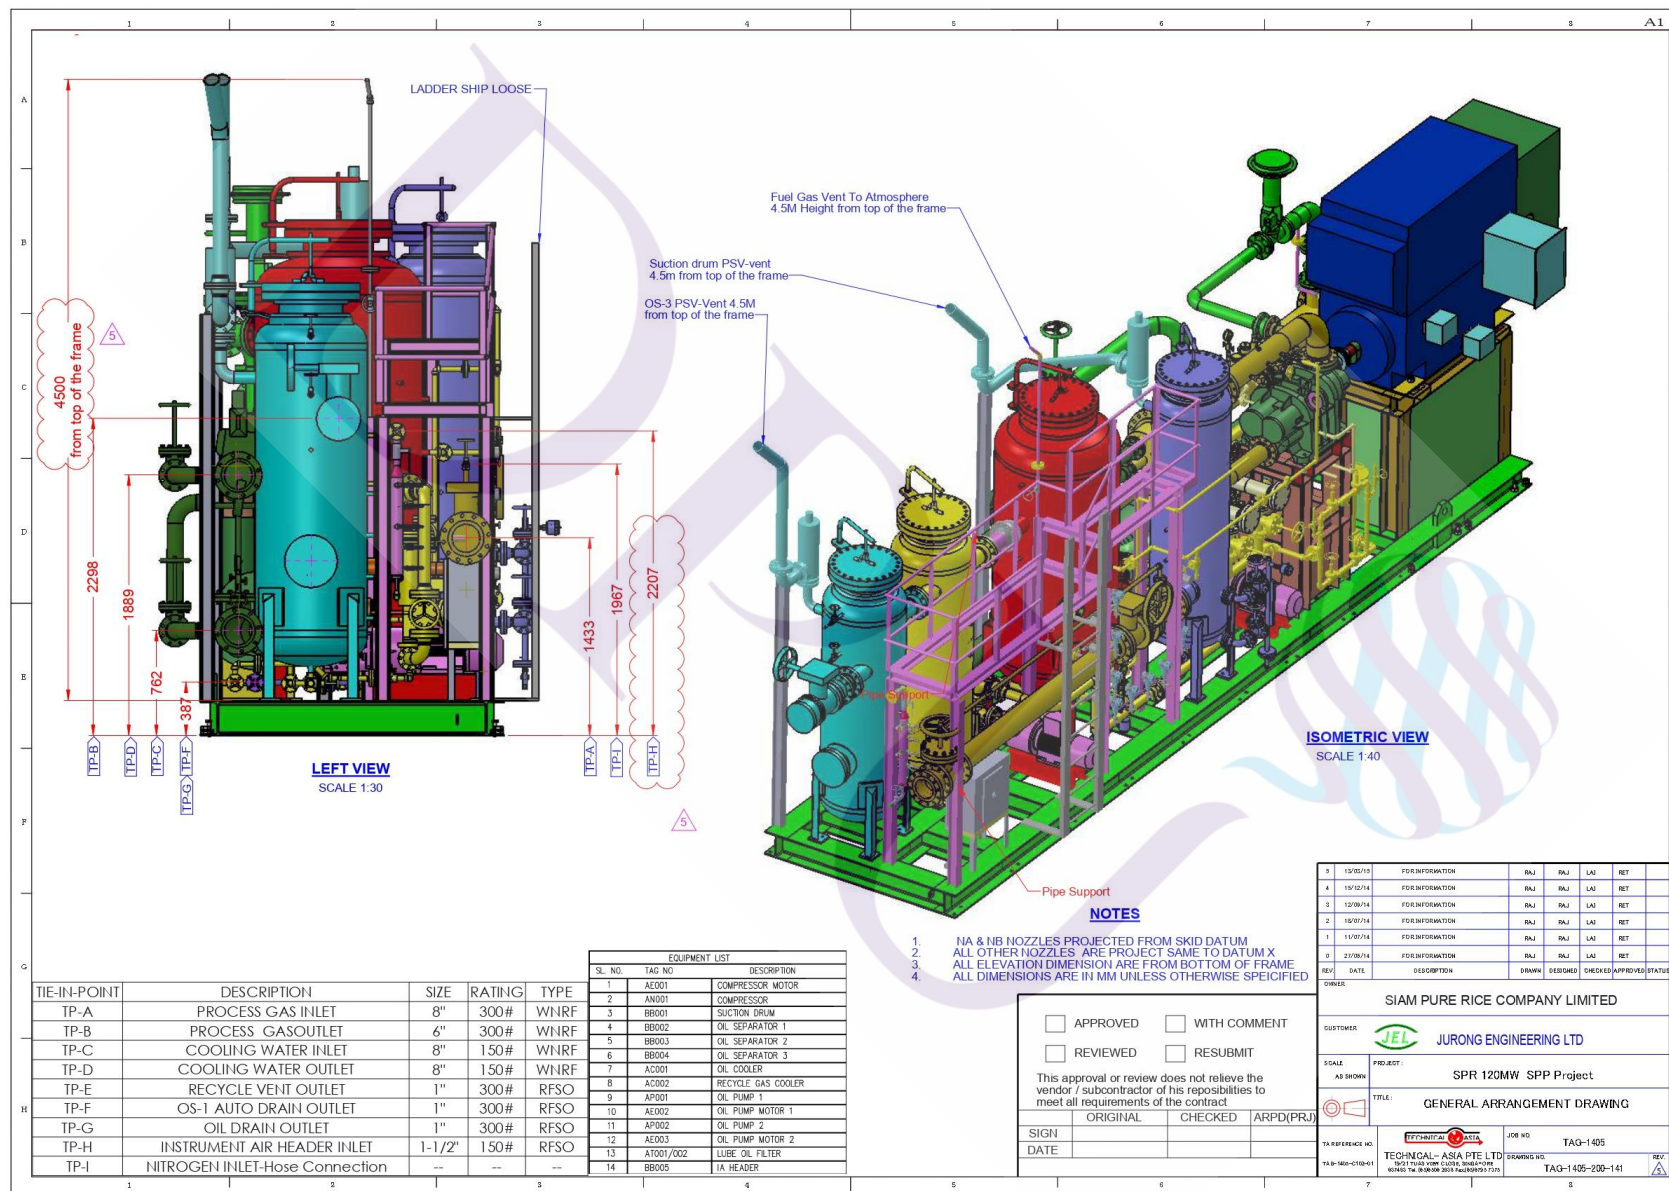

LEFT VIEW
SCALE 1:30

ISOMETRIC VIEW
SCALE 1:40

NOTES

1. NA & NB NOZZLES PROJECTED FROM SKID DATUM
2. ALL OTHER NOZZLES ARE PROJECT SAME TO DATUM X
3. ALL ELEVATION DIMENSION ARE FROM BOTTOM OF FRAME
4. ALL DIMENSIONS ARE IN MM UNLESS OTHERWISE SPECIFIED

SL. NO.	TAG NO.	DESCRIPTION
1	AE001	COMPRESSOR MOTOR
2	AN001	COMPRESSOR
3	BB001	SUCTION DRUM
4	BB002	OIL SEPARATOR 1
5	BB003	OIL SEPARATOR 2
6	BB004	OIL SEPARATOR 3
7	AC001	OIL COOLER
8	AC002	RECYCLE GAS COOLER
9	AP001	OIL PUMP 1
10	AE002	OIL PUMP MOTOR 1
11	AP002	OIL PUMP 2
12	AC003	OIL PUMP MOTOR 2
13	AT001/002	LUBE OIL FILTER
14	BB005	IA HEADER

TIE-IN-POINT	DESCRIPTION	SIZE	RATING	TYPE
TP-A	PROCESS GAS INLET	8"	300#	WNRF
TP-B	PROCESS GAS OUTLET	6"	300#	WNRF
TP-C	COOLING WATER INLET	8"	150#	WNRF
TP-D	COOLING WATER OUTLET	8"	150#	WNRF
TP-E	RECYCLE VENT OUTLET	1"	300#	RFSD
TP-F	OS-1 AUTO DRAIN OUTLET	1"	300#	RFSD
TP-G	OIL DRAIN OUTLET	1"	300#	RFSD
TP-H	INSTRUMENT AIR HEADER INLET	1-1/2"	150#	RFSD
TP-I	NITROGEN INLET-Hose Connection	--	--	--

APPROVED WITH COMMENT
 REVIEWED RESUBMIT

This approval or review does not relieve the vendor / subcontractor of his responsibilities to meet all requirements of the contract

SIGN	ORIGINAL	CHECKED	ARPD(PRJ)
DATE			

REV	DATE	DESCRIPTION	BY	CHKD	APPD	STATUS
5	15/01/15	FOR INFORMATION	RAJ	RAJ	LAI	RET
4	15/12/14	FOR INFORMATION	RAJ	RAJ	LAI	RET
3	12/09/14	FOR INFORMATION	RAJ	RAJ	LAI	RET
2	12/07/14	FOR INFORMATION	RAJ	RAJ	LAI	RET
1	11/07/14	FOR INFORMATION	RAJ	RAJ	LAI	RET
0	27/08/14	FOR INFORMATION	RAJ	RAJ	LAI	RET







OWNER: **SIAM PURE RICE COMPANY LIMITED**

CUSTOMER: **JEL JURONG ENGINEERING LTD**

SCALE: AS SHOWN PROJECT: **SPR 120MW SPP Project**

TITLE: **GENERAL ARRANGEMENT DRAWING**

TA REFERENCE NO: TECHNICAL ASIA PTE LTD JOB NO: TAG-1405
 TA-140-0100-01 10/21/14 11:53 AM C:\24_59643\0100 01/14/15 10:28:09 AM 2017/04/09/09:57:51m TAG-1405-200-141

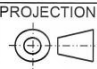0	17-DEC-14	Issued for Construction	-	RD	LAX/SKM	GPJ		C
A	27-AUG-14	Issued for Reference	-	RD	LAX/SKM	GPJ		R
REV.	DATE	DESCRIPTION	DRAWN	DESIGNED	CHECKED	APPROVED	STATUS	
JEL STAMP			OWNER'S APPROVAL STAMP					
		OWNER  SIAM PURE RICE COMPANY LIMITED 71 AGR Building, Charoen Rat Road, Bang Khlo, Bang Kho Laem, Bangkok 10120.						
SPR		OWNER'S ENGINEER  TRACTEBEL ENGINEERING LTD. Unit 1903-1905, 19 th Fl., Two Pacific Place Building, 142 Sukhumvit Road, Kwaeng Klongtoey, Khet Klongtoey, Bangkok 10110.						
TE								
TJEL								
PROJ		THE CONSORTIUM OF						
P&E		OFFSHORE CONSORTIUM MEMBER			ONSHORE CONSORTIUM MEMBER			
PIPING		 JURONG ENGINEERING LIMITED 25 Tanjong Kling Road, Singapore 628050.			 THAI JURONG ENGINEERING LIMITED 75/43 Ocean Tower 2, 22nd Floor, Sukhumvit 19, North Klongtoey, Wattana, Bangkok 10110.			
C&S								
T&V								
ELEC		OWNER CONTRACT NO.	PROJEC ^T SPR 120MW SPP PROJECT					
INST								
PROC		SCALE	PROJECTION	TITLE:				
				DATASHEET FOR GAS COMPRESSOR & AUXILIARIES				
		NTS		JOB NO.		JEL DRAWING NO.		
				20036		C515-001		
TOTAL		 Jurong Engineering Limited			PROJECT DRAWING NO.		REV. NO.	
DISTRIBUTION					SPR-10-EKG-DS-M4002		0	

JURONG ENGINEERING LIMITED

INDEX

Sl.No	Vendor Dwg/Doc. No	Rev	Vendor Drawing Title	Project Dwg No. / Rev	Remarks
1	TAG-1405-200-161	1	GAS COMPRESSOR PERFORMAN CE DATA	SPR-10-EKG-DS-M4002_Rev_A	Superseded
2	UHEX-GC-052	-	GAS COOLER DATA SHEET	SPR-10-EKG-DS-M4002_Rev_A	Superseded
3	UHEX-OC-053	-	OIL COOLER DATA SHEET	SPR-10-EKG-DS-M4002_Rev_A	Superseded
4	TMEIC (PAGE P11-P16)	1	MOTOR DATASHEET & CURVES	SPR-10-EKG-DS-M4002_Rev_A	Superseded
5	TAG-1405-200-161	1	GAS COMPRESSOR PERFORMAN CE DATA	SPR-10-EKG-DS-M4002_Rev_0	
6	UHEX-GC-052	7a	GAS COOLER DATA SHEET	SPR-10-EKG-DS-M4002_Rev_0	
7	UHEX-OC-053	9	OIL COOLER DATA SHEET	SPR-10-EKG-DS-M4002_Rev_0	
8	TMEIC (PAGE P11-P16)	1	MOTOR DATASHEET & CURVES	SPR-10-EKG-DS-M4002_Rev_0	
9	-	-	AA201 Vent Valve	SPR-10-EKG-DS-M4002_Rev_0	
10	-	-	AA-202 Recycle Valve	SPR-10-EKG-DS-M4002_Rev_0	
11	-	-	AA-203 Oil Pressure Control Valve	SPR-10-EKG-DS-M4002_Rev_0	
12	-	-	AA204 Water Shut Off Valve	SPR-10-EKG-DS-M4002_Rev_0	
13	-	-	AA-205 Injection Oil Control Valve	SPR-10-EKG-DS-M4002_Rev_0	
14	-	-	AA-206 Oil Return Shut Off Valve	SPR-10-EKG-DS-M4002_Rev_0	
15	-	-	AA301,302 PSV	SPR-10-EKG-DS-M4002_Rev_0	
16	-	-	AT001,002 Oil Filter Element	SPR-10-EKG-DS-M4002_Rev_0	
17	TAG-1405-200-181B	0	OS1 BB002 (1st stage oil seperator) GA	SPR-10-EKG-DS-M4002_Rev_0	
18	TAG-1405-200-181C	0	OS2 BB003(2nd stage oil seperator) GA	SPR-10-EKG-DS-M4002_Rev_0	
19	TAG-1405-200-181D	0	OS3 BB004(3nd stage oil seperator) GA	SPR-10-EKG-DS-M4002_Rev_0	
20	-	-	OS1,OS2 BB002, BB003 Coalesce Element	SPR-10-EKG-DS-M4002_Rev_0	
21	-	-	OS3 BB004 Coalesce Element	SPR-10-EKG-DS-M4002_Rev_0	
22	-	-	SD BB001 Suction Strainer	SPR-10-EKG-DS-M4002_Rev_0	
23			Lubrication list		

				
		Job No	TAG-1405	
For	SIAM PURE RICE			
Site	THAILAND	DocumentNo.	TAG-1405-200-161	
Service	WEST GAS	No. Required	3 X 50%	
Manufacturer	TA / GRASSO	Driver	Electric Motor	
Model	ZP-Y23H-52			
Case		Case 1	Case 2	Case 3
Theor. Swept Volume	[m3/h]	2398	2398	2398
Fixed VI		2.3	2.3	2.3
Speed	[1/min]	2950	2950	2950
Gas Description :				
Molecular Mass	[kg/mol]	20.854	20.854	20.854
Suction Pressure	[bar.G]	7.70	7.70	7.70
Discharge Pressure	[bar.G]	31.50	31.50	31.50
Pressure Ratio		3.74	3.74	3.74
Suction Temperature	[oC]	25.0	25.0	25.0
Slide Valve Position	[%]	98.5	96.5	78.1
Suction Volume Flow	[%]	91.0	86.0	64
Suction Volume Flow	[m3/h]	1909.5	1804.6	1343.0
Norm Volume Flow	[Nm3/h]	15024.5	14199	10566.7
Suction Mass Flow	[kg/h]	14274.2	13489.9	10039
Discharge Temperature	[oC]	100.0	100.0	100.0
Discharge Volume Flow	[m3/h]	639.7	604.6	449.9
Driving Power	[Kw]	1038.7	990.2	796
Functional Oil Flow	[l/min]	130.9	130.9	130.9
Injection Oil Flow	[l/min]	281.5	265.3	208.1
Total Oil Flow	[l/min]	412.5	396.2	339
Oil Inlet Temperature	[oC]	55.0	55.0	55.0

HEAT EXCHANGER SPECIFICATION SHEET						Page 1
						SI Units
Customer			Technical Asia Pte Ltd		Job No.	
Address					Reference No. UHEX-GC-052	
Plant Location					Proposal No. TAG-1405	
Service of Unit			GAS COOLER		Date	
Size			381x2996 mm		Rev. 7A	
Surf/Unit (Gross/Eff)			22.62 / 21.55 m ²		Item No.	
			Type BEM		Horz. Connected In	
			Shell/Unit 1		1 Parallel 1 Series	
			Surf/Shell (Gros 22.62 / 21.55 m ²)			
PERFORMANCE OF ONE UNIT						
Fluid Allocation		Shell Side			Tube Side	
Fluid Name		NATURAL GAS			COOLING WATER	
Fluid Quantity, Total		7,100.00			27,800.00	
Vapor (In/Out)		7,100.00				
Liquid					27,800.00	
Steam					27,800.00	
Water					27,800.00	
Noncondensables						
Temperature (In/Out)		105.00			38.00	
		60.00			45	
Specific Gravity		0.69			0.9956	
		0.0155			0.7644	
Viscosity		mN-s/m ²			0.0143	
Molecular Weight, Vapor		20.1				
Molecular Weight, Noncondensables						
Specific Heat		kJ/kg-C			4.1790	
		2.1500			4.1782	
Thermal Conductivity		W/m-C			0.6181	
		0.0430			0.6314	
Latent Heat		kJ/kg				
Inlet Pressure		BarA			32.00	
					2.50	
Velocity		m/s			1.75	
					1.05	
Pressure Drop, Allow/Calc		BarA			0.40	
					0.15	
Fouling Resistance (min)		m ² -K/W			0.000176	
					0.000176	
Heat Exchanged W		224,500			MTD (Corrected) 32.2 C	
Transfer Rate, Service		448.00 W/m ² -K			Clean 783.4 W/m ² -K Actual 536.6 W/m ² -K	
CONSTRUCTION OF ONE SHELL						
		Shell Side			Tube Side	
Design/Test Pressure		BarA			42 / 10 /	
Design Temperature		C			160.00 70.00	
No Passes per Shell		1			2	
Corrosion Allowance		mm			1.6 1	
Connections		In mm			1 @ 6" NB 1 @ 4" NB	
Size & Rating		Out mm			1 @ 8" NB 1 @ 4" NB	
		Intermediate			@ @	
Tube No.		120			OD 19.050 mm Thk. (Ave) 2.11 mm	
Tube Type		Plain			Length 3000 mm Pitch 25.4 mm Layout 30	
Shell SA106 B		ID 381 mm			Material SA 213M TP 304	
Channel or Bonnet		SA106 B			Shell Cover NA	
Tubesheet-Stationary		SA 516M GR. 485			Channel Cover SA234 WPB	
Floating Head Cover		NA			Tubesheet-Floating NA	
					Impingement Plate None	
Baffles-Cross		SA36 Type SINGLE-SEG.			%Cut (Diam) 29.5 Spacing 250 mm Inlet 360 mm	
Baffles-Long		NA			Seal Type NA	
Supports-Tube		NA			U-Bend Type NA	
Bypass Seal Arrangement		NA			Tube-Tubesheet Joint Strength Weld	
Expansion Joint		NA			Type NA	
Rho-V2-Inlet Nozzle		NA			Bundle Entrance Bundle Exit kg/m-s ²	
Gaskets-Shell Side		NA			Tube Side Comprofile	
-Floating Head		NA				
Code Requirements					TEMA Class R	
Weight/Shell		Filled with water			Bundle kg	
Remarks: 1) AMSE "U" Stamped.						
2) Approximate 12% overdesigned.						
2) Recycled Gas flow required is 5000 kg/hr. However cooler is designed to bypass 100% of gas flow at 14170 kg/hr.						

HEAT EXCHANGER SPECIFICATION SHEET						Page 1		
						SI Units		
Customer	TECHNICAL ASIA		Job No.	TAG-1405				
Address			Reference No.					
Plant Location			Proposal No.	UHEX-HEX-063				
Service of Unit	OIL COOLER		Date	Rev. 9				
Size	584.2x5000 mm		Item No.					
Surf/Unit (Gross/Eff)	141.39 / 134.65 m ²		Type	BEM	Horz.	Connected In	1 Parallel	1 Series
			Shell/Unit	1		Surf/Shell (Gros	141.39 / 134.65 m ²	
PERFORMANCE OF ONE UNIT								
Fluid Allocation			Shell Side			Tube Side		
Fluid Name			ISO VG 68 (Turbine Oil)			COOLING WATER		
Fluid Quantity, Total			kg/hr			30,500.00		
Vapor (In/Out)						118,710.00		
Liquid			30,500.00			30,500.00		
Steam						118,710.00		
Water						118,710.00		
Noncondensables								
Temperature (In/Out)			C			105.00		
Specific Gravity			0.8594			0.8782		
Viscosity			mN-s/m ²			8.3490		
Molecular Weight, Vapor								
Molecular Weight, Noncondensables								
Specific Heat			kJ/kg-C			2.0070		
Thermal Conductivity			W/m-C			0.1303		
Latent Heat			kJ/kg					
Inlet Pressure			BarG			31.00		
Velocity			m/s			1.2		
Pressure Drop, Allow/Calc			BarG			0.3		
Fouling Resistance (min)			m ² -K/W			0.000172		
Heat Exchanged W			962,500			MTD (Corrected)		
Transfer Rate, Service			222.00 W/m ² -K			Clean		
						337 W/m ² -K		
						Actual		
						322.5 W/m ² -K		
CONSTRUCTION OF ONE SHELL						Sketch (Bundle/Nozzle Orientation)		
Design/Test Pressure			BarG			41 / 10 /		
Design Temperature			C			130.00		
No Passes per Shell			1			2		
Corrosion Allowance			mm			1		
Connections			In mm			1 @ 4" NB		
Size & Rating			Out mm			1 @ 4" NB		
			Intermediate			@		
Tube No.			432 OD 19.05 mm			Thk. (Min.) 2.11 m		
Tube Type			Low Fin			Length 5000 mm		
Shell SA 516M Gr. 485			ID 584.2 mm			Pitch 23.8 mm		
Channel or Bonnet			SA 516M Gr. 485			Material SA213M TP 304		
Tubesheet-Stationary			SA 516M Gr. 485			Shell Cover NA		
Floating Head Cover			NA			Channel Cover		
Baffles-Cross			SA36 Type SINGLE-SEG.			%Cut (Diam) 25.5		
Baffles-Long			NA			Seal Type		
Supports-Tube			NA			U-Bend Type		
Bypass Seal Arrangement			NA			Tube-Tubesheet Joint		
Expansion Joint			NA			Type		
Rho-V2-Inlet Nozzle			NA			Bundle Entrance		
Gaskets-Shell Side			NA			Bundle Exit		
-Floating Head			NA			Tube Side		
Code Requirements						TEMA Class R		
Weight/Shell			Filled with Water			Bundle kg		
Remarks: 1) ASME "U" stamped								

6

1, MOTOR PERFORMANCE DATA

MOTOR DATA SHEETS

Item 10EKH21-AE001 / 10EKH22-AE001 / 10EKH23-AE001







Manufacturer	TMEIC
Mark or Item No.	
Quantity	3
Model/Size	ICFT-CHNWXN11
Frame No.	450-1400
Kilowatt, KW (at each speed)	1200kW
Rated Voltage, V	6600V
Thermal Reserve Margin (°C)	25 deg.C
Enclosure type	TEAAC, IP55
Type: Single Speed	Yes (Single speed)
Two Speed Single Winding	-
Other	-
Full Load Speed, RPM	2965 RPM
Full Load Current, AMP	120 A
Locked Rotor Current, AMP	720 A
Space Htrs., Watts (If Specified)	110 W
Net Weight , Kg	7400 kg
Full Load Torque in Nm	3863 Nm
Mounting Arrangement	IBM3
Description of Insulation System	VPI System
Insulation Class (B,F,H)	F
Temperature Rise (B,F) at (without thermal reserve)	B
Bearing Type	Sleeve
P.F Full Load	0.925
Eff. Full Load, %	95.2
Locked Rotor AMP	720 A
Thrust-Vertical Motors:	
Load Thrust Requirement (Kg)	None
Motor Thrust Bearing Rating (Kg)	None

(7)

TMEiC
We drive industry

P-12

	<u>Startup</u>	<u>50%Load</u>	<u>75%Load</u>	<u>100%Load</u>
Efficiency		93.6%	94.8%	95.2%
Power Factor	14.7%	89.9%	92.1 %	92.5%
Starting Torque, % FL				70%
Breakdown Torque, % FL				220%
Permissible Starts Per Hr With:				
Motor At Ambient Temp.				3 times
Motor At Rated Total Temp.				2 times
Description of Insulation System				VPI System
Full Load Temp. Rise				90deg.C by RTD
Insulation class (B,F,H)				F
Accel. Time, Fully Loaded				
With 100% V, Sec.				5 sec.
With 80% V, Sec.				12 sec.
With 0% V, Sec.				-
Safe Stall Time at 100% Voltage, Sec.				10/17 sec. (H / C)
$\frac{GD^2}{4}$ of Rotor , kg-m ²				27.7kgm2
Sound Level, DB				85 dB(A) at no load
Areae classification (IEC)				 Class 1,Zone 2,Group A, T3
Paint color (Munsell)				 2.5PB 6/2
Direction of rotation (Viewed from DE)				 CCW
Ambient temperature				 15 to 40deg.C


**ELECTRICAL PERFORMANCE DATA
 (DESIGN VALUE)**

TMEIC ORDER NO. : TR30078VMD100

No.	Item	Item No.	1	2	3	4	Remarks
1	Motor No.	-					
2	Quantity	unit(s)	3	1			
3	Type-Form	-	ICPT CFMXXNLL				
4	Number of poles	-	2				
5	Rated output	kW	1,200				
6	Rated voltage	V	6,600				
7	Rated frequency	Hz	50				
8	Insulation class	-	F				
9	Temperature rise	deg.C	90				By RTD
10	Frame size	-	450-1400				
11	Rated speed	rpm	2,965				
12	Rated current	A	120				
13	Locked rotor current	%	600				Guaranteed Value (with tolerance)
14	Efficiency	at 100% Load	%	95.2			Design value by IEC 60034 Equivalent circuit
		at 75% Load	%	94.8			
		at 50% Load	%	93.6			
15	Power factor	at 100% Load	%	92.5			Design value by IEC 60034 Equivalent circuit
		at 75% Load	%	92.1			
		at 50% Load	%	89.9			
16	Locked rotor torque	%	70				
17	Pull-up torque	%	70				
18	Breakdown torque	%	220				
19	Rotor GD2	kgm2	111				
20	Sound pressure level	dB(A)	85				Guaranteed at no-load from 1m (Average of 4 key points)
21	Safe stall time (Hot / Cold)	s	10 / 17				
22	Remarks						

[Note] This datasheet shows
 1) design value. (not guaranteed).
 2) data for sine wave power.

E140427-A

Approved	H.Ogawa	2014/7/24
Reviewed	H.Ogawa	2014/7/24
Prepared	K.Yamaguchi	2014/7/24

9




2, MOTOR CURVES

e-design 005 Ver.03

STARTING CHARACTERISTIC CURVE

Order No.	7R30078MM0100				
Type	ICFT	Form	CHNWXN11	Ins.Class	F
Pole	2	Voltage[V]	6600	Rating	S1
Output(kW)	1200	Frequency[Hz]	50	Frame No.	450-1400
Rated Speed [min ⁻¹]	2965	J _M (=GD ² /4) (kgm ²)	27.75	J _L (=GD ² /4) (kgm ²)	0.47

Starting Time (sec) at 100%V 5 at 80%V 12 Rated Current : 120 (A)

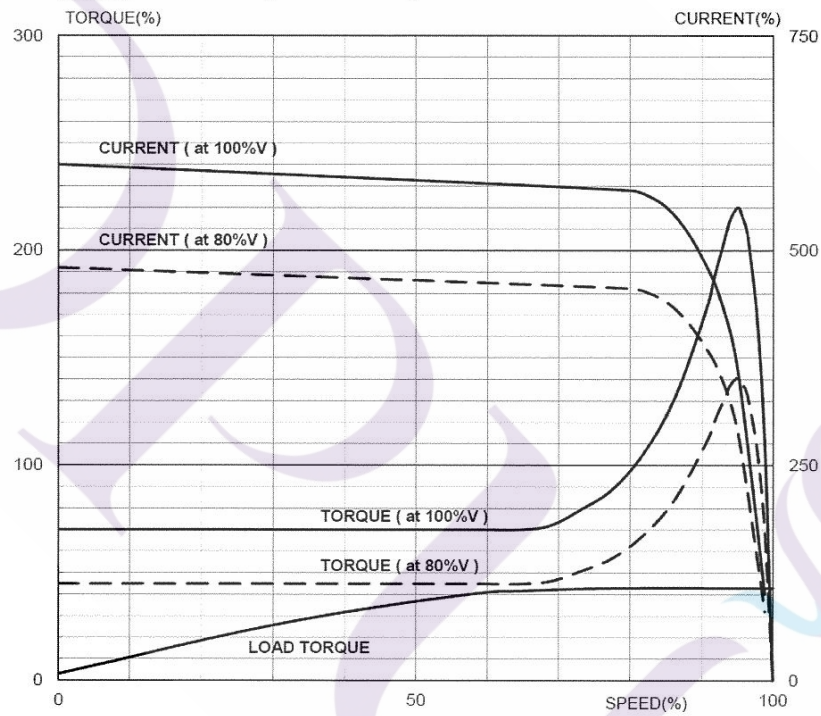

DESIGN VALUE (NOT GUARANTEED)

E140428-A		
Approved	H.Ogawa	2014/7/26
Reviewed	H.Ogawa	2014/7/26
Prepared	K.Yamaguchi	2014/7/26



10



P-15


e-design 005 Ver.03

THERMAL CAPABILITY CURVE

Order No.	7R30078MM0100				
Type	ICFT	Form	CHNWXN11	Ins.Class	F
Pole	2	Voltage[V]	6600	Rating	S1
Output(kW)	1200	Frequency[Hz]	50	Frame No.	450-1400

ALLOWABLE TIME(sec)

Rated Current : 120 (A)

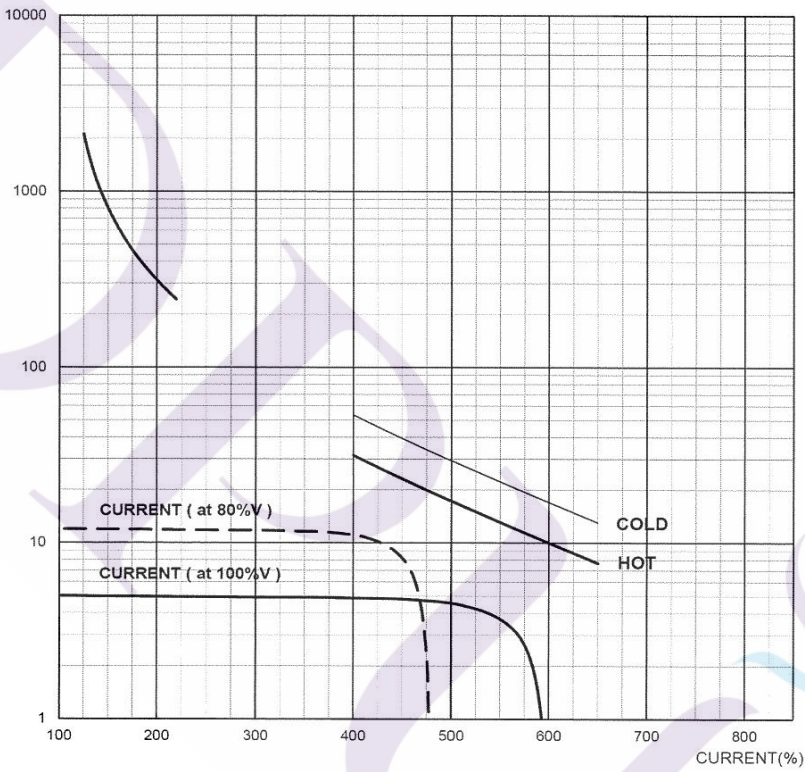

DESIGN VALUE (NOT GUARANTEED)

E140429-A		
Approved	H.Ogawa	2014/7/26
Reviewed	H.Ogawa	2014/7/26
Prepared	K.Yamaguchi	2014/7/26




TOSHIBA MITSUBISHI-ELECTRIC INDUSTRIAL SYSTEMS CORPORATION

LOAD vs EFFICIENCY AND POWER FACTOR CURVE



Type	ICFT	Form	CHNWXN11	Ins.Class	F
Pole	2	Voltage[V]	6600	Rating	S1
Output[kW]	1200	Frequency[Hz]	50	Frame No.	450-1400

Rated Current : 120 (A)

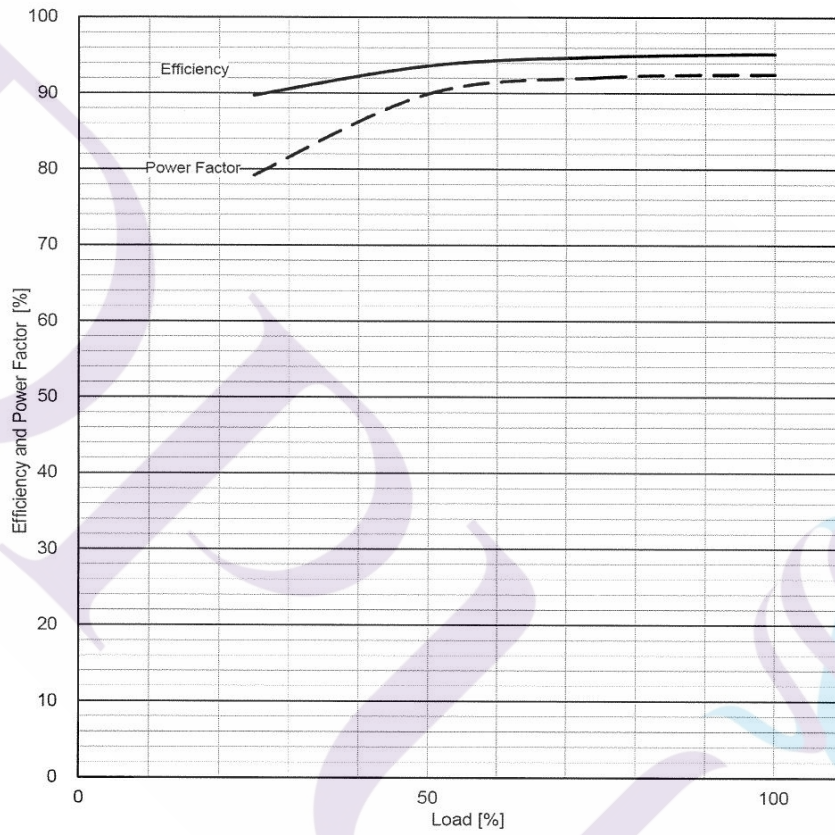

DESIGN VALUE (NOT GUARANTEED)

E140430-A		
Approved	H.Ogawa	2014/7/24
Reviewed	H.Ogawa	2014/7/24
Prepared	K.Yamaguchi	2014/7/24

AA201 Vent Valve

		DATA SHEET - PNEUMATIC ON-OFF VALVE							
JOB NO : TAG-1405		PAGE 1 OF 1	REV. 0	DATE	DESCRIPTION	PREPD	CHKD	REVD	APPVD
PROJECT : Siam Pure Rice									
CLIENT : Siam Pure Rice									
LOCATION : Chaoyo, Ang Thong, Thailand									
SERVICE	1 Tag No.	10EKH21-AA201	10EKH22-AA201	10EKH23-AA201					
	2 Service	Vent Valve	Vent Valve	Vent Valve					
	3 Line Spec								
	4 Line Size / Sched. No.	1" / Sch 80	1" / Sch 80	1" / Sch 80					
VALVE	5 Type of Body	2-WAY BALL VALVE	2-WAY BALL VALVE	2-WAY BALL VALVE					
	6 Body size	1" 1"	1" 1"	1" 1"					
	7 End Connection & Rating	Socket-weld	Socket-weld	Socket-weld					
	8 Bonnet Type								
	9 Characteristic								
	10 Body	Carbon Steel	Carbon Steel	Carbon Steel					
	11 Ball / Disc	SS316	SS316	SS316					
	12 Material	Seat RPTFE	Seat RPTFE	Seat RPTFE					
	13 Shaft	SS316	SS316	SS316					
	14 Packing	CPTFE	CPTFE	CPTFE					
ACTUATOR	15 Leakage Class								
	16 Model No.	AT201U SR	AT201U SR	AT201U SR					
	17 Type of Actuator	Spring return	Spring return	Spring return					
	18 Supply to Air Con'n	G1/8"	G1/8"	G1/8"					
	19 Close at	Open at							
SOLENOID VALVE	20 Torque								
	21 Fail Position	Open	Open	Open					
	22 MFR. & Model No.	Airtec / KN-05	Airtec / KN-05	Airtec / KN-05					
	23 Con.Conn. Size	G1/4"	G1/4"	G1/4"					
	24 Power Supply	24VDC	24VDC	24VDC					
LIMIT SWITCH BOX	25 Enclosure	II 2G EEx m IIC T5	II 2G EEx m IIC T5	II 2G EEx m IIC T5					
	26 Port								
	27 MFR. & Model No.	Rotech / TCR	Rotech / TCR	Rotech / TCR					
	28 Conduit Size								
HAND WHEEL	29 Switch Type	microswitch	microswitch	microswitch					
	30 Enclosure	EEx ed IIC T6	EEx ed IIC T6	EEx ed IIC T6					
	31 Bracket	YES	YES	YES					
AIR FILTER REGULATOR	32 MFR. & Model No.	-	-	-					
	33 Reduction Ratio	-	-	-					
SPEED CONTROL	34 MFR. & Model No.	-	-	-					
	35 Air Supply Pressure	-	-	-					
ELECTRO POSITIONEF	36 MFR. & Model No.	-	-	-					
	37 Type	-	-	-					
OPERATING CONDITION	38 MFR. & Model No.	-	-	-					
	39 Type	-	-	-					
	40 Nor. Inlet Pressure (Barg)	31.0							
	41 Max. Working pressure	31.0							
	42 Temp. Max. (°C)	Operating (°C) 105 90							
	43 Oper. Sp. Gr (Kg/m3)	Mol Wt. 0.6064							
OTHERS	44 Oper. Visc. (CP)	%Flash							
	45 Fluid(Phase)	Gas							
	46 Design Spec (Face to Face)								
47									
48 Manufacturer									
49 Model No.									
50 Q'ty									
Notes :									

AA-202 Recycle Valve



Sliding Stem Valve Specification

Customer: TECHNICAL ASIA PTE LTD Singapore Sales
 Contact: Desmond Kok
 Customer Reference: TAG-1405, Control Valve Sales Office Reference: Lead Time:
 Inquiry Item: 1 Rev: Qty: 3 Quote: 77E-RR-140826-0014654 / SQ-14207PJ Rev: 03 (Won 077-064539)
 Tags: 10EKH21-AA-202,10EKH22-AA-202,10EKH23-AA-202 Date Last Modified: 24/10/2014
 Description: NPS 4 ET Origin Cert PL Special Charges 657 Size 45 DVC6200 SS VBL 67DF Series Acc Process Level 3

Service Description: Recycle Control Valve		Positioner Type: DVC6200,HART Communicating-HC
Service:		Input Signal: 4 to 20 mA dc
Size and Type: NPS 4 ET		Access: None
Body Style: Globe		Gauges: 0-60 psig/0-4 bar
Design Temp: 80 deg C		Action: Single/Direct
Design Press: 40 barg		Certification: ATEX
End Connect/In/Out: CL300/RF Flg/RF Flg		Controller Type:
Material: WCC Steel		Action:
Ports: 1		Measure Element:
Flow Directn: Up		Range:
Trim Number: 27		Output:
Cage Matl: CF8M SST/ENC		Mounting:
Retainer Matl:		Airset:
Bushing Matl:		Mounting:
Seat Ring Matl: CoCr-A Seat		Transducer:
VALVE PLUG		Input Signal:
Material: S31600 SST/CoCr-A Seat/Guide		Output Signal:
Guiding: Cage		Action:
Balance: Balanced		Mounting:
Shutoff Class: ANSI CL IV		Airset:
Port Size: 3 7/16 Inch		Certifications:
Characteristic: Whisper III (Linear)		Line In: 6 in, SCH STD
Stem Material: 316SST		Line Out: 6 in, SCH STD
Stem Size: 1/2 Inch		Insulation:
Bonnet Style: Plain		Service Cond: Fuel gas
Boss Size: 2 13/16		Process Fluid:
Packing: Single PTFE		Critical Pressure:
Access: No		Shutoff Drop: 580.151 psi
Bolt, Bonnet: SA-193-B7 Studs/2H Nuts		
PackFlg/Bltg: SST Pkg Flg, SST Studs & Nuts		
Actuator: Spring & Diaphragm		Max Rated Cv: 89
Type/Size: 657/45		
Travel: 2 Inch		
Bench Set: 6-30 psi		
Push Down To: PDTC		
Supply: Air		
To Actuator: 0 to 33 psig		
Fails Valve: Open		
Handwheel: None		

Variable Name	Unit	Max-1	Max-2	Alt Max-1	Alt Max-2
Mass flow rate (w)	kg/h	14170.0000	14170.0000	14170.0000	14170.0000
Inlet Pressure (P1)	bar(g)	30.49960	30.49960	30.50000	30.50000
Outlet Pressure (P2)	bar(g)	7.69960	7.69960	21.00000	21.00000
Temperature (T1)	deg C	60.0000	60.0000	60.0000	60.0000
M / Gg	SG	0.60600	0.73000	0.60600	0.73000
Specific heats ratio (gamma)		1.400	1.400	1.400	1.400
Dynamic Viscosity (Mu)	cP	1.000	1.000	1.000	1.000
Sizing Coefficient (Cv)		41.265	37.586	45.897	41.802
% Open		61	42	37	55
Valve LpA(LpAeValve1m)	dB(A)	83	83	73	72

NOTES:

AA-203 Oil Pressure Control Valve



Sliding Stem Valve Specification

Customer: TECHNICAL ASIA PTE LTD Contact: Customer Reference: TAG-1405, Control Valve Inquiry Item: 2 Rev: Qty: 3 Tags: 10EKH21-AA-203,10EKH22-AA-203,10EKH23-AA-203 Description: NPS 2 EZ Origin Cert PL 667 Size 46 DVC6200 SS 67CF Series Acc Process Level 3	Singapore Sales Contact: Desmond Kok Sales Office Reference: Lead Time: Quote: 77E-RR-140826-0014654 / SQ-14207PJ Rev: 03 (Won 077-064539) Date Last Modified: 24/10/2014
Service Description: Oil Differential Pressure Control Valve	

Service: Size and Type: NPS 2 EZ Body Style: Globe Design Temp: 80 deg C Design Press: 40 bar(g) End Connect/In/Out: CL300/RF Flg/RF Flg Material: WCC Steel Ports: 1 Flow Directn: Up Trim Number: 127 Cage Matl: CF8M SST Retainer Matl: R30006 Cobalt Alloy Bushing Matl: S31600 SST/CoCr-A Seat Seat Ring Matl: VALVE PLUG Material: S31600 SST/CoCr-A Seat/Guide Guiding: Post Balance: Unbalanced Shutoff Class: ANSI CL IV Port Size: 2 Inch Characteristic: Equal Percent Stem Material: 316SST Stem Size: 1/2 Inch Bonnet Style: Plain Boss Size: 2 13/16 Packing: Single PTFE Access: No Bolt, Bonnet: SA-193-B7 Studs/2H Nuts PackFlg/Bltg: SST Pkg Flg, SST Studs & Nuts Actuator: Spring & Diaphragm Type/Size: 667/46 Travel: 1 1/8 Inch Bench Set: 15-30 psi Push Down To: PDTC Supply: Air To Actuator: 0 to 33 psig Fails Valve: Close Handwheel: None	Positioner Type: DVC6200,HART Communicating-HC Input Signal: 4 to 20 mA dc Access: None Gauges: 0-60 psig/0-4 bar Action: Single/Direct Certification: ATEX Controller Type: Action: Measure Element: Range: Output: Mounting: Airset: Mounting: Transducer: Input Signal: Output Signal: Action: Mounting: Airset: Certifications: Line In: 3 in, SCH STD Line Out: 3 in, SCH STD Insulation: Service Cond: Process Fluid: Lube Oil Critical Pressure: 221.00000 bar(a) Shutoff Drop: 40.00 bar Max Rated Cv: 53.8
---	---

Variable Name	Unit	Maximum			
Liquid Flow Rate (Ql)	l/m	460.000			
Inlet Pressure (P1)	bar(g)	33.99960			
Outlet Pressure (P2)	bar(g)	30.99960			
Temperature (T1)	deg C	60.0000			
SG		0.600			
Dynamic Viscosity (Mu)	cP	1.000			
Vapor Pressure (Pv)	bar(a)	0.10000			
Sizing Coefficient (Cv)		14.321			
% Open		53			
Valve Lpa (LpAe1m)	dB(A)	< 50			

NOTES:

AA204 Water Shut Off Valve


		DATA SHEET - PNEUMATIC ON-OFF VALVE							
JOB NO : TAG-1405		PAGE 1 OF 1	REV.	DATE	DESCRIPTION	PREPD	CHKD	REVD	APPVD
PROJECT : Siam Pure Rice			0						
CLIENT : Siam Pure Rice									
LOCATION : Chaayo, Ang Thong, Thailand									
SERVICE	1 Tag No.		10EKH21-AA204	10EKH22-AA204	10EKH23-AA204				
	2 Service		Water Shut Off Valve	Water Shut Off Valve	Water Shut Off Valve				
	3 Line Spec								
	4 Line Size / Sched. No.		8" / Sch 40	8" / Sch 40	8" / Sch 40				
VALVE	5 Type of Body		Wafer						
	6 Body size	Port Size	8"	8"	8"	8"	8"	8"	
	7 End Connection & Rating		For ANSI 150# flanges		For ANSI 150# flanges	For ANSI 150# flanges			
	8 Bonnet Type								
	9 Characteristic								
	10	Body		SS316	SS316	SS316			
	11	Ball / Disc		SS316	SS316	SS316			
	12 Material	Seat		Buna	Buna	Buna			
	13	Shaft		SS430	SS430	SS430			
	14	Packing		Buna	Buna	Buna			
15 Leakage Class									
ACTUATOR	16 Model No.		AT501U SR	AT501U SR	AT501U SR				
	17 Type of Actuator		Spring return	Spring return	Spring return				
	18 Supply to Air Con'n		G1/4"	G1/4"	G1/4"				
	19 Close at	Open at							
20 Torque									
21 Fail Position			Open	Open	Open				
SOLENOID VALVE	22 MFR. & Model No.		Airtec / KN-05	Airtec / KN-05	Airtec / KN-05				
	23 Con.Conn. Size		G1/4"	G1/4"	G1/4"				
	24 Power Supply		24VDC	24VDC	24VDC				
	25 Enclosure		II 2G EEx m IIC T5	II 2G EEx m IIC T5	II 2G EEx m IIC T5				
26 Port									
LIMIT SWITCH BOX	27 MFR. & Model No.		Rotech / TCR	Rotech / TCR	Rotech / TCR				
	28 Conduit Size								
	29 Switch Type		microswitch		microswitch				
30 Enclosure		EEx ed IIC T6		EEx ed IIC T6					
31 Bracket		YES		YES					
HAND WHEEL	32 MFR. & Model No.		-						
33 Reduction Ratio			-						
AIR FILTER REGULATOR	34 MFR. & Model No.								
35 Air Supply Pressure									
SPEED CONTROL	36 MFR. & Model No.								
37 Type									
ELECTRO POSITIONEF	38 MFR. & Model No.								
39 Type									
OPERATING CONDITION	40 Nor. Inlet Pressure (Barg)		2.0						
	41 Max. Working pressure		5.0						
	42 Temp. Max. (°C)	Operating (°C)	55	45					
	43 Oper. Sp. Gr (Kg/m3)	Mol Wt.	1.0						
	44 Oper. Visc. (CP)	%Flash							
	45 Fluid(Phase)		Cooling Water, Liquid						
46 Design Spec (Face to Face)									
OTHERS	47								
	48 Manufacturer								
	49 Model No.								
50 Q'ty									
Notes :									

FISHER		Sliding Stem Valve Specification		AA-205 Injection Oil Control Valve	
Customer: TECHNICAL ASIA PTE LTD		Singapore Sales			
Contact:		Contact: Desmond Kok			
Customer Reference: TAG-1405, Control Valve		Sales Office Reference:		Lead Time:	
Inquiry		Quote: 77E-RR-140826-0014654 / SQ-14207PJ		Rev: 03 (Won 077-064539)	
Item: 3	Rev:	Qty: 3	Date Last Modified: 24/10/2014		
Tags: 10EKH21-AA-205,10EKH22-AA-205,10EKH23-AA-205					
Description: NPS 1 1/2 EZ Origin Cert PL 667 Size 34 DVC6200 SS 67CF Series Acc Process Level 3					
Service Description: Turbine Oil VG 68					
Service:			Positioner Type: DVC6200,HART Communicating-HC		
Size and Type: NPS 1 1/2 EZ			Input Signal: 4 to 20 mA dc		
Body Style: Globe			Access: None		
Design Temp: 60 deg C			Gauges: 0-60 psig/0-4 bar		
Design Press: 34 bar(g)			Action: Single/Direct		
End Connect/In/Out: CL300/RF Flg/RF Flg			Certification: ATEX		
Material: WCC Steel			Controller Type:		
Ports: 1			Action:		
Flow Directn: Up			Measure Element:		
Trim Number: 127			Range:		
Cage Matl: CF8M SST			Output:		
Retainer Matl: R30006 Cobalt Alloy			Mounting:		
Bushing Matl: S31600 SST/CoCr-A Seat			Airset:		
Seat Ring Matl: S31600 SST/CoCr-A Seat			Mounting:		
VALVE PLUG			Transducer:		
Material: S31600 SST/CoCr-A Seat/Guide			Input Signal:		
Guiding: Post			Output Signal:		
Balance: Unbalanced			Action:		
Shutoff Class: ANSI CL IV			Mounting:		
Port Size: 1 1/2 Inch			Airset:		
Characteristic: Linear			Certifications:		
Stem Material: S31600 SST			Line In: 1.5 in, SCH STD		
Stem Size: 3/8 Inch			Line Out: 1.5 in, SCH STD		
Bonnet Style: Plain			Insulation:		
Boss Size: 2 1/8			Service Cond: Turbine Oil		
Packing: Single PTFE			Process Fluid: 221.00000 bar(a)		
Access: No			Critical Pressure: 493.128 psi		
Bolt, Bonnet: SA-193-B7 Studs/2H Nuts			Shutoff Drop:		
PackFlg/Bltg: SST Pkg Flg, SST Studs & Nuts			Max Rated Cv: 31.9		
Actuator: Spring & Diaphragm					
Type/Size: 667/34					
Travel: 3/4 Inch					
Bench Set: 16-30 psi					
Push Down To: PDTC					
Supply: Air					
To Actuator: 0 to 33 psig					
Fails Valve: Close					
Handwheel: None					
Variable Name		Unit	At 90% Flow		
Liquid Flow Rate (Ql)		l/m	636.097		
Inlet Pressure (P1)		bar(g)	34.00000		
Outlet Pressure (P2)		bar(g)	32.00000		
Temperature (T1)		deg C	60.0000		
SG			1.000		
Kinematic Viscosity (Nu)		cSt	1.000		
Vapor Pressure (Pv)		bar(a)	0.10000		
Sizing Coefficient (Cv)			31.200		
% Open			90.00		
Valve Lpa (LpAe1m)		dB(A)	< 50		
NOTES:					

AA-206 Oil Return Shut Off Valve

		DATA SHEET - PNEUMATIC ON-OFF VALVE								
JOB NO : TAG-1405		PAGE 1 OF 1		REV	DATE	DESCRIPTION	PREPD	CHKD	REVD	APPVD
PROJECT : Siam Pure Rice				0						
CLIENT : Siam Pure Rice										
LOCATION : Chaayo, Ang Thong, Thailand										
SERVICE	1 Tag No.	10EKH21-AA206		10EKH22-AA206		10EKH23-AA206				
	2 Service	Oil Return Shut Off Valve		Oil Return Shut Off Valve		Oil Return Shut Off Valve				
	3 Line Spec									
	4 Line Size / Sched. No.	1" / Sch 80		1" / Sch 80		1" / Sch 80				
VALVE	5 Type of Body	2-WAY BALL VALVE		2-WAY BALL VALVE		2-WAY BALL VALVE				
	6 Body size	Port Size	1"	1"	1"	1"	1"	1"		
	7 End Connection & Rating	Socket-weld		Socket-weld		Socket-weld				
	8 Bonnet Type									
	9 Characteristic									
	10 Body	Carbon Steel		Carbon Steel		Carbon Steel				
	11 Ball / Disc	SS316		SS316		SS316				
	12 Material	Seat	RPTFE		RPTFE		RPTFE			
	13 Shaft	SS316		SS316		SS316				
	14 Packing	CPTFE		CPTFE		CPTFE				
15 Leakage Class										
ACTUATOR	16 Model No.	PS Auto / PSR25		PS Auto / PSR25		PS Auto / PSR25				
	17 Type of Actuator	Electric		Electric		Electric				
	18 Supply to Air Con'n									
	19 Close at	Open at								
SOLENOID VALVE	20 Torque	25Nm		25Nm		25Nm				
	21 Fail Position	Last		Last		Last				
	22 MFR. & Model No.	NA		NA		NA				
	23 Con.Conn. Size									
LIMIT SWITCH BOX	24 Power Supply									
	25 Enclosure									
	26 Port									
	27 MFR. & Model No.	Build-in		Build-in		Build-in				
HAND WHEEL	28 Conduit Size									
	29 Switch Type									
	30 Enclosure									
	31 Bracket									
AIR FILTER REGULATOR	32 MFR. & Model No.									
	33 Reduction Ratio									
	34 MFR. & Model No.									
	35 Air Supply Pressure									
SPEED CONTROL	36 MFR. & Model No.									
	37 Type									
	38 MFR. & Model No.									
	39 Type									
ELECTRO POSITIONER	40 Nor. Inlet Pressure (Barg)	31.0								
	41 Max. Working pressure	31.0								
	42 Temp. Max. (°C)	Operating (°C)	105	90						
	43 Oper. Sp. Gr (Kg/m3)	Mol Wt	0.88							
	44 Oper. Visc. (CP)	%Flash								
	45 Fluid(Phase)	ISO VG 68 Turbine Oil								
OPERATING CONDITION	46 Design Spec (Face to Face)									
	47									
	48 Manufacturer									
	49 Model No.									
OTHERS	50 Q'ty									
	Notes :									

AA301,302 PSV


 The-Safety-Valve.com	Sizing acc. to API 520 for Gas VALVESTAR® - v.7.2.3.1205	Page:	1 of 7
		Date:	2014-12-09 11:53:26
		Project:	SIAM PURE RICE
		Tag No:	10EKH21/22/23-AA301
		LESER Job No	

Sizing - Medium			
1000	Designation	WEST GAS	
1004	Formula		
1001	Molar mass	M	20.857 kg/kmol
1002	Ratio of specific heats	k	1.331
1003	Compressibility factor	Z	0.977

Sizing - Service condition			
1100	Maximum allowable working pressure		
1101	Set pressure	p	35 bar-g
1102	Superimposed back pressure	paf	0 bar-g
1103	Built up back pressure	pae	
1104	Backpressure		0 bar-g
1105	Overpressure	dp	10.00 %
1106	Environmental pressure	pu	1.013 bar
1107	Temperature	T	49 °C
1108	Required massflow	qm,ab	14,170 kg/h
1109	Volume flow to be discharged (working condition)	qvb,ab	449.939 m ³ /h
1110	Volume flow to be discharged (std condition) [T=60 °F P=14.7 psi]	qvn,ab	15,720.165 m ³ /h
1120	Rupture disc correction factor	Kc	1.000

Sizing - Calculation			
1200	Certified massflow	qm,zu	22,052.384 kg/h
1201	Certified volume flow (operating condition)	qvb,zu	700.228 m ³ /h
1203	Certified volume flow (standard condition)	qvn,zu	24,464.864 m ³ /h
1204	Maximum mass flow	qm,max	24,502.649 kg/h
1205	Maximum volume flow (working condition)	qvb,max	778.031 m ³ /h
1206	Maximum volume flow (standard condition)	qvn,max	27,183.182 m ³ /h
1207	Capacity exceed		55.63 %

Name	Default user			
Date	2014-12-09 11:53:26			
Rev.No	1			

 The-Safety-Valve.com	Sizing acc. to API 520 for Gas VALVESTAR® - v.7.2.3.1205	Page:	2 of 7
		Date:	2014-12-09 11:53:26
		Project:	SIAM PURE RICE
		Tag No:	10EKH21/22/23-AA301
		LESER Job No	

Valve - General			
1500	Article number		5262.1642
1512	Reseller article number		
1513	Quantity of safety valve		1
1501	Certified coefficient of discharge for steam and gases	K,DG	0.801
1502	Certified coefficient of discharge for liquid	K,F	0.579
1453	Orifice		J
1505	Bonnet / Lifting device		Cap H2
1506	Body-/ Inlet base material		1.0619 / SA 216 WCB
1511	Bonnet		Closed Bonnet
1514	Order code	5262.1642-35 bar_g-H65H79H03H01-3.1	


Inlet connection			
1303	Connection standard		acc. to ASME B16.5
1304	DN / NPS		3"
1305	PN / PR		#300
1306	Flange facing		RF

Outlet connection			
1353	Connection standard		acc. to ASME B16.5
1354	DN / NPS		4"
1355	PN / PR		#150
1356	Flange facing		RF

Valve - Dimensions			
1400	Discharge area	Ao	1,017.876 mm ²
1401	Discharge diameter	do	36 mm
1402	Centre to Face dimensions	a	184 mm
1403	Centre to Face dimensions	b	181 mm
1405	Height	H	786 mm
1406	Weight	M	77.7 kg
1411	Inlet flange thickness incl. raised face	S1	49 mm

Lift			
1507	Standard		10.1 mm

Name	Default user				
Date	2014-12-09 11:53:26				
Rev.No	1				


 The-Safety-Valve.com	Sizing acc. to API 520 for Gas VALVESTAR® - v.7.2.3.1205	Page:	3 of 7
		Date:	2014-12-09 11:53:26
		Project:	SIAM PURE RICE
		Tag No:	10EKH21/22/23-AA301
		LESER Job №	

Valve - Calculation			
1200	Certified massflow	qm,zu	22,052.384 kg/h
1201	Certified volumeflow (operating condition)	qvb,zu	700.228 m ³ /h
1203	Certified volumeflow (standard condition)	qvn,zu	24,464.864 m ³ /h
1204	Maximum mass flow	qm,max	24,502.649 kg/h
1205	Maximum volume flow (working condition)	qvb,max	778.031 m ³ /h
1206	Maximum volume flow (standard condition)	qvn,max	27,183.182 m ³ /h
1207	Capacity exceed		55.63 %
1600	Required actual discharge area	Ao, req	654.047 mm ²
1601	Required discharge diameter	do,req	28.858 mm
1617	Back pressure correction factor	Kb	1.000
1618	Cold differential test pressure	CDTP	35 bar-g
1620	Cold differential test pressure, manually	CDTP	

Valve - Inspections	
H03	LESER CGA: Inspection certificate 3.1 acc. to DIN EN 10204, Declaration of conformity acc. to PED 97/23/EC

Valve - Material certificates	
H01	Material test certificate for body acc. to DIN EN 10204-3.1


Name	Default user				
Date	2014-12-09 11:53:26				
Rev.No	1				


 The-Safety-Valve.com	Sizing acc. to API 520 for Gas VALVESTAR® - v.7.2.3.1205	Page:	4 of 7
		Date:	2014-12-09 11:53:26
		Project:	SIAM PURE RICE
		Tag No:	10EKH21/22/23-AA301
		LESER Job №	

Valve - Part list					
	PosNo	Denomination	Q	Material ASME	Material DIN
12010	1	Body	1	SA 216 WCB	1.0619
12050	5	Full nozzle	1	CF8M or 316L	1.4408 or 1.4404
12060	6	Adjusting ring	1	CF8M	1.4408
12070	7	Disc	1	Hardened Stainless steel	1.4122
12080	8	Guide	1	Carbon steel/chrome st. Tenifer	1.0501/ 1.4104 tenifer
12090	9	Bonnet	1	SA 216 WCB	1.0619
12120	12	Spindle	1	420	1.4021
12140	14	Split ring	2	Chrome steel	1.4104
12160	16	Spring plate	1	Steel	1.0718
12170	17	Spring plate	1	Steel	1.0718
12180	18	Adjusting screw	1	Chrome steel	1.4104
12190	19	Lock nut	1	Steel	1.0718
12220	22	Lift stopper	1	316L	1.4404
12400	40	Plain lever H3	1	Ductile Gr. 60-40-18	0.7040
12540	54	Spring	1	High temperature alloy steel	1.8159
12550	55	Bolt	8	B8M	1.4401
12560	56	Nut	8	8M	1.4401
12570	57	Ball	15	316	1.4401
12600	60	Gasket	1	Graphite / 316	Graphit / 1.4401
12610	61	Ball washer	1	Hardened stainless steel	1.3541
12660	66	Hex. nut	1	B8M	1.4401
12690	69	Thrust needle bearing	1	316L	1.4404
12730	73	Locking screw	1	8M	1.4404


LESER is free to upgrade materials without further notice.


Name	Default user				
Date	2014-12-09 11:53:26				
Rev.No	1				

 The-Safety-Valve.com	Sizing acc. to API 520 for Gas VALVESTAR® - v.7.2.3.1205	Page:	5 of 7
		Date:	2014-12-09 11:53:26
		Project:	SIAM PURE RICE
		Tag No:	10EKH21/22/23-AA301
		LESER Job №	

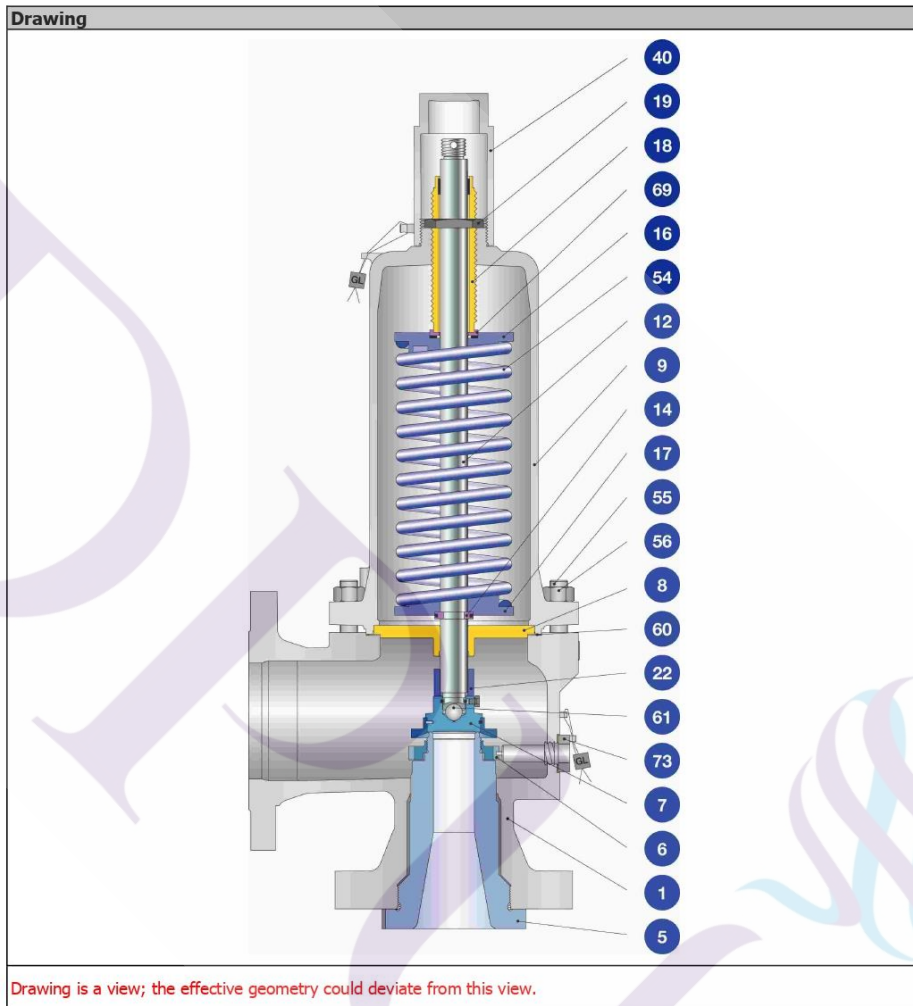


Name	Default user				
Date	2014-12-09 11:53:26				
Rev.No	1				



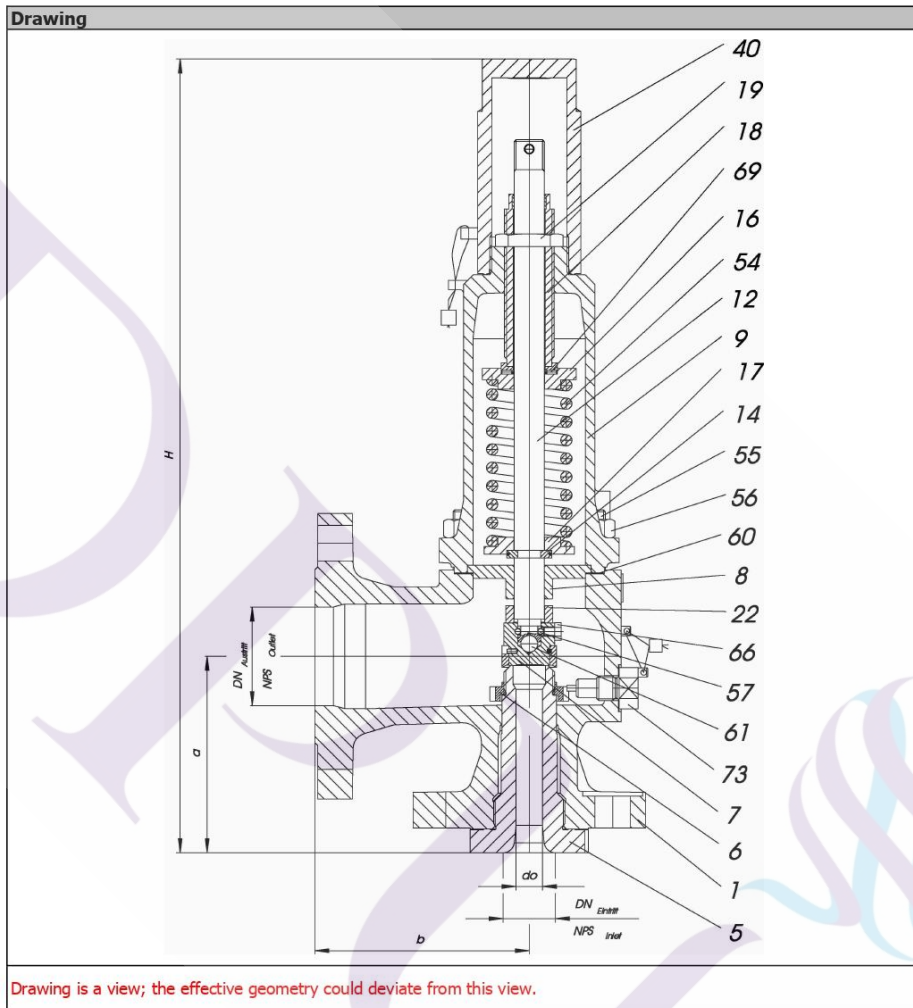

 The-Safety-Valve.com	Sizing acc. to API 520 for Gas VALVESTAR® - v.7.2.3.1205	Page:	6 of 7
		Date:	2014-12-09 11:53:26
		Project:	SIAM PURE RICE
		Tag No:	10EKH21/22/23-AA301
		LESER Job №	




Name	Default user				
Date	2014-12-09 11:53:26				
Rev.No	1				

 The-Safety-Valve.com	Sizing acc. to API 520 for Gas VALVESTAR® - v.7.2.3.1205	Page:	7 of 7
		Date:	2014-12-09 11:53:26
		Project:	SIAM PURE RICE
		Tag No:	10EKH21/22/23-AA301
		LESER Job No	

World nameplate					
LESER		Tag		10EKH21/22/23-AA	
Type	5262.1642	Size	3"	Serial no.	
Flow area	1018	mm ²	d ₀	36.0	mm Seat
	Set p.	Back p.	CDTP	Temp.	
bar	35	0	35	49.00 °C	
psig	507.632	0	507.632	120.2 °F	
TÜV-SV	Lift	10.10	mm ISO 4126-1	ASME-Cap.	
04-1082	Steam	0.80		37298	lbs/hr
Date	Gas	0.80		13653	SCFM
	Liquid	0.58		820	GPM
5262.1642-35 bar_g-H65H79H03H01-3.1					


 0045


 cc2408


Name	Default user				
Date	2014-12-09 11:53:26				
Rev.No	1				


 The-Safety-Valve.com	Sizing acc. to API 520 for Gas VALVESTAR® - v.7.2.3.1205	Page:	1 of 7
		Date:	2014-12-09 11:55:37
		Project:	SIAM PURE RICE
		Tag No:	10EKH21/22/23-AA302
		LESER Job №	

Sizing - Medium			
1000	Designation	WEST GAS	
1004	Formula		
1001	Molar mass	M	20.857 kg/kmol
1002	Ratio of specific heats	k	1.331
1003	Compressibility factor	Z	0.977

Sizing - Service condition			
1100	Maximum allowable working pressure		
1101	Set pressure	p	37 bar-g
1102	Superimposed back pressure	paf	0 bar-g
1103	Built up back pressure	pae	
1104	Backpressure		0 bar-g
1105	Overpressure	dp	10.00 %
1106	Environmental pressure	pu	1.013 bar
1107	Temperature	T	100 °C
1108	Required massflow	qm,ab	14,170 kg/h
1109	Volume flow to be discharged (working condition)	qvb,ab	493.682 m³/h
1110	Volume flow to be discharged (std condition) [T=60 °F P=14.7 psi]	qvn,ab	15,720.165 m³/h
1120	Rupture disc correction factor	Kc	1.000

Sizing - Calculation			
1200	Certified massflow	qm,zu	30,860.747 kg/h
1201	Certified volume flow (operating condition)	qvb,zu	1,075.187 m³/h
1203	Certified volume flow (standard condition)	qvn,zu	34,236.842 m³/h
1204	Maximum mass flow	qm,max	34,289.719 kg/h
1205	Maximum volume flow (working condition)	qvb,max	1,194.652 m³/h
1206	Maximum volume flow (standard condition)	qvn,max	38,040.935 m³/h
1207	Capacity exceed		117.79 %

Name	Default user			
Date	2014-12-09 11:55:37			
Rev.No	1			

 The-Safety-Valve.com	Sizing acc. to API 520 for Gas VALVESTAR® - v.7.2.3.1205	Page:	2 of 7
		Date:	2014-12-09 11:55:37
		Project:	SIAM PURE RICE
		Tag No:	10EKH21/22/23-AA302
		LESER Job No	

Valve - General			
1500	Article number		5262.2032
1512	Reseller article number		
1513	Quantity of safety valve		1
1501	Certified coefficient of discharge for steam and gases	K,DG	0.801
1502	Certified coefficient of discharge for liquid	K,F	0.579
1453	Orifice		K
1505	Bonnet / Lifting device		Cap H2
1506	Body-/ Inlet base material		1.0619 / SA 216 WCB
1511	Bonnet		Closed Bonnet
1514	Order code	5262.2032-37 bar_g-H65H79H03H01-3.1	


Inlet connection			
1303	Connection standard		acc. to ASME B16.5
1304	DN / NPS		3"
1305	PN / PR		#300
1306	Flange facing		RF

Outlet connection			
1353	Connection standard		acc. to ASME B16.5
1354	DN / NPS		4"
1355	PN / PR		#150
1356	Flange facing		RF

Valve - Dimensions			
1400	Discharge area	Ao	1,452.201 mm ²
1401	Discharge diameter	do	43 mm
1402	Centre to Face dimensions	a	156 mm
1403	Centre to Face dimensions	b	162 mm
1405	Height	H	758 mm
1406	Weight	M	70.1 kg
1411	Inlet flange thickness incl. raised face	S1	49 mm

Lift			
1507	Standard		12 mm

Name	Default user				
Date	2014-12-09 11:55:37				
Rev.No	1				


 The-Safety-Valve.com	Sizing acc. to API 520 for Gas VALVESTAR® - v.7.2.3.1205	Page:	3 of 7
		Date:	2014-12-09 11:55:37
		Project:	SIAM PURE RICE
		Tag No:	10EKH21/22/23-AA302
		LESER Job №	

Valve - Calculation			
1200	Certified massflow	qm,zu	30,860.747 kg/h
1201	Certified volumeflow (operating condition)	qvb,zu	1,075.187 m ³ /h
1203	Certified volumeflow (standard condition)	qvn,zu	34,236.842 m ³ /h
1204	Maximum mass flow	qm,max	34,289.719 kg/h
1205	Maximum volume flow (working condition)	qvb,max	1,194.652 m ³ /h
1206	Maximum volume flow (standard condition)	qvn,max	38,040.935 m ³ /h
1207	Capacity exceed		117.79 %
1600	Required actual discharge area	Ao, req	666.792 mm ²
1601	Required discharge diameter	do,req	29.137 mm
1617	Back pressure correction factor	Kb	1.000
1618	Cold differential test pressure	CDTP	37 bar-g
1620	Cold differential test pressure, manually	CDTP	

Valve - Inspections	
H03	LESER CGA: Inspection certificate 3.1 acc. to DIN EN 10204, Declaration of conformity acc. to PED 97/23/EC

Valve - Material certificates	
H01	Material test certificate for body acc. to DIN EN 10204-3.1


Name	Default user				
Date	2014-12-09 11:55:37				
Rev.No	1				


 The-Safety-Valve.com	Sizing acc. to API 520 for Gas VALVESTAR® - v.7.2.3.1205	Page:	4 of 7
		Date:	2014-12-09 11:55:37
		Project:	SIAM PURE RICE
		Tag No:	10EKH21/22/23-AA302
		LESER Job №	

Valve - Part list					
	PosNo	Denomination	Q	Material ASME	Material DIN
12010	1	Body	1	SA 216 WCB	1.0619
12050	5	Full nozzle	1	CF8M or 316L	1.4408 or 1.4404
12060	6	Adjusting ring	1	CF8M	1.4408
12070	7	Disc	1	Hardened Stainless steel	1.4122
12080	8	Guide	1	Carbon steel/chrome st. Tenifer	1.0501/ 1.4104 tenifer
12090	9	Bonnet	1	SA 216 WCB	1.0619
12120	12	Spindle	1	420	1.4021
12140	14	Split ring	2	Chrome steel	1.4104
12160	16	Spring plate	1	Steel	1.0718
12170	17	Spring plate	1	Steel	1.0718
12180	18	Adjusting screw	1	Chrome steel	1.4104
12190	19	Lock nut	1	Steel	1.0718
12220	22	Lift stopper	1	316L	1.4404
12400	40	Plain lever H3	1	Ductile Gr. 60-40-18	0.7040
12540	54	Spring	1	High temperature alloy steel	1.8159
12550	55	Bolt	8	B8M	1.4401
12560	56	Nut	8	8M	1.4401
12570	57	Ball	15	316	1.4401
12600	60	Gasket	1	Graphite / 316	Graphit / 1.4401
12610	61	Ball washer	1	Hardened stainless steel	1.3541
12660	66	Hex. nut	1	B8M	1.4401
12690	69	Thrust needle bearing	1	316L	1.4404
12730	73	Locking screw	1	8M	1.4404


LESER is free to upgrade materials without further notice.


Name	Default user				
Date	2014-12-09 11:55:37				
Rev.No	1				

 The-Safety-Valve.com	Sizing acc. to API 520 for Gas VALVESTAR® - v.7.2.3.1205	Page:	5 of 7
		Date:	2014-12-09 11:55:37
		Project:	SIAM PURE RICE
		Tag No:	10EKH21/22/23-AA302
		LESER Job №	

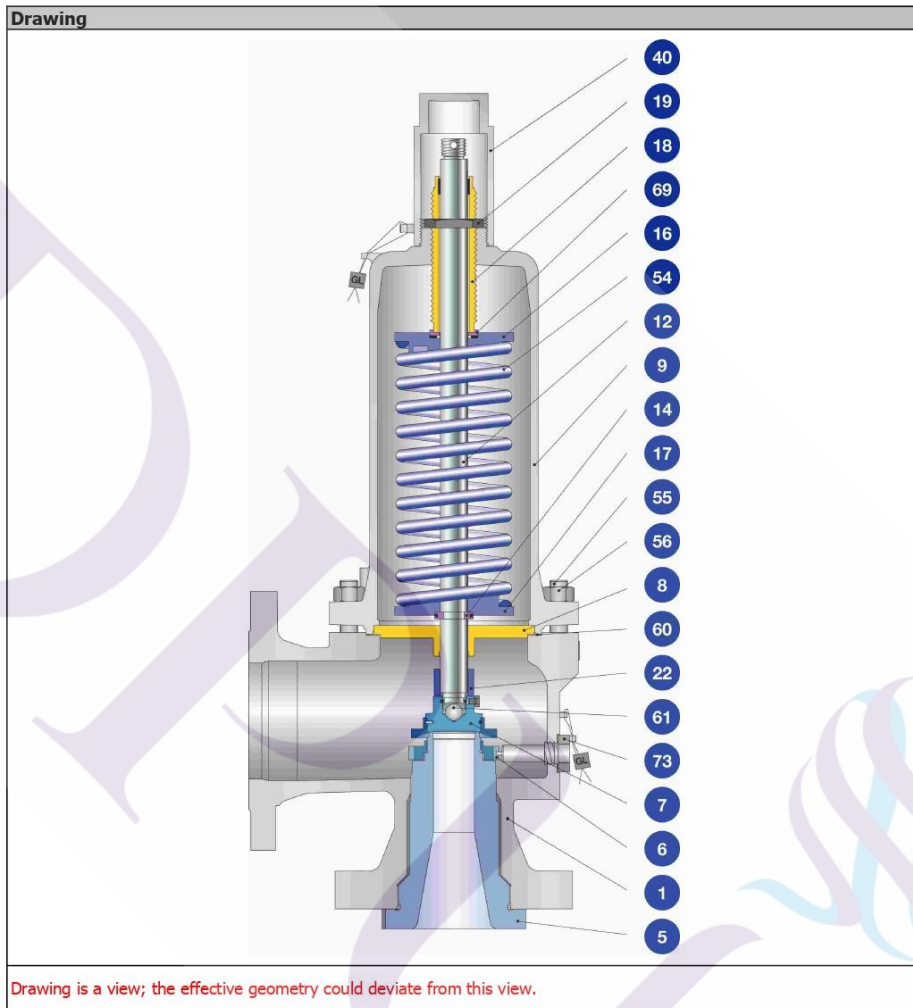



Name	Default user				
Date	2014-12-09 11:55:37				
Rev.No	1				

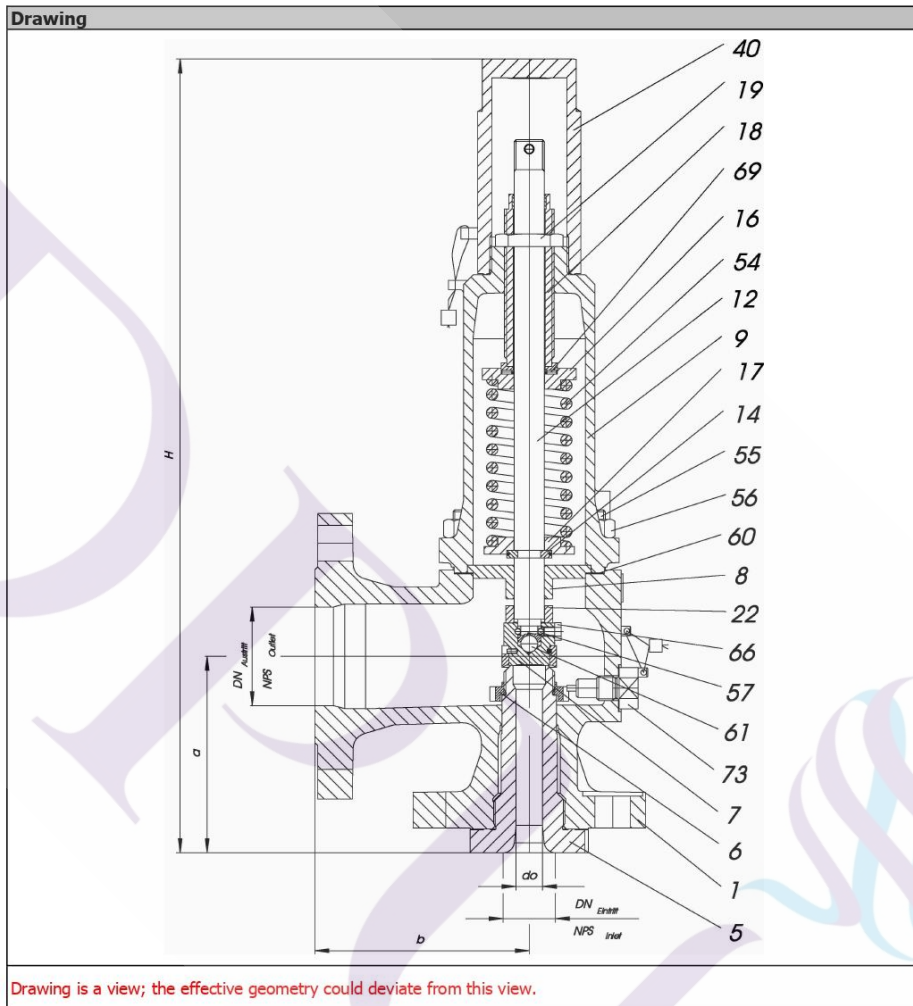



 The-Safety-Valve.com	Sizing acc. to API 520 for Gas VALVESTAR® - v.7.2.3.1205	Page:	6 of 7
		Date:	2014-12-09 11:55:37
		Project:	SIAM PURE RICE
		Tag No:	10EKH21/22/23-AA302
		LESER Job №	



Name	Default user				
Date	2014-12-09 11:55:37				
Rev.No	1				


 The-Safety-Valve.com	Sizing acc. to API 520 for Gas VALVESTAR® - v.7.2.3.1205	Page:	7 of 7
		Date:	2014-12-09 11:55:37
		Project:	SIAM PURE RICE
		Tag No:	10EKH21/22/23-AA302
		LESER Job No	

World nameplate				
		Tag 10EKH21/22/23-AA		
Type	5262.2032	Size	3"	
Flow area	1452	mm ²	d ₀	43.0
		mm	Seat	
	Set p.	Back p.	CDTP	Temp.
bar	37	0	37	100.0 °C
psig	536.64	0	536.64	212.0 °F
TÜV-SV	Lift	12.00	mm ISO 4126-1	ASME-Cap.
04-1082	Steam	0.80	56176	lbs/hr
Date	Gas	0.80	20563	SCFM
	Liquid	0.58	1203	GPM
5262.2032-37 bar_g-H65H79H03H01-3.1				



 0045


 cc2408


Name	Default user				
Date	2014-12-09 11:55:37				
Rev.No	1				

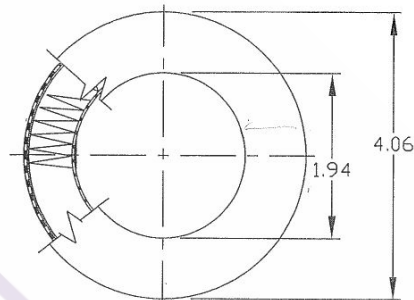**AT001,002 Oil
Filter Element**

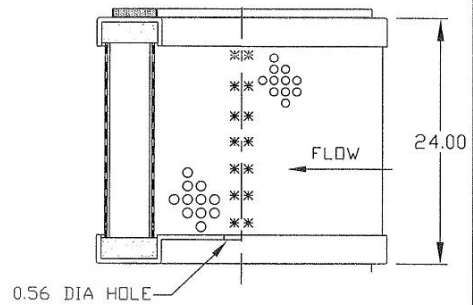

TOP VIEW



SIDE VIEW

SPECIFICATIONS:

ELEMENT PART NUMBER = KL450-039P
 ELEMENT TYPE = PLEATED OIL FILTRATION
 MICRON RATING = 10 MICRON
 FLOW DIRECTION = OUTSIDE TO INSIDE
 FLOW CAPACITY = 50 GPM **189 litre/min**
 EFFECTIVE SURFACE = 5.72 SQ. FT.
 OPERATING TEMPERATURE = -35F to +230F
 COLLAPSE PRESSURE = 100 PSI
 END CAP MATERIAL = GALVANIZED STEEL
 TUBING = GALVANIZED STEEL
 MEDIA = MICROGLASS REINFORCED WITH ALUM. MESH
 END SEAL = URETHANE
 GASKET SEAL = NEOPRENE



THIS DOCUMENT AND ITS CONTENT ARE THE PROPERTY OF KELTEC TECHNOLOGICAL. THE USE OF THIS DOCUMENT AND ITS CONTENTS WITHOUT WRITTEN PERMISSION OF KELTEC TECHNOLOGICAL IS PROHIBITED.	DEM: TECHNICAL USA	Part No. KL 450-039P	Rev. 00
	DEM No. 0060811-1		
	WEIGHT LBS. 0000		
	DRAWN BY: LJR		
DATE: 6/9/11			
Part No. KL 450-039P			

KELTEC
Technolab

2300 East Enterprise Parkway
Twinsburg, Ohio 44087

OS1 BB002

APPROVED

REV. NO.		DATE	REVISION	DRAWN BY	CHECK'D BY	APP'D BY
0		12/1/14	For Approval	AG	JK	JK

DRAWN		AG	06/10/14	JOB NO :	J.51608	SCALE :	NTS
CHECKED		JK	07/10/14	DRAWING NO :	TAG-1405-200-181B	REV.	1 of 5
APPROVED		JK	07/10/14				

DESIGN DATA

CODE REFERENCE	ASME Sec. VIII, Div.1, 2013, Edition		
FLUID	NATURAL GAS		
DESIGN PRESSURE (Int'n/Ext'l)	40 BarG / 1.034 BarG		
DESIGN TEMPERATURE (Int'l/Ext'l)	130 °C / 50°C		
OPERATING PRESSURE	7.7 BarG		
OPERATING TEMPERATURE	49°C		
MDMT	-10° C at 40 BarG		
M.A.W.P	40 BarG at 130° C		
RT : FULL	U.T. : NO	HYDROTEST PRESSURE	52 BarG
M.T. : NO	P.T. : 100%	HYDROTEST POSITION	VERTICAL
P. W. H. T.	YES (HEAD ONLY)	CORROSION ALLOWANCE	3 mm
IMPACT TEST	EXEMPTED per UG20 (f)	JOINT EFFICIENCY HEAD/ SHELL	3/1
CERTIFICATION	LR Insurance INC	EMPTY WEIGHT (Kg)	4600
INSULATION	NO	OPERATION WEIGHT (Kg)	--
		FULL OF WATER WEIGHT (Kg)	7100
		VOLUME	2.5 m ³

NOZZLE LIST

MARK	QTY	SIZE	SCH/THK	RATING	FACING	COMP. P. LAM.	SERVICE
NA	1	NPS 4"(DN100)	160	ANS 300P	WNRF	330 22	GAS INLET
NB	1	NPS 4"(DN100)	160	ANS 300P	WNRF	330 22	GAS OULET
NC	1	NPS 4"(DN100)	160	ANS 300P	WNRF	220 22	OIL COOLER OULET
ND	1	NPS 4"(DN100)	160	ANS 300P	WNRF	220 22	BY PASS LINE
NE	1	NPS 2"(DN50)	XXS	--	--	140 22	LEVEL GAUGE
NF	1	NPS 2"(DN50)	XXS	--	--	140 22	LEVEL GAUGE
NG	1	NPS 1"(DN25)	--	6000P NPT	--	--	OIL RETURN LINE
NH	1	NPS 1"(DN25)	--	6000P NPT	--	--	TEMPERATURE TRANSMITTER
NI	1	NPS 1"(DN25)	--	6000P NPT	--	--	TEMPERATURE GAUGE
NJ	1	NPS 3/4"(DN20)	--	6000P NPT	--	--	PRESSURE GAUGE
NK	1	NPS 3/4"(DN20)	--	6000P NPT	--	--	PRESSURE TRANSMITTER
NL	1	NPS 3/4"(DN20)	--	6000P NPT	--	--	PRESSURE TRANSMITTER
NM	1	NPS 3/2"(DN90)	2270a	ANS 300P	SOFR	850 22	ACCESS/MANNWAY
NN	1	NPS 1"(DN25)	--	6000P NPT	--	--	DRAIN PORT
NO	1	NPS 3/4"(DN20)	--	6000P NPT	--	--	PRESSURE DIFF. GAUGE
NP	1	NPS 3/4"(DN20)	--	6000P NPT	--	--	PRESSURE DIFF. GAUGE

TAG NO :
 -108KH21-BB002
 -108KH22-BB002
 -108KH23-BB002

PAINTING SPECIFICATION

SURFACE PREPARATION:
 EXTERNAL : SAND BLAST SA 2 1/2
 EXTERNAL PAINTING :
 PRIMER COAT : 75 micron- Interzinc 52 by Envicon

GENERAL NOTES

1. ALL DIMENSION ARE IN MM UNLESS NOTED OTHERWISE
2. ALL FLANGE BOLT HOLES SHALL STRIKE TO VESSEL "NORMAL" CENTERLINE
3. ALL FLANGE SHALL COMPLY WITH ASME B16.5 UNLESS NOTED OTHERWISE
4. ALL WELDMENT SHOULD BE FULL PENETRATION WELD EXCEPT AS NOTED
5. REINFORCING PAD OF NOZZLE TO BE PROVIDED WITH ONE 1/8" NPT TELL TALE HOLE AND SHALL BE LOCATED AT THE LOWEST POINT POSSIBLE.
6. FABRICATION TOLERANCE REFER TO DRAWING ENDS-ST0-001


PROJECT : TAG-1405
 JKL - SPR


CLIENT : TECHNICAL ASIA PTE LTD
 15/01 STRAITS CLOSE
 Singapore 627482
 Tel: (65)6396-2638 Fax: (65)6795-7375


TITLE : 1st STAGE OYL SEPARATOR (D248" x 85" x 8')
 GENERAL ARRANGEMENT

REMARK : QTY : 3 UNIT

PT. BIRWOOD IKATAMA

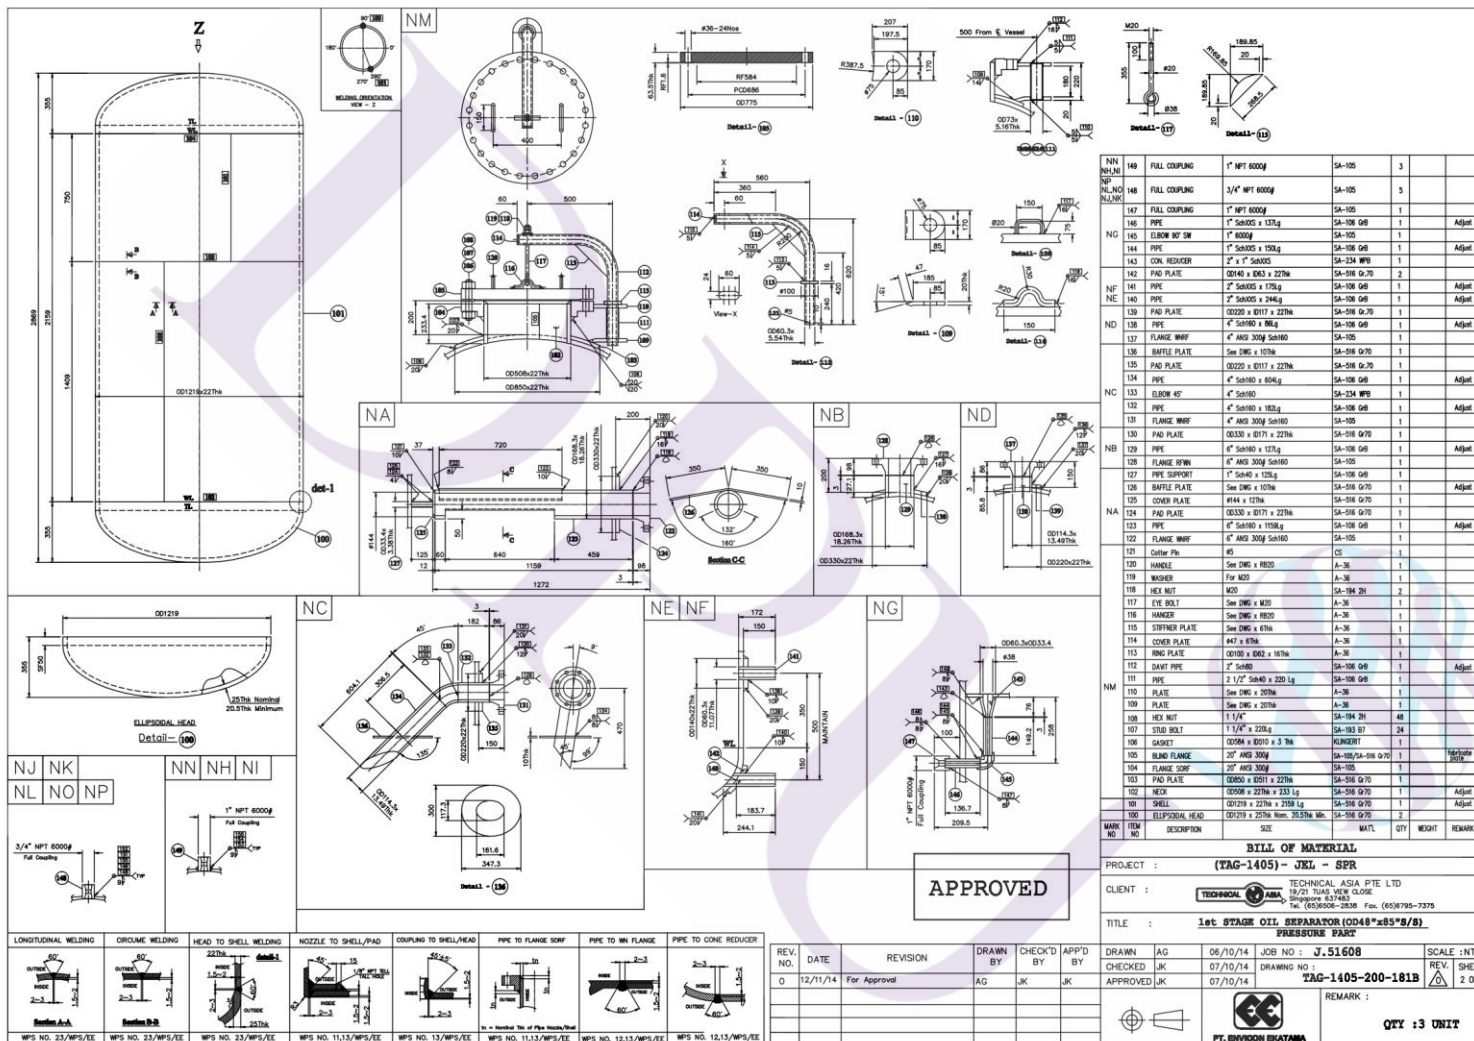

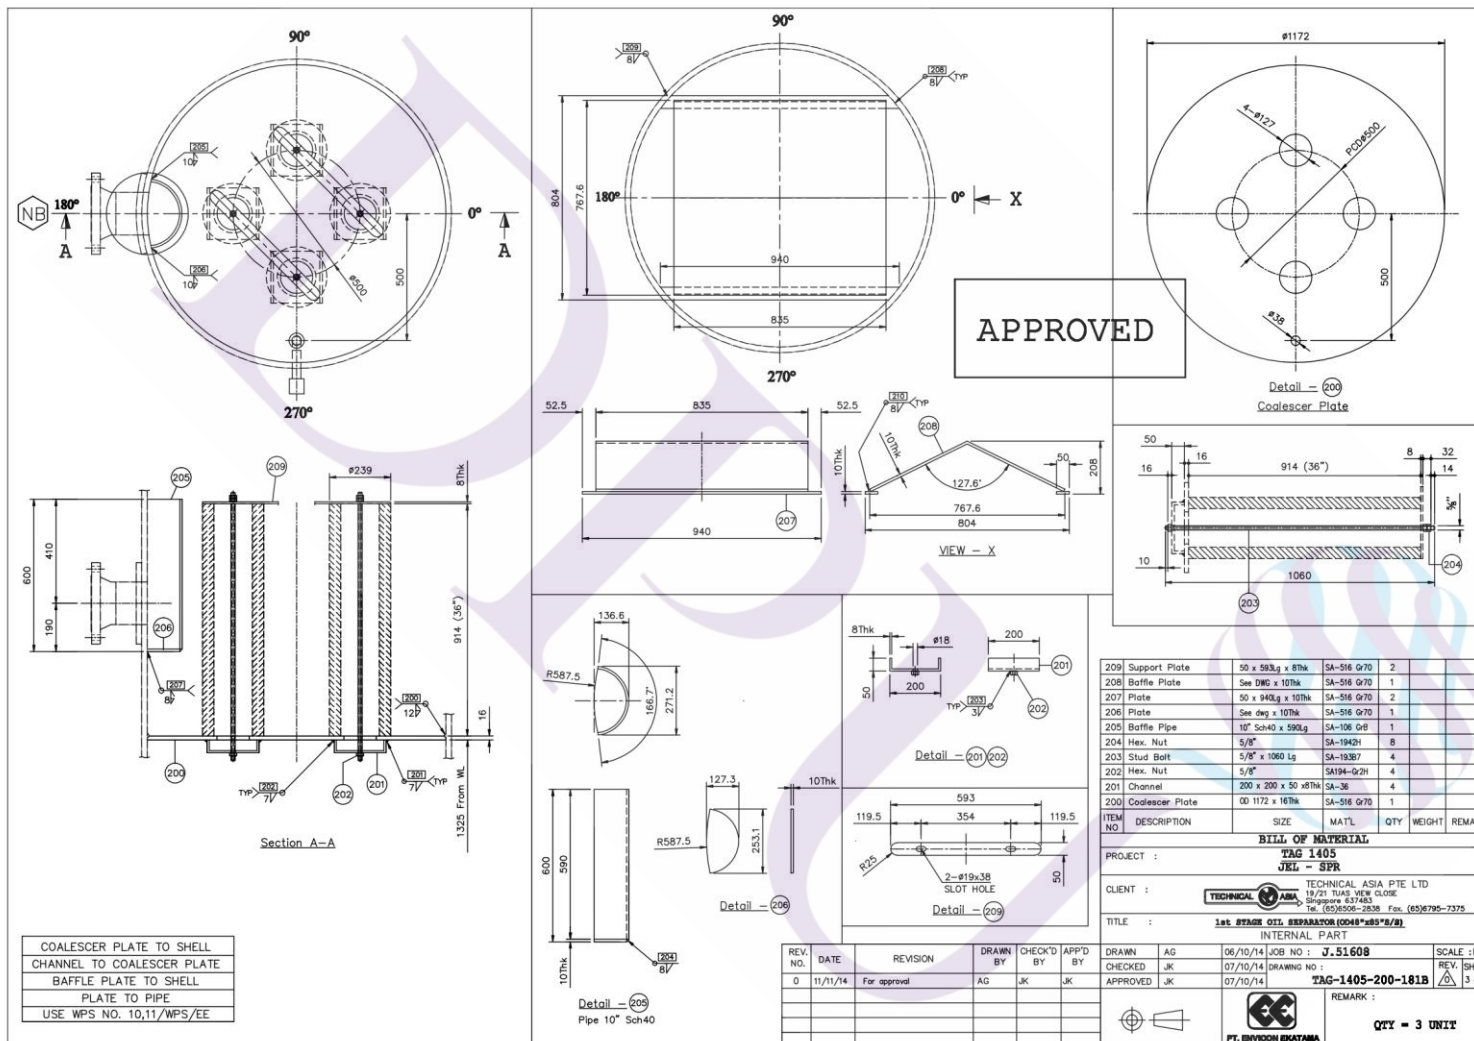

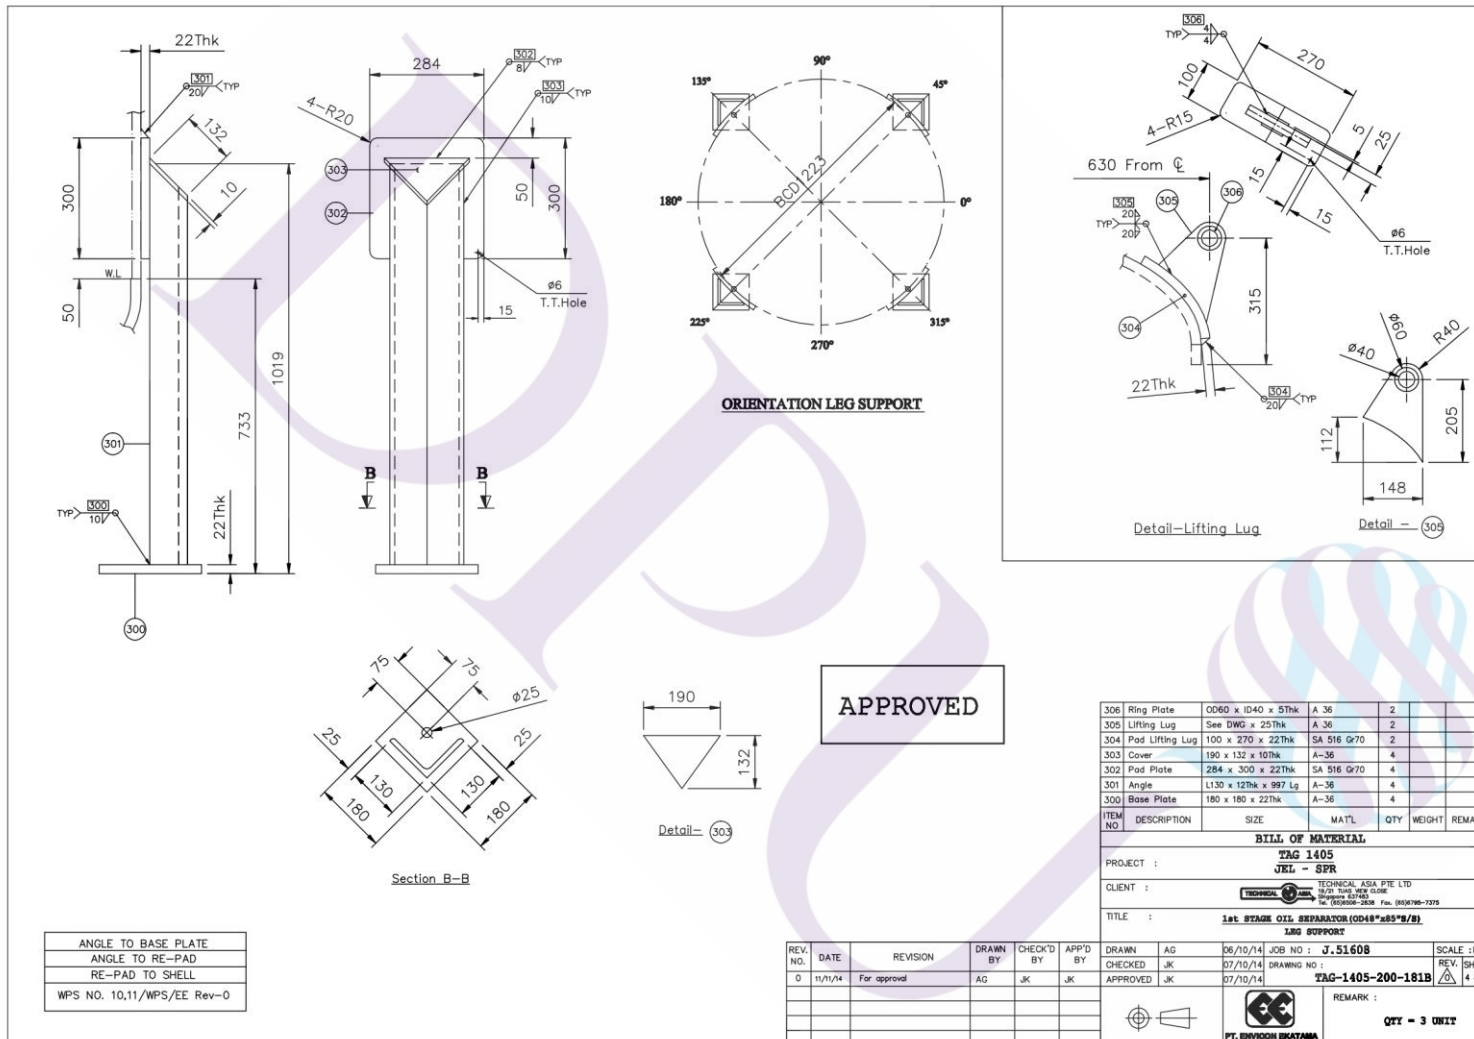

APPROVED

TAG NO : 10 EK121-BB002
 : 10 EK122-BB002
 : 10 EK123-BB002

TAG NO : XX EK10X-BB00X
 TECHNICAL ASIA PTE LTD SINGAPORE
 CERTIFIED BY: PT. ENVOON EKATAMA
 Fabrication & Contracting
 MAX ALLOWABLE WORKING PRESSURE: 40 BarG AT 130°C
 MAX ALLOWABLE EXTERNAL WORKING PRESSURE: -1.03 BarG AT 50°C
 MIN DESIGN METAL TEMPERATURE: -10°C AT 40 BarG
 MFR SERIAL NO: J.51608-1/EE/A/137
 YEAR BUILT: 2014

NAME PLATE DETAIL

J.51608-1/EE/A/137
 J.51608-2/EE/A/138
 J.51608-3/EE/A/139

(USE WPS NO. 11/WPS/EE)

REV. NO.	DATE	REVISION	DRAWN BY	CHECKED BY	APP'D BY	AG	AG	DATE	JOB NO	SCALE
0	11/11/14	For Approval	AG	JK	JK			07/10/14	J.51608	:NTS

Item No.	DESCRIPTION	SIZE	MATL	QTY	WEIGHT	REMARK
402	Name Plate	165 x 145 x 2mm	SS	1		
401	Name Plate Bracket	See Day x 6 Thk	SA-304 300	1		
400	Name Plate Bracket	See Day x 6 Thk	SA-304 300	1		

BILL OF MATERIAL

PROJECT : TAG-1405 (JEL-SPR)


CLIENT : TECHNICAL ASIA PTE LTD
12/21 TUAJEN CLOSE
SINGAPORE 617463
Tel: (65)6506-2838 Fax: (65)6795-7375


TITLE : **1st STAGE OIL SEPARATOR (048"x85" S/S)**
NAME PLATE


REV. NO.	DATE	REVISION	DRAWN BY	CHECKED BY	APP'D BY	AG	AG	DATE	JOB NO	SCALE
0	11/11/14	For Approval	AG	JK	JK			07/10/14	J.51608	:NTS

TAG-1405-200-181B

REMARK : Qty= 3 UNIT

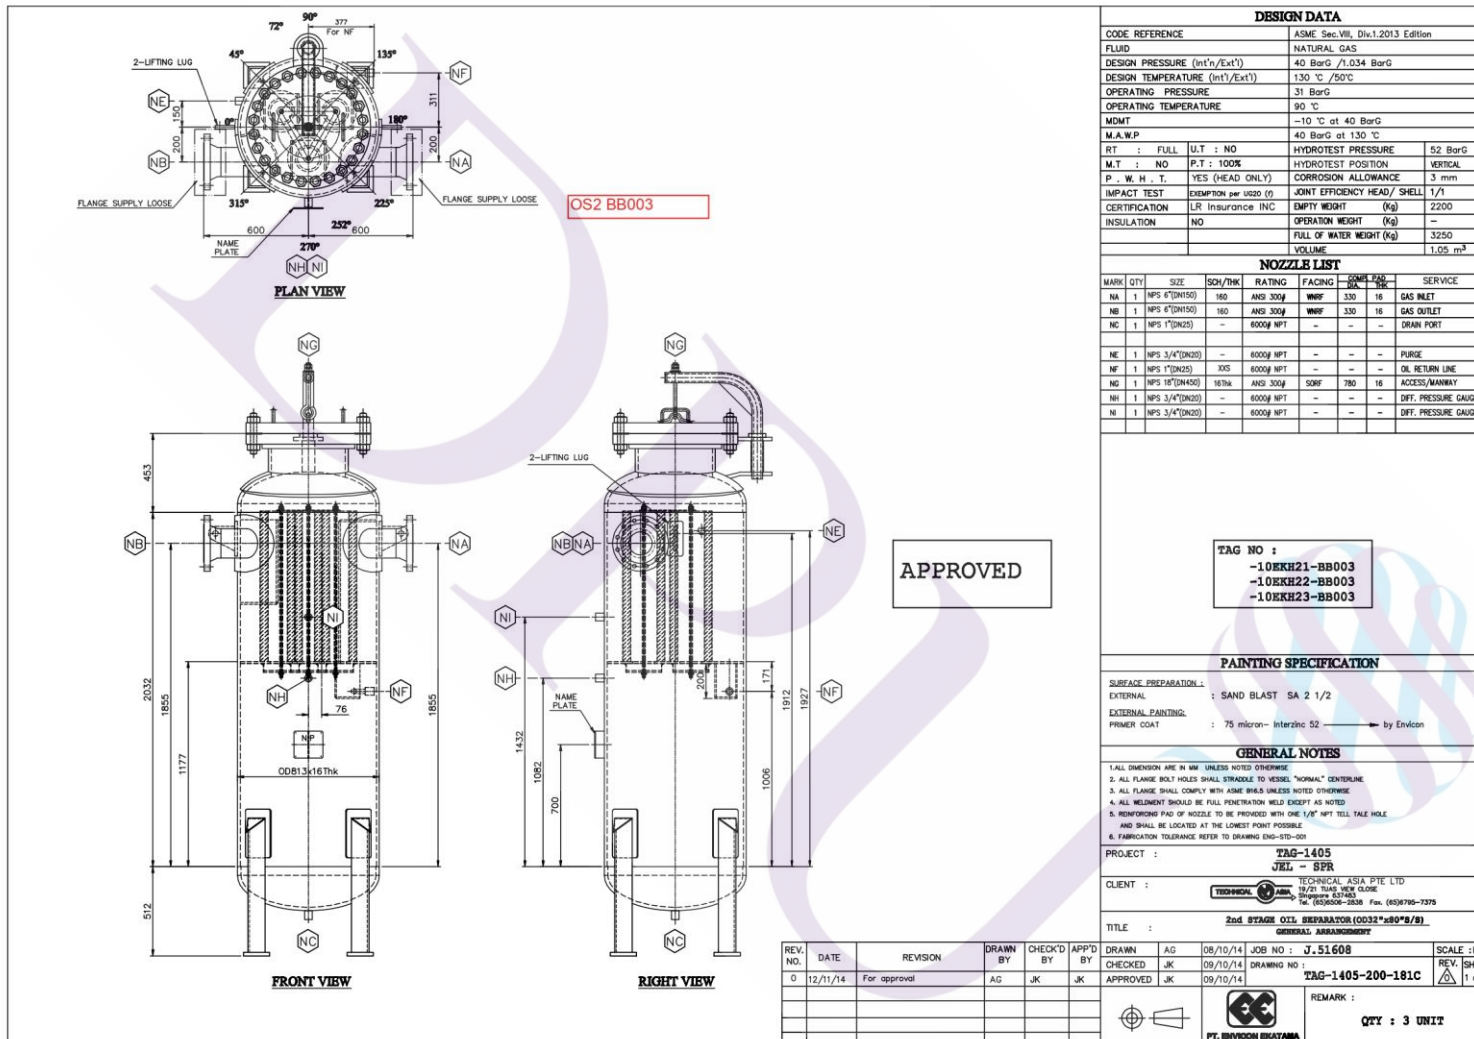

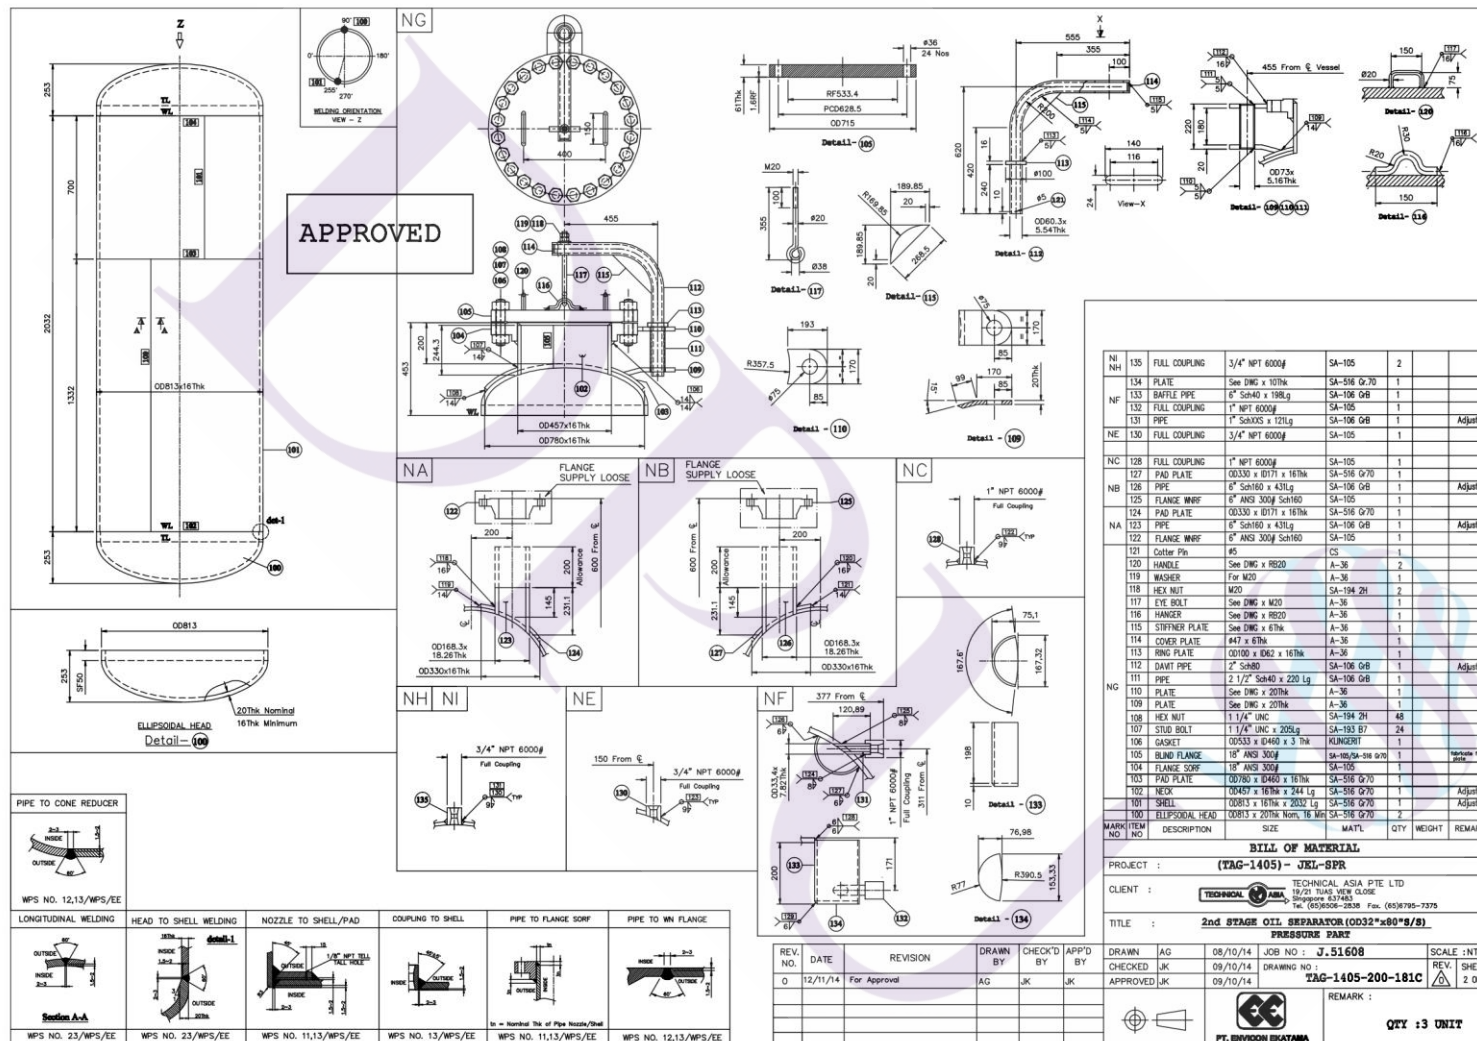

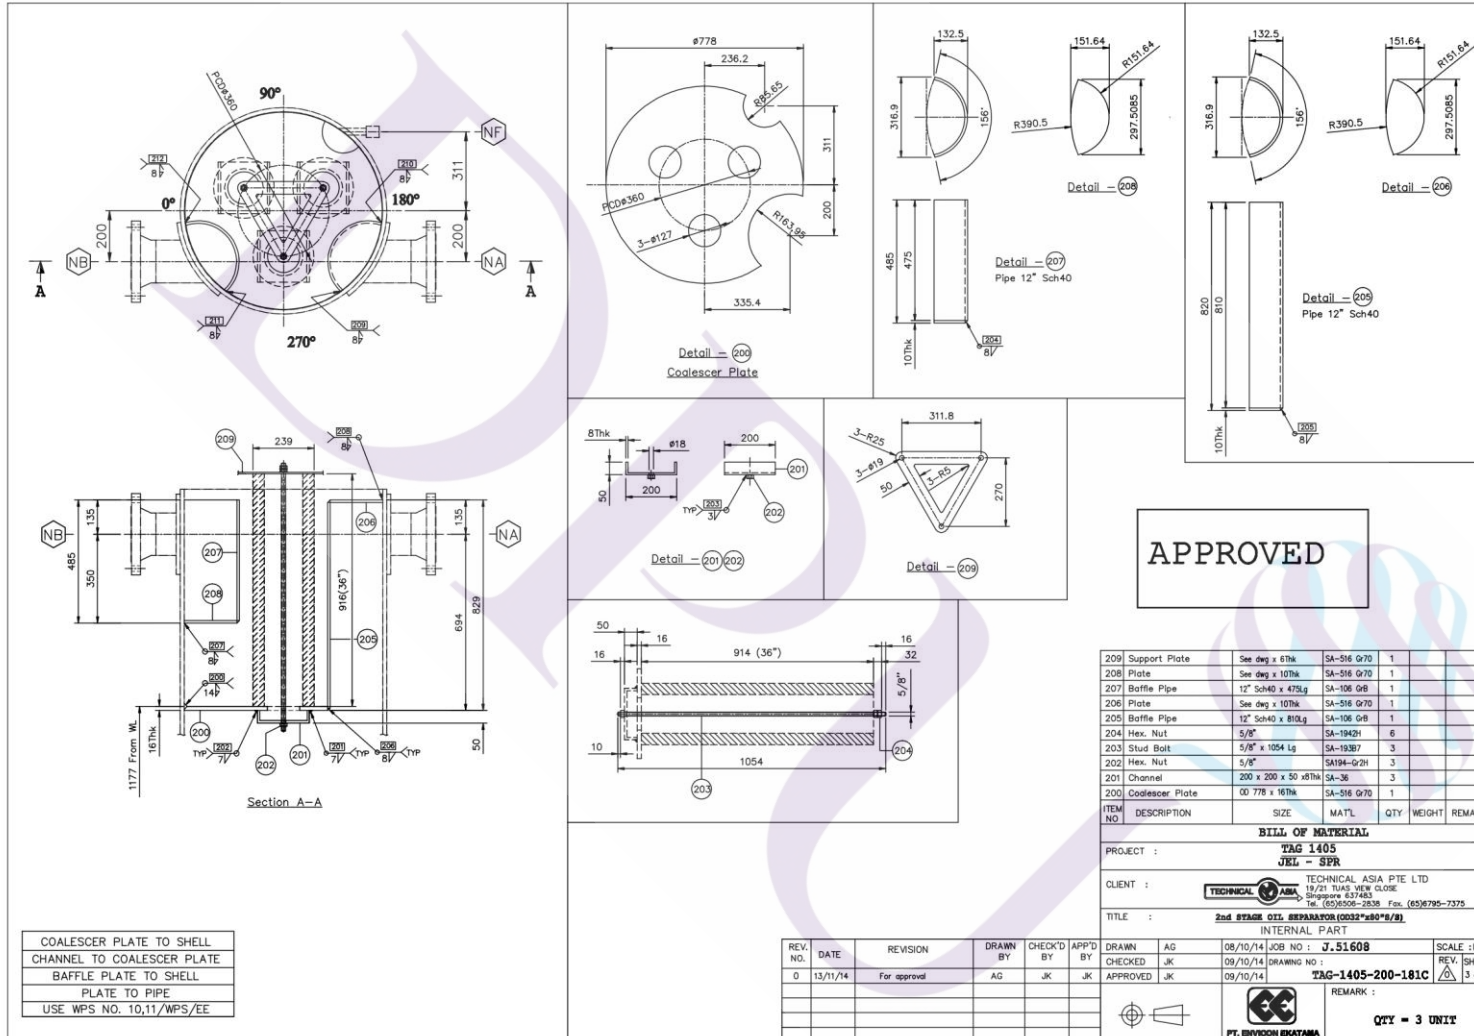

COALESCKER PLATE TO SHELL
 CHANNEL TO COALESCKER PLATE
 BAFFLE PLATE TO SHELL
 PLATE TO PIPE
 USE WPS NO. 10,11/WPS/EE


APPROVED


ITEM NO	DESCRIPTION	SIZE	MATL	QTY	WEIGHT	REMARK
209	Support Plate	See dwg x 6Thk	SA-516 Gr70	1		
208	Plate	See dwg x 10Thk	SA-516 Gr70	1		
207	Baffle Pipe	12" Sch40 x 475Lg	SA-106 GrB	1		
206	Plate	See dwg x 10Thk	SA-516 Gr70	1		
205	Baffle Pipe	12" Sch40 x 810Lg	SA-106 GrB	1		
204	Hex. Nut	5/8"	SA-1942H	6		
203	Stud Bolt	5/8" x 1054 Lg	SA-193B7	3		
202	Hex. Nut	5/8"	SA194-Gr2H	3		
201	Channel	200 x 200 x 50 x8Thk	SA-36	3		
200	Coalescker Plate	00.778 x 16Thk	SA-516 Gr70	1		


BILL OF MATERIAL
TAG 1405
JEL - SPR
 PROJECT :
 CLIENT : TECHNICAL ASIA PTE LTD
 19/01 HUKA WING CLUSE
 Singapore 637485
 Tel: (65)6556-2838 Fax: (65)6795-7375
 TITLE : 2nd STAGE OIL SEPARATOR (0052*200*8/9)
 INTERNAL PART


REV. NO.	DATE	REVISION	DRAWN BY	CHECK'D BY	APP'D BY	AG	JK	SCALE
0	13/11/14	For approval	AG	JK	JK			SCALE : NTS


08/10/14 JOB NO : J.51608
 09/10/14 DRAWING NO :
 09/10/14 APPROVED TAG-1405-200-181C
 3 of 5
 REMARK :
QTY = 3 UNIT
 PT. BINYUON EKATAMA

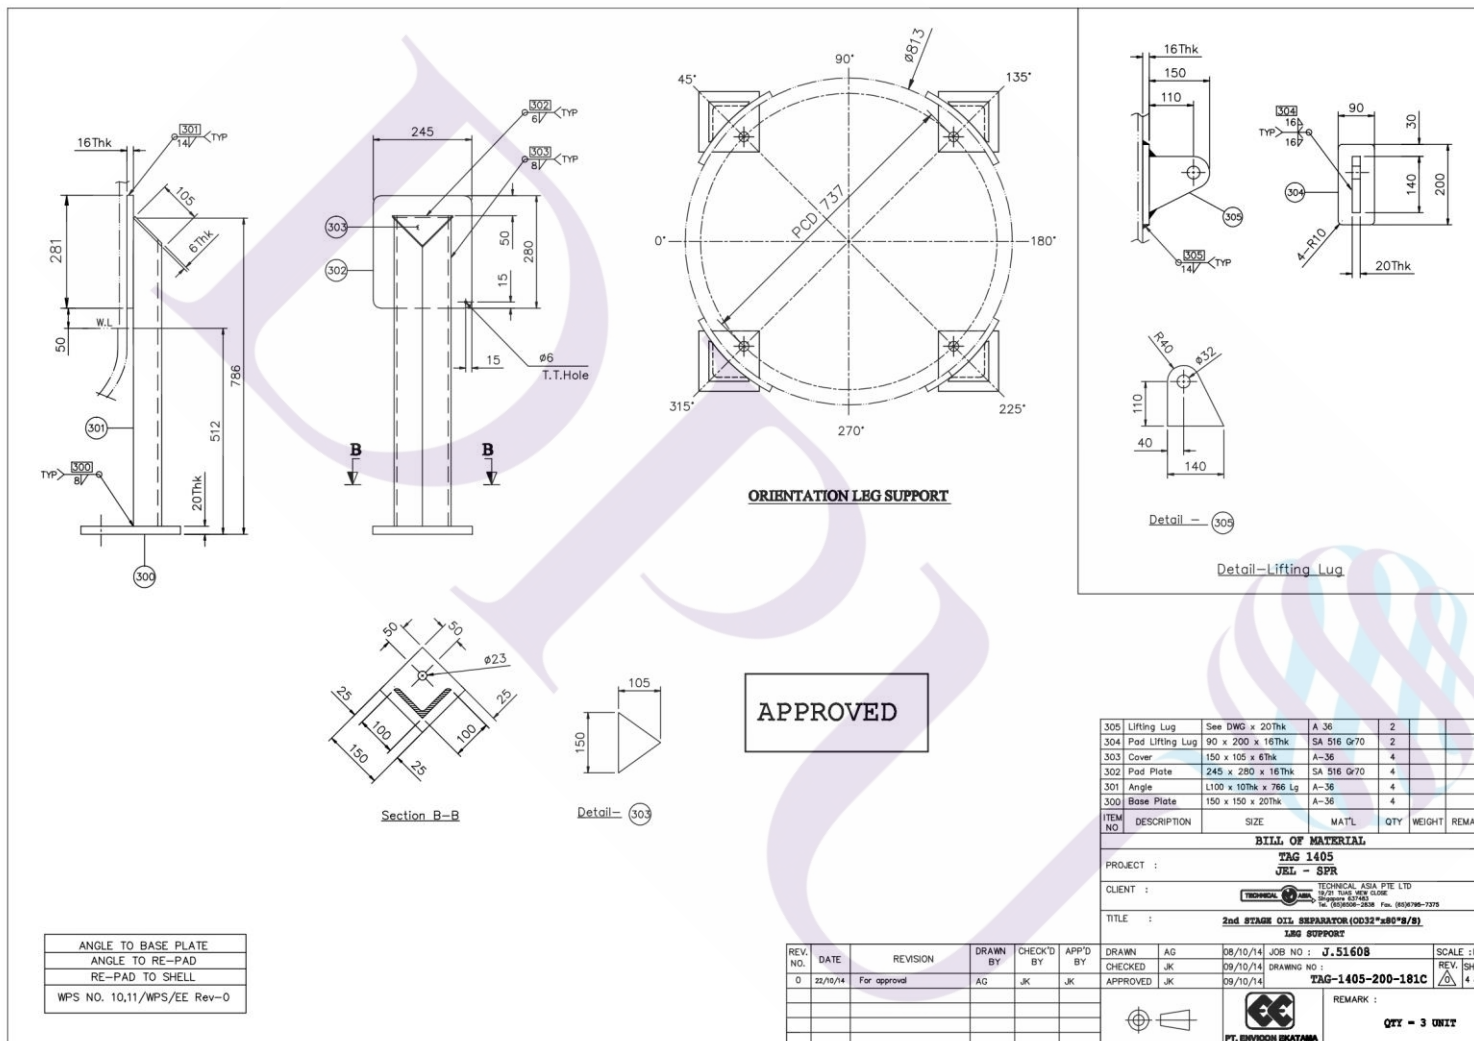

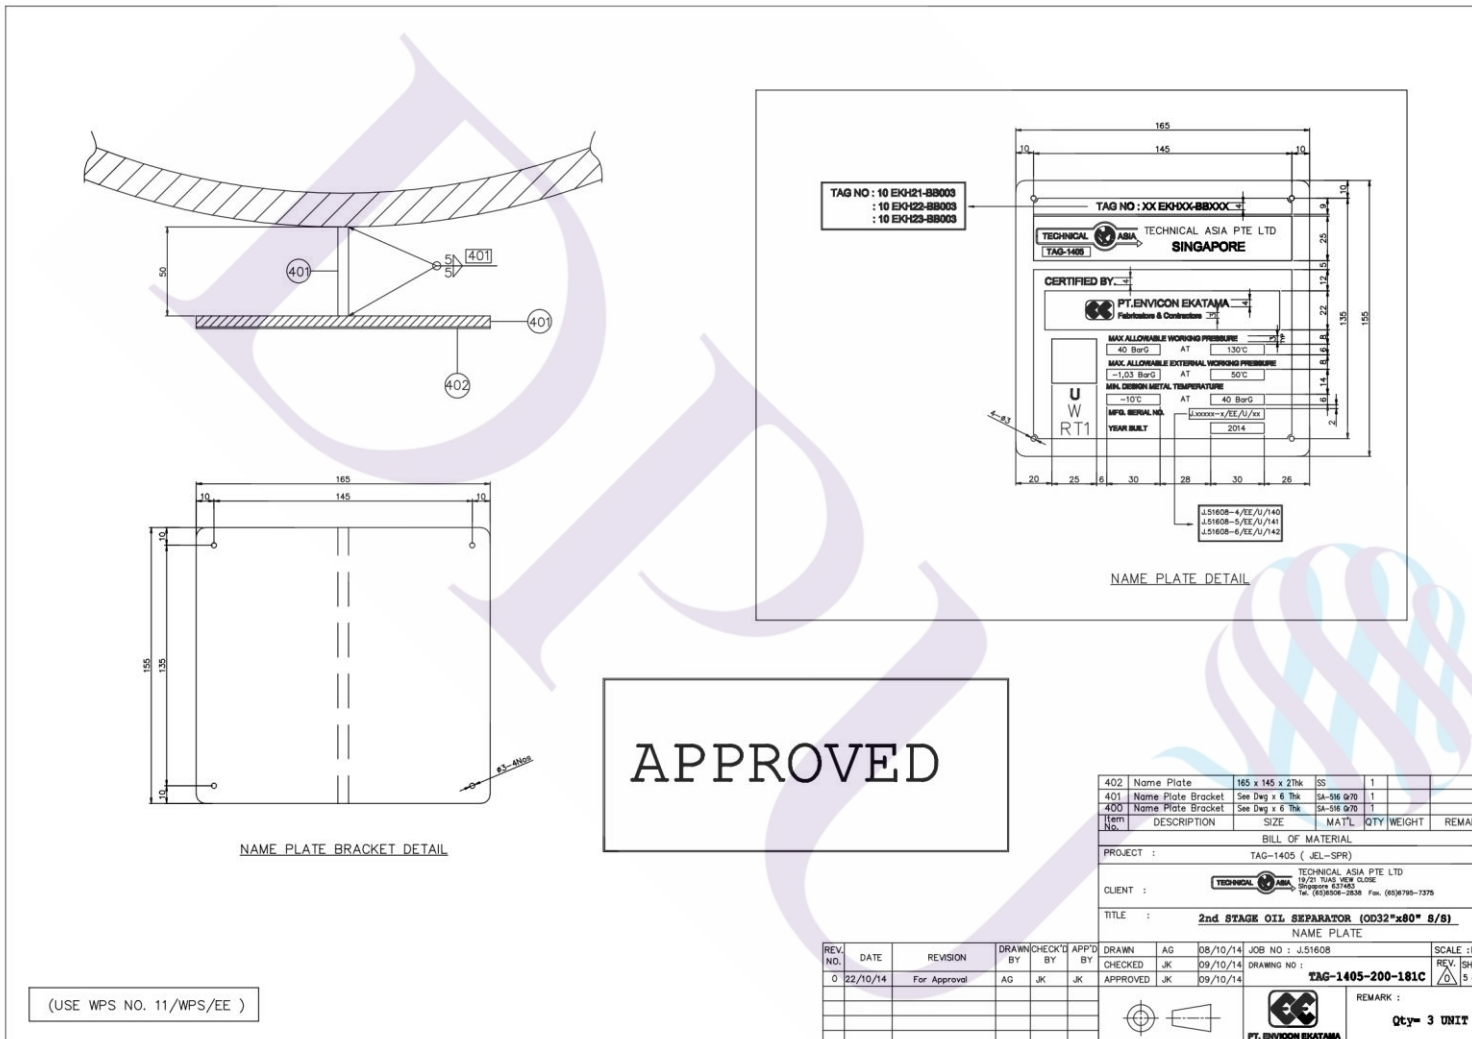

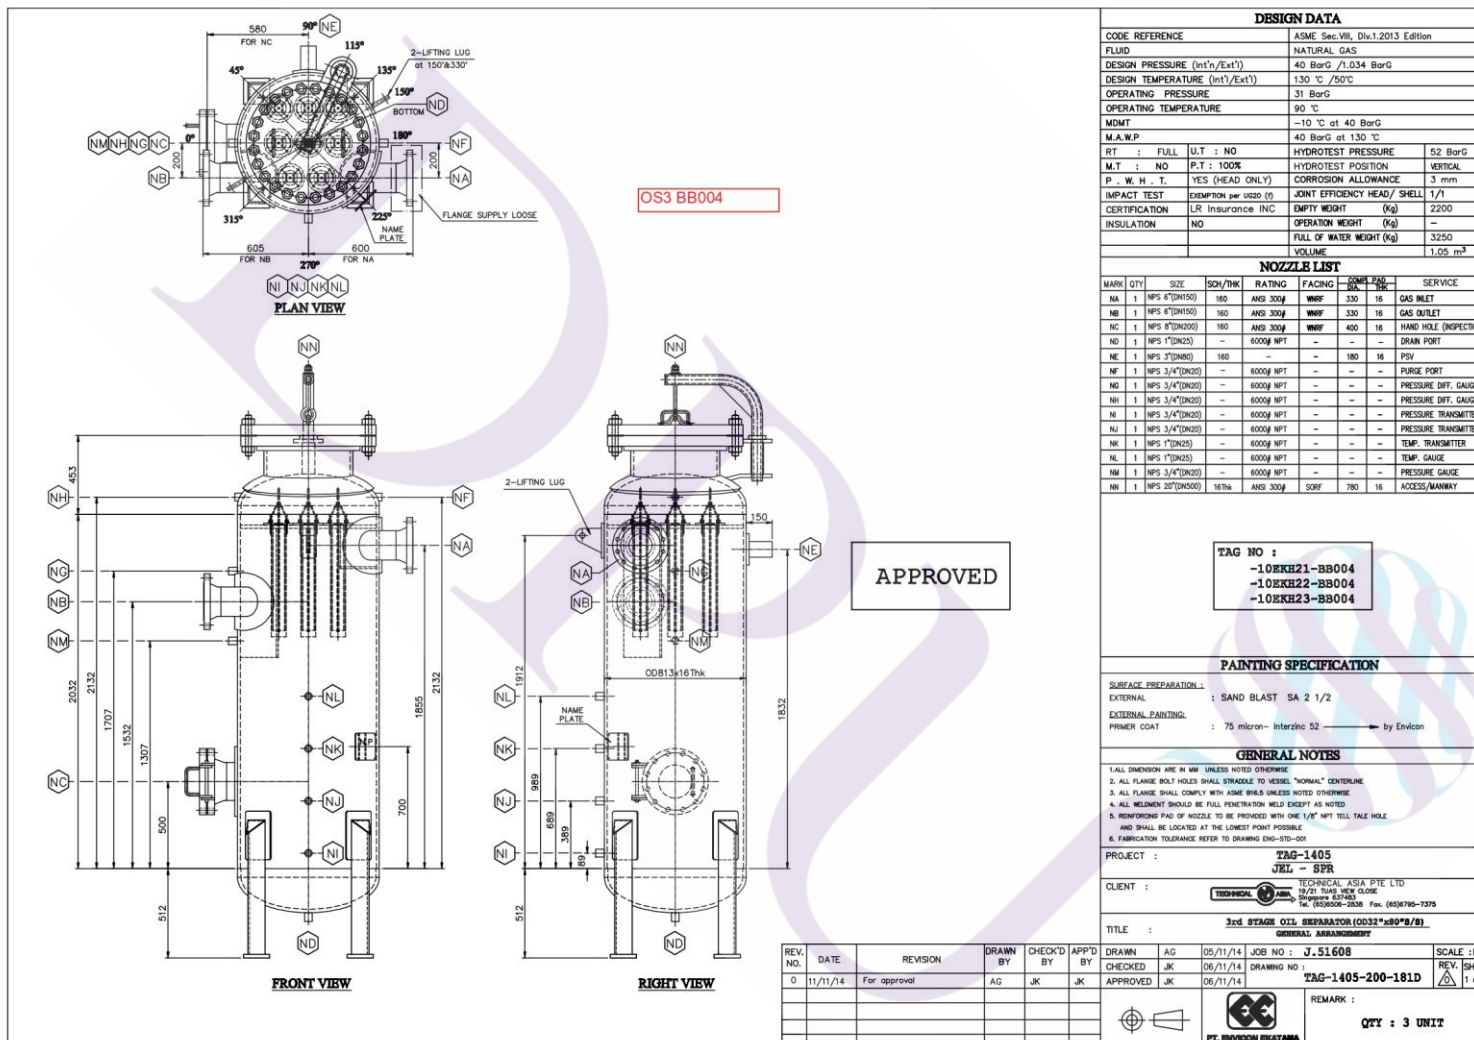

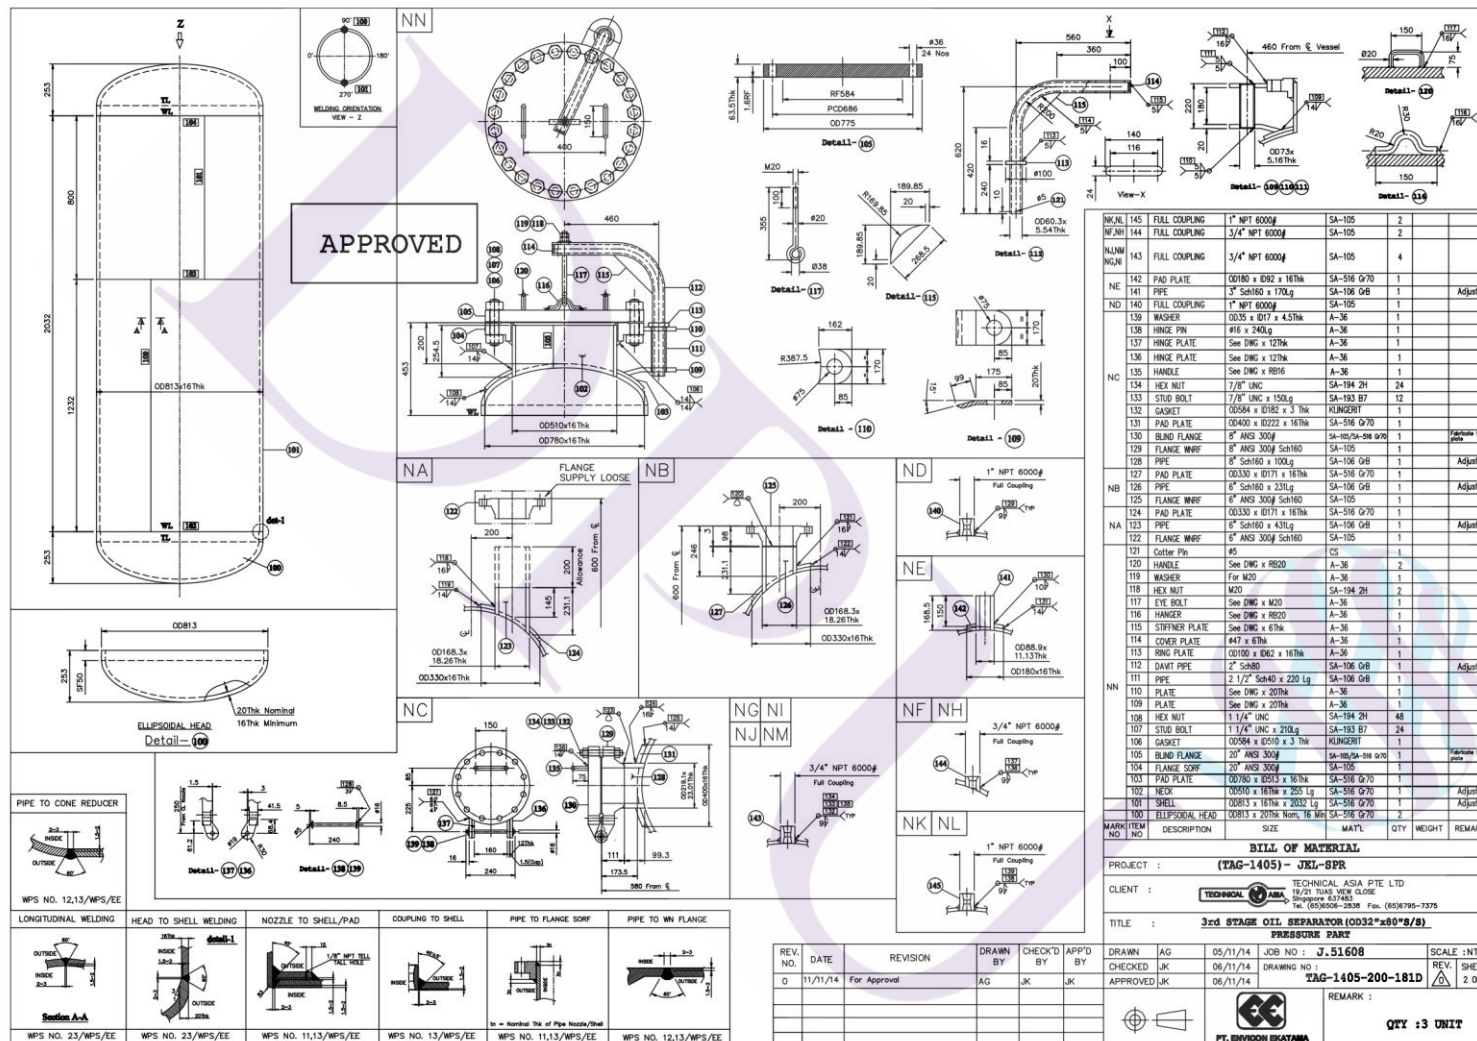

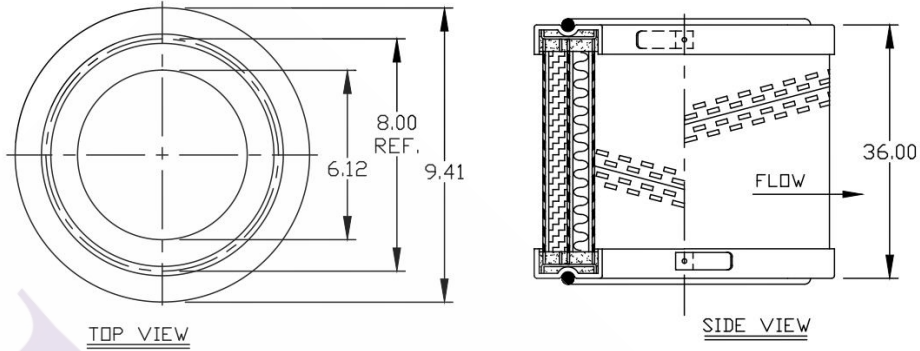


**OS1, OS2 BB002, BB003
Coalesce Element**

TECHNICAL DATA INFORMATION KR1900-014P			
BOX SIZE:	B136 (12.5 X 39 IN.) (318 X 991 MM)		
CASE QUANTITY:	1 PER BOX		
WEIGHT:	31.00 LBS.		
ELEMENT TYPE:	GAS/OIL SEPARATOR		
UNIT TYPE:	OPEN/OPEN STEEL CAPS		
MEDIA TYPE:	FIBERGLASS/MICROGLASS		
SEAL TYPE:	NEOPRENE O-RING		
END SEAL:	EPOXY		
FLOW DIRECTION:	INSIDE/OUTSIDE		
MICRON RATING:	0.1μ		
UNIT:	IN.	MM	
O.D. LARGEST:	9.41	239	
BODY O.D. DIA:	9.41	239	
INSIDE DIAMETER:	6.12	155	
BODY HEIGHT:	36.00	914	
DIA. HOLE ON RETAINER:	0.00	0.00	
BOLT PATTERN:	IN.	MM	
DIA. HOLES:	0.00	0.00	
BCD HOLES:	0.00	0.00	
QTY. OF HOLES:	0		
UNIT:	FT ²	M ²	
SURFACE AREA:	22.53	2.09	
CAPACITY PER UNIT @ 31 BARG:	CFM	M ³ /H	
NATURAL GAS:	225.3	382.7	
UNIT:			
OPERATING TEMPERATURE:	-35°F / 300°F		
INITIAL DELTA P:	1-2 PSI (0.069-0.14 bar)		
EFFICIENCY:	2-3 PPM		
MAX. OPER. PRESSURE:	Designed for a Delta P. not to exceed 3.5 Bar		

THIS DOCUMENT AND ITS CONTENT ARE THE PROPERTY OF KELTEC TECHNOLOG. THE USE OF THIS DOCUMENT AND ITS CONTENT WITHOUT WRITTEN PERMISSION OF KELTEC TECHNOLOG IS PROHIBITED.




2300 East Enterprise Parkway
Twinsburg, Ohio 44087

Part No. KR1900-014P


Rev. 0.0

DEM: SPECIAL	DEM No. ---	WEIGHT LBS. 31.00	DRAWN BY: E.RICHE
THIS DOCUMENT AND ITS CONTENT ARE THE PROPERTY OF KELTEC TECHNOLOG. THE USE OF THIS DOCUMENT AND ITS CONTENT WITHOUT WRITTEN PERMISSION OF KELTEC TECHNOLOG IS PROHIBITED.		DATE: 8/16/12	Part No. KR1900-014P

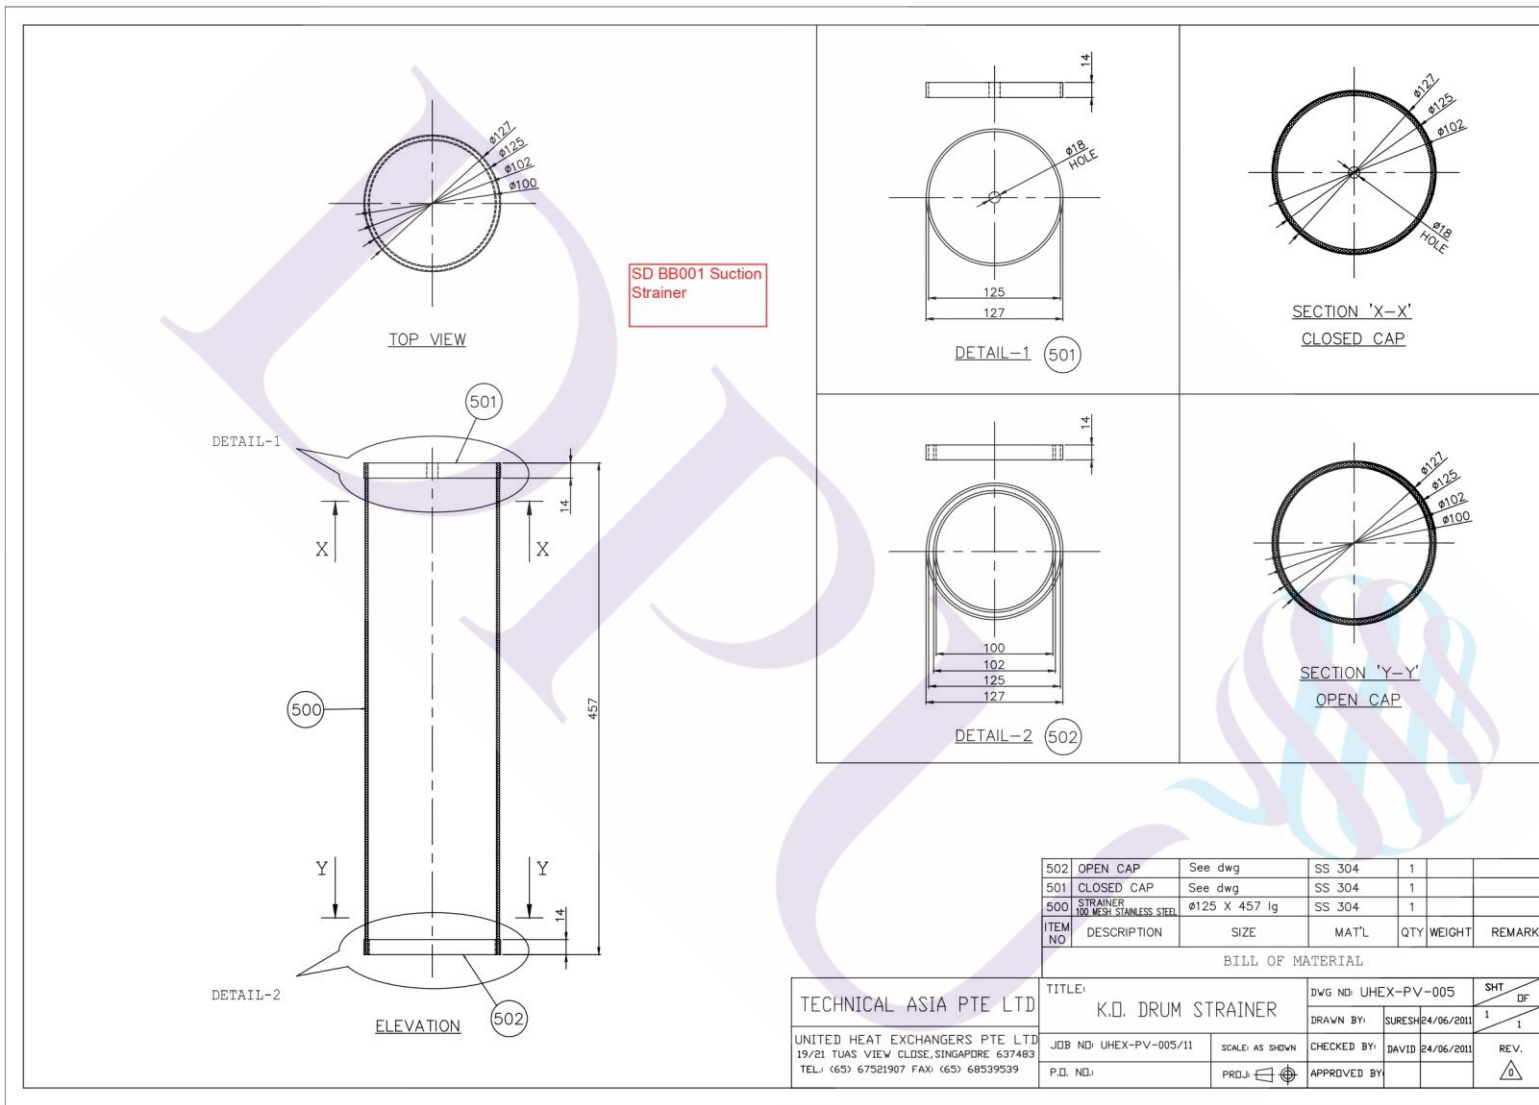




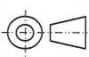

TAG-1405 Siam Pure Rice Lubricant List

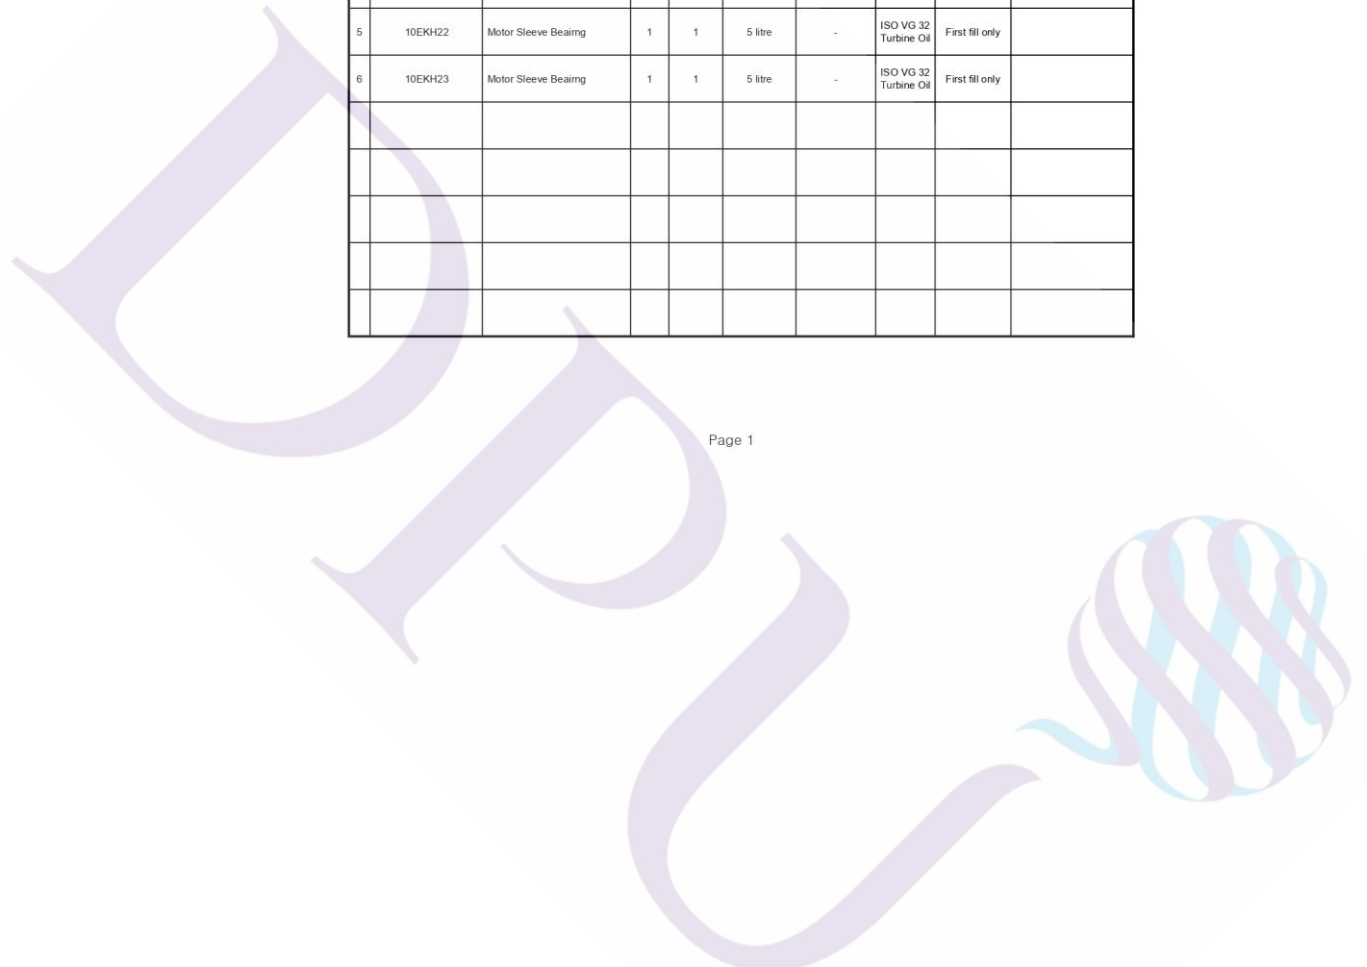No.	Item no.	Service name	No. of Req'd (unit)	Part Lubricated	Total Quantity per item (liters or grams)		Lubricant Spec.	Refilling Interval (daily, weekly, monthly or yearly)	REMARK
					Initial Filling	1 Year			
1	10EKH21	Compressor Lubrication	1	1	1350 litre	10 litre	ISO VG 68 Turbine Oil	Based on sampling testing	
2	10EKH22	Compressor Lubrication	1	1	1350 litre	10 litre	ISO VG 68 Turbine Oil	Based on sampling testing	
3	10EKH23	Compressor Lubrication	1	1	1350 litre	10 litre	ISO VG 68 Turbine Oil	Based on sampling testing	
4	10EKH21	Motor Sleeve Bearing	1	1	5 litre	-	ISO VG 32 Turbine Oil	First fill only	
5	10EKH22	Motor Sleeve Bearing	1	1	5 litre	-	ISO VG 32 Turbine Oil	First fill only	
6	10EKH23	Motor Sleeve Bearing	1	1	5 litre	-	ISO VG 32 Turbine Oil	First fill only	



REV.	DATE	DESCRIPTION	DRAWN	DESIGNED	CHECKED	APPROVED	STATUS
0	25-Jan-16	Issued for Construction	-	ABP	LAX	GPJ	C
B	31-Aug-15	Issued for Reference	-	ABP	SKM	GPJ	R
A	12-Aug-15	Issued for Reference	-	ABP	SKM	GPJ	R

JEL STAMP			OWNER'S APPROVAL STAMP				
<div style="border: 2px solid red; padding: 5px; color: red; font-weight: bold; font-size: 1.2em;">FOR CONSTRUCTION</div>							

OWNER		 SIAM PURE RICE COMPANY LIMITED 71 AGR Building, Charoen Rat Road, Bang Khlo, Bang Kho Laem, Bangkok 10120.					
SPR	OWNER'S ENGINEER	TRACTEBEL ENGINEERING LTD. TRACTEBEL Engineering Unit 1903-1905,19 th Fl., Two Pacific Place Building,142 Sukhumvit Road, Kwaeng Klongtoey, Khet Klongtoey, Bangkok 10110.					
TE							
TJEL							
PROJ	THE CONSORTIUM OF						
P&E	OFFSHORE CONSORTIUM MEMBER			ONSHORE CONSORTIUM MEMBER			
PIPING	 JURONG ENGINEERING LIMITED 25 Tanjong Kling Road, Singapore 628050.			 THAI JURONG ENGINEERING LIMITED 75/43 Ocean Tower2, 22nd Floor, Sukhumvit 19, North Klongtoey, Wattana, Bangkok 10110.			
C&S	OWNER CONTRACT NO.		PROJECT				
T&V	-		SPR 120MW SPP PROJECT				
ELEC	SCALE	PROJECTION	TITLE:				
INST		NTS	GAS TURBINE DATA SHEET				
PROC							
	 Jurong Engineering Limited			JOB NO. 20036		JEL DRAWING NO. C551-005	
TOTAL				PROJECT DRAWING NO. SPR-10-MB-DS-M1001			REV. NO. 0
DISTRIBUTION							

SIEMENS

Project: Siam Pure Rice Co., Ltd. 120MW Cogeneration SPP Project		Page 1	
GAS TURBINE DATA SHEET			
Technical / Equipment Data Sheet			
Item	Description	Unit	Data
1	Gas Turbine & Auxiliary Systems		
1.1	General		
	Gas turbine model		SGT-800
	Manufacturer		
	• Rotor		Siemens
	• Power turbine		Siemens
	• Compressor		Siemens
	Rating (ISO conditions)	kW	50500
1.2	Compressor		
	Number of stages		15
	Maximum tip speed	m/s	375
	Mean axial velocity, Ca	m/s	165
	Mass flow	kg/s	130
	Discharge pressure	bar(g)	20
	Discharge temperature	°C	450
	Variable inlet guide vane control,		Yes
	Number of variable stages		3
	Shaft type (welded/bolted joints)		Electron beam welding; bolted joint
	Rotor Speeds		
	• Service speed	RPM	6600
	• Power turbine service speed (if not a single shaft turbine)	RPM	Single shaft
	Materials		
	• Compressor forgings (discs and shafts)		Disc 1-9 = 2596-55 Disc 10-15 = 2390-95
	• Compressor blades and vanes		Guide vane 0 - 4 = 2388-63 Guide vane 5 - 15 = 2390-95
	• Compressor blades and vanes		Blade 1-4 = 2388-63 Blade 5-15 = 2390-95
	• Compressor blades and vanes coating		N/A

SIEMENS

Project :- Siam Pure Rice Co., Ltd. 120MW Cogeneration SPP Project			
Page 2			
Technical / Equipment Data Sheet			
Item	Description	Unit	Data
1.3	Combustion system		
	Number of combustion chambers		1
	Adiabatic combustion temperature	°C	N/A
	Turbine rotor inlet temperature	°C	1180
	Number of fuel nozzles/chamber		30
	Fuel nozzle types		
	• Natural gas		Removable, single fuel DLE
	Number of ignition spark plugs		1
	Number of flame detectors		2
	Lifetime (equivalent combustion hours of)		
	• Combustion liners		30 000 EOH
	• Transition pieces		30 000 EOH
	Materials		
	• Combustion liners		6323-XX (Haynes 230)
	• Transition pieces		N/A
	Coatings		
	• Combustion liners		TBC
	• Transition pieces		N/A
1.4	Turbine		
	Number of stages		3
	Cooled stages		
	• Rotor		2 (Stage 1: Film Cooled; Stage 2: Convection cooled)
	• Stator		
	Mass flow		
	• Nominal	kg/s	Approx. 130
	• Maximal (Ambient air +15 oC)	kg/s	Approx. 133
	Outlet temperature		
	• Nominal	°C	540
	• At idle load	°C	Approx. 400
	• Maximal mean temperature (ambient air +37 oC)	°C	600
	• Hot spot temperature (+37 oC)	°C	Core engine is isolated
	• Max. temperature spread	°C	This is Siemens knowledge that is not handed over to customer.

SIEMENS

Project :- Siam Pure Rice Co., Ltd. 120MW Cogeneration SPP Project			
Page 3			
Technical / Equipment Data Sheet			
Item	Description	Unit	Data
	Materials		
	• Turbine Stator blades (each stage)	1 st	Stator vane 1 = 6380-XX (IN792, Ni-alloy)
		2 nd	Stator vane 2 = 6384-XX (IN738, Ni-alloy)
		3 rd	Stator vane 3 = 6377-XX (IN939, Ni-alloy)
	• Turbine Rotor blades (each stage)	1 st	Rotor blade 1 = CMSX4 (Ni-alloy)
		2 nd	Rotor blade 2 = 6380-XX (IN792, Ni-alloy)
		3 rd	Rotor blade 3 = 6380-XX (IN792, Ni-alloy)
	Coatings		
	• Turbine Stator blades (each stage)	1 st	Vane 1 (profile) = SV394 (MCrAlY) Vane 1 (platform) = SV349+TBC(0.4 mm thick)
		2 nd	Vane 2 (profile+platforms) = Sermalloy J Vane 3 (platforms) = TBC
		3 rd	See above
	• Turbine Rotor blades (each stage)	1 st	Blade 1 = PWP400-1 (NiCoCrAlY), bond coat + PWP100 (TBC)
	Turbine discs material		Discs 1-3 = 6381-03 (IN718, Ni-alloy)
	Number of shafts, if not a single shaft gas turbine		Single shaft
	Shaft type (welded/bolted joints)		Bolted joint
	Exhaust gas outlet dimensions(at the delivery limit, inner diameter)		
	• Round outlet		
	• Diameter	mm	Approx. 1.54
1.5	Auxiliaries		
1.5.1	Fuel systems		
	Minimum fuel temperatures		
	• Natural gas	°C	20 degC above fuel gas dew point.
	Maximum fuel temperatures		
	• Natural gas	°C	140 degC
	Minimum fuel pressure at delivery limit to fully load the GT at all ambient		
	• Natural gas	bar(g)	Varies on fuel gas composition, 27-30 bar(g).
	Maximum fuel pressure at delivery limit		
	• Natural gas	bar(g)	Approx. 32

SIEMENS

Siam Pure Rice Co., Ltd.		Page 4	
120MW Cogeneration SPP Project			
Technical / Equipment Data Sheet			
Item	Description	Unit	Data
1.5.2	Coolers (use cooling water)		
	Cooler	Water flow (kg/s)	Temp. Difference (°C)
	Lube oil Cooler	25	1150 kW, 11,6°C (flow depends on cooling water temp)
	Generator	27.5	750 kW, 7,5°C (flow depends on cooling water temp)
1.5.3	Pumps (use and power demand)		
	Pump	Drive	Power demand (kW)
	Lube oil		15 (se nedan punkt 1.5.5)
	Jacking oil		10 (se nedan punkt 1.5.5)
1.5.4	Gas Turbine Lube Oil System		
	Pump	Drive	Power Demand (kW)
	3 Pumps (3x70%)	AC-driven	37 (2x10 kW at operation)
	Jacking oil	AC-driven	11
	Lube oil filters, capacity (number * xx%)		2 x 100% (Duplex type filters)
	Lube oil coolers, capacity (number * xx%)		2 x 100%
	Lube oil coolers, material		Stainless steel
	Total lube oil flow	l/min	1750
	Lube oil piping material		Stainless steel downstream of filter.
	Number of temperature detectors		3 at each bearing and 1 on oil tank.
	Oil quantity	Liters	12500 (Tank capacity)
	Oil type		ISO VG46
	Retention time acc. API 614	Min	6
1.5.5	Load Gearbox		
	Manufacturer		Flender
	Power rating according to AGMA 6011— G92, Chapter 3.9		Designed according to AGMA421/06
	Type / tooth surface		Single stage double helical design with horizontal offset.
	Rated speed		
	•Inlet	RPM	6600
	•Outlet	RPM	1500
	Application factor acc. to AGMA 6011— G92		AGMA
	Gear hardness (Rockwell C scale)	RC	58-63 HRC
	Gear hardness method		Carburizing
	Bearings: type		White metal lined bearings

SIEMENS

Project :- Siam Pure Rice Co., Ltd. 120MW Cogeneration SPP Project		Page 5	
Technical / Equipment Data Sheet			
Item	Description	Unit	Data
1.5.6	Couplings		
	Gas turbine < > Gearbox coupling		
	• manufacturer		Flender
	• type and description		Generator drive couplings, total 2 – HS and LS: Rigid couplings to API 671 with exceptions. External quillshafts per AGMA 421.06.
	Gearbox < > Generator coupling		
	• manufacturer		Flender
	• type and description		Speed Reduction gear of double hellical parallel design
1.5.7	Bearings		
	Gas turbine		
	• Number		2
	• Types		tilting pad hydrodynamic (forced lubrication), on rotor end hubs
	• Lubrication		Lube oil
	Generator		
	• Number		2
	• Lubrication		Mineral oil, quality ISO VG 46.
1.5.8	Auxiliary Power Demand		
	All the Equipment together	kW	125 kW at base load
1.5.9	Starting System		
	Motor / SFC Manufacturer		Frequency controlled Electric Starter Siemens
	Protection class	IP	21
	Voltage	V	690 VAC
	Speed	RPM	5900
	Allowed number of consecutive starts		3 starts/hour
1.5.10	Air Inlet System		
	Air Inlet System manufacturer		Static
	Filter manufacturer		Camfil Farr
	Inlet chiller manufacturer		FAIST



Project:-		Siam Pure Rice Co., Ltd. 120MW Cogeneration SPP Project			Page 6
Technical / Equipment Data Sheet					
Item	Description		Unit	Data	
	Description	Cross section area	Air velocity	Pressure Drop	Material
	unit	m ²	m/s	Pa	
	Prefilter	42.05	2.5	80/450	
	Fine filter	42.05	2.5	150/600	
	Chiller	42.05	2.5	234	
	Silencer	3.8	2.5	190	
	Ducts	3.8	2.5	30	
	Inlet elbow	3.8	2.5	30	
	Total	137.55	N/A		N/A
1.6	Weights and Dimensions				
	Turbine generator overall length		m	5.9	
	Turbine generator overall weight		kg	36000	
	Turbine rotor weight(s)		kg	7200	
	Generator rotor weight		kg	Approx. 27000	
	Heaviest piece to be lifted during erection		kg	85000	
	Heaviest piece to be lifted after erection (excluding the generator rotor)		kg	7200	
	Space required to remove generator rotor straight		m	5.2	
	Vertical clearance required to lift the largest piece over the assembled unit		m	Approx. 16.5 to clear air intake system.	
	Total moment of inertia of assembled rotor		kg-m ²	4823	
	Generator stator weight		kg	40400	



Nominal degradation for extended service intervals

The nominal unrecoverable degradation is shown in comparison with new and clean engine. Data is based on assumption that the compressor is clean and that the unit has operated in accordance with Operation & Maintenance manuals.

The degradation graph is for general information only. Replacements/refurbishments according to Maintenance general information for extended interval maintenance plan for SGT-800, 1CS77773 or 1CS120398.


The base load curves are applicable when running the gas turbine at 100% load.

The "Heat rate @ constant power" curves are applicable when the gas turbine runs at constant power output irrespective of ambient conditions, i.e. to be used for part load applications.


Equivalent operating hours after maintenance (EOH)	Power output degradation (%)	Heat rate @ base load degradation (%)	Heat rate @ constant power degradation (%)	Exhaust temperature degradation (% of °C)	Exhaust flow degradation (%)
After 30 000	-1.7	0.7	0.5	0.4	-1.0
After 60 000	-1.2	0.6	0.4	0.3	-0.7
After 90 000	-2.2	1.0	0.6	0.5	-1.2

We reserve all rights in this document and in the information contained therein. Reproduction, use or disclosure to third Parties without express authority is strictly forbidden.
© Siemens Industrial Turbomachinery AB

**SGT-800 Power output and heat rate degradation
in case TBO 30', gas fuel operation**

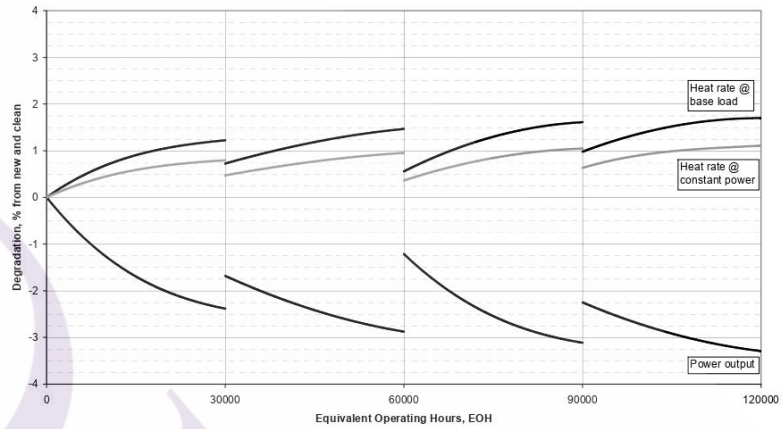

**SGT-800 Exhaust gas temperature and flow degradation
in case TBO 30', gas fuel operation**

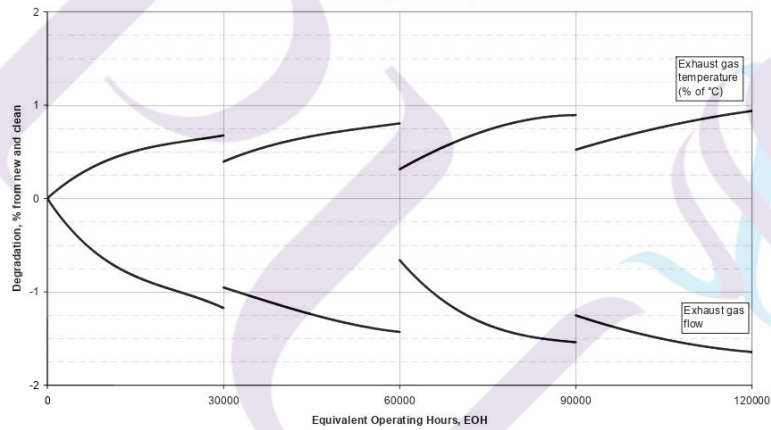

We reserve all rights in this document and in the information contained therein. Reproduction, use or disclosure to third Parties without express authority is strictly forbidden.
 © Siemens Industrial Turbomachinery AB

Specification for Gaseous Fuels, SGT-800

The purpose of this specification is to define the properties of gaseous fuels acceptable for use in the SGT-800. The SGT-800, with 3rd generation DLE combustion system, is capable of burning all common natural gases and a number of other gases such as hydrocarbon fuels rich in inert compounds, heavy hydrocarbons, hydrogen, etc. Tables 1-3 show the general allowable ranges for properties, constituents and contaminants valid for gaseous fuels in the SGT-800. The specification is valid at the terminal point of the gas turbine internal fuel system. Gas treatment options are available if required.

The contaminants listed are those most commonly found in natural gas fuels. If a fuel contains a contaminant or constituent for which a limit has not been included, or in cases where there are deviations from the requirements, Siemens must be consulted. A chemical analysis of the fuel must be submitted to Siemens for review and approval prior to operation of the gas turbine. Variations in gas composition and properties must also be reported and reviewed. Ultimately, only those fuels stipulated in the supply contract shall be permissible for operation.

Auxiliary systems and turbine governor will be adapted for the specific project gases and requirements and may not apply to all gases within this specification. The levels of certain constituents or properties may influence the design of the fuel system, enclosure ventilation, gas detection, area classification, materials selection, etc.

For definitions, see Appendix.

Table 1: Gas Fuel Constituents		Max	Min
Methane, CH ₄	mole % ⁽¹⁾	100	50
Ethane, C ₂ H ₆	mole % ⁽¹⁾	30	0
Propane, C ₃ H ₈	mole % ⁽¹⁾	30	0
Butanes and heavier alkanes, C ₄ +	mole % ⁽¹⁾	15 ⁽³⁾	0
Hydrogen and carbon monoxide, H ₂ + CO	mole % ⁽¹⁾	15 ⁽³⁾	0
Inerts, N ₂ /CO ₂	mole % ⁽²⁾	50/40 ⁽⁴⁾	0
Hydrogen sulfide, H ₂ S	mole % ⁽¹⁾	Report	0
Others (aromatics, alkenes, oxygen, etc)		Report	0

⁽¹⁾ % of reactant species (i.e. inerts not included)

⁽²⁾ % of total (inerts + reactants)

⁽³⁾ May be restricted to lower levels depending on the other gas constituents

⁽⁴⁾ Fuels with high inert content may require a separate fuel for ignition and start-up

Table 2: Gas Fuel Properties	Unit	Max	Min
Wobbe index, WI^0	MJ/Nm ³	60	22
WI^T variation during start-up	%	±5	-
WI^T variation rate	MJ/m ³ /s	±0.1	-
Gas temperature	°C	140 ^(5,6)	-15
Temperature above dew point	°C	-	20
Gas pressure set value ⁽⁷⁾	bar(a)	36	25
Pressure variation from set value	bar	±0.5 ⁽⁸⁾	-
Pressure variation rate	bar/s	±0.1 ⁽⁹⁾	-

⁽⁵⁾ May be restricted to lower temperatures for gases with low Wobbe index.

⁽⁶⁾ An option for higher gas temperature (<200°C) is also available

⁽⁷⁾ This will be project specific depending on e.g. gas composition, gas temperature and ambient temperature. Typical value is 27-30 bar(a) for natural gas.

⁽⁸⁾ <1.5 bar for transients, such as start-ups, sudden load steps or load rejections

⁽⁹⁾ No periodic cycling of gas pressure is permitted

Table 3: Contaminants	Unit	Max	Min
Particulates < 5 µm	ppmw	5	-
Particulates > 5 µm	ppbw	5	-
Na, K	ppmw	0.1	-
Other metals		Report	-
Lube oil	ppmw	0.5	-
Other impurities		Report	-

Appendix

Wobbe index

The fuel gas Wobbe index, WI^0 , is defined as the lower heating value, LHV (volumetric) divided by the square root of the relative density.

$$WI^0 = \frac{LHV}{\sqrt{\rho_{rel}}} \quad (\rho_{rel} = \frac{\rho_{gas}}{\rho_{air}})$$

Nm^3 (normal cubic meter) at 101.325 kPa and 273 K (0°C).

To evaluate the suitability of a gas with varying properties or several gases with different properties, the temperature corrected Wobbe index, WI^T , is introduced.

$$WI^T = WI^0 \cdot \sqrt{\frac{273}{T_{Fuel}}}$$

T_{Fuel} = Fuel temperature at gas fuel system terminal point, K

ประวัติผู้เขียน

ชื่อ-นามสกุล

นายจิรากร อิ่มทอง

ประวัติการศึกษา

ปีการศึกษา 2549 ปริญญาตรี วิศวกรรมศาสตรบัณฑิต
สาขาวิชาวิศวกรรมไฟฟ้า มหาวิทยาลัยเทคโนโลยีราชมงคล
ล้านนา วิทยาเขตตาก

ตำแหน่งและสถานที่ทำงานปัจจุบัน

พนักงานควบคุมการผลิต (Control Room Operator)
บริษัท อมตะ บี.กริม เพาเวอร์ (ระยอง) 4 จำกัด